

NOTES:

**NTE TO ADD NOTED FEATURES OF THIS DRAWING TO LIGO P/N D060493.**

(R20 TYP)

R20 TYP

2X 25

ADDED FEATURE DETAIL TYPICAL

(600)

(759)


**FOR REVISION ADD NOTED FEATURES**

CALIFORNIA INSTITUTE OF TECHNOLOGY MASSACHUSETTS INSTITUTE OF TECHNOLOGY		REV.
SIZE	DWG. NO.	XX
<b>REVISIONS</b>		
SCALE: NONE	PROJECTION:	SHEET 1 OF 2


D060493 Rev. 10/2012 PART PDM REV. X-022 DRAWING PDM REV. X-003

8 7 6 5 4 3 2 1

H  
G  
F  
E  
D  
C  
B  
A

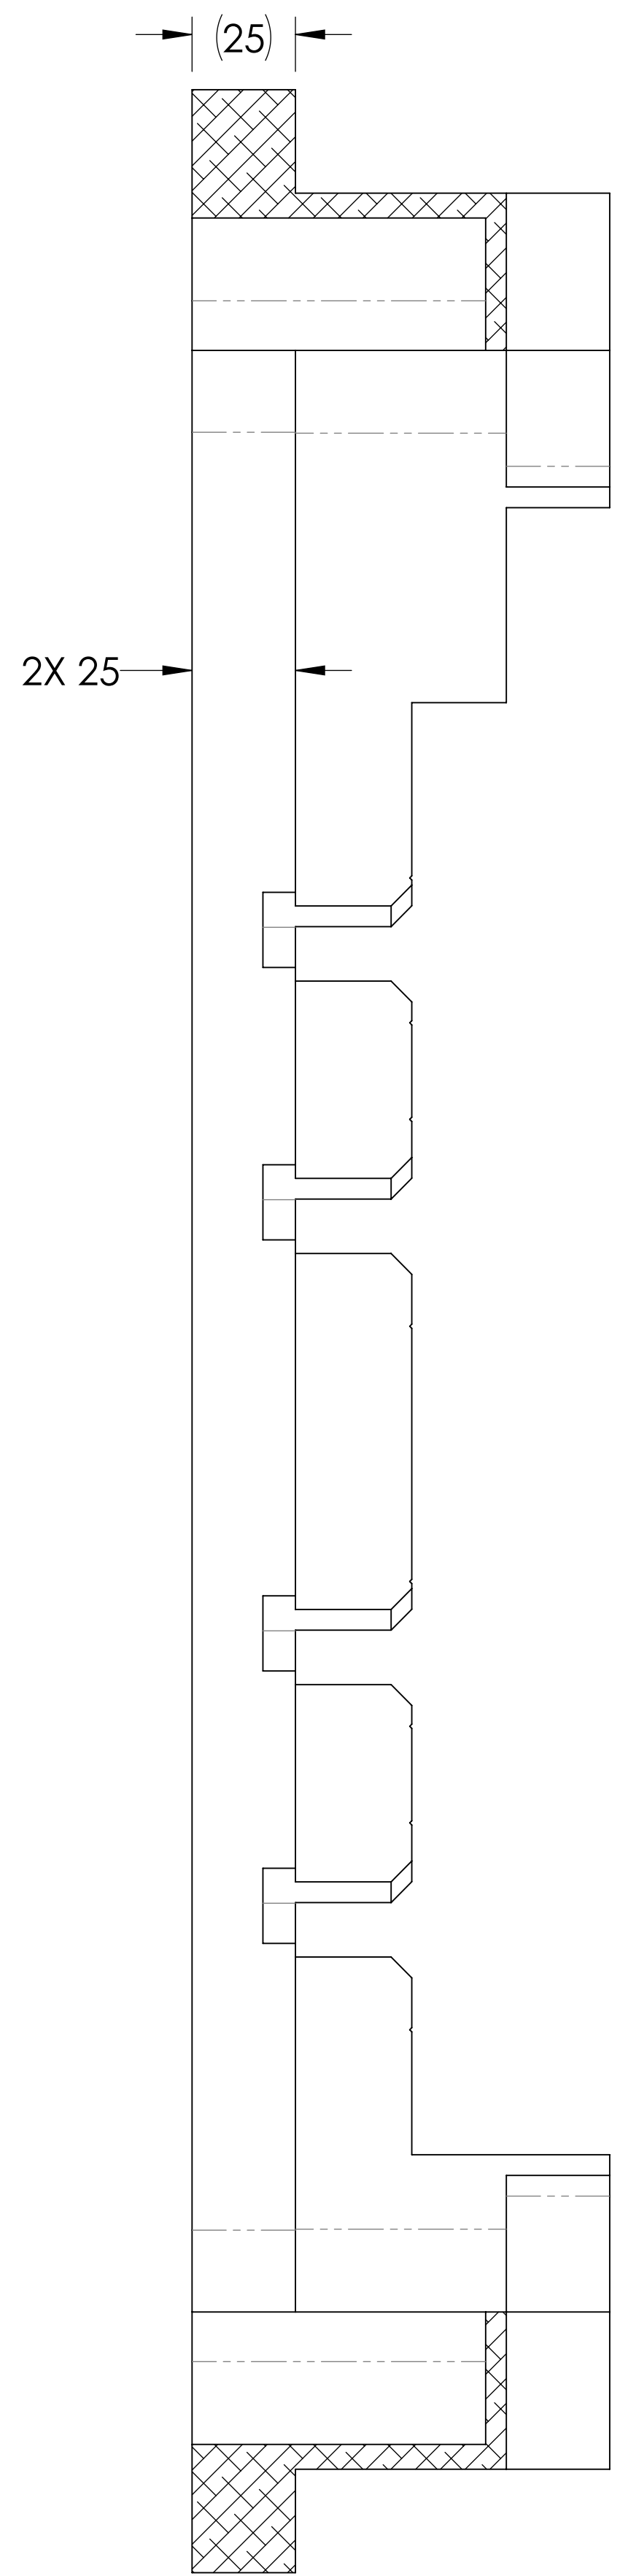

SECTION A-A

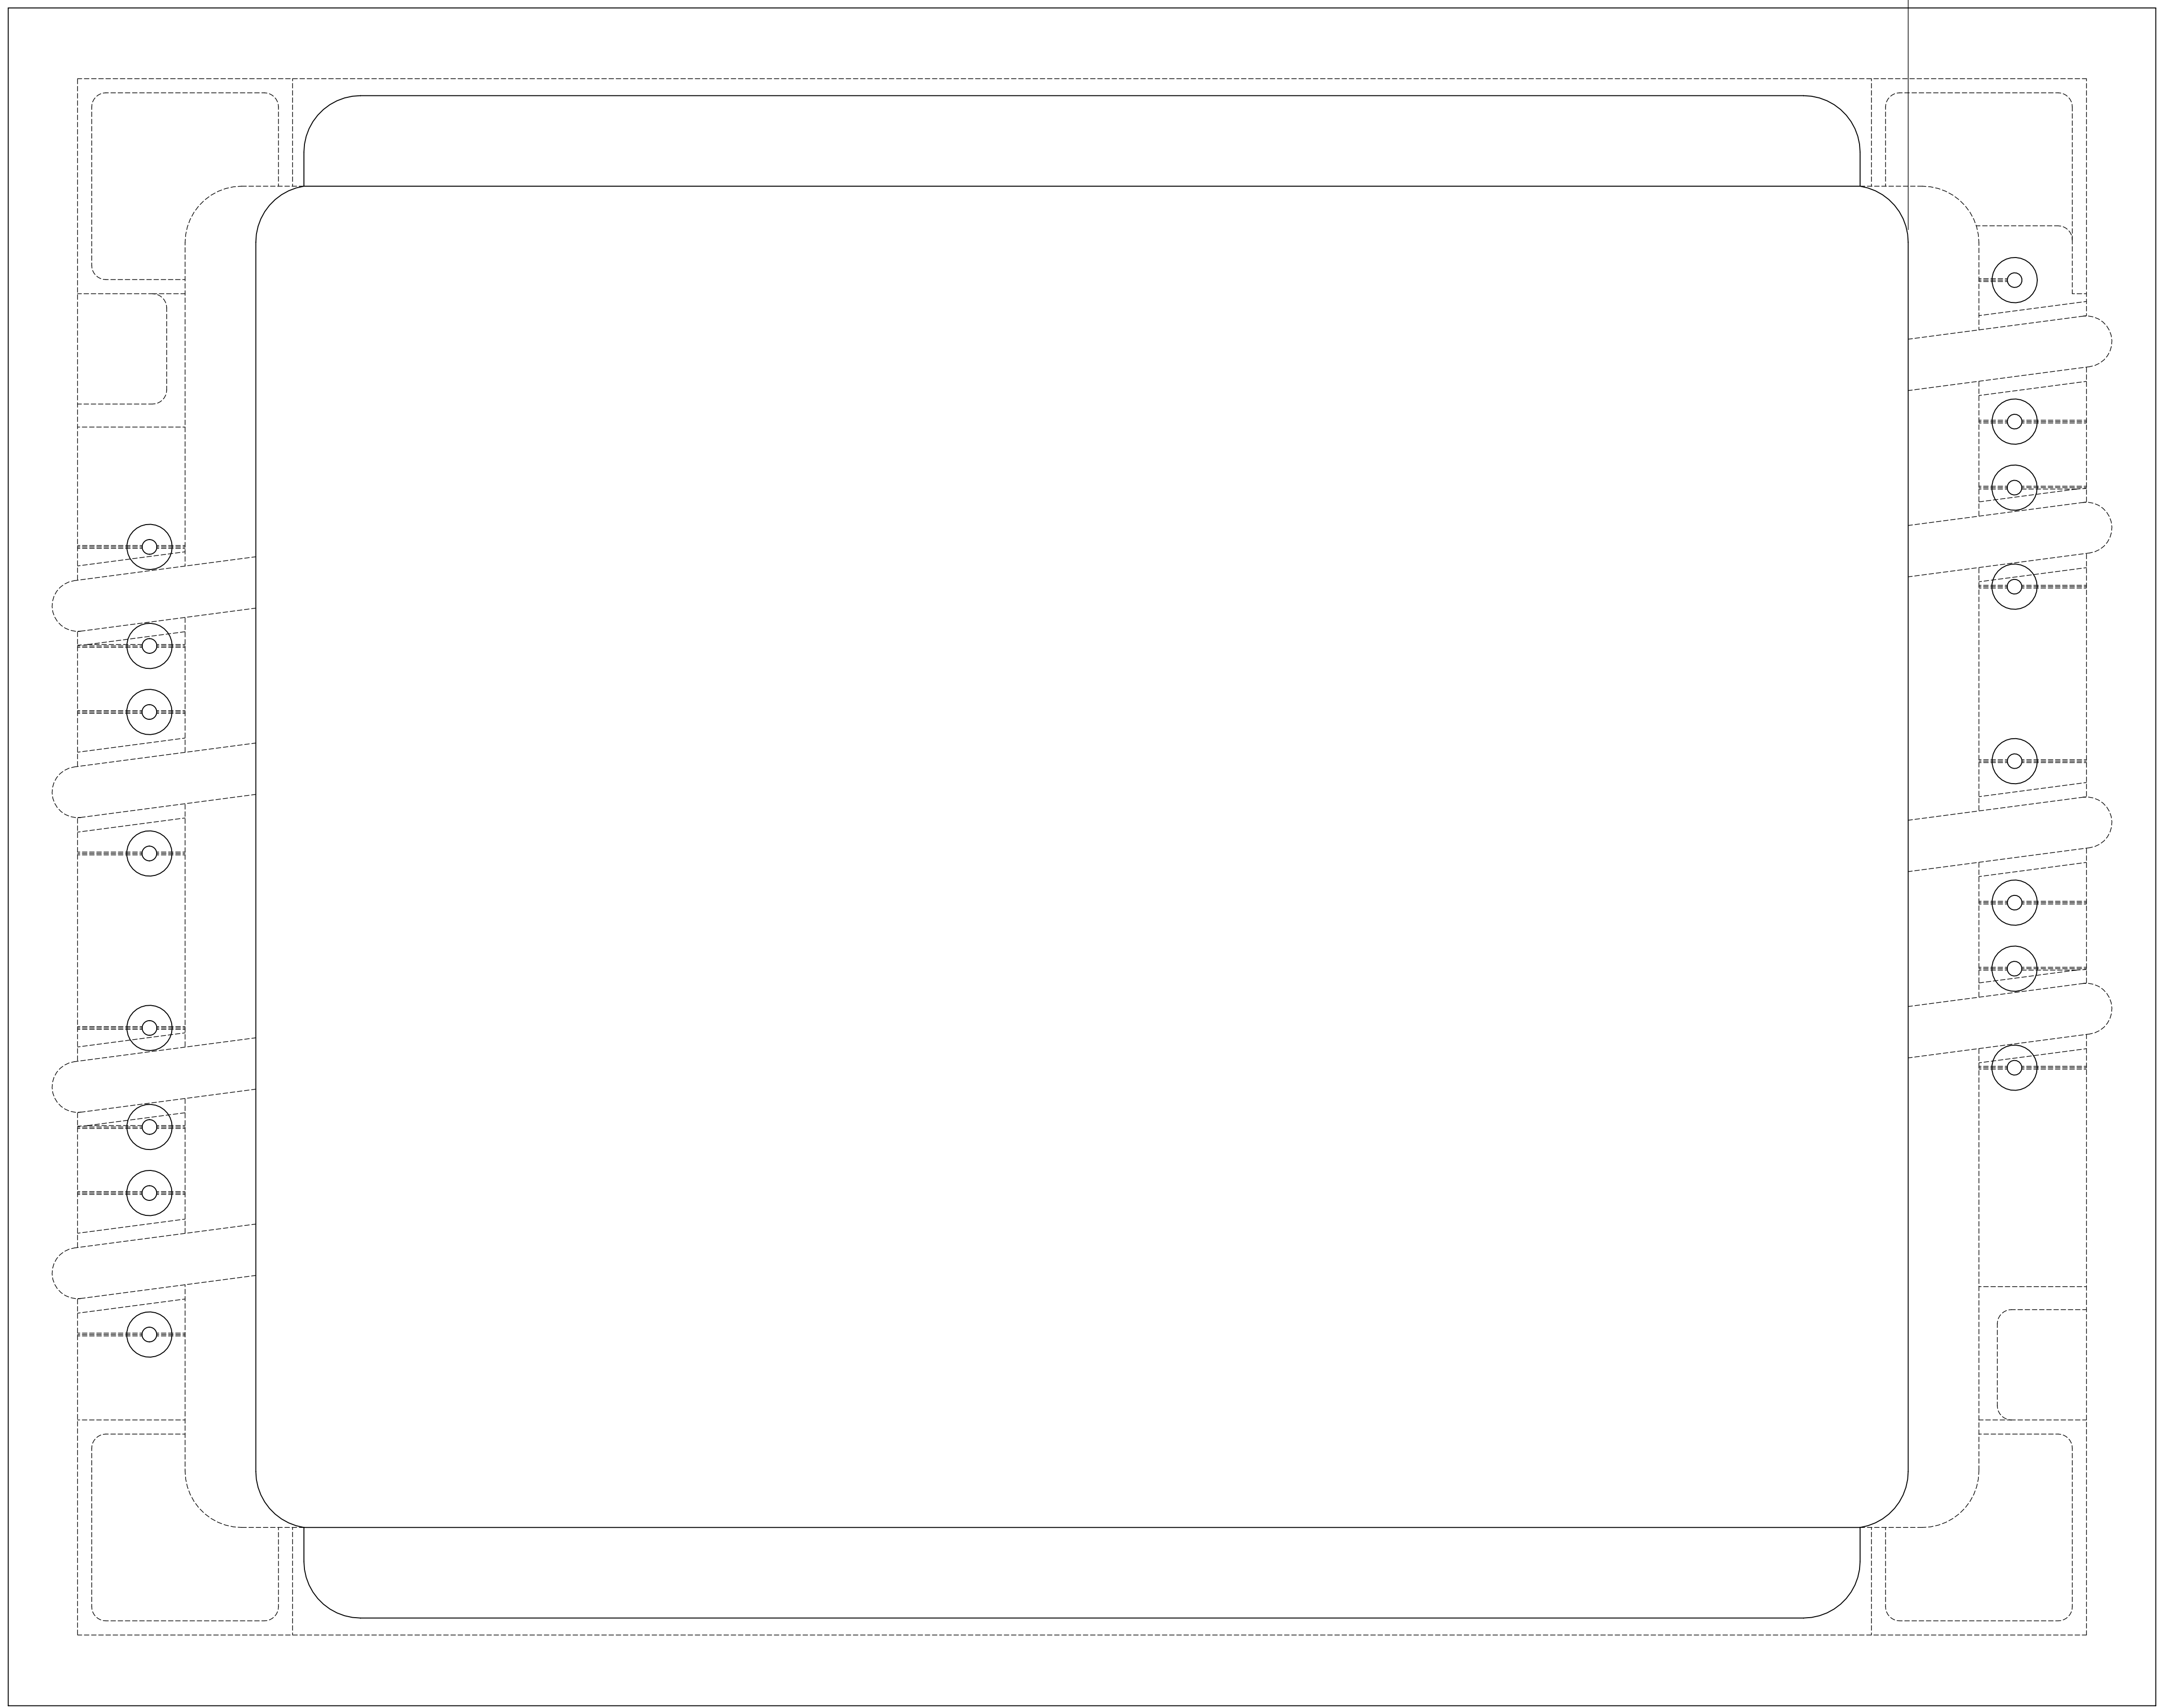

VIEW B-B

(2X 87.5)

H  
G  
F  
E  
D  
C  
B  
A

FOR REVISION ADD NOTED FEATURES

<b>LIGO</b> CALIFORNIA INSTITUTE OF TECHNOLOGY MASSACHUSETTS INSTITUTE OF TECHNOLOGY		REV.
SIZE	DWG. NO.	XX
<b>REVISIONS</b>		
SCALE: NONE	PROJECTION:	SHEET 2 OF 2

8 7 6 5 4 3 2 1

DSG093 Redline (v2) PART PDM REV-X-022 DRAWING PDM REV-X-003