
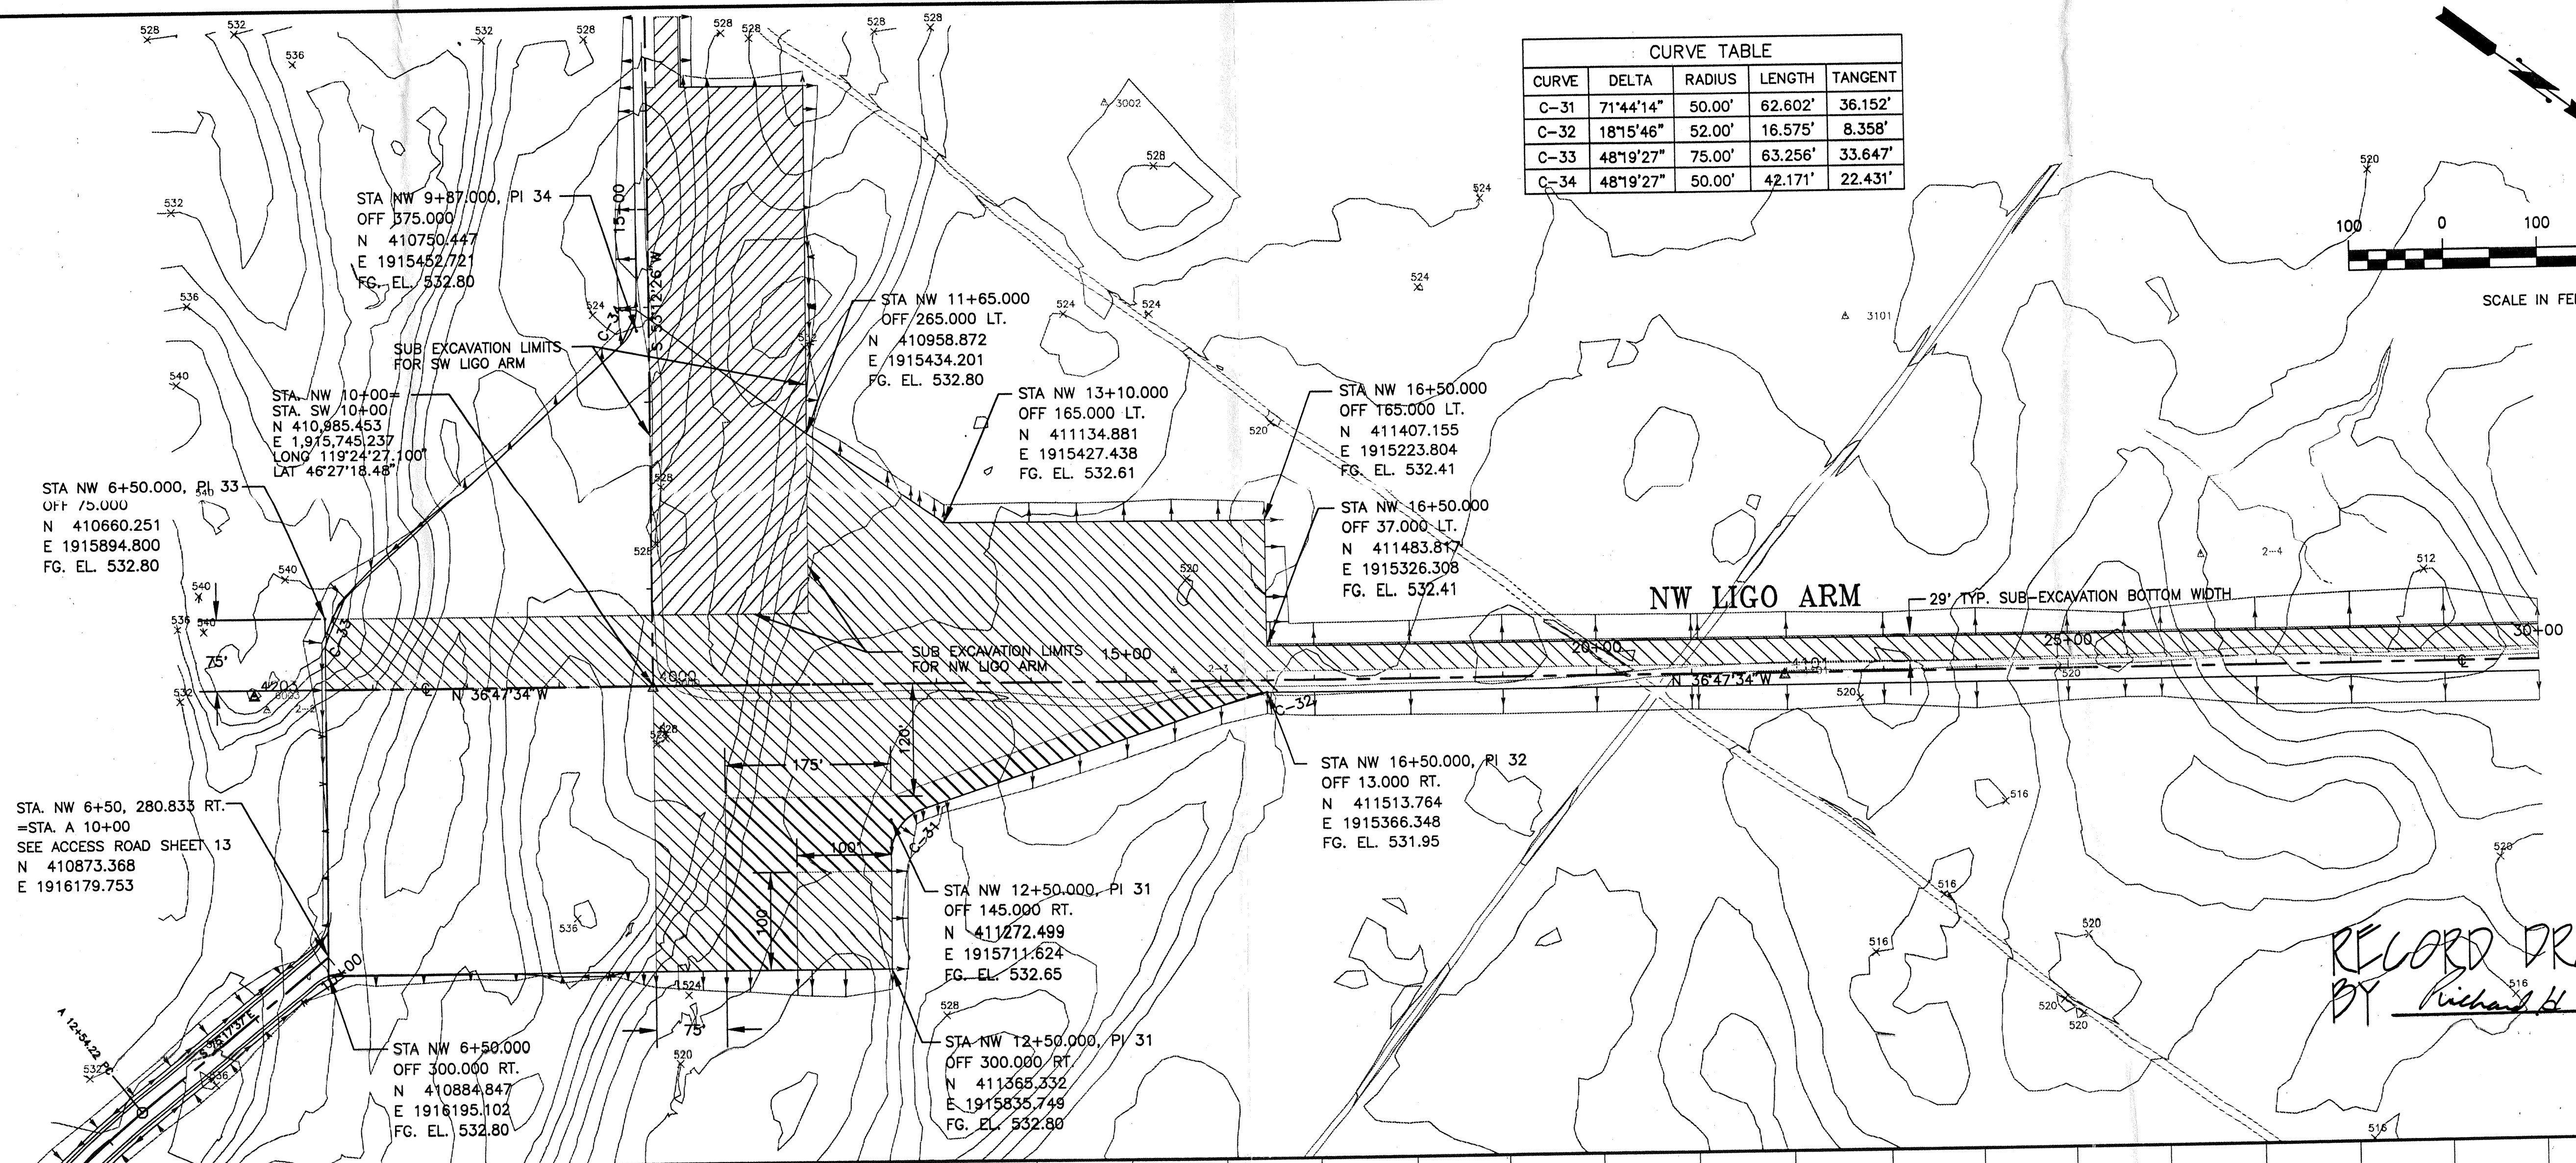




CURVE TABLE				
CURVE	DELTA	RADIUS	LENGTH	TANGENT
C-31	71°44'14"	50.00'	62.802'	36.152'
C-32	18°15'46"	52.00'	16.575'	8.358'
C-33	48°19'27"	75.00'	63.256'	33.647'
C-34	48°19'27"	50.00'	42.171'	22.431'

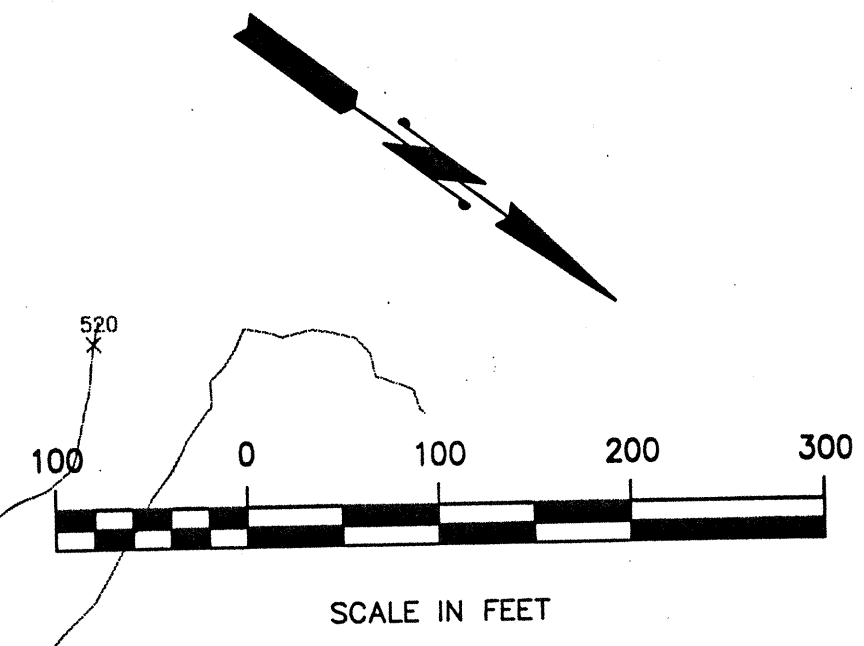

RECORD DRAWING 5-19-95
 BY Richard H. Dorr

MASS DIAGRAM

(QUANTITIES FOR INFORMATION ONLY)

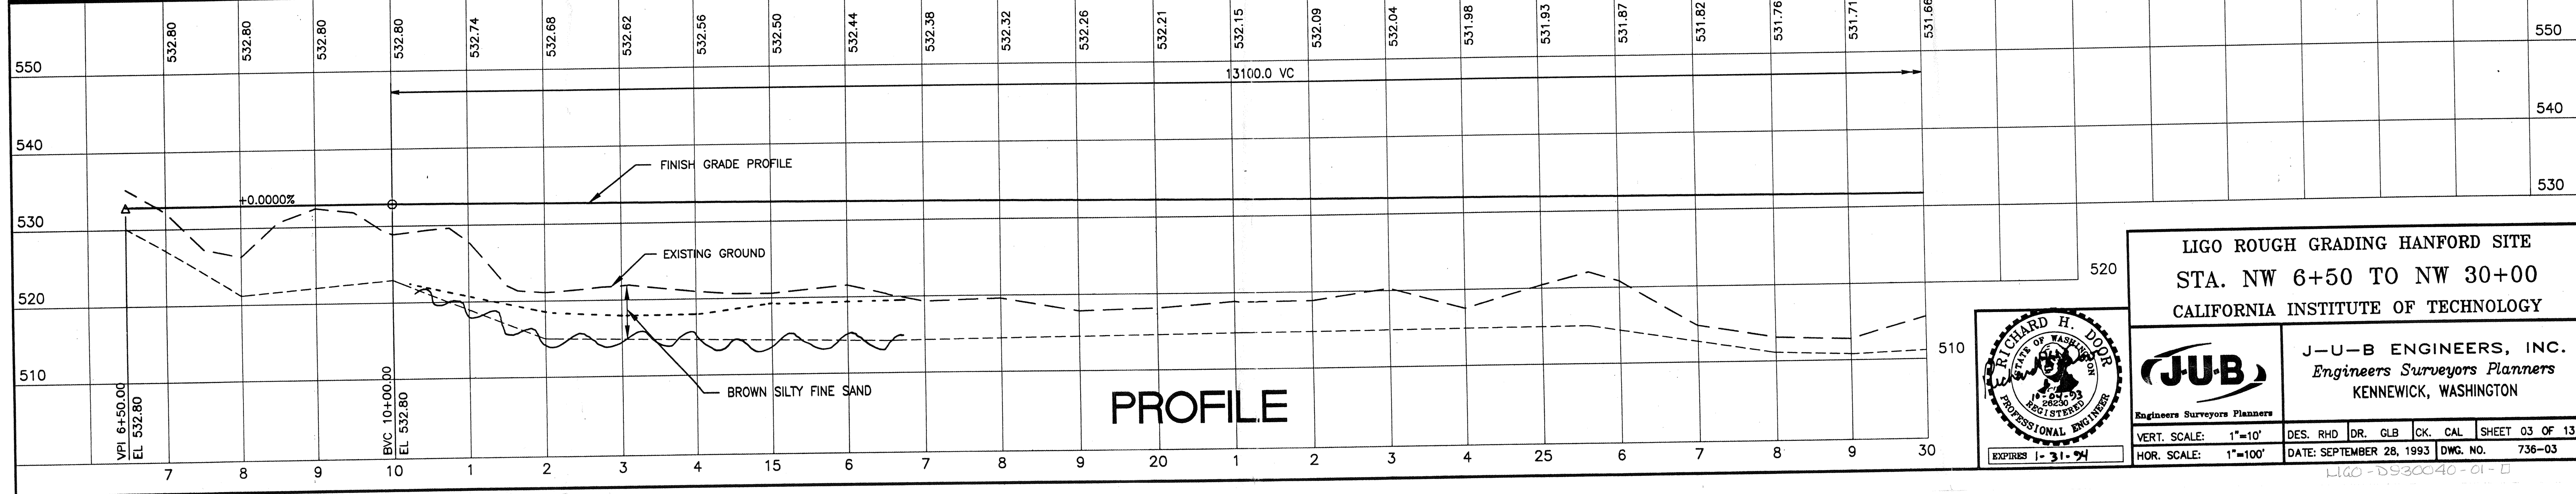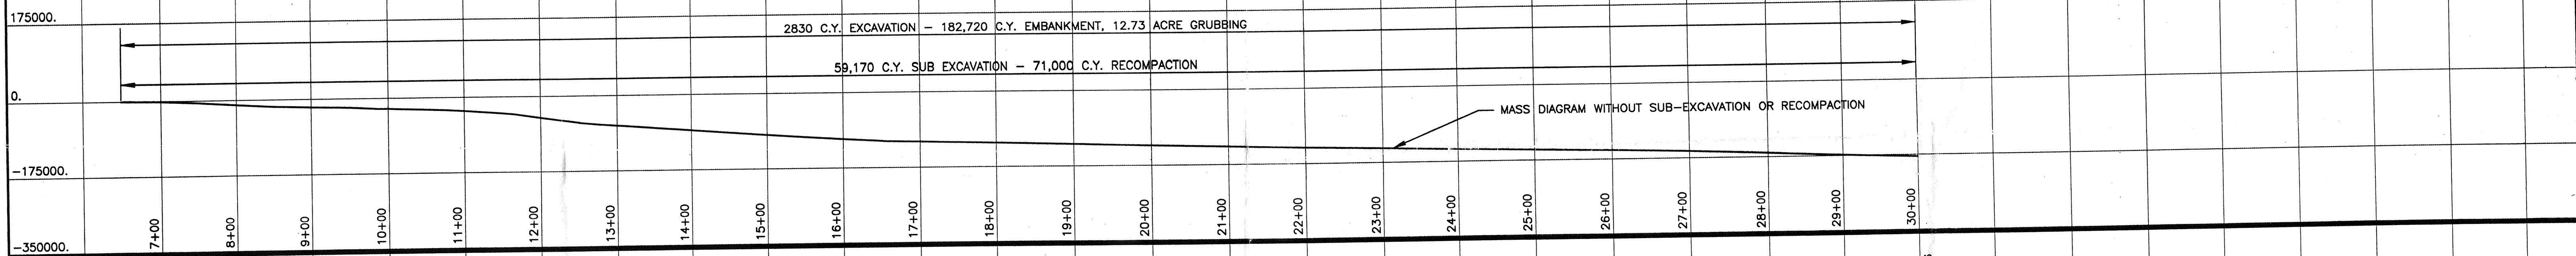

PROFILE

LIGO ROUGH GRADING HANFORD SITE
 STA. NW 6+50 TO NW 30+00
 CALIFORNIA INSTITUTE OF TECHNOLOGY

JUB ENGINEERS SURVEYORS PLANNERS
 KENNEWICK, WASHINGTON

DES. RHD DR. GLB CK. CAL SHEET 03 OF 13
 VERT. SCALE: 1"=10' DATE: SEPTEMBER 28, 1993 DWG. NO. 736-03
 HOR. SCALE: 1"=100'

EXPIRES 1-31-94

C:\12736\736-03 Fr1 Oct 1 19:43:12 1993

L160-5930040-01-D