
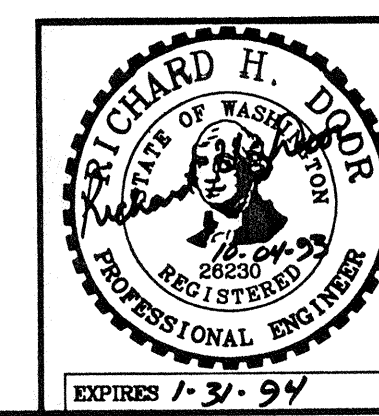


RECORD DRAWING 5.19.95
 BY *Richard H. Door*

MASS DIAGRAM

(QUANTITIES FOR INFORMATION ONLY)

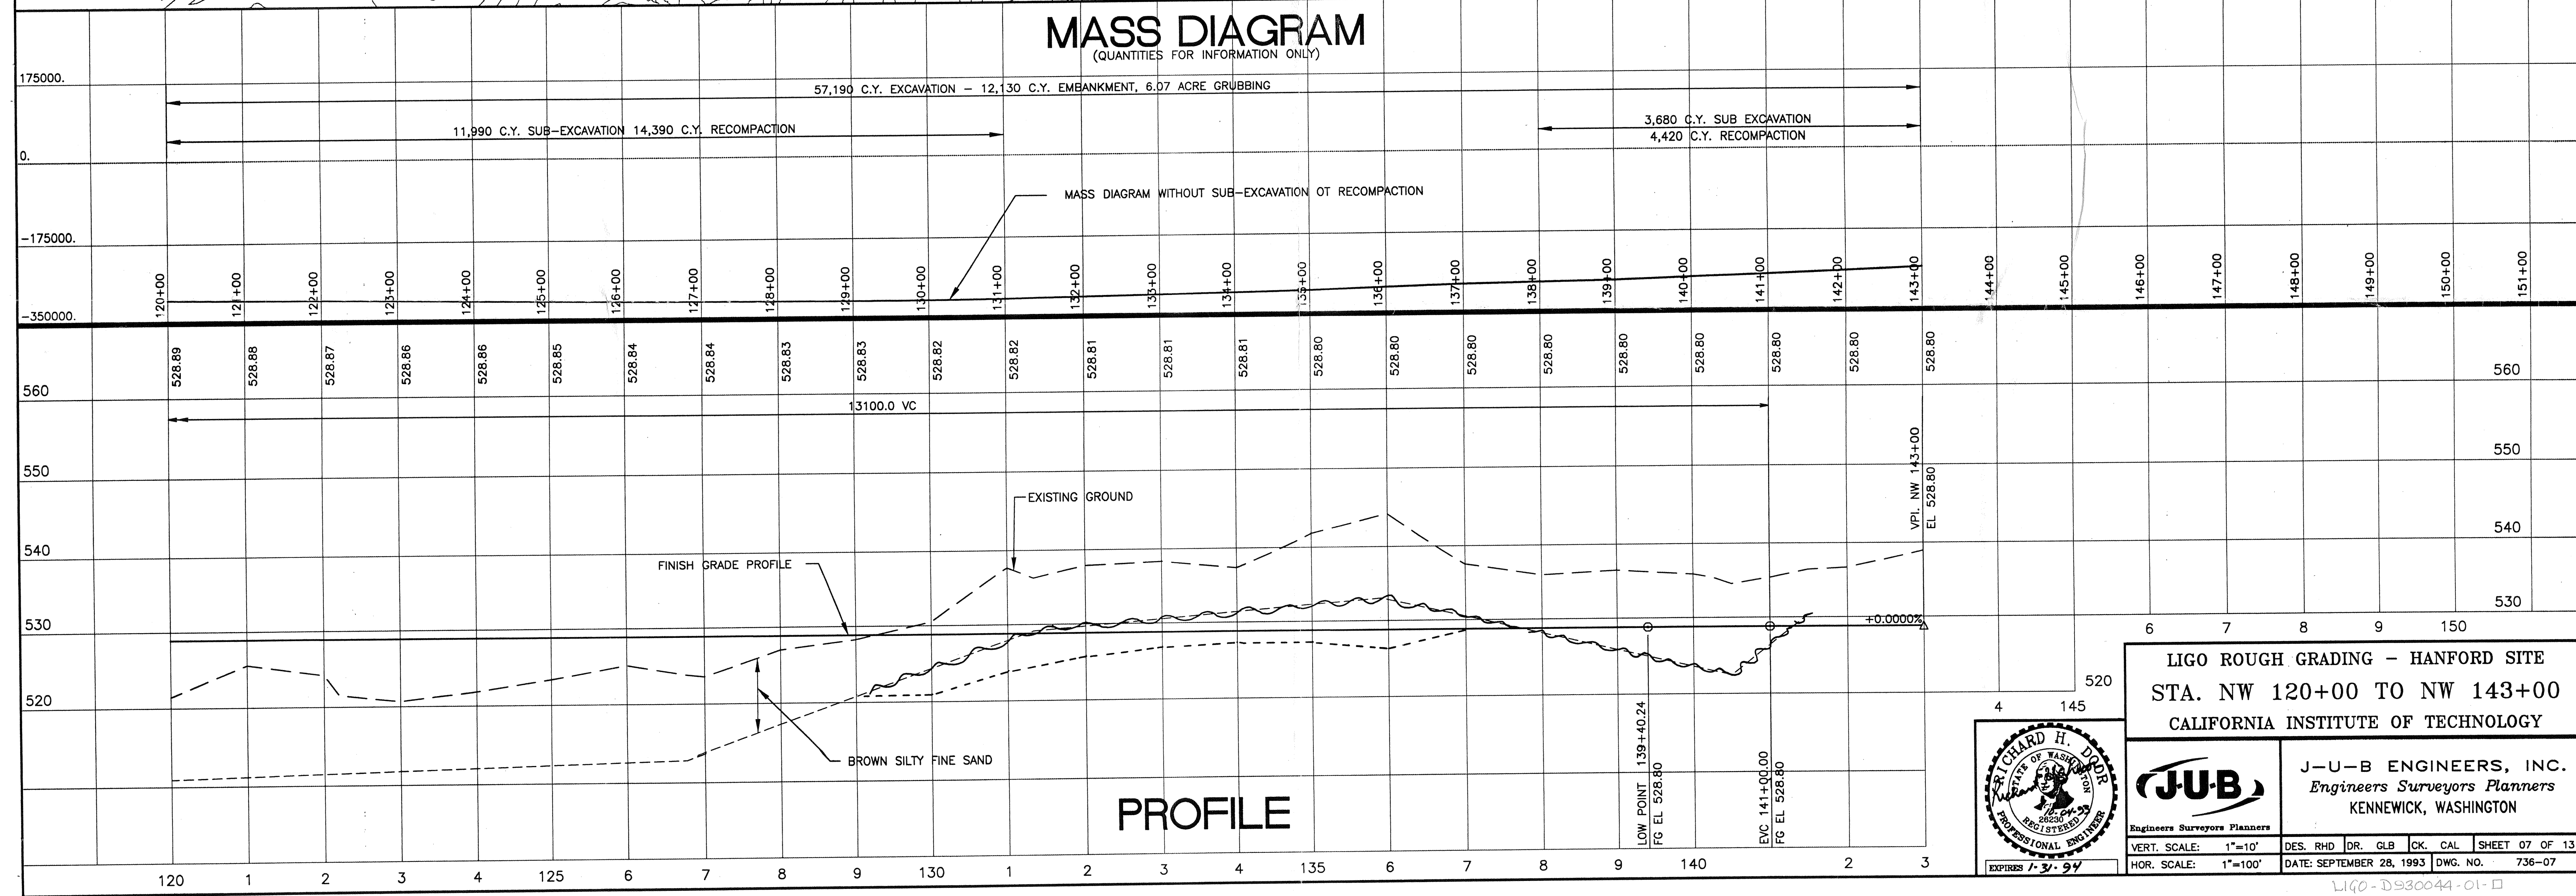

LIGO ROUGH GRADING - HANFORD SITE
 STA. NW 120+00 TO NW 143+00
 CALIFORNIA INSTITUTE OF TECHNOLOGY

JUB
 Engineers Surveyors Planners

J-U-B ENGINEERS, INC.
 Engineers Surveyors Planners
 KENNEWICK, WASHINGTON

VERT. SCALE: 1"=10'	DES. RHD	DR. GLB	CK. CAL	SHEET 07 OF 13
HOR. SCALE: 1"=100'	DATE: SEPTEMBER 28, 1993	DWG. NO.	736-07	

C:\1278\1278-07 Fri Oct 1 19:59:24 1993