




RECORD DRAWING 5.19.95
[Signature]

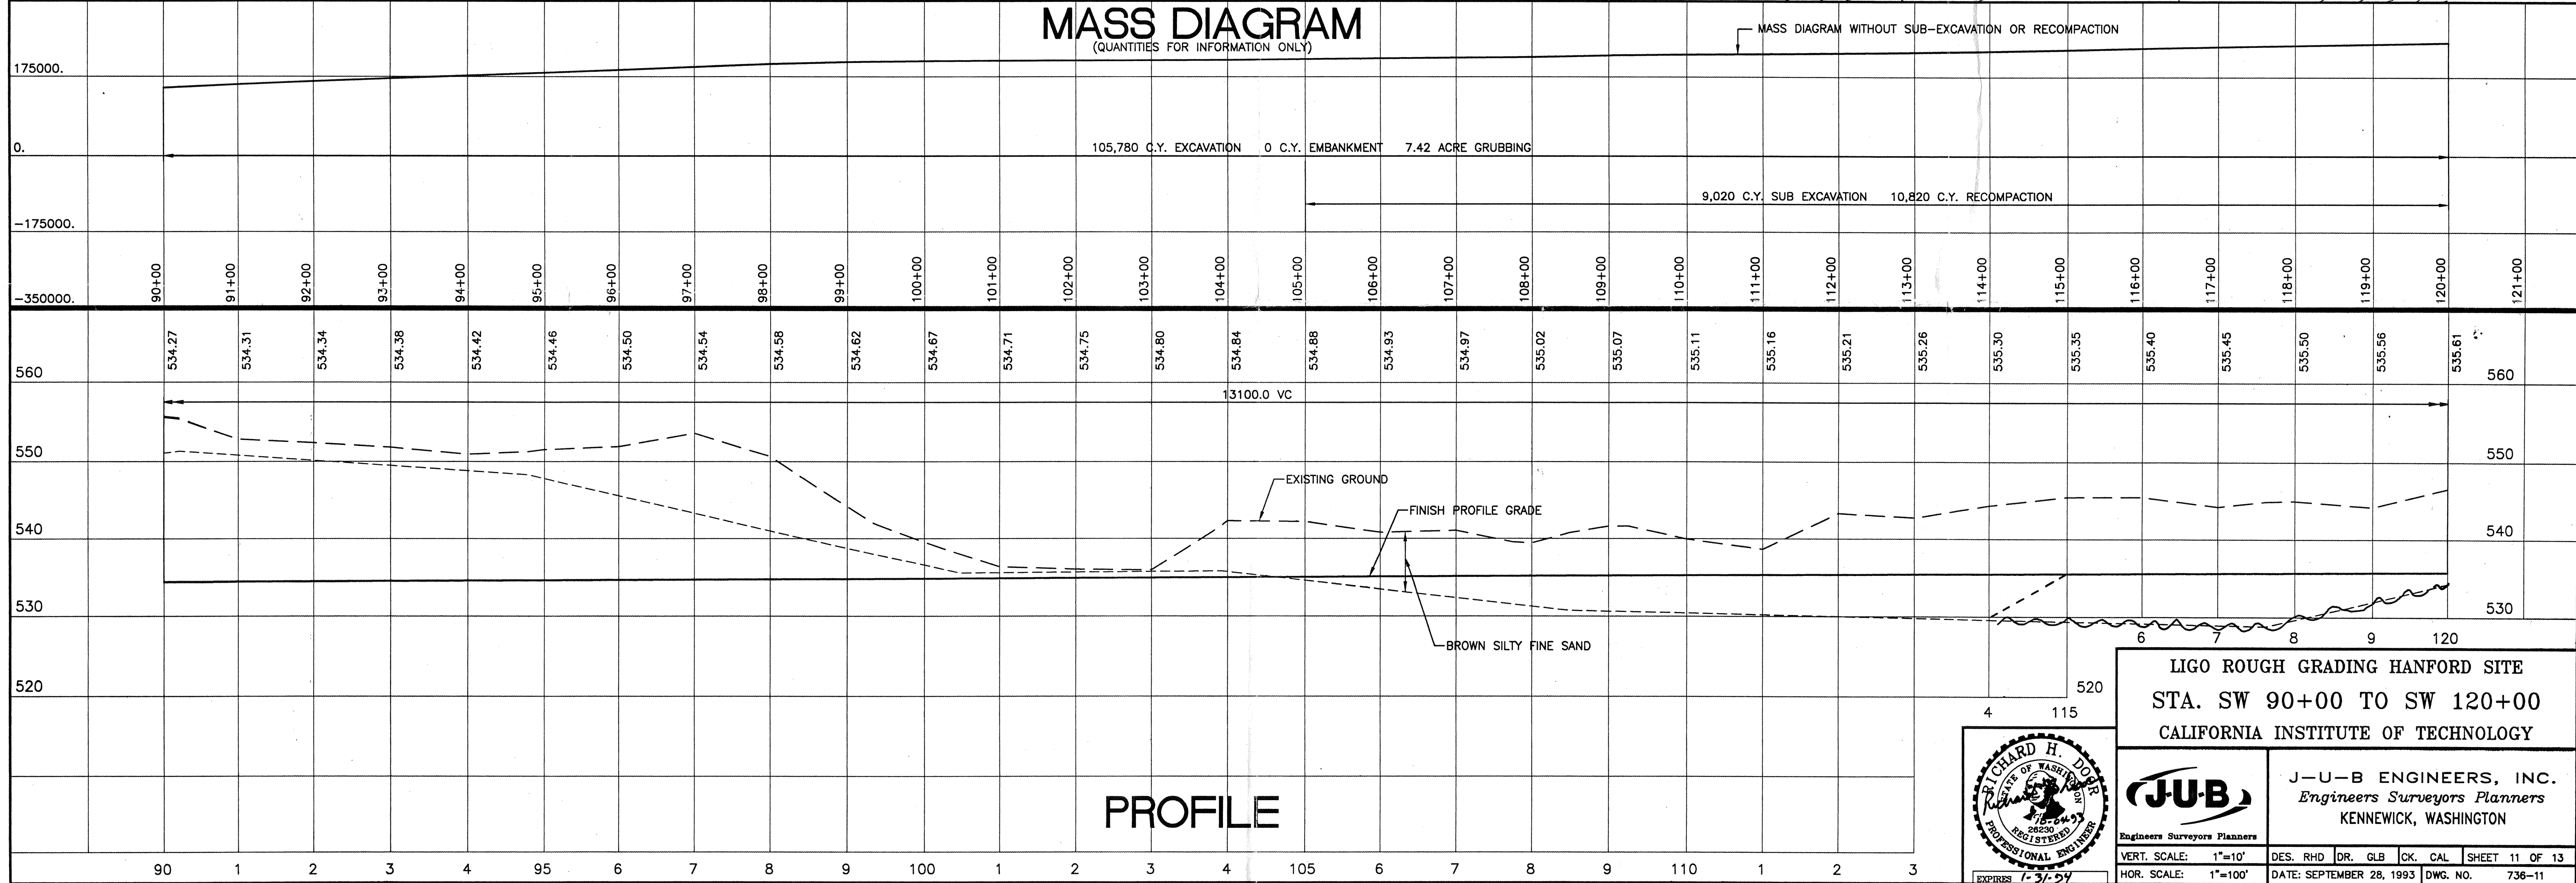

C:\12736\736-11 F1 Oct 1 2:14:05 1993

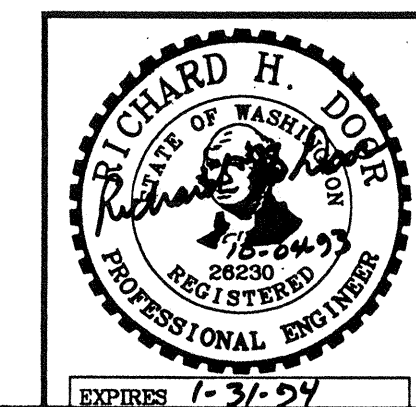

LIGO ROUGH GRADING HANFORD SITE
 STA. SW 90+00 TO SW 120+00
 CALIFORNIA INSTITUTE OF TECHNOLOGY



JUB
 Engineers Surveyors Planners

J-U-B ENGINEERS, INC.
 Engineers Surveyors Planners
 KENNEWICK, WASHINGTON

VERT. SCALE: 1"=10'	DES. RHD	DR. GLB	CK. CAL
HOR. SCALE: 1"=100'	DATE: SEPTEMBER 28, 1993		SHEET 11 OF 13
EXPIRES 1-31-97		DWG. NO. 736-11	

Ligo-3930048-a-b