

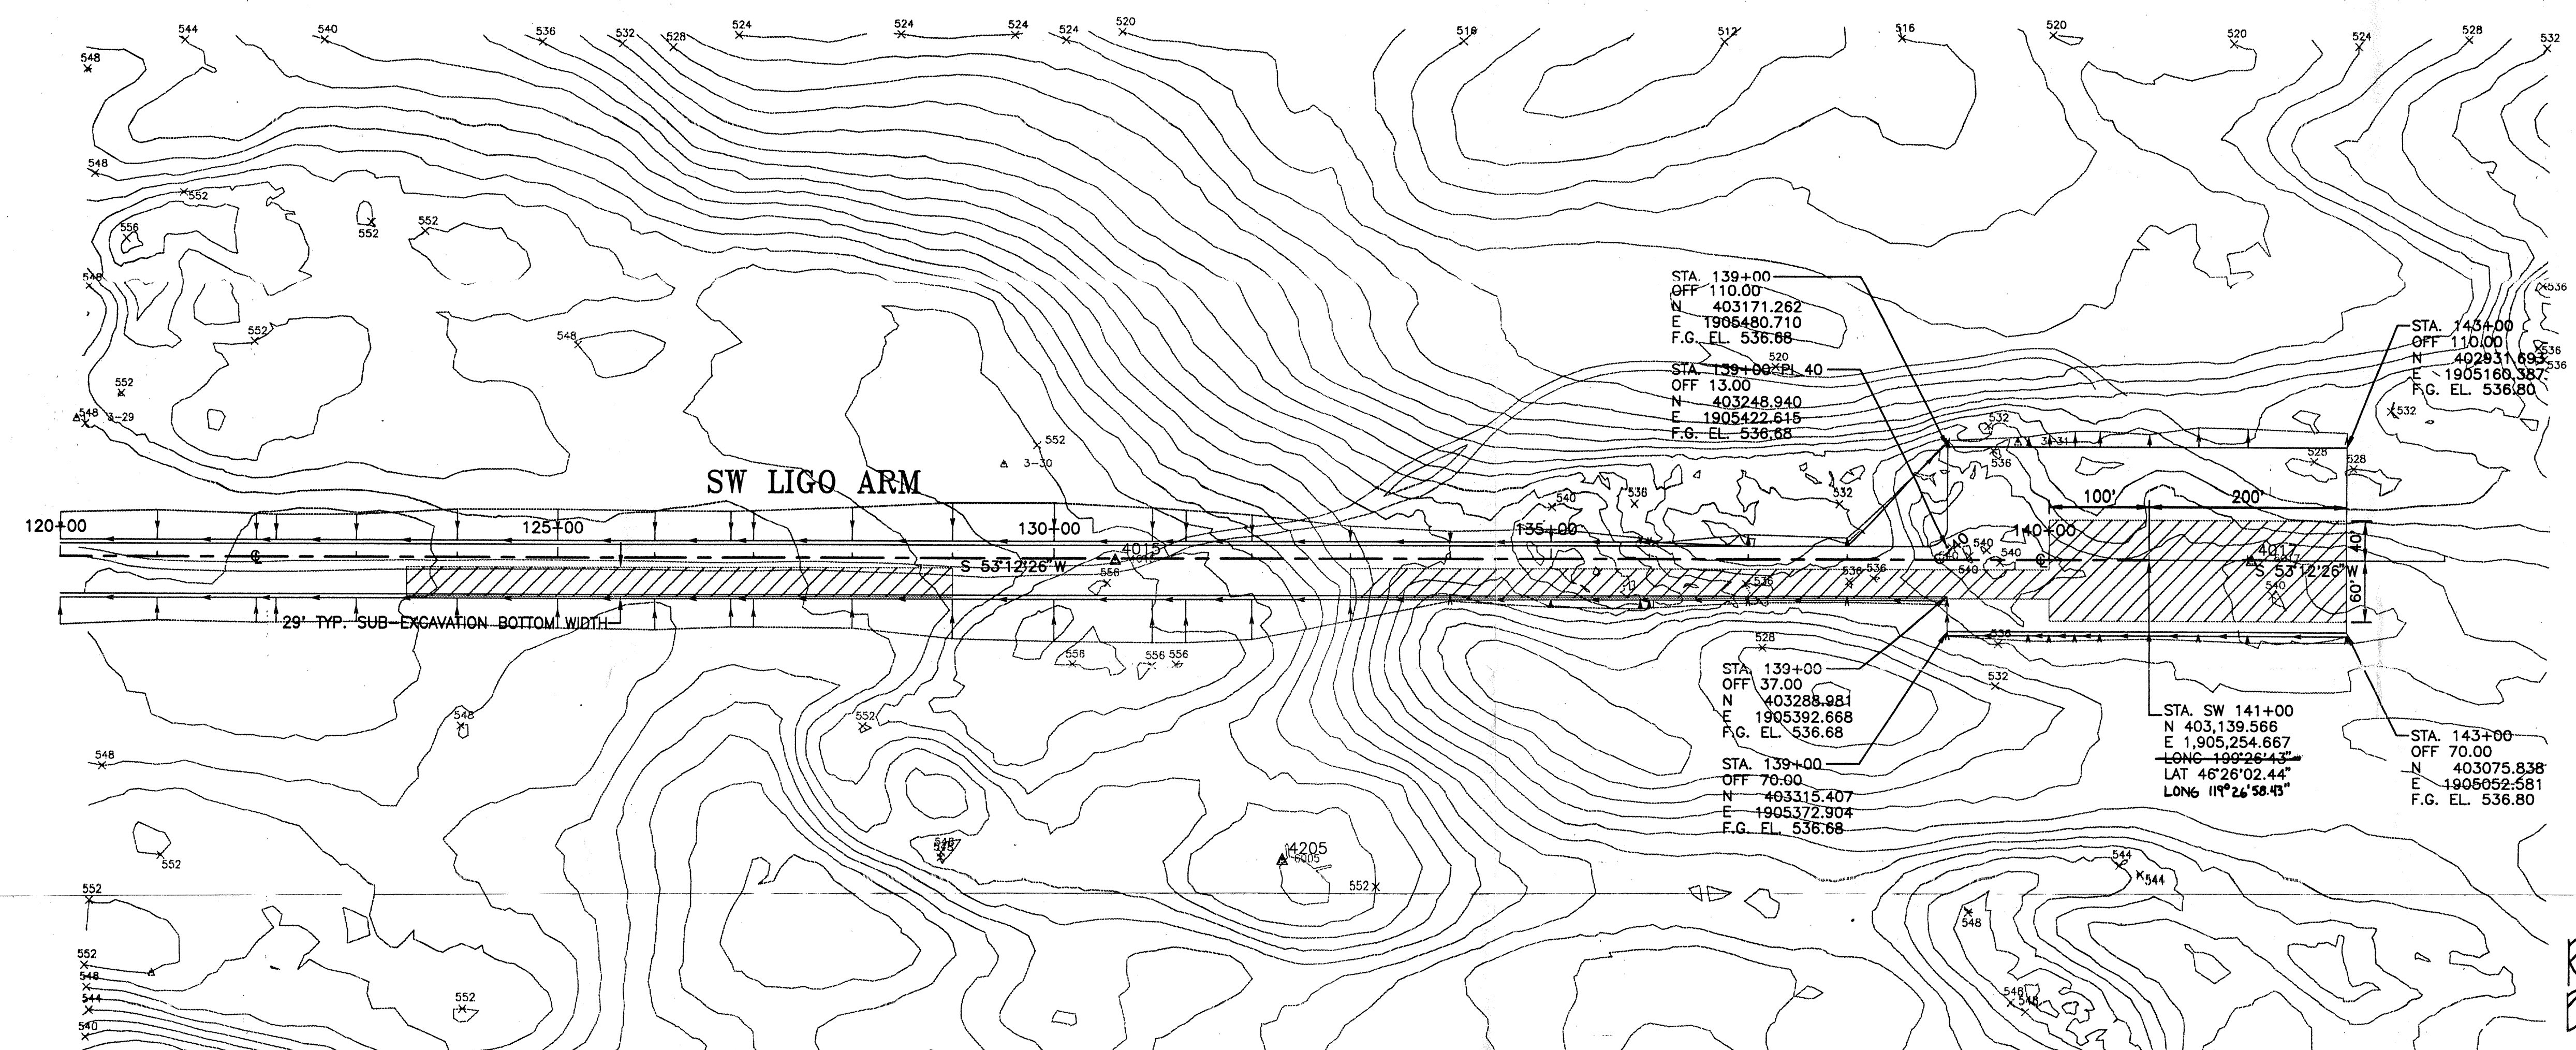


CURVE TABLE				
CURVE	DELTA	RADIUS	LENGTH	TANGENT
C-40	90°54'40"	20.00'	31.73'	20.32'

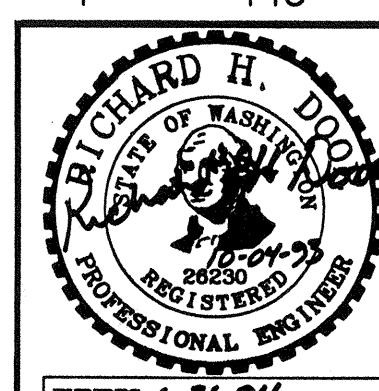

RECORD DRAWING 5-19-95  
BY Richard H. Dorn

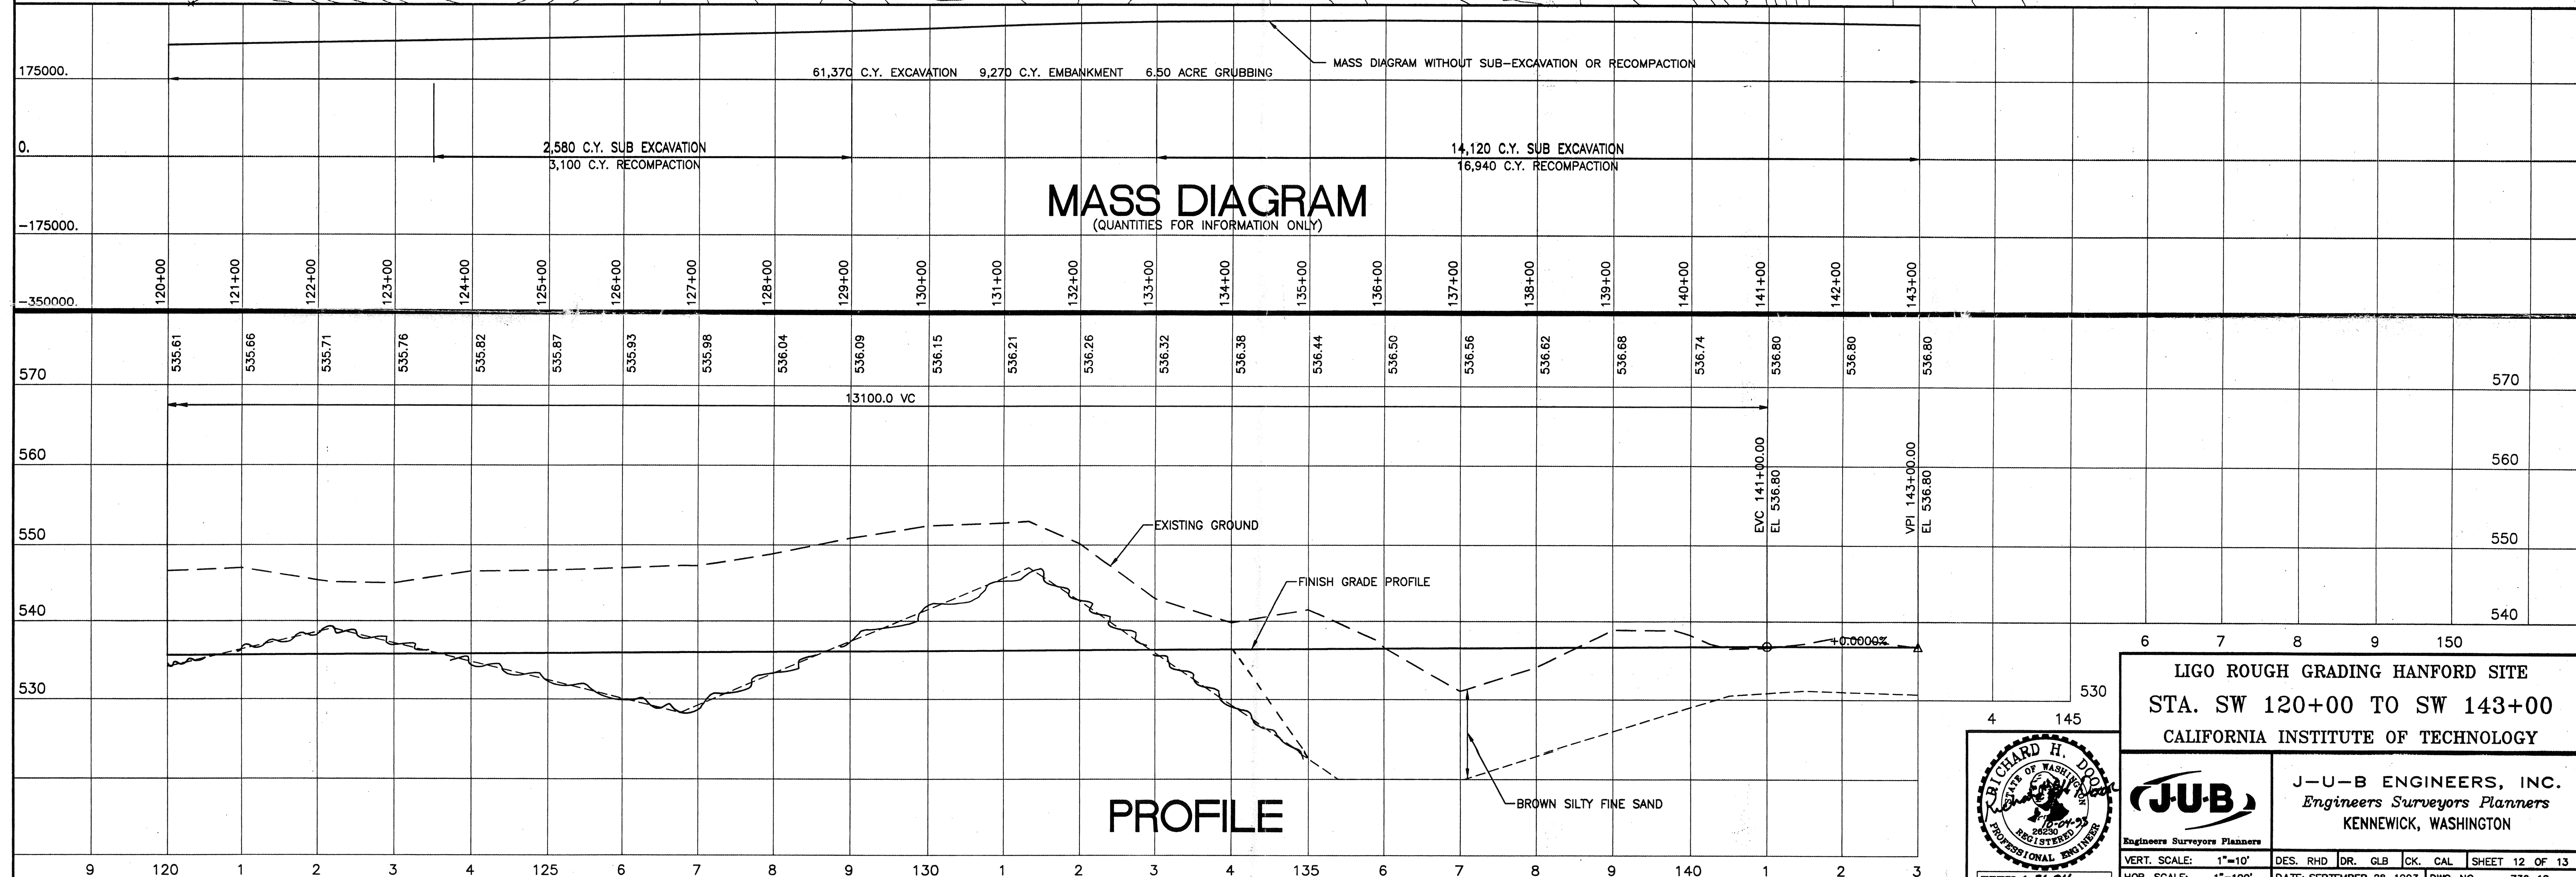

LIGO ROUGH GRADING HANFORD SITE  
STA. SW 120+00 TO SW 143+00  
CALIFORNIA INSTITUTE OF TECHNOLOGY

**JUB**  
Engineers Surveyors Planners  
KENNEWICK, WASHINGTON

J-U-B ENGINEERS, INC.  
Engineers Surveyors Planners  
KENNEWICK, WASHINGTON

DES. RHD DR. GLB CK. CAL SHEET 12 OF 13  
DATE: SEPTEMBER 28, 1993 DWG. NO. 736-12

C:\12736\736-12 Fr1 Oct 1 22:18:31 1993