

5

4


3

2

DATE: 01/21/99 TIME: 17:43:32  
DESIGN FILE: I:\ligo\site\lge\btg001.dwg

# LASER INTERFEROMETER GRAVITATIONAL-WAVE OBSERVATORY

## BEAM TUBE ENCLOSURE SITework AND PRECAST FABRICATION ISSUED FOR AS BUILT

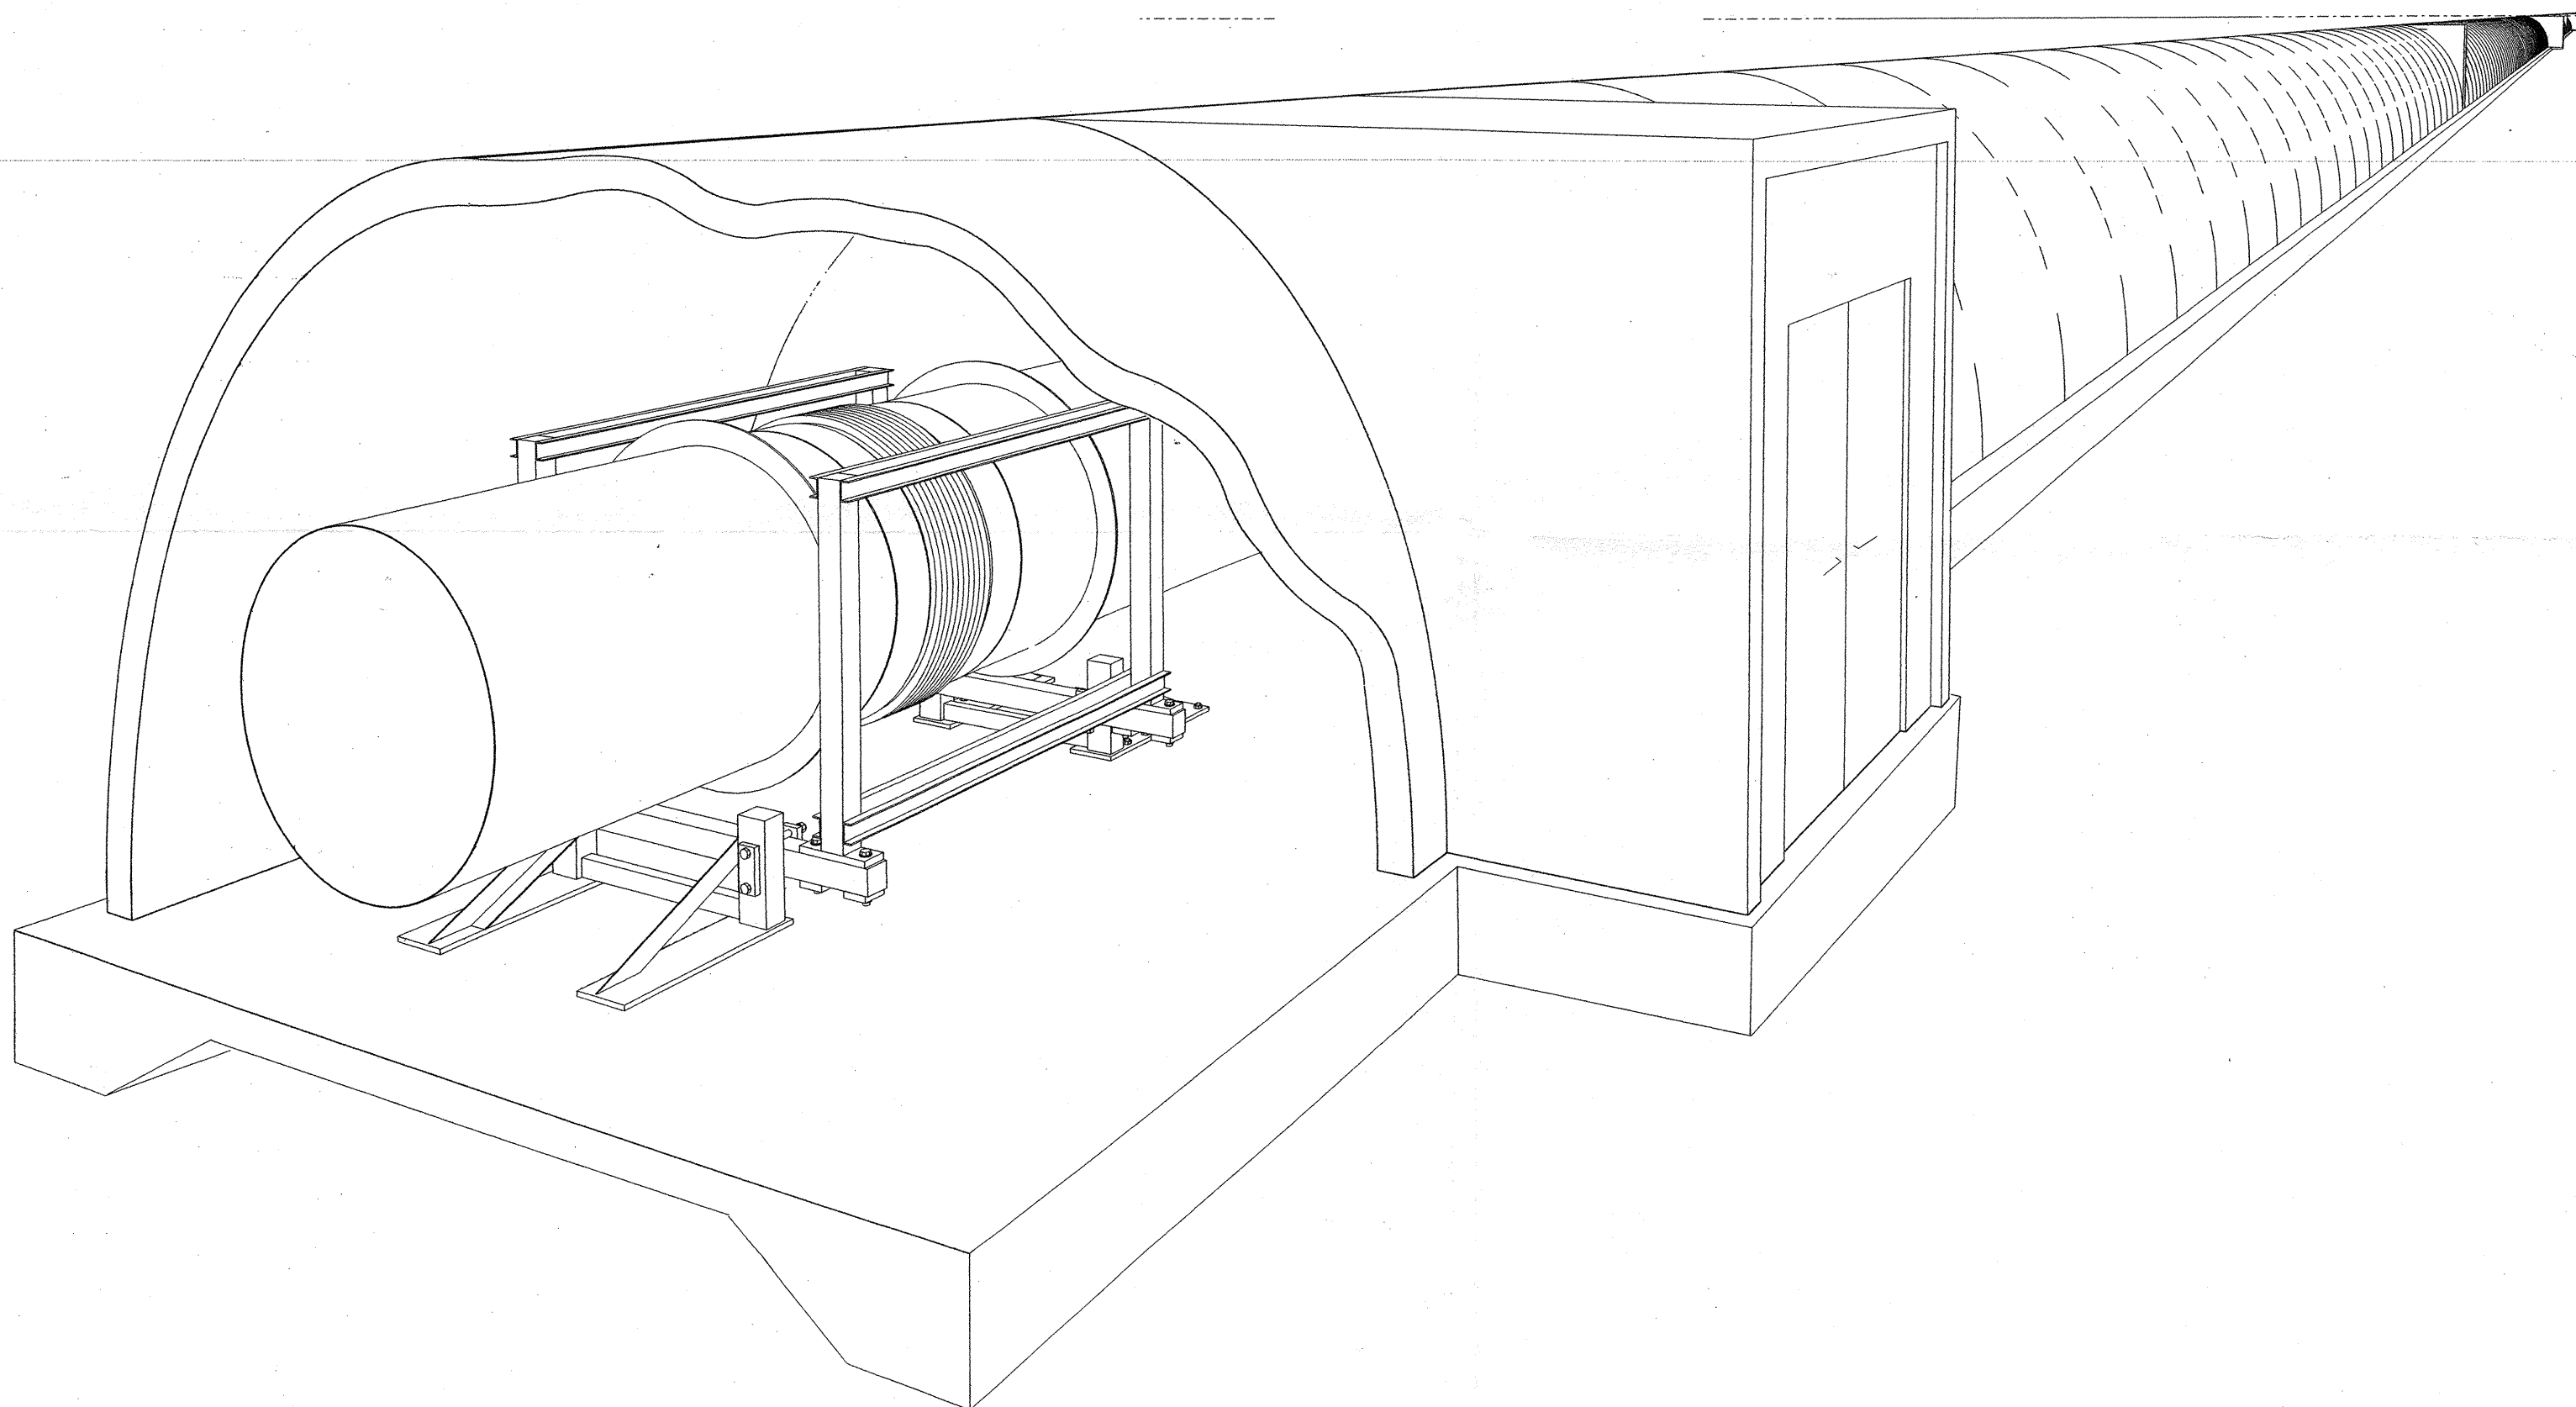

This document and the design it covers are the property of PARSONS. They are loaned only with the borrower's expressed written agreement that they will not be reproduced, copied, loaned, exhibited, or used in any other way, except by written consent from PARSONS to the borrower.

This document and the design it covers are the property of PARSONS. They are loaned only with the borrower's expressed written agreement that they will not be reproduced, copied, loaned, exhibited, or used in any other way, except by written consent from PARSONS to the borrower.

LIGO-D960160-01-0

DRAWING NO.	DESCRIPTION	NO.	DATE	BY	CHKD	ENGR	PROJ	DESCRIPTION
		1	1-22-99	MEI	--	--	MDW	ISSUED FOR AS BUILT

AS-BUILT  
DRAWINGS

ISSUED FOR CONSTRUCTION  
DRAWN: RGC 1-19-96  
CHECKED: RGC  
ENGINEER: MDW 1-19-96  
PROJ: MDW 1-19-96

**PARSONS**  
100 WEST WALNUT STREET  
PASADENA, CALIFORNIA

**LIGO**  
CALIFORNIA INSTITUTE OF TECHNOLOGY  
MASSACHUSETTS INSTITUTE OF TECHNOLOGY

LASER INTERFEROMETER  
GRAVITATIONAL-WAVE OBSERVATORY  
BTE SITEWORK & FABRICATION - HANFORD, WA

GENERAL COVER SHEET

SHEET NUMBER: NONE  
PROJECT NUMBER: PP150969  
8094  
BT-G-001

5

4

3

2

LIG08TF.BDR

E  
D  
C  
B  
A

Thu Jan 21 17:42:42 1999 C:\PLOT\GUESS\Y082.DWG 52865 K:\V3852\g081a.prf