



PROFILE
 SCALES: HORIZ: 1" = 50'
 VERT: 1" = 5'

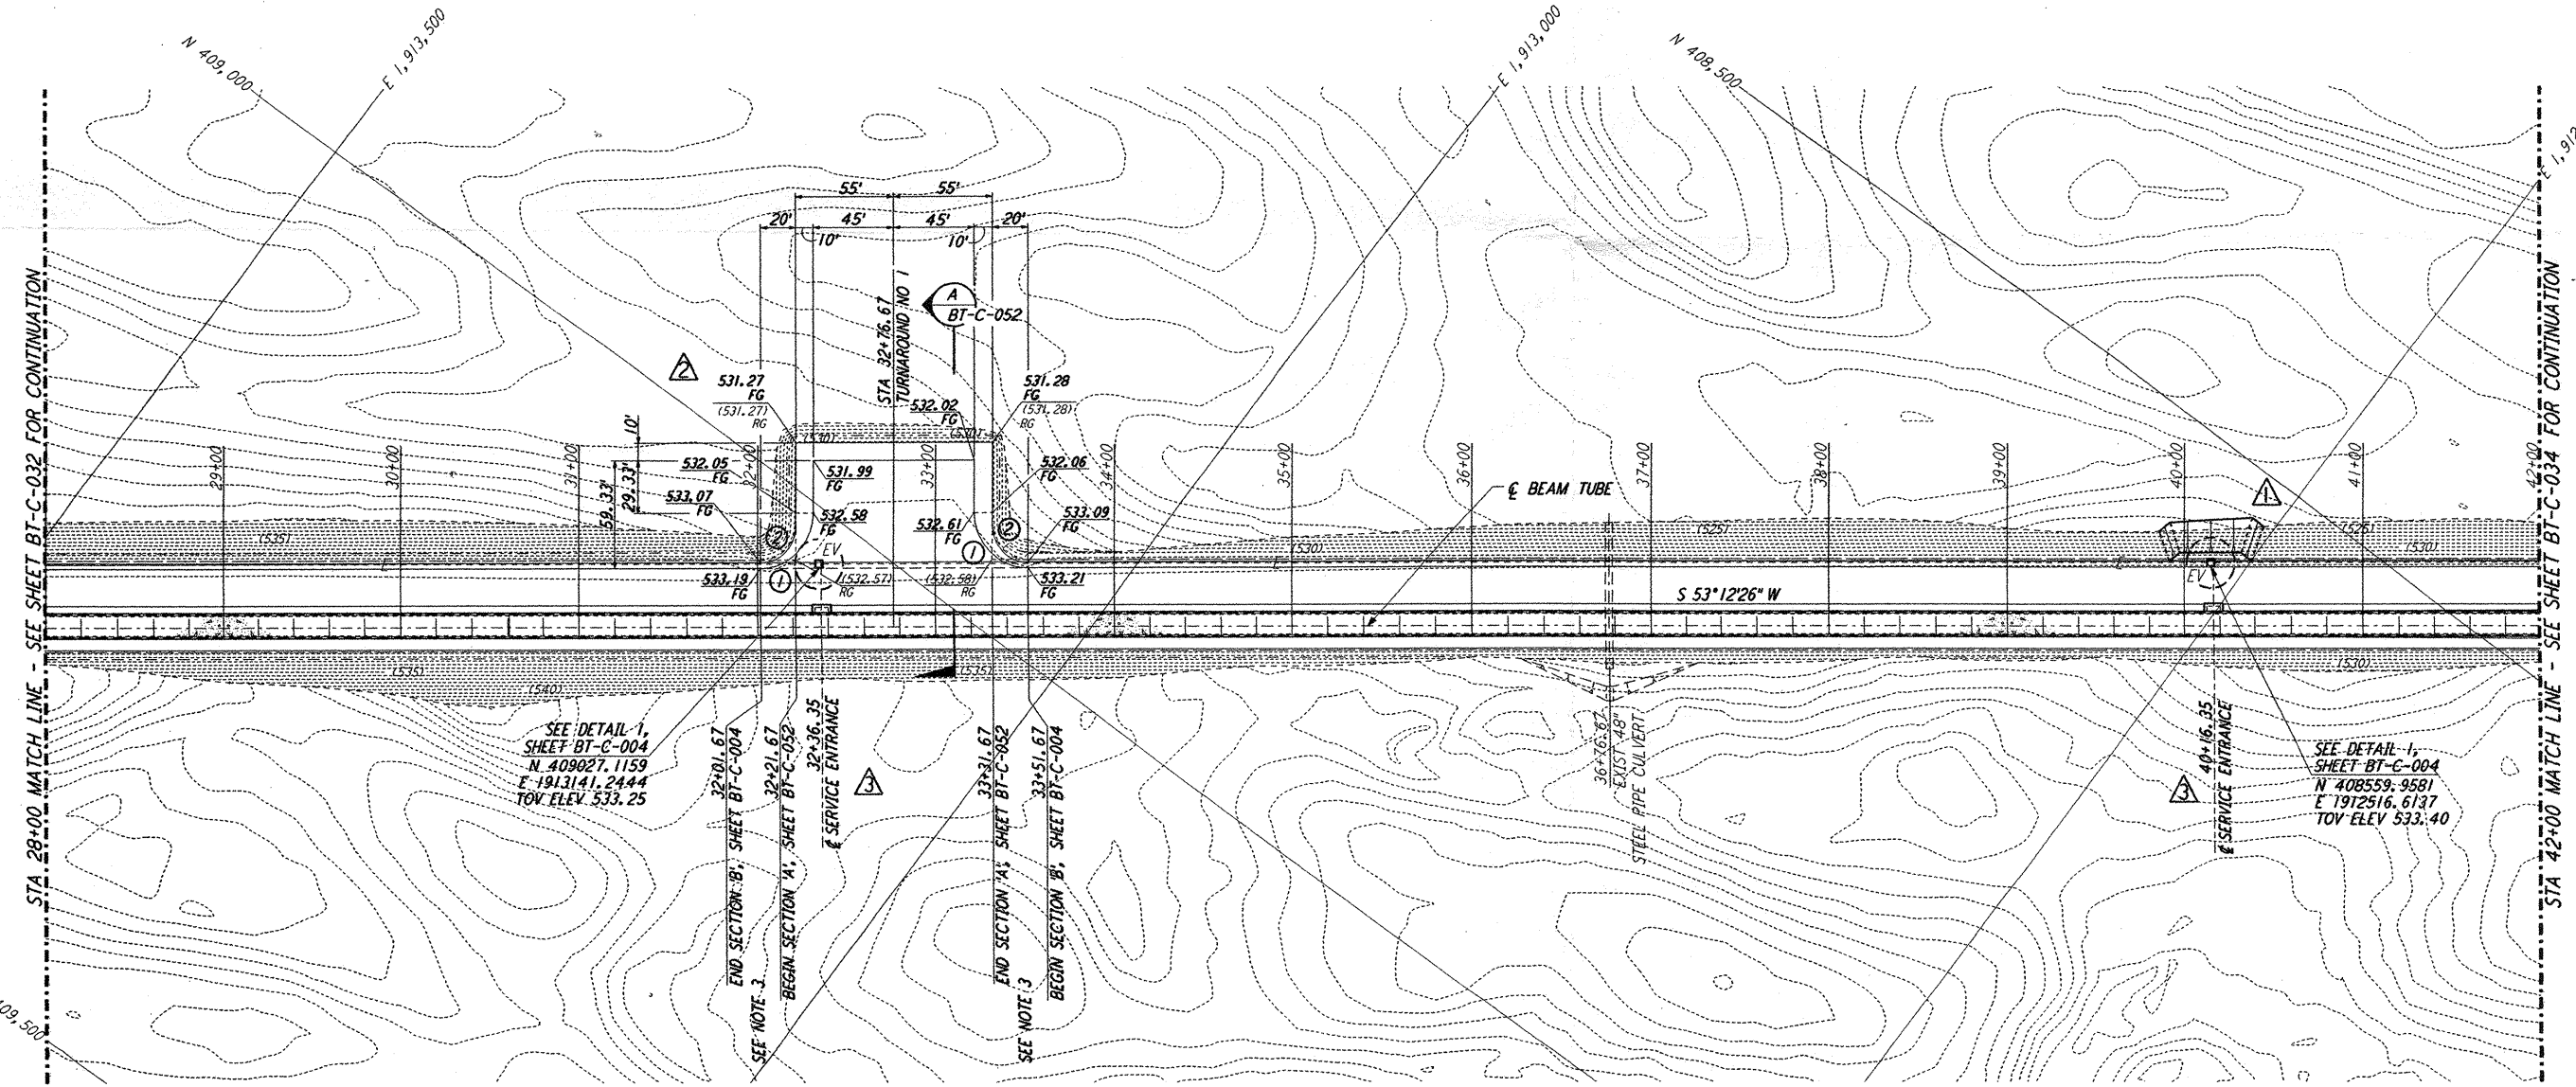


PLAN
 SCALE: 1" = 50'

- NOTES:**
1. SEE SHEET BT-C-002 FOR GENERAL NOTES, LEGEND AND ABBREVIATIONS.
 2. SEE SHEET BT-C-004 FOR TYPICAL SECTIONS AND DETAILS.
 3. TRANSITION BETWEEN SECTIONS, AS SHOWN ON PLAN.

CURVE DATA				
Δ	RADIUS	LENGTH	TANGENT	
1	90°00'00"	30'	47.12'	30.00'
2	90°00'00"	20'	31.42'	20.00'

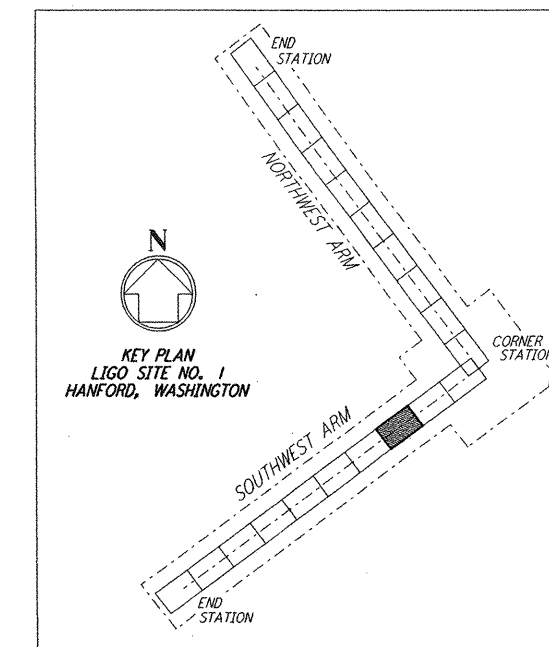

LIGO-D960178-04-O

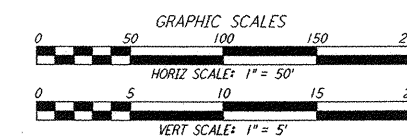

This document and the design it covers are the property of PARSONS. They are loaned only with the borrower's expressed written agreement that they will not be reproduced, copied, loaned, exhibited, or used in any other way, except by written consent from PARSONS to the borrower.

NO.	DATE	BY	CHKD	ENGR	PROJ	DESCRIPTION
4	1-22-99	MEI	--	--	MDW	ISSUED FOR AS-BUILT
3	5-10-96	WRB	TDW	JB	MDW	REVISED BEAM TUBE SERVICE ENTRANCES
2	4-19-96	WRB	TDW	JB	MDW	CHANGE ORDER NO. 4
1	2-29-96	WRB	TDW	JB	MDW	CHANGE ORDER NO. 2

ISSUED FOR CONSTRUCTION
 DRAWN: WRB 1-19-96
 CHECKED: MP 1-19-96
 ENGINEER: JB 1-19-96
 PROJ: MDW 1-19-96

AS-BUILT DRAWINGS



100 WEST WALNUT STREET
 PASADENA, CALIFORNIA



CALIFORNIA INSTITUTE OF TECHNOLOGY
 MASSACHUSETTS INSTITUTE OF TECHNOLOGY

LASER INTERFEROMETER
 GRAVITATIONAL-WAVE OBSERVATORY
 BTE SITWORK & FABRICATION - HANFORD, WA

TITLE: CIVIL SOUTHWEST ARM PLAN AND PROFILE STA 28+00 TO STA 42+00	SCALE: AS NOTED	CONTRACT NUMBER: PP150969	PROJECT NUMBER: 8094
SHEET NUMBER: BT-C-033		REVISIONS: 4	