


This document and the design it covers are the property of PARSONS. They are loaned only with the borrower's expressed written agreement that they will not be reproduced, copied, loaned, exhibited, or used in any other way, except by written consent from PARSONS to the borrower.


This document and the design it covers are the property of PARSONS. They are loaned only with the borrower's expressed written agreement that they will not be reproduced, copied, loaned, exhibited, or used in any other way, except by written consent from PARSONS to the borrower.

NOTES:

- 1. SEE SHEET BT-C-002 FOR GENERAL NOTES, LEGEND AND ABBREVIATIONS.
- 2. SEE SHEET BT-C-004 FOR TYPICAL SECTIONS AND DETAILS.
- 3. TRANSITION BETWEEN SECTIONS, AS SHOWN ON PLAN.

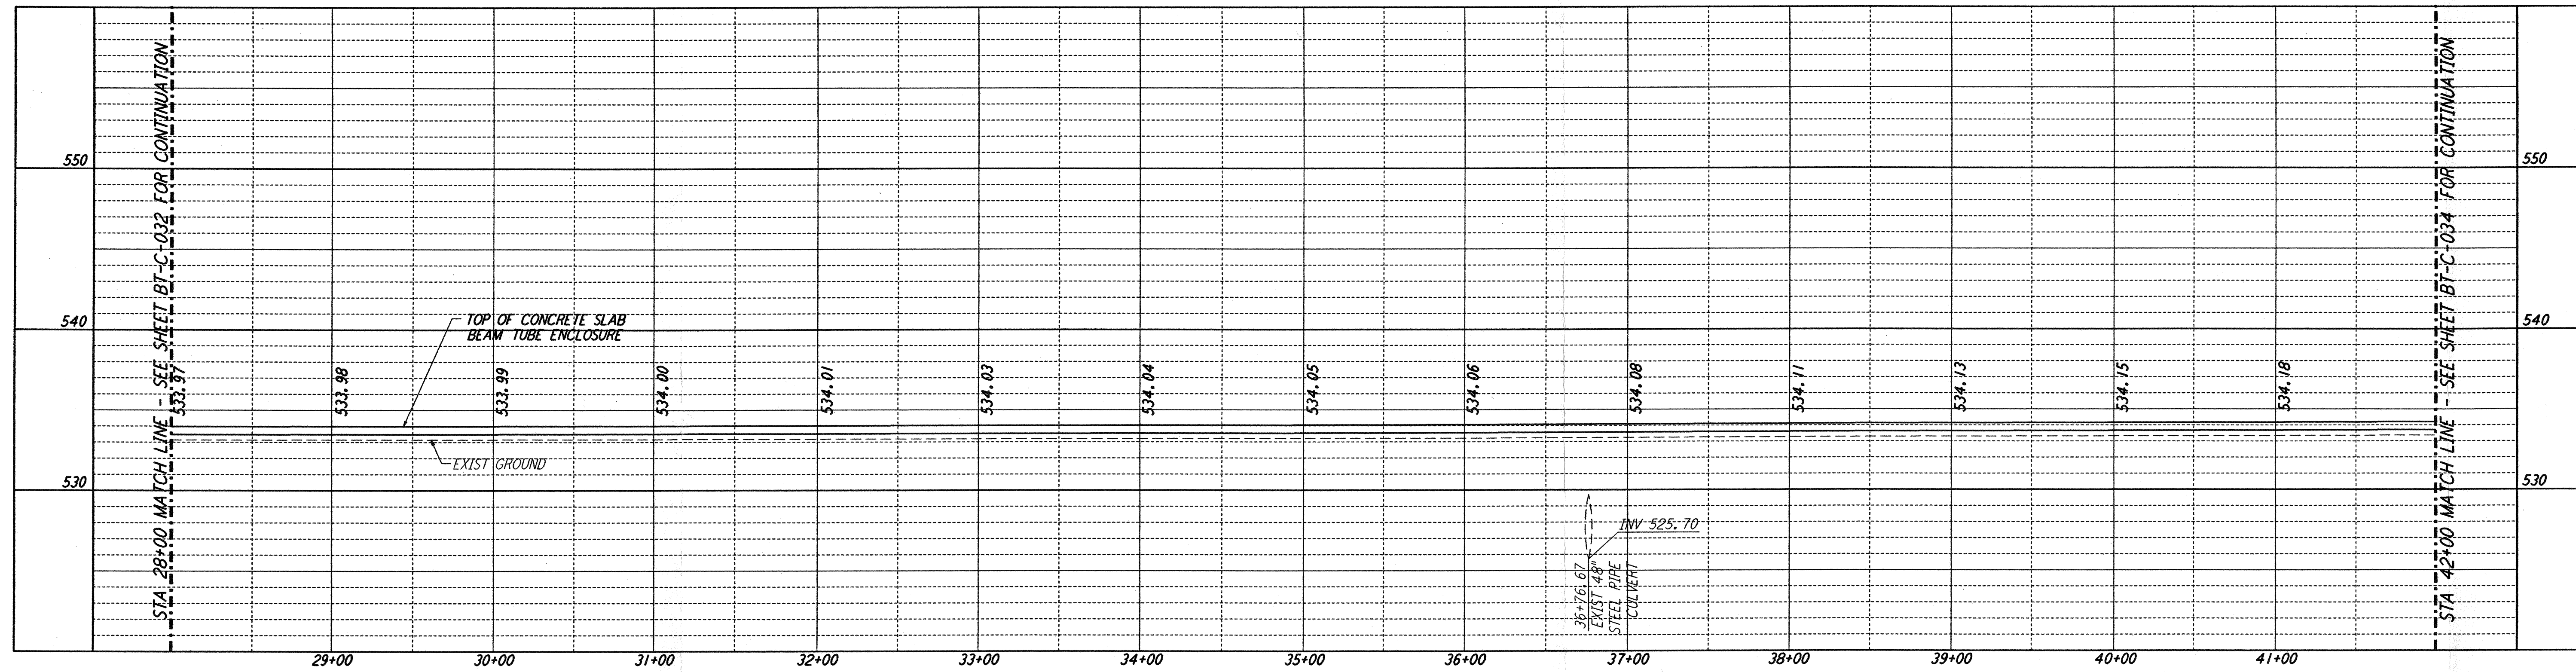


PROFILE  
SCALE: HORIZ: 1" = 50'  
VERT: 1" = 5'

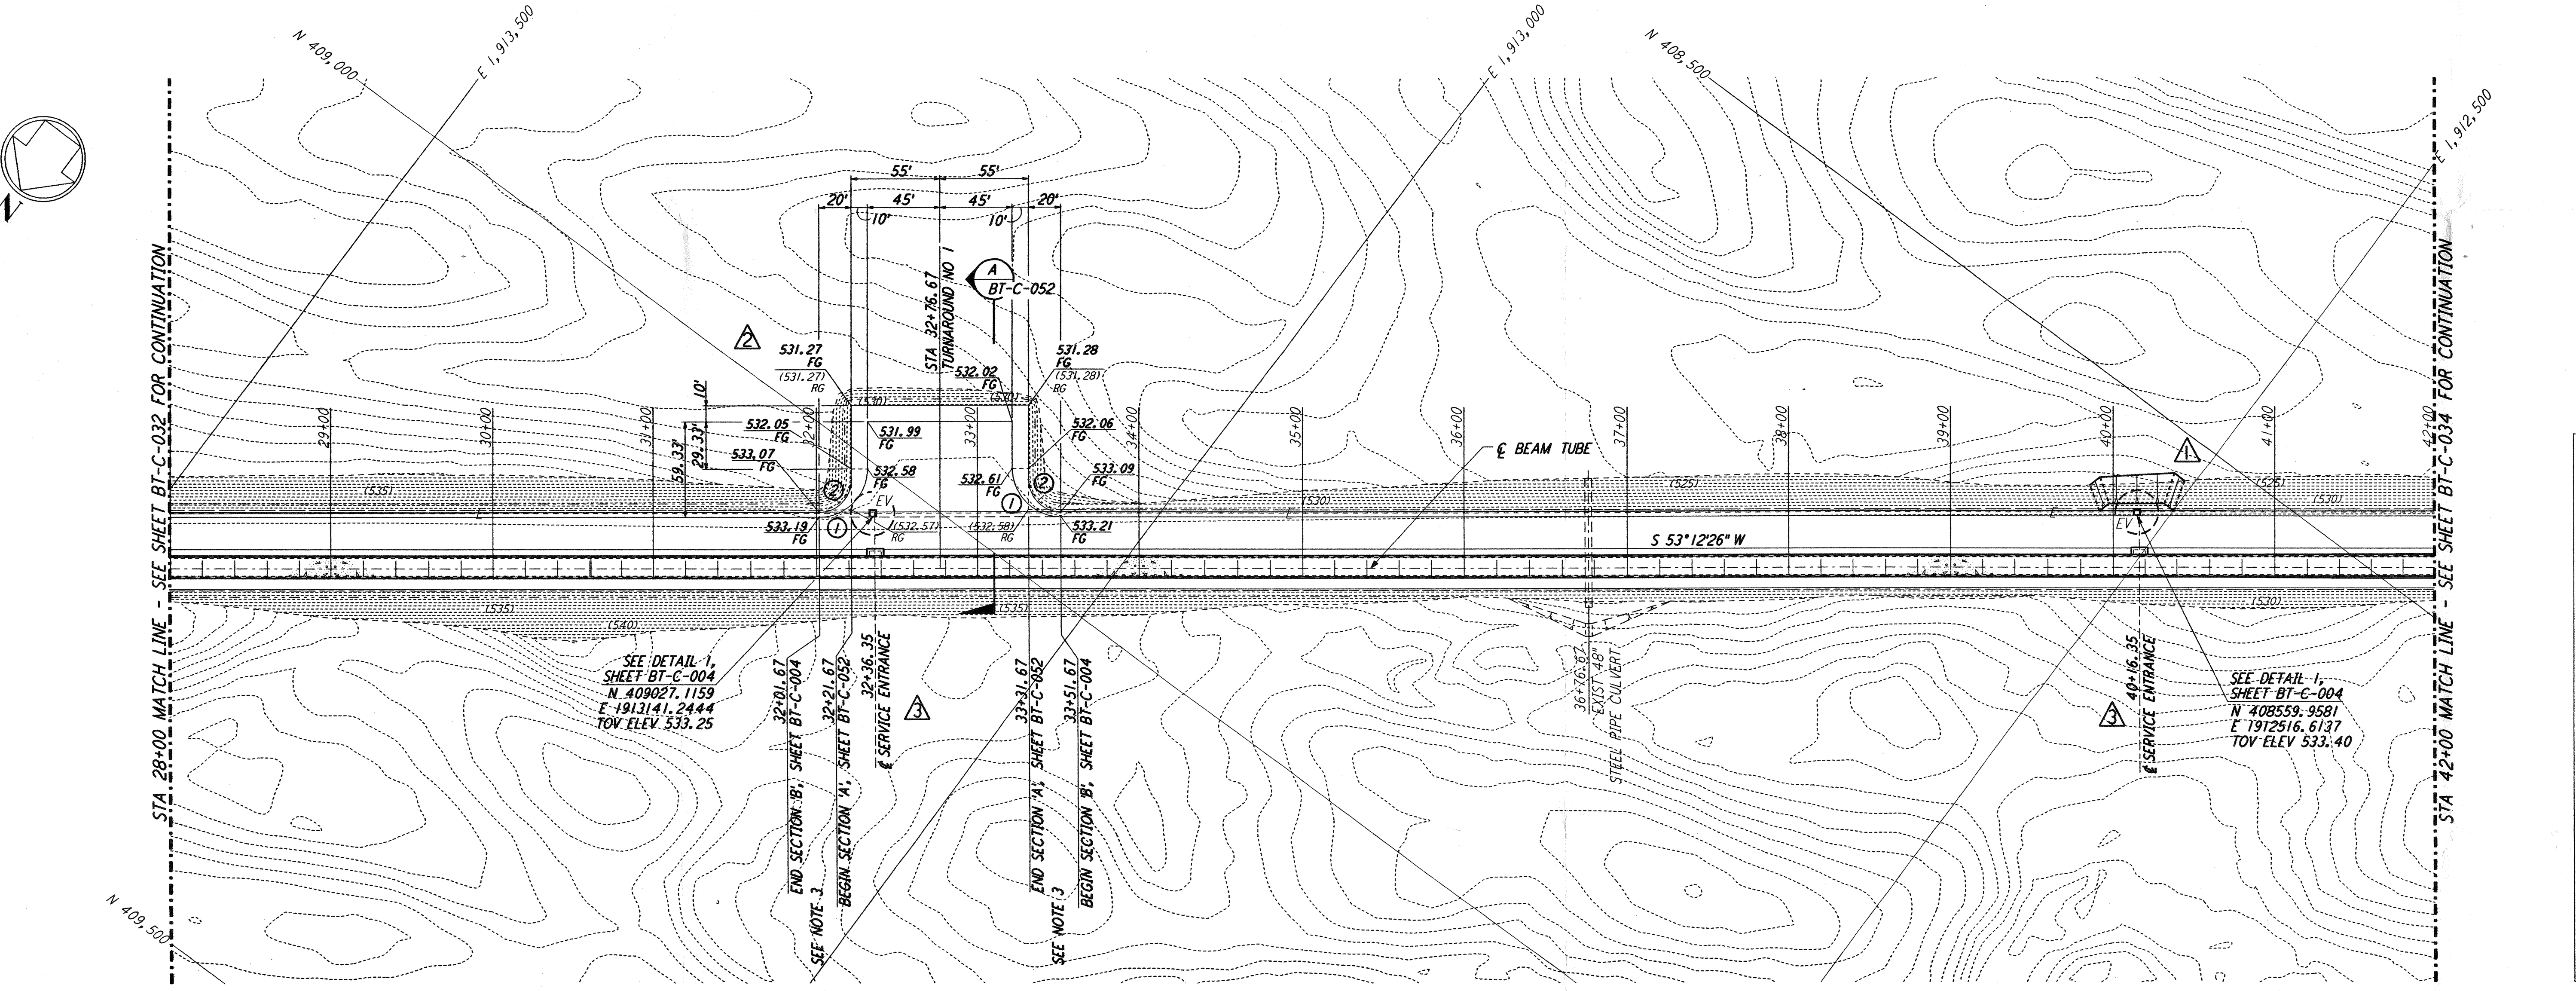


PLAN  
SCALE: 1" = 50'

CURVE DATA				
Δ	RADIUS	LENGTH	TANGENT	
1	90°00'00"	30'	47.12'	30.00'
2	90°00'00"	20'	31.42'	20.00'

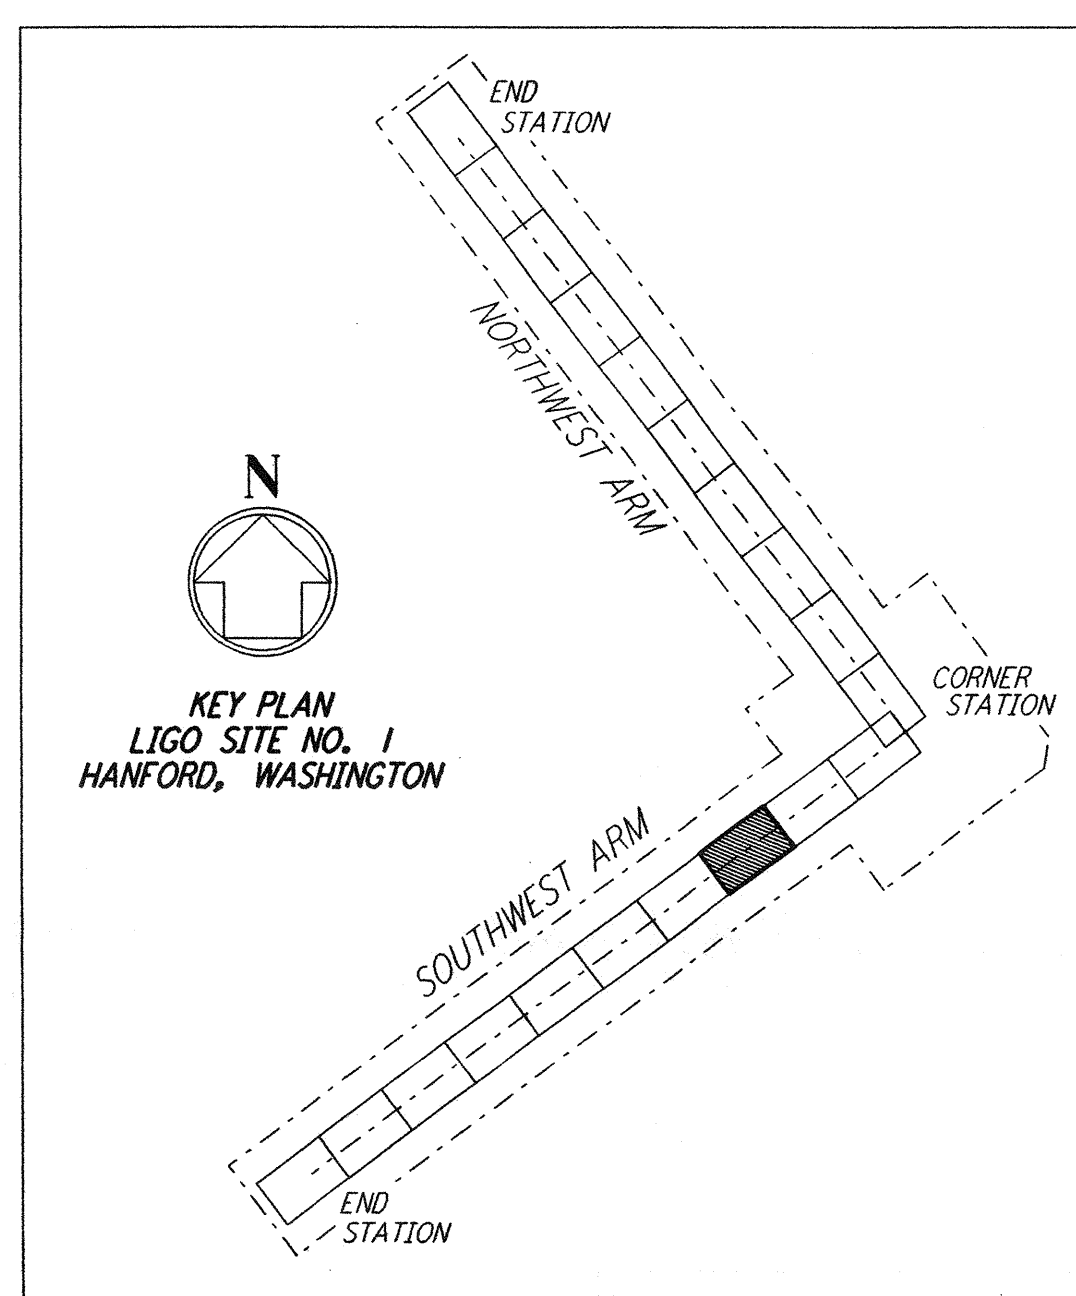

LIGO-D960178-04-O

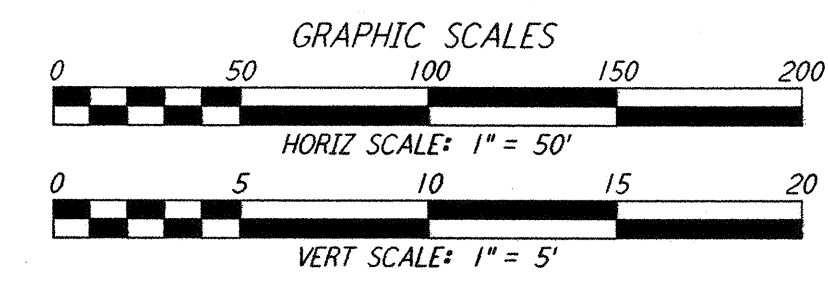

NO.	DATE	BY	CHKD	ENGR	PROJ	DESCRIPTION
4	1-22-99	MEI	--	--	MDW	ISSUED FOR AS BUILT
3	5-10-96	WRB	TDM	JB	MDW	REVISED BEAM TUBE SERVICE ENTRANCES
2	4-19-96	WRB	TDM	JB	MDW	CHANGE ORDER NO. 4
1	2-29-96	WRB	TDM	JB	MDW	CHANGE ORDER NO. 2

ISSUED FOR CONSTRUCTION  
 DRAWN WRB 1-19-96  
 CHECKED MP 1-19-96  
 ENGINEER JB 1-19-96  
 PROJ MDW 1-19-96

AS-BUILT DRAWINGS



100 WEST WALNUT STREET  
PASADENA, CALIFORNIA



CALIFORNIA INSTITUTE OF TECHNOLOGY  
MASSACHUSETTS INSTITUTE OF TECHNOLOGY

LASER INTERFEROMETER  
GRAVITATIONAL-WAVE OBSERVATORY  
BTE SITWORK & FABRICATION - HANFORD, WA

CIVIL  
SOUTHWEST ARM  
PLAN AND PROFILE  
STA 28+00 TO STA 42+00

AS NOTED PPI50969 8094

SHEET NUMBER  
BT-C-033