



This document and the design it covers are the property of PARSONS. They are loaned only with the borrower's expressed written agreement that they will not be reproduced, copied, loaned, exhibited, or used in any other way, except by written consent from PARSONS to the borrower.

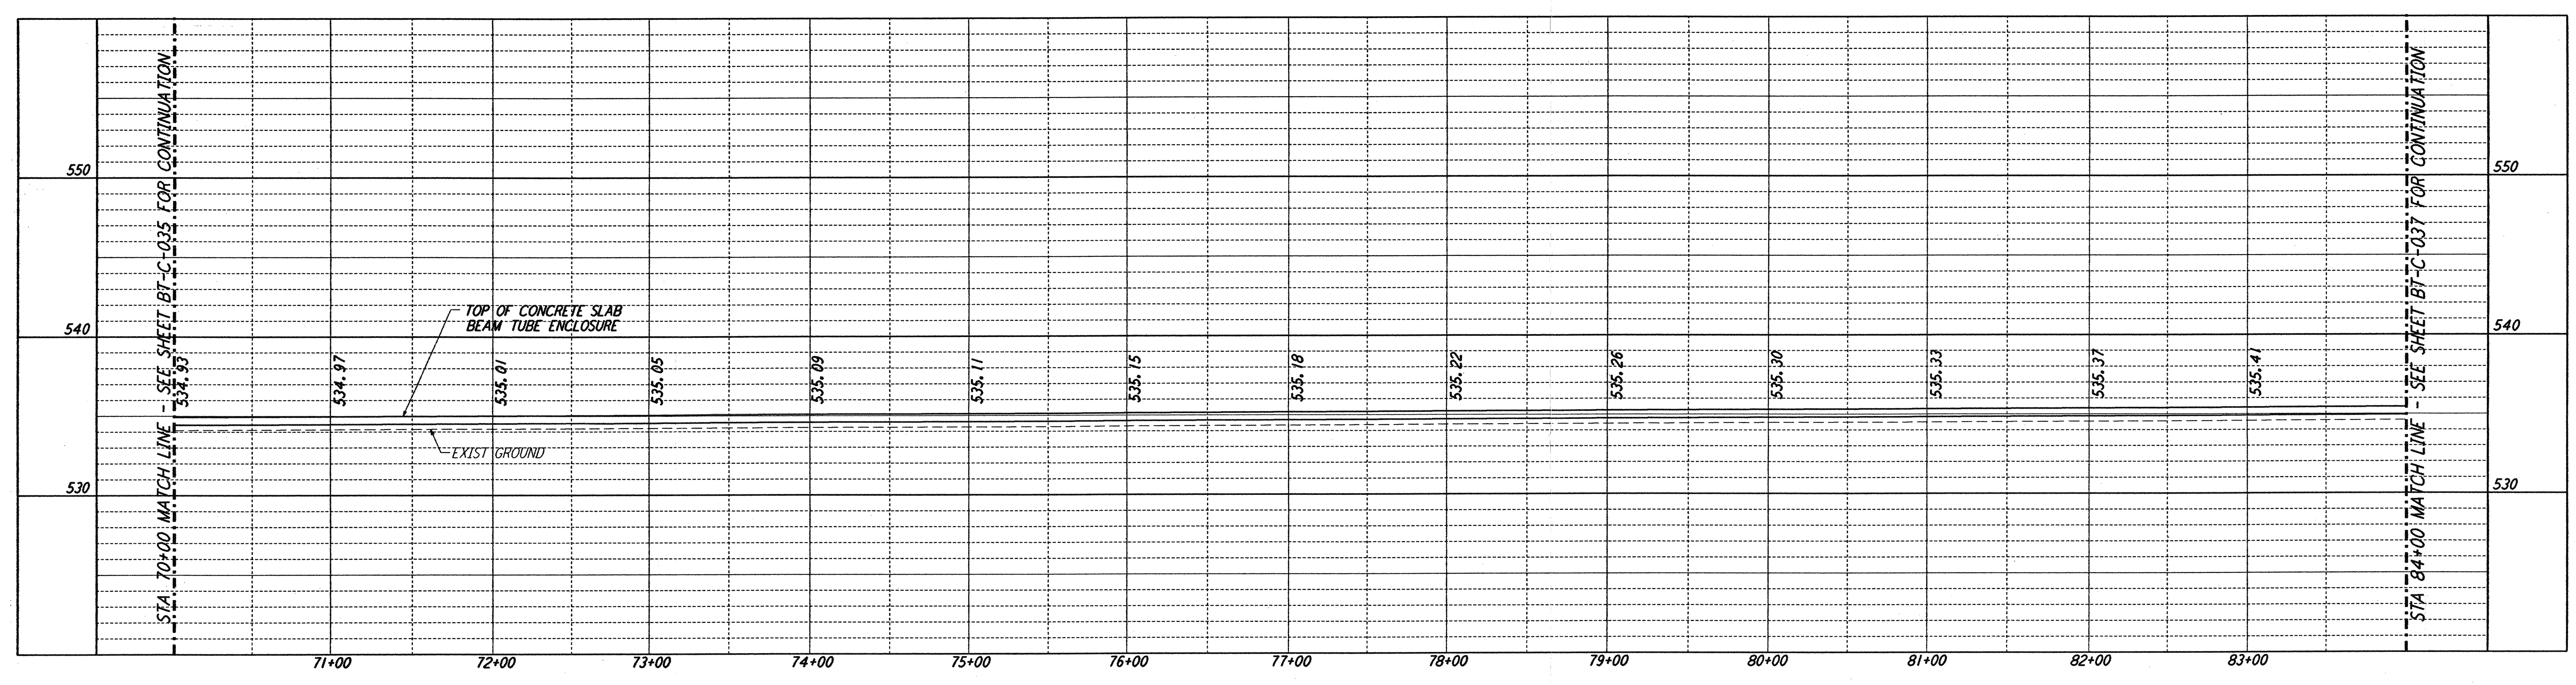


- NOTES:**
- SEE SHEET BT-C-002 FOR GENERAL NOTES, LEGEND AND ABBREVIATIONS.
 - SEE SHEET BT-C-004 FOR TYPICAL SECTIONS AND DETAILS.


PROFILE
 SCALES: HORIZ: 1" = 50'
 VERT: 1" = 5'

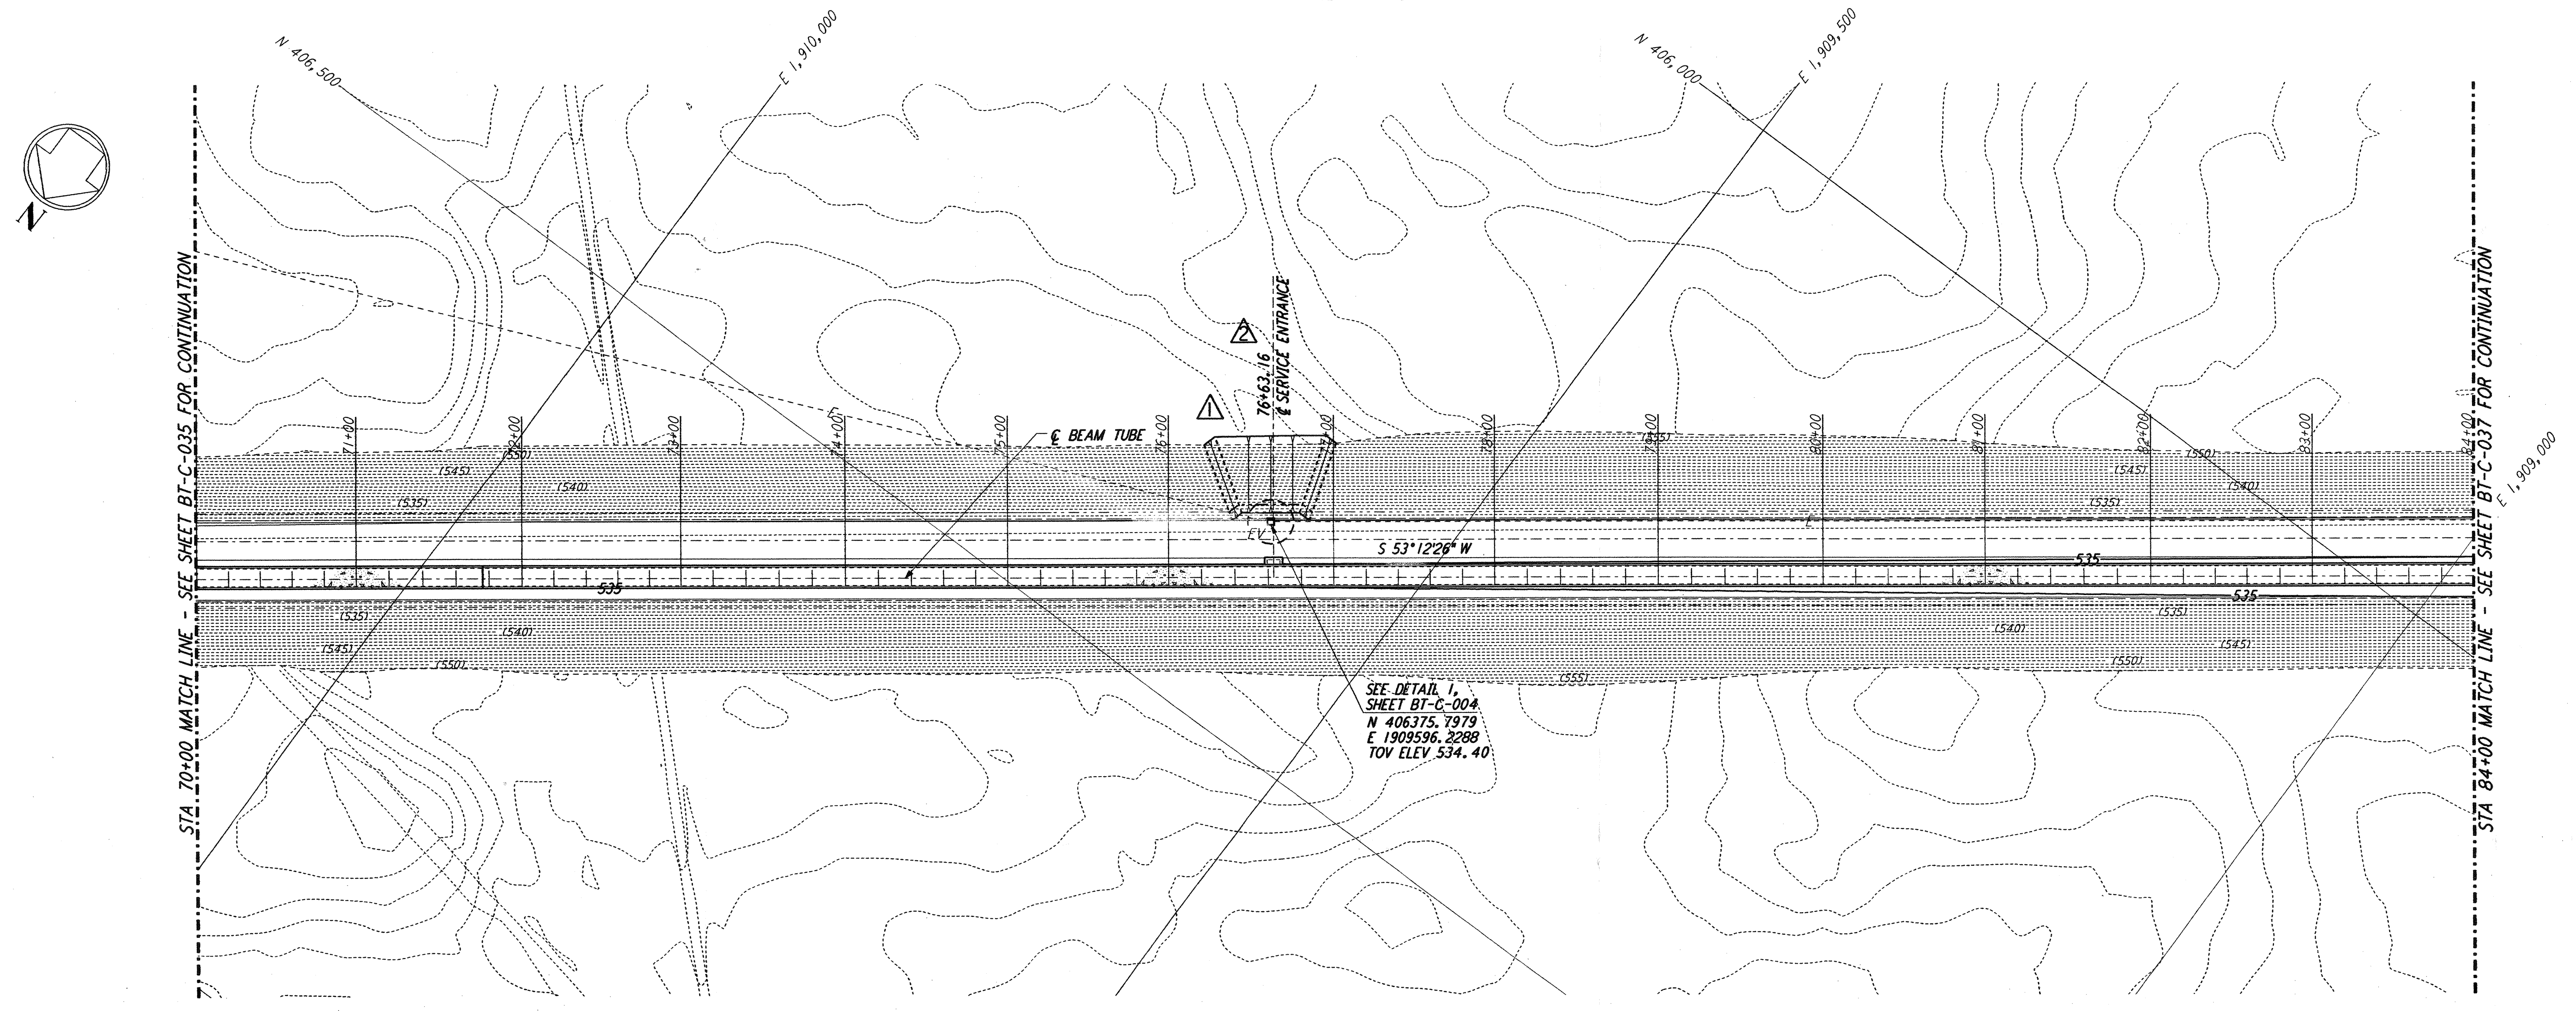

PLAN
 SCALE: 1" = 50'

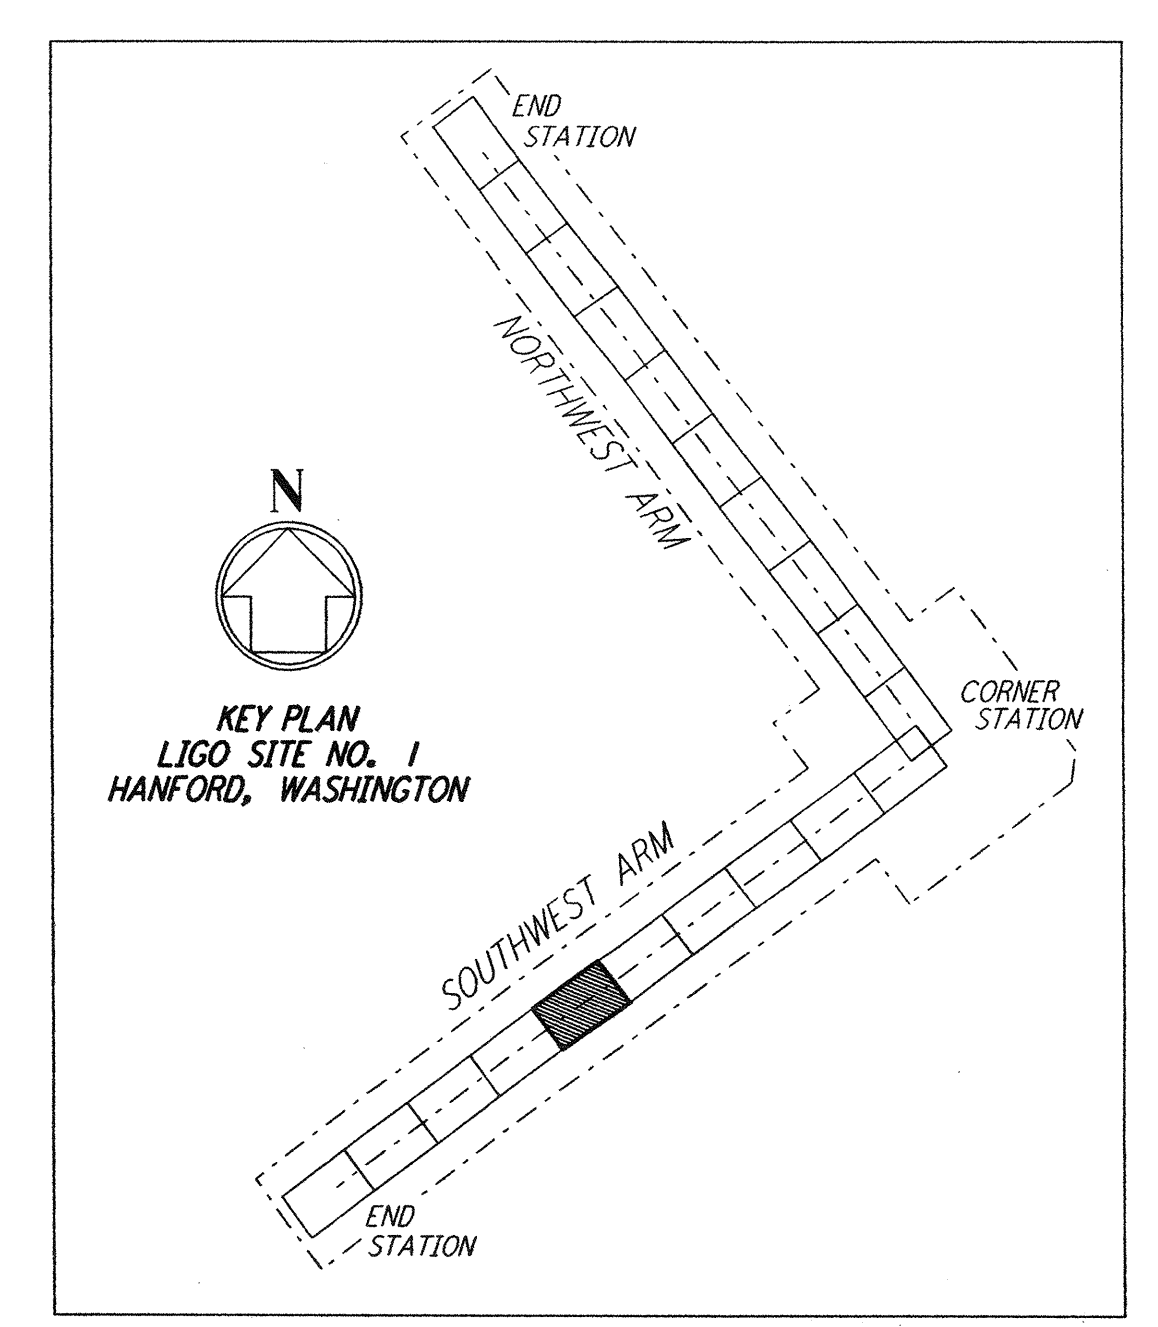

LIGO-D960181-03-O

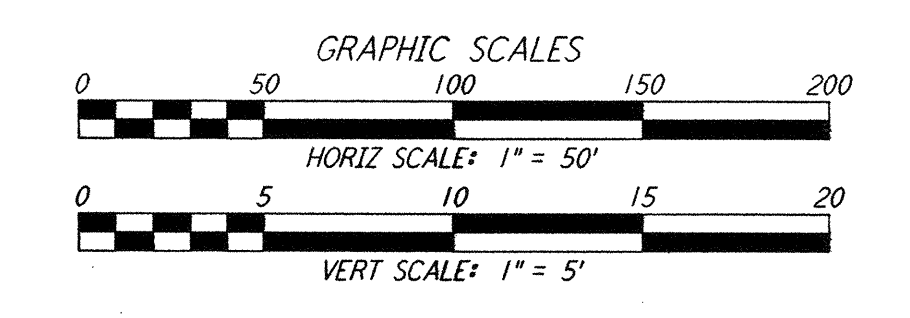

NO.	DATE	BY	CHKD	ENGR	PROJ	DESCRIPTION
3	1-22-99	MEI	--	--	MDW	ISSUED FOR AS BUILT
2	5-10-96	WRB	TDM	MDW	JB	REVISED BEAM TUBE SERVICE ENTRANCES
1	2-29-96	WRB	TDM	JB	MDW	CHANGE ORDER NO. 2

ISSUED FOR CONSTRUCTION
 DRAWN: WRB 1-19-96
 CHECKED: MP 1-19-96
 ENGINEER: JB 1-19-96
 PROJ: MDW 1-19-96

AS-BUILT DRAWINGS

PARSONS
 100 WEST WALNUT STREET
 PASADENA, CALIFORNIA

LIGO
 CALIFORNIA INSTITUTE OF TECHNOLOGY
 MASSACHUSETTS INSTITUTE OF TECHNOLOGY

LASER INTERFEROMETER
 GRAVITATIONAL-WAVE OBSERVATORY
 BTE SITESWORK & FABRICATION - HANFORD, WA

TITLE	CIVIL SOUTHWEST ARM PLAN AND PROFILE STA 70+00 TO STA 84+00	SCALE	AS NOTED	CONTRACT NUMBER	PP150969	PROJECT NUMBER	8094
SHEET NUMBER	BT - C - 036	REVISIONS	3				