



This document and the design it covers are the property of PARSONS. They are loaned only with the borrower's expressed written agreement that they will not be reproduced, copied, loaned, exhibited, or used in any other way, except by written consent from PARSONS to the borrower.

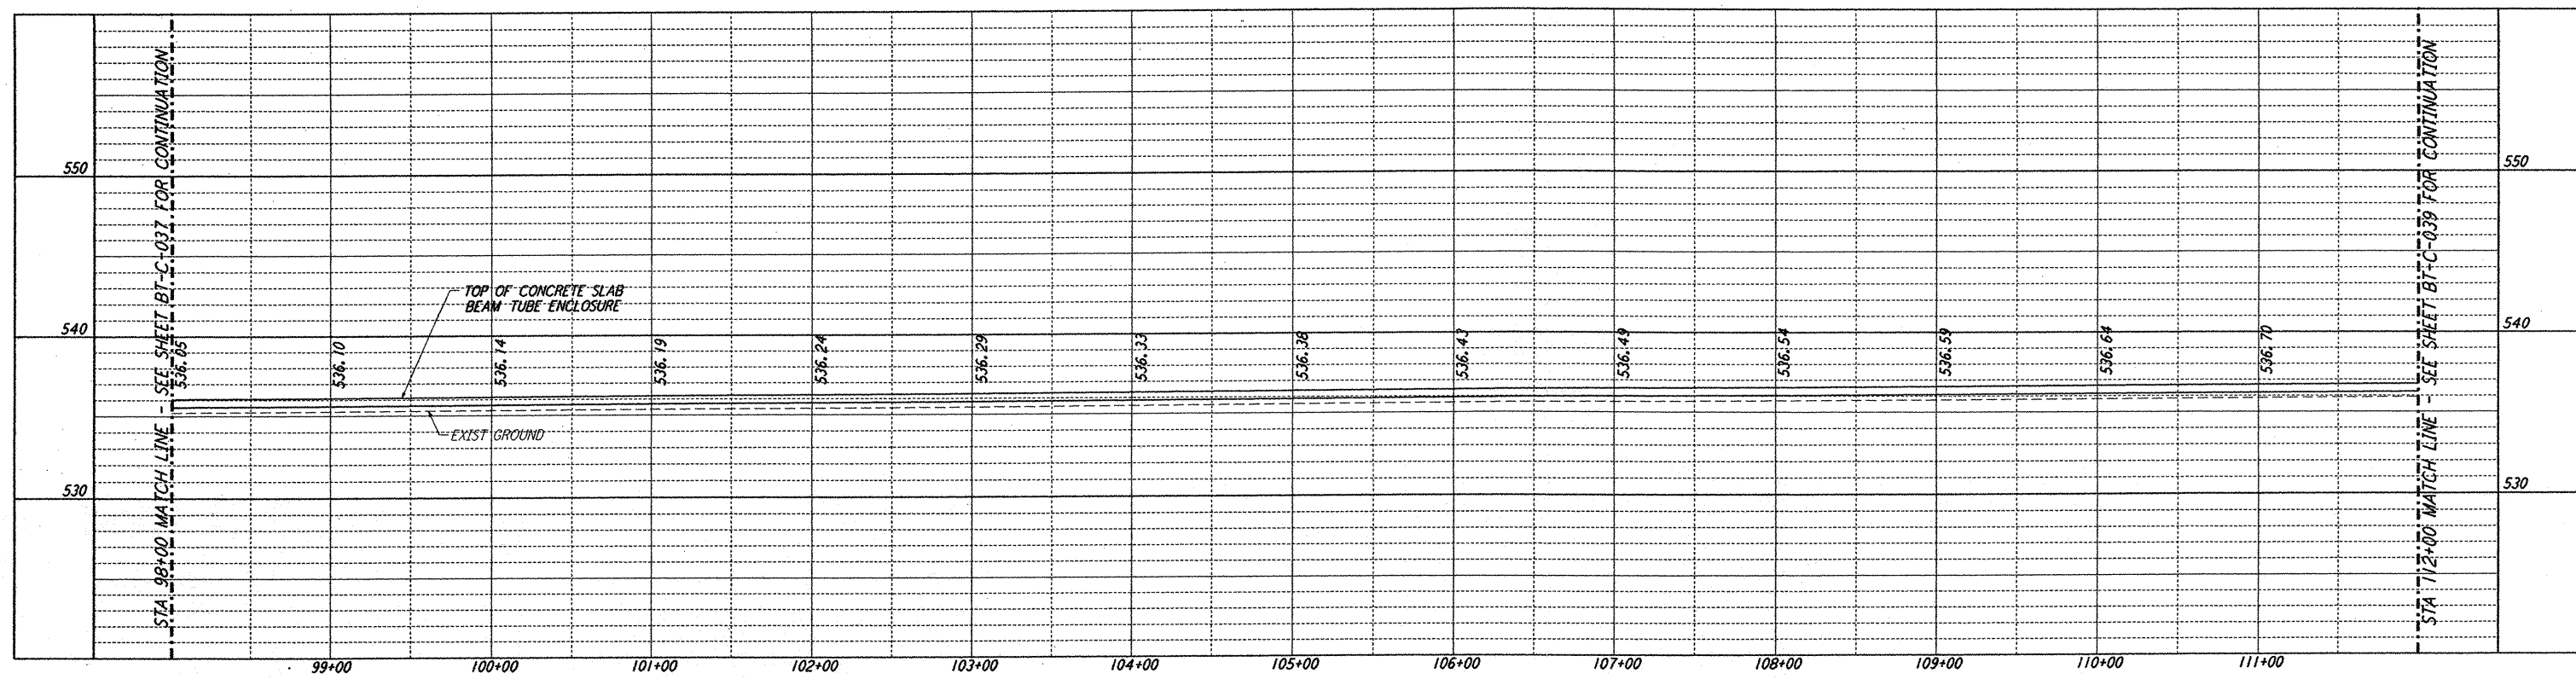


- NOTES:**
- SEE SHEET BT-C-002 FOR GENERAL NOTES, LEGEND AND ABBREVIATIONS.
 - SEE SHEET BT-C-004 FOR TYPICAL SECTIONS AND DETAILS.
 - TRANSITION BETWEEN SECTIONS, AS SHOWN ON PLAN.

PROFILE
 SCALES: HORIZ: 1" = 50'
 VERT: 1" = 5'

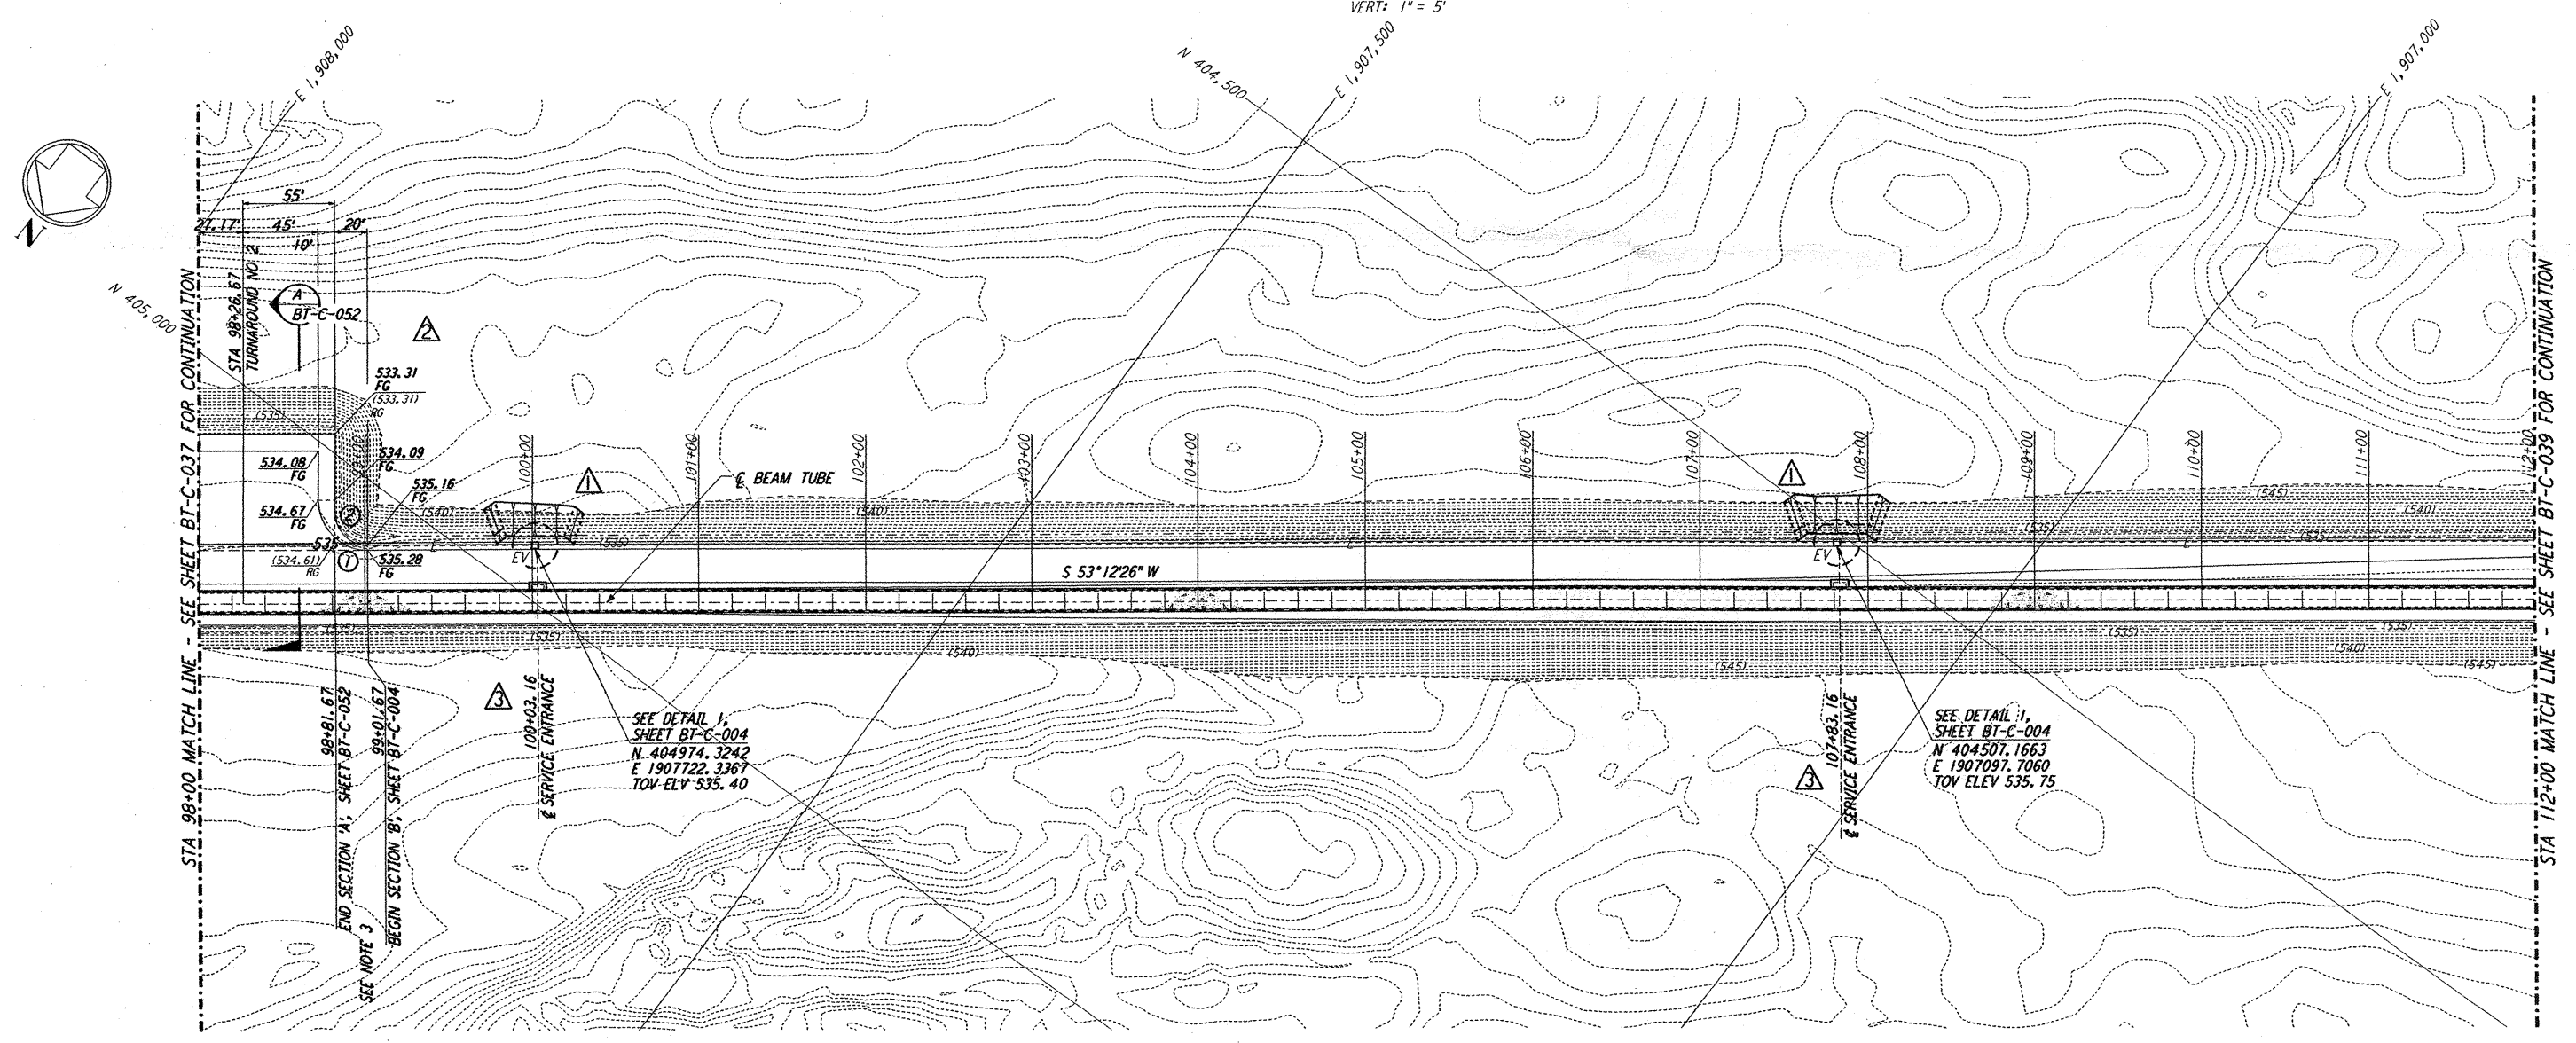


PLAN
 SCALE: 1" = 50'

CURVE DATA				
Δ	RADIUS	LENGTH	TANGENT	
1	90°00'00"	30'	47.12'	30.00'
2	90°00'00"	20'	31.42'	20.00'

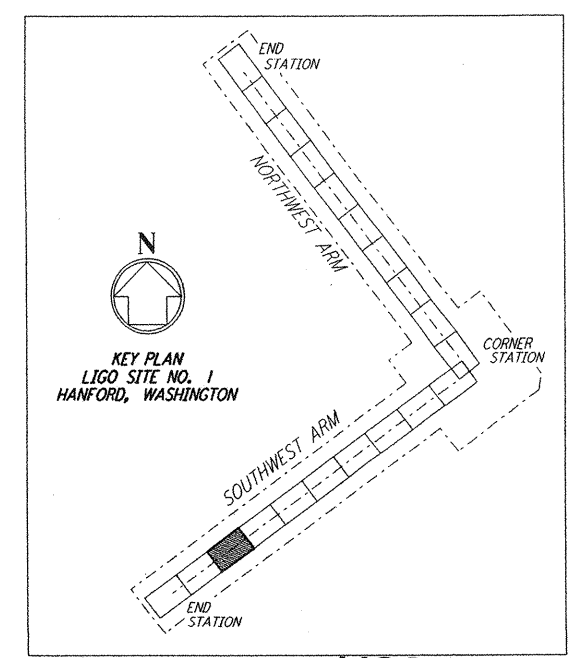

LIGO-D960183-04-0

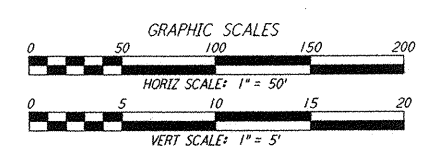

REV	NO.	DATE	BY	CHKD	ENGR	PROJ	DESCRIPTION
4	1-22-99	MET	---	---	MDW		ISSUED FOR AS BUILT
3	5-10-96	WRB	TDM	JB	MDW		REVISED BEAM TUBE SERVICE ENTRANCES
2	4-19-96	WRB	TDM	JB	MDW		CHANGE ORDER NO. 4
1	2-29-96	WRB	TDM	JB	MDW		CHANGE ORDER NO. 2

AS-BUILT DRAWINGS

ISSUED FOR CONSTRUCTION	
DRAWN	WRB 1-19-96
CHECKED	MP 1-19-96
ENGINEER	JB 1-19-96
PROJ	MDW 1-19-96

PARSONS
 100 WEST WALNUT STREET
 PASADENA, CALIFORNIA

LIGO
 CALIFORNIA INSTITUTE OF TECHNOLOGY
 MASSACHUSETTS INSTITUTE OF TECHNOLOGY

LASER INTERFEROMETER
 GRAVITATIONAL-WAVE OBSERVATORY
 BTE SITEWORK & FABRICATION - HANFORD, WA

TITLE: CIVIL SOUTHWEST ARM PLAN AND PROFILE
 STA 98+00 TO STA 112+00

SCALE: AS NOTED
 CONTRACT NUMBER: PPI 50969
 PROJECT NUMBER: 8094

SHEET NUMBER: **BT - C - 038**