

DRAWING LIST

DRAWING LIST

DRAWING LIST



REV	DATE	SHEET NO.	TITLE	REV	DATE	SHEET NO.	TITLE	REV	DATE	SHEET NO.	TITLE
1	5-15-98	WA-C-036	CIVIL SOUTHWEST ARM PLAN AND PROFILE STA 70+00 TO STA 84+00	1	5-15-98	WA-A-425	ARCHITECTURAL ROOF & MISCELLANEOUS EXTERIOR DETAILS	1	6-15-98	WA-S-401	STRUCTURAL MID & END STATION FOUNDATION SCHEDULE AND DETAILS
1	5-15-98	WA-C-037	CIVIL SOUTHWEST ARM PLAN AND PROFILE STA 84+00 TO STA 98+00	2	5-15-98	WA-A-426	ARCHITECTURAL DOOR DETAILS	1	6-15-98	WA-S-402	STRUCTURAL CORNER STATION OSB FOUNDATION SCHEDULE & DETAILS SHEET 1
1	5-15-98	WA-C-038	CIVIL SOUTHWEST ARM PLAN AND PROFILE STA 98+00 TO STA 112+00	2	5-15-98	WA-A-427	ARCHITECTURAL INTERIOR ELEVATIONS & MISCELLANEOUS DETAILS	1	6-15-98	WA-S-403	STRUCTURAL CORNER STATION OSB FOUNDATION SCHEDULE & DETAILS SHEET 2
1	5-15-98	WA-C-039	CIVIL SOUTHWEST ARM PLAN AND PROFILE STA 112+00 TO STA 126+00	2	5-15-98	WA-A-428	ARCHITECTURAL WALL TYPES SCHEDULE	1	6-15-98	WA-S-405	STRUCTURAL FOUNDATION SECTIONS & DETAILS SHEET 1
1	5-15-98	WA-C-040	CIVIL SOUTHWEST ARM PLAN AND PROFILE STA 126+00 TO STA 133+00	1	5-15-98	WA-A-501	ARCHITECTURAL CORNER STATION LVEA FLOOR PLAN	1	6-15-98	WA-S-406	STRUCTURAL FOUNDATION SECTIONS & DETAILS SHEET 2
1	5-15-98	WA-C-041	CIVIL SOUTHWEST ARM MID-STATION, PLOT PLAN	1	5-15-98	WA-A-502	ARCHITECTURAL CORNER STATION LVEA PARTIAL FLOOR PLAN SHEET 1	1	6-15-98	WA-S-407	STRUCTURAL STEEL SECTIONS & DETAILS
1	5-15-98	WA-C-042	CIVIL SOUTHWEST ARM MID-STATION, GRADING PLAN	1	5-15-98	WA-A-503	ARCHITECTURAL CORNER STATION LVEA PARTIAL FLOOR PLAN SHEET 2	1	6-15-98	WA-S-501	STRUCTURAL CORNER STATION LVEA FOUNDATION PLAN
1	5-15-98	WA-C-043	CIVIL SOUTHWEST ARM MID-STATION, UTILITY PLAN	1	5-15-98	WA-A-504	ARCHITECTURAL CORNER STATION LVEA PARTIAL FLOOR PLAN SHEET 3	1	6-15-98	WA-S-502	STRUCTURAL CORNER STATION AIR HANDLING UNIT ENCLOSURE PLAN
1	5-15-98	WA-C-045	CIVIL SOUTHWEST ARM END-STATION, PLOT PLAN	2	5-15-98	WA-A-505	ARCHITECTURAL CORNER STATION LVEA PARTIAL FLOOR PLAN SHEET 4	1	6-15-98	WA-S-503	STRUCTURAL CORNER STATION AIR HANDLING UNIT ENCLOSURE ELEVS & SECTS
1	5-15-98	WA-C-046	CIVIL SOUTHWEST ARM END-STATION, GRADING PLAN	2	5-15-98	WA-A-510	ARCHITECTURAL CORNER STATION ROOF PLATFORM PLAN	1	6-15-98	WA-S-504	STRUCTURAL CORNER STATION LVEA ROOF FRAMING PLAN
1	5-15-98	WA-C-047	CIVIL SOUTHWEST ARM END-STATION, UTILITY PLAN	1	5-15-98	WA-A-521	ARCHITECTURAL CORNER STATION LVEA REFLECTED CEILING PLAN	1	6-15-98	WA-S-505	STRUCTURAL CORNER STATION LVEA TRUSS BOTTOM CHORD FRAMING PLAN
1	5-15-98	WA-C-050	CIVIL LIGO ACCESS ROAD PLAN AND PROFILE	1	5-15-98	WA-A-531	ARCHITECTURAL CORNER STATION LVEA ROOF PLAN	1	6-15-98	WA-S-506	STRUCTURAL CORNER STATION LVEA CRANE SUPPORT FRAMING PLAN
2	5-15-98	WA-C-051	CIVIL SITEWORK DETAILS SHEET 1	2	5-15-98	WA-A-541	ARCHITECTURAL CORNER STATION LVEA & OSB ELEVATIONS SHEET 1	1	6-15-98	WA-S-507	STRUCTURAL CORNER STATION LVEA FRAMING ELEVATIONS SHEET 1
1	5-15-98	WA-C-052	CIVIL SITEWORK DETAILS SHEET 2	2	5-15-98	WA-A-542	ARCHITECTURAL CORNER STATION LVEA & OSB ELEVATIONS SHEET 2	1	6-15-98	WA-S-508	STRUCTURAL CORNER STATION LVEA FRAMING ELEVATIONS SHEET 2
1	5-15-98	WA-C-053	CIVIL GRADING SECTIONS & DETAILS SHEET 1	2	5-15-98	WA-A-551	ARCHITECTURAL CORNER STATION LVEA & OSB SECTIONS SHEET 1	1	6-15-98	WA-S-509	STRUCTURAL CORNER STATION LVEA FRAMING ELEVATIONS SHEET 3
1	5-15-98	WA-C-054	CIVIL GRADING SECTIONS & DETAILS SHEET 2	2	5-15-98	WA-A-552	ARCHITECTURAL CORNER STATION LVEA & OSB SECTIONS SHEET 2	1	6-15-98	WA-S-510	STRUCTURAL CORNER STATION LVEA FRAMING ELEVATIONS SHEET 4
1	5-15-98	WA-C-055	CIVIL UTILITY DETAILS SHEET 1	2	5-15-98	WA-A-553	ARCHITECTURAL CORNER STATION LVEA & OSB SECTIONS SHEET 3	1	6-15-98	WA-S-511	STRUCTURAL CORNER STATION LVEA FRAMING ELEVATIONS SHEET 5
1	5-15-98	WA-C-056	CIVIL UTILITY DETAILS SHEET 2					1	6-15-98	WA-S-512	STRUCTURAL CORNER STATION LVEA FRAMING ELEVATIONS SHEET 6
0	5-15-98	WA-C-057	CIVIL UTILITY DETAILS SHEET 3					1	6-15-98	WA-S-513	STRUCTURAL CORNER STATION LVEA FRAMING ELEVATIONS SHEET 7
2	5-15-98	WA-C-505	CIVIL CORNER STATION PLOT PLAN					1	6-15-98	WA-S-514	STRUCTURAL CORNER STATION LVEA FRAMING ELEVATIONS SHEET 8
2	5-15-98	WA-C-507	CIVIL CORNER STATION GRADING PLAN	1	6-15-98	WA-S-001	STRUCTURAL GENERAL NOTES, ABBREVIATIONS & LEGEND	1	6-15-98	WA-S-515	STRUCTURAL CORNER STATION LVEA FRAMING ELEVATIONS SHEET 9
2	5-15-98	WA-C-509	CIVIL CORNER STATION UTILITY PLAN	1	6-15-98	WA-S-002	STRUCTURAL STANDARD CONCRETE DETAILS SHEET 1	1	6-15-98	WA-S-516	STRUCTURAL CORNER STATION LVEA FRAMING ELEVATIONS SHEET 10
1	5-15-98	WA-C-510	CIVIL CORNER STATION UTILITY PLAN, ENLARGED PLANS	1	6-15-98	WA-S-003	STRUCTURAL STANDARD CONCRETE DETAILS SHEET 2	1	6-15-98	WA-S-517	STRUCTURAL CORNER STATION LVEA TRUSS ELEVATION SHEET 1
				1	6-15-98	WA-S-004	STRUCTURAL STANDARD STRUCTURAL STEEL CONNECTION DETAILS SHEET 1	1	6-15-98	WA-S-518	STRUCTURAL CORNER STATION LVEA TRUSS ELEVATION SHEET 2
				1	6-15-98	WA-S-005	STRUCTURAL STANDARD STRUCTURAL STEEL CONNECTION DETAILS SHEET 2	1	6-15-98	WA-S-519	STRUCTURAL CORNER STATION LVEA FOUNDATION SCHEDULE
				1	6-15-98	WA-S-006	STRUCTURAL STANDARD STRUCTURAL STEEL CONNECTION DETAILS SHEET 3	1	6-15-98	WA-S-520	STRUCTURAL CORNER STATION FOUNDATION SECTIONS & DETAILS
				1	6-15-98	WA-S-007	STRUCTURAL STANDARD STRUCTURAL STEEL CONNECTION DETAILS SHEET 4	1	6-15-98	WA-S-521	STRUCTURAL CORNER STATION STEEL SECTIONS & DETAILS
1	5-15-98	WA-A-001	ARCHITECTURAL LEGEND, SYMBOLS, & ABBREVIATIONS	1	6-15-98	WA-S-008	STRUCTURAL STANDARD STRUCTURAL STEEL LADDER DETAILS				
1	5-15-98	WA-A-002	ARCHITECTURAL GENERAL NOTES & LIFE SAFETY PLAN	1	6-15-98	WA-S-009	STRUCTURAL STANDARD STRUCTURAL STEEL STAIR & HANDRAIL DETAILS				
2	5-15-98	WA-A-107	ARCHITECTURAL CORNER STATION OSB FLOOR PLAN	1	6-15-98	WA-S-010	STRUCTURAL KEY PLAN				
2	5-15-98	WA-A-108	ARCHITECTURAL CORNER STATION OSB PARTIAL FLOOR PLAN SHEET 1	1	6-15-98	WA-S-102	STRUCTURAL CORNER STATION OSB FOUNDATION PLAN	1	5-15-98	WA-H-001	HVAC LEGEND & ABBREVIATIONS
2	5-15-98	WA-A-109	ARCHITECTURAL CORNER STATION OSB PARTIAL FLOOR PLAN SHEET 2	1	6-15-98	WA-S-117	STRUCTURAL CORNER STATION OSB ROOF FRAMING PLANS	1	5-15-98	WA-H-002	HVAC LEGEND & GENERAL NOTES
2	5-15-98	WA-A-111	ARCHITECTURAL CORNER STATION OSB ENLARGED PLANS	2	6-15-98	WA-S-118	STRUCTURAL CORNER STATION OSB FRAMING ELEVATIONS SHEET 1	1	5-15-98	WA-H-003	HVAC EQUIPMENT SCHEDULES SHEET 1
1	5-15-98	WA-A-112	ARCHITECTURAL CORNER STATION MAINTENANCE BUILDING PLANS	1	6-15-98	WA-S-119	STRUCTURAL CORNER STATION OSB FRAMING ELEVATIONS SHEET 2	2	5-15-98	WA-H-004	HVAC EQUIPMENT SCHEDULES SHEET 2
2	5-15-98	WA-A-122	ARCHITECTURAL CORNER STATION OSB PARTIAL REFLECTED CEILING PLAN SHEET 1	1	6-15-98	WA-S-120	STRUCTURAL CORNER STATION OSB FRAMING ELEVATIONS SHEET 3	1	5-15-98	WA-H-005	HVAC EQUIPMENT SCHEDULES SHEET 3
1	5-15-98	WA-A-123	ARCHITECTURAL CORNER STATION OSB PARTIAL REFLECTED CEILING PLAN SHEET 2	1	6-15-98	WA-S-121	STRUCTURAL CORNER STATION OSB FRAMING ELEVATIONS SHEET 4	1	5-15-98	WA-H-006	HVAC EQUIPMENT SCHEDULES SHEET 4
2	5-15-98	WA-A-132	ARCHITECTURAL CORNER STATION OSB ROOF PLAN	1	6-15-98	WA-S-122	STRUCTURAL CORNER STATION OSB FRAMING ELEVATIONS SHEET 5	1	5-15-98	WA-H-007	HVAC CONTROL SYSTEM DIAGRAM
1	5-15-98	WA-A-143	ARCHITECTURAL CORNER STATION MAINTENANCE BUILDING ELEVATIONS/SECTIONS	1	6-15-98	WA-S-123	STRUCTURAL CORNER STATION OSB FRAMING ELEVATIONS SHEET 6	2	5-15-98	WA-H-113	HVAC CORNER STATION OSB FLOOR PLAN SHEET 1
2	5-15-98	WA-A-161	ARCHITECTURAL CORNER STATION WALL SECTIONS SHEET 1	1	6-15-98	WA-S-124	STRUCTURAL CORNER STATION OSB FRAMING ELEVATIONS SHEET 7	2	5-15-98	WA-H-114	HVAC CORNER STATION OSB FLOOR PLAN SHEET 2
2	5-15-98	WA-A-162	ARCHITECTURAL CORNER STATION WALL SECTIONS SHEET 2	1	6-15-98	WA-S-125	STRUCTURAL MAINTENANCE BUILDING FRAMING PLANS & ELEVATIONS	1	5-15-98	WA-H-115	HVAC CORNER STATION CHILLERS YARD FLOOR PLAN
1	5-15-98	WA-A-163	ARCHITECTURAL CORNER STATION WALL SECTIONS SHEET 3	1	6-15-98	WA-S-126	STRUCTURAL MAINTENANCE BUILDING FOUNDATION PLAN & SECTIONS	1	5-15-98	WA-H-116	HVAC CORNER STATION MAINTENANCE BUILDING FLOOR PLAN
2	5-15-98	WA-A-201	ARCHITECTURAL MID & END STATIONS FLOOR PLANS	1	6-15-98	WA-S-201	STRUCTURAL MID STATION "A" & END STATION "A" FOUNDATION PLANS	1	5-15-98	WA-H-121	HVAC CORNER STATION CHILLED WATER FLOW DIAGRAM
2	5-15-98	WA-A-202	ARCHITECTURAL END STATIONS FLOOR PLANS	1	6-15-98	WA-S-202	STRUCTURAL MID & END STATIONS AIR HANDLING UNIT ENCLOSURE PLANS	1	5-15-98	WA-H-122	HVAC CORNER STATION AIR FLOW DIAGRAMS SHEET 1
1	5-15-98	WA-A-221	ARCHITECTURAL MID & END STATIONS REFLECTED CEILING PLAN & ROOF PLAN	1	6-15-98	WA-S-203	STRUCTURAL MID & END STATIONS AIR HANDLING UNIT ENCLOSURE ELEVS & SECTS	1	5-15-98	WA-H-123	HVAC CORNER STATION AIR FLOW DIAGRAMS SHEET 2
1	5-15-98	WA-A-241	ARCHITECTURAL MID & END STATIONS BUILDING ELEVATIONS	1	6-15-98	WA-S-204	STRUCTURAL MID & END STATIONS "A" ROOF & CRANE GIRDER FRAMING PLANS	1	5-15-98	WA-H-141	HVAC CORNER STATION SEQUENCES OF OPERATION & 1/0 SUMMARY SHEET 1
1	5-15-98	WA-A-251	ARCHITECTURAL MID & END STATIONS BUILDING SECTIONS	1	6-15-98	WA-S-205	STRUCTURAL MID & END STATIONS FRAMING ELEVATIONS SHEET 1	1	5-15-98	WA-H-142	HVAC CORNER STATION SEQUENCES OF OPERATION & 1/0 SUMMARY SHEET 2
1	5-15-98	WA-A-261	ARCHITECTURAL MID & END STATIONS WALL SECTIONS	1	6-15-98	WA-S-206	STRUCTURAL MID & END STATIONS FRAMING ELEVATIONS SHEET 2	1	5-15-98	WA-H-152	HVAC CORNER STATION SECTIONS SHEET 2
1	5-15-98	WA-A-421	ARCHITECTURAL EXTERIOR WALL DETAILS	1	6-15-98	WA-S-207	STRUCTURAL MID & END STATIONS FRAMING ELEVATIONS SHEET 3	1	5-15-98	WA-H-153	HVAC CORNER STATION SECTIONS SHEET 3
2	5-15-98	WA-A-422	ARCHITECTURAL INTERIOR WALL DETAILS	1	6-15-98	WA-S-208	STRUCTURAL MID STATION "B" & END STATION "B" FOUNDATION PLANS	2	5-15-98	WA-H-211	HVAC MID & END STATIONS "A" FLOOR PLAN
1	5-15-98	WA-A-423	ARCHITECTURAL WINDOW & LOUVER DETAILS	1	6-15-98	WA-S-209	STRUCTURAL MID & END STATIONS "B" ROOF & CRANE GIRDER FRAMING PLANS	2	5-15-98	WA-H-212	HVAC MID & END STATIONS "B" FLOOR PLAN
1	5-15-98	WA-A-424	ARCHITECTURAL CEILING & MISCELLANEOUS INTERIOR DETAILS								

This document and the design it covers are the property of PARSONS. They are loaned only with the borrower's expressed written agreement that they will not be reproduced, copied, loaned, exhibited, or used in any other way, except by written consent from PARSONS to the borrower.

NO. ISSUED FOR CONSTRUCTION	6-24-98
DRAWN	MEI
CHECKED	MEI
ENGINEER	
PROJ	

AS-BUILT DRAWINGS

ISSUED FOR AS-BUILT
ADDED REV COLUMN & UPDATED INDEX SHEET

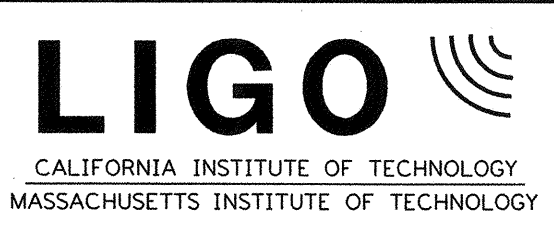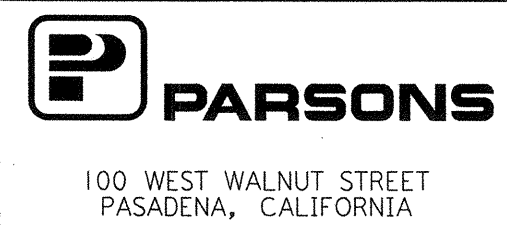

LIGO-D960194-02-O

LASER INTERFEROMETER GRAVITATIONAL-WAVE OBSERVATORY
 SITE NO. 1 - HANFORD, WASHINGTON

GENERAL DRAWING INDEX SHEET 2

SCALE: NONE
 CONTRACT NUMBER: PP150969
 PROJECT NUMBER: 8094

SHEET NUMBER: **WA-G-002**

Non Jul 28 10:47:53 1998 C:\PLOT\01\DESIGN\3\9862.DWG 52885 K:\V\9862\9802.dwg