
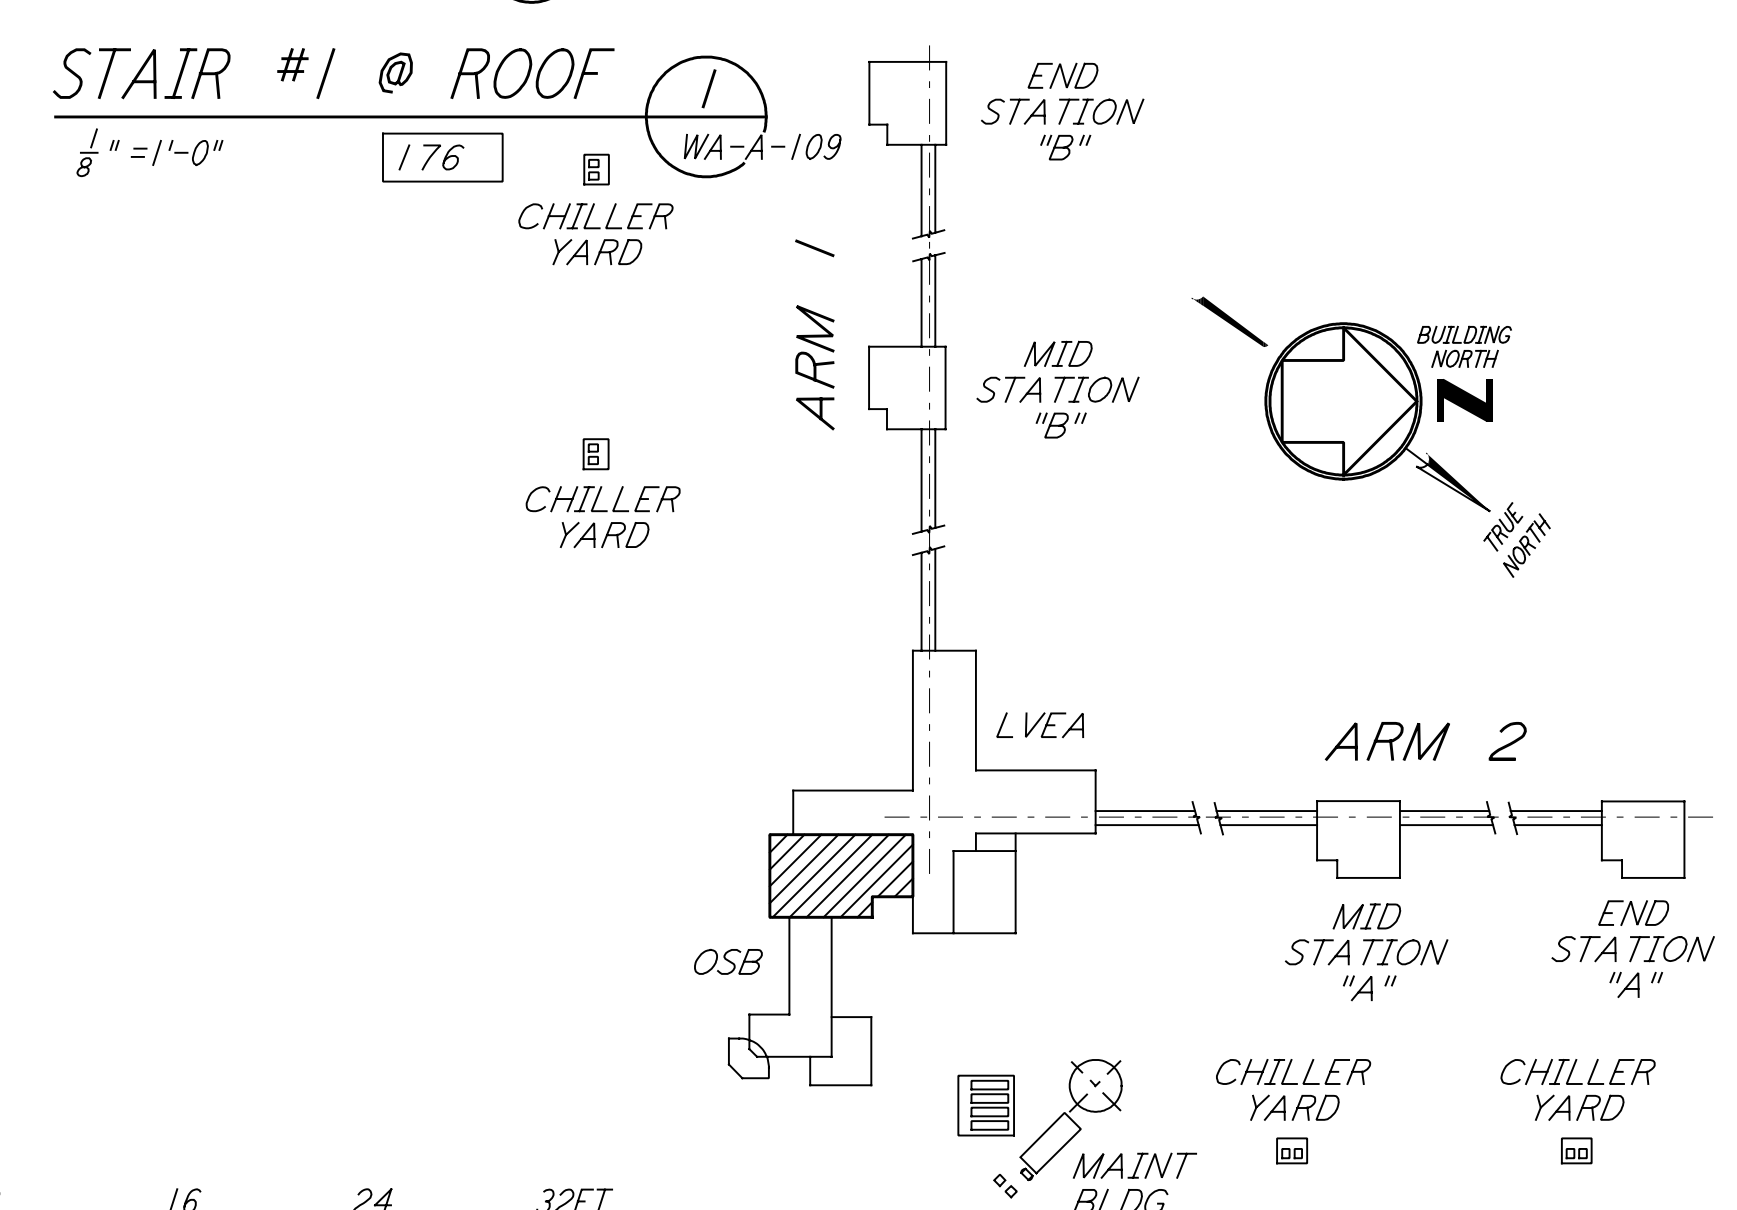


NOTE: SEE SPECIFICATIONS FOR ADDITIONAL INFORMATION AND SCHEDULES

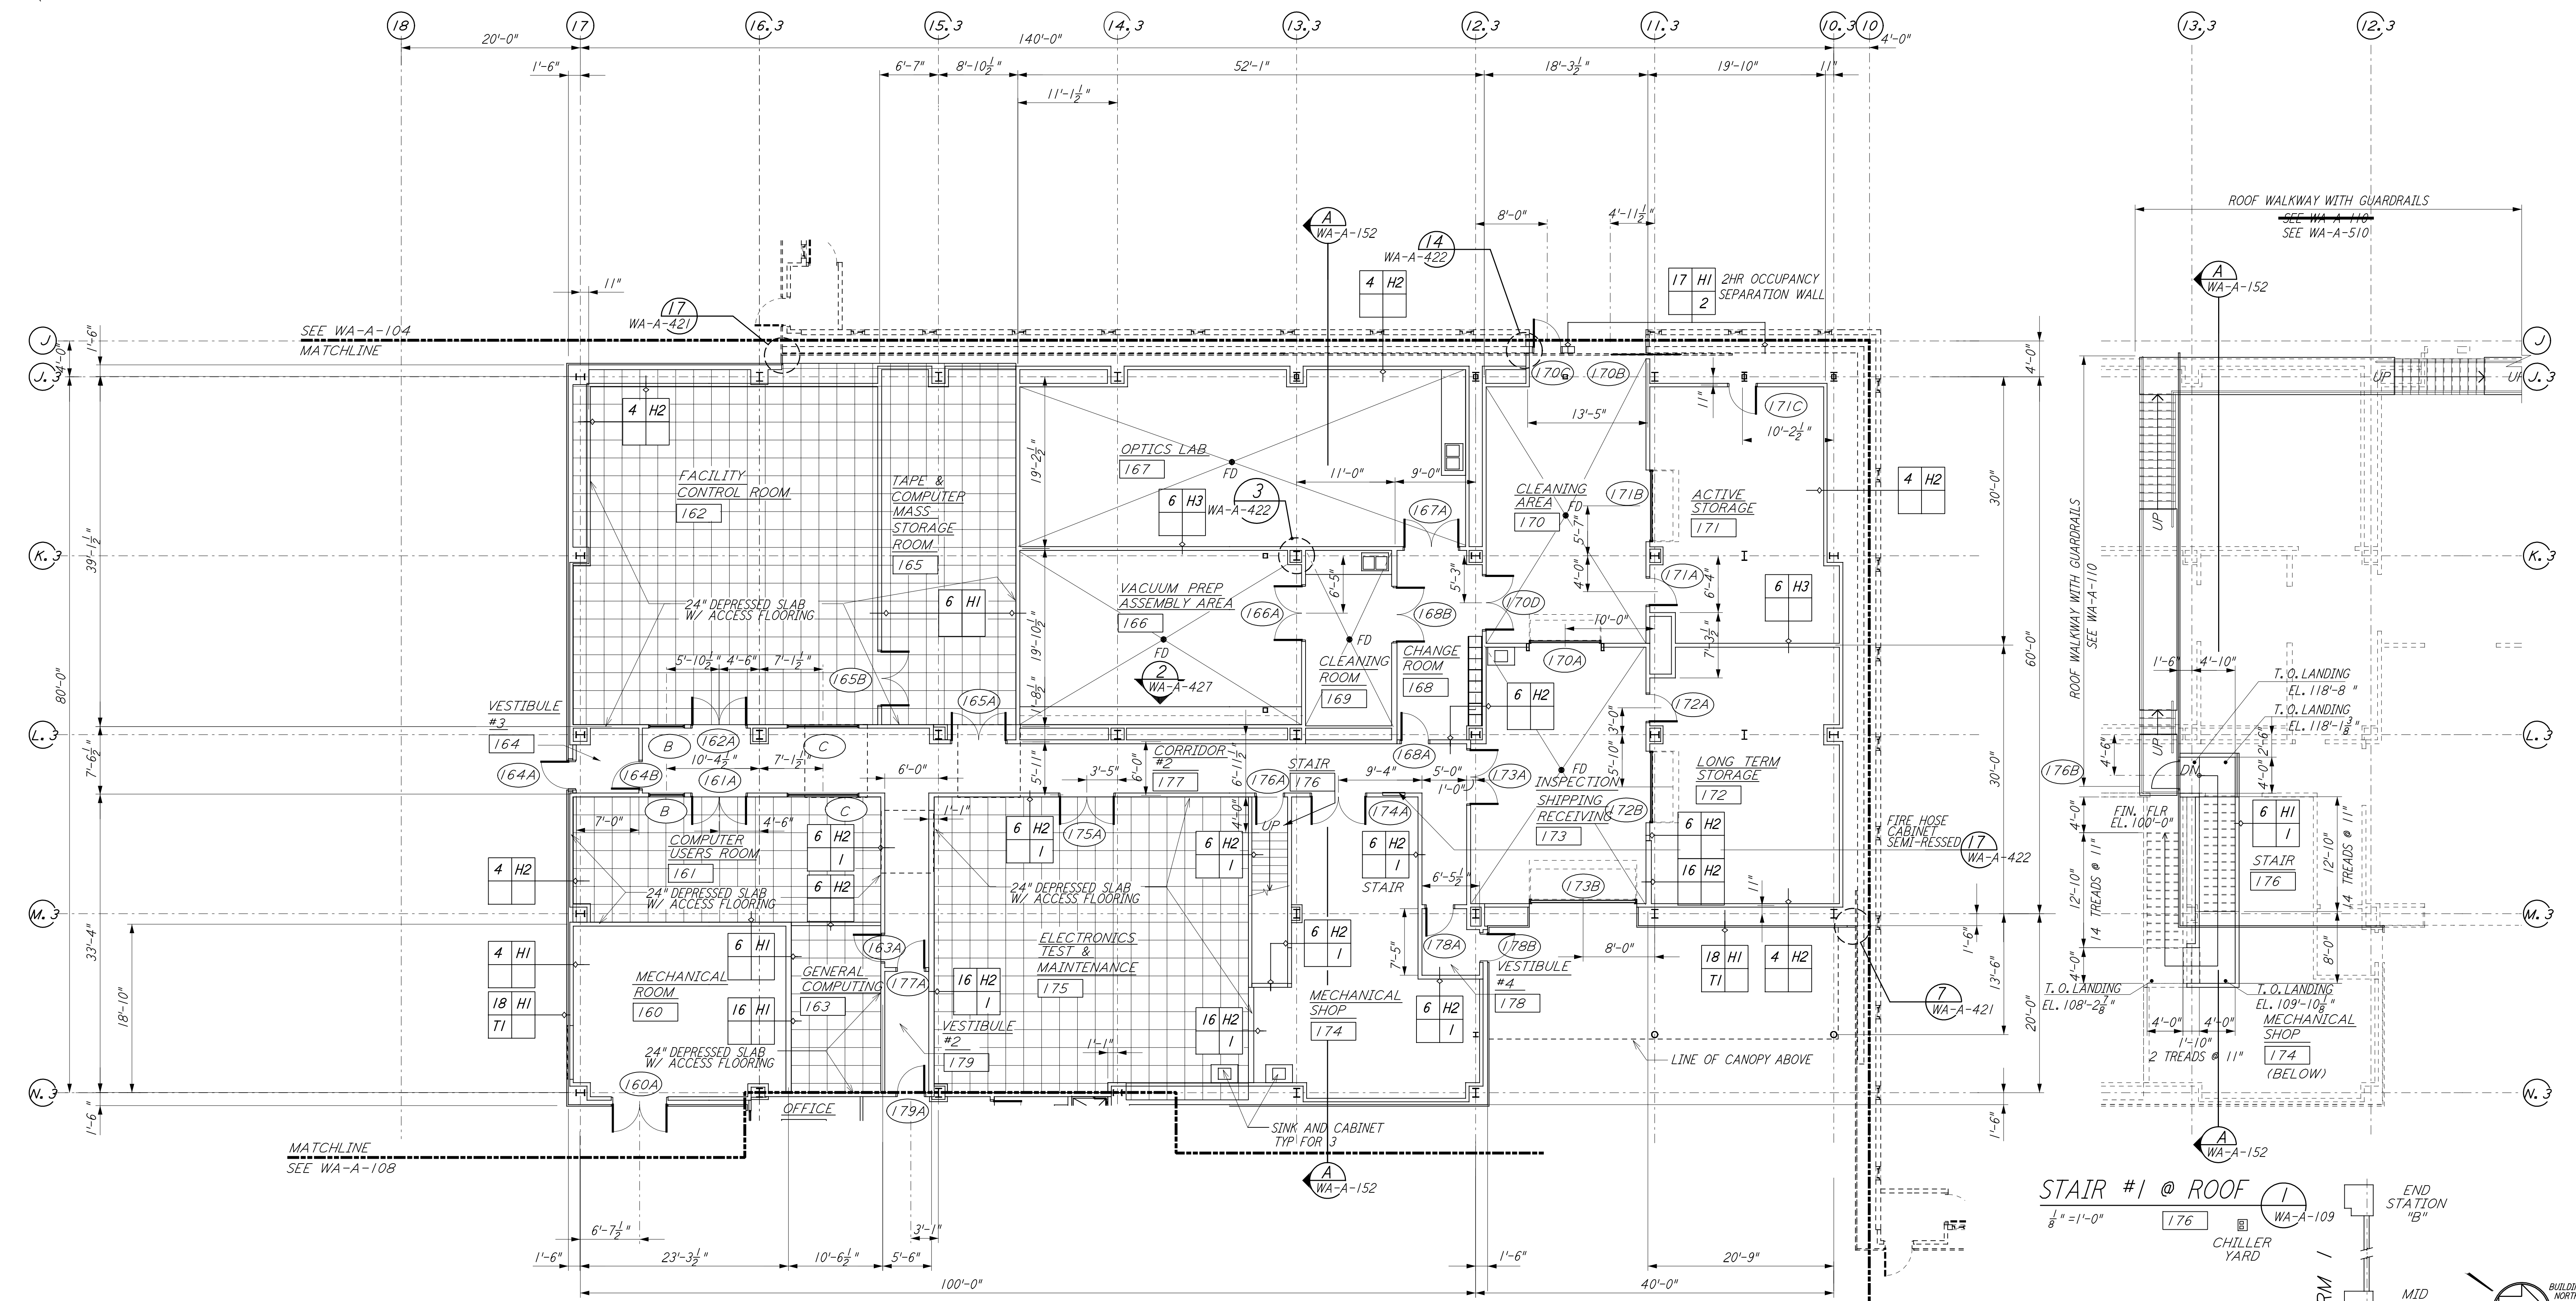

0 8 16 24 32 FT
 1" = 1'-0"
 DATUM POINT EL. +100.00 = 531.11' (LVEA)
 DATUM POINT EL. +100.00 = 531.11' (OSB)

KEY PLAN
LIGO-D960249-02-0

This document and the design it covers are the property of PARSONS. They are loaned only with the borrower's expressed written agreement that they will not be reproduced, copied, loaned, exhibited, or used in any other way, except by written consent from PARSONS to the borrower.

NO.	DATE	BY	CHKD	ENGR	PROJ	DESCRIPTION
2	5-15-98	CKT				ISSUED FOR AS-BUILT
1	2-28-97	CKT	TB	AK	TDM	OSB REVISION

NO.	DATE	BY	CHKD	ENGR	PROJ	DESCRIPTION
1	5-12-96	CKT				ISSUED FOR CONSTRUCTION
1	5-26-96	TB				CHECKED
1	7-12-96	bkk				ENGINEER
1	7-12-96	MDW				PROJ

AS-BUILT DRAWINGS

100 WEST WALNUT STREET
 PASADENA, CALIFORNIA

CALIFORNIA INSTITUTE OF TECHNOLOGY
 MASSACHUSETTS INSTITUTE OF TECHNOLOGY

LASER INTERFEROMETER
 GRAVITATIONAL-WAVE OBSERVATORY
 SITE NO. 1 - HANFORD, WASHINGTON

TITLE	ARCHITECTURAL CORNER STATION OSB PARTIAL FLOOR PLAN SHEET 2	SCALE	AS NOTED	PROJECT NUMBER	PP150969	PROJECT SHEET NUMBER	8094
SHEET NUMBER	WA-A-109	REVISIONS					

Note 1, Linda L Turner, 04/13/99 03:25:55 PM
LIGO-D960249-02-O