

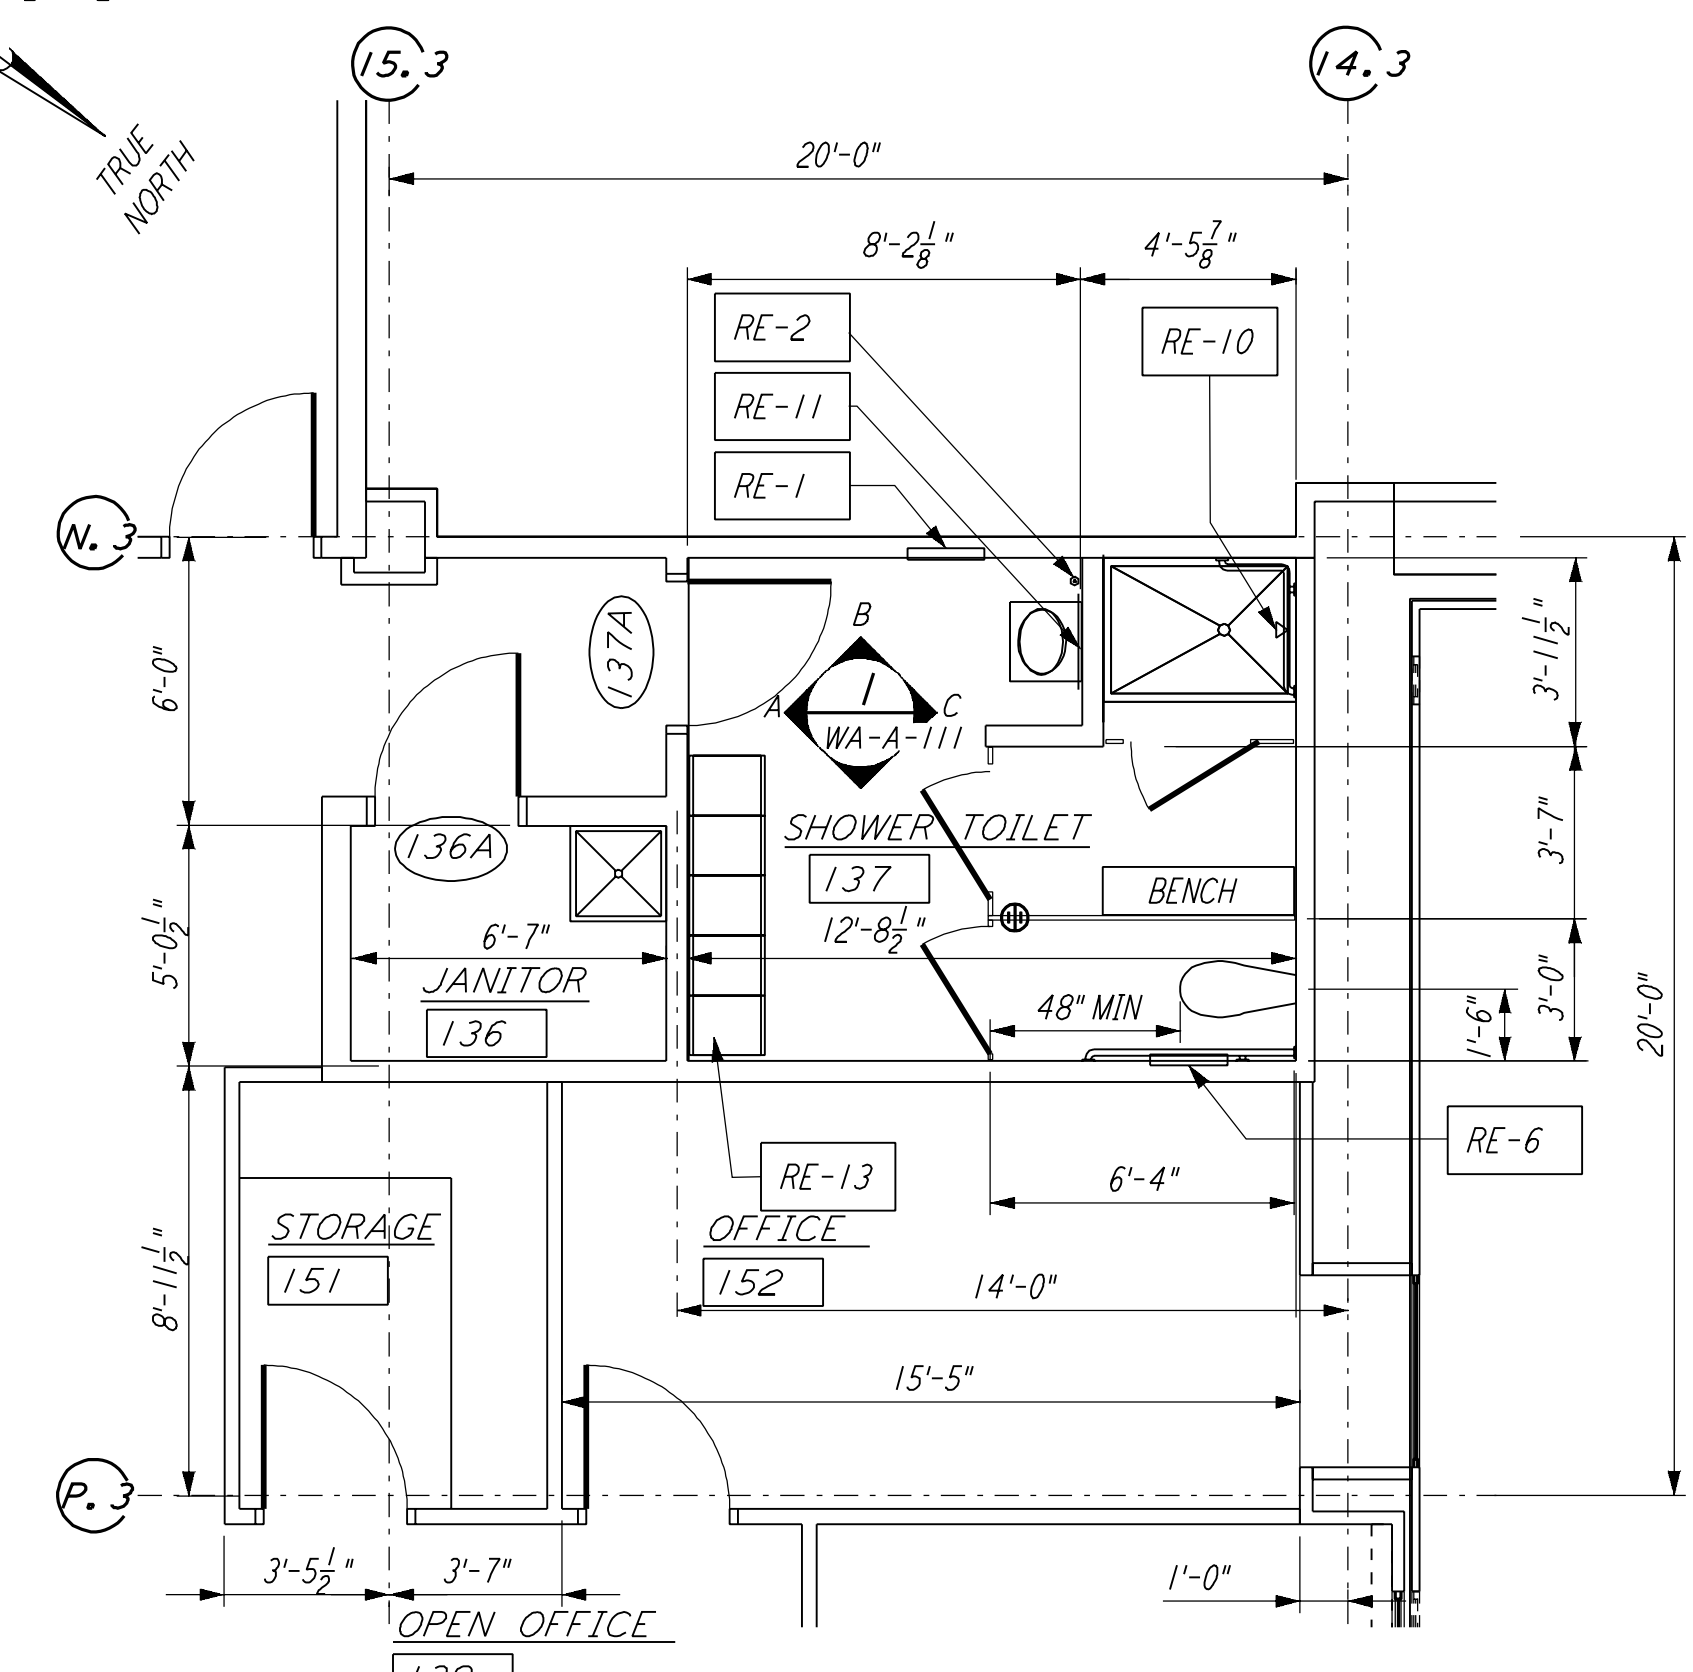


NOTE: SEE SPECIFICATIONS FOR ADDITIONAL INFORMATION AND SCHEDULES

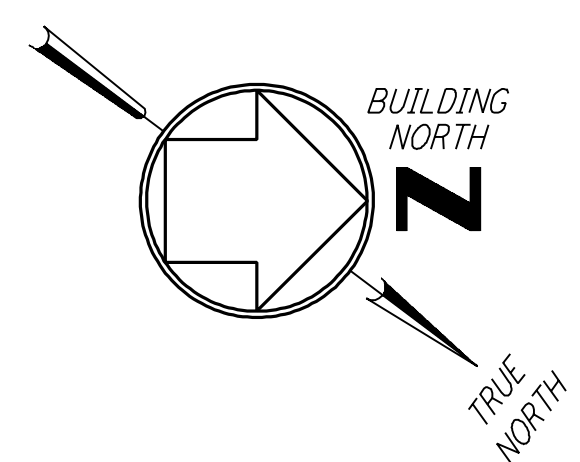


ENLARGED PLAN


JANITOR 136 / SHOWER TOILET 137
 1/4" = 1'-0"

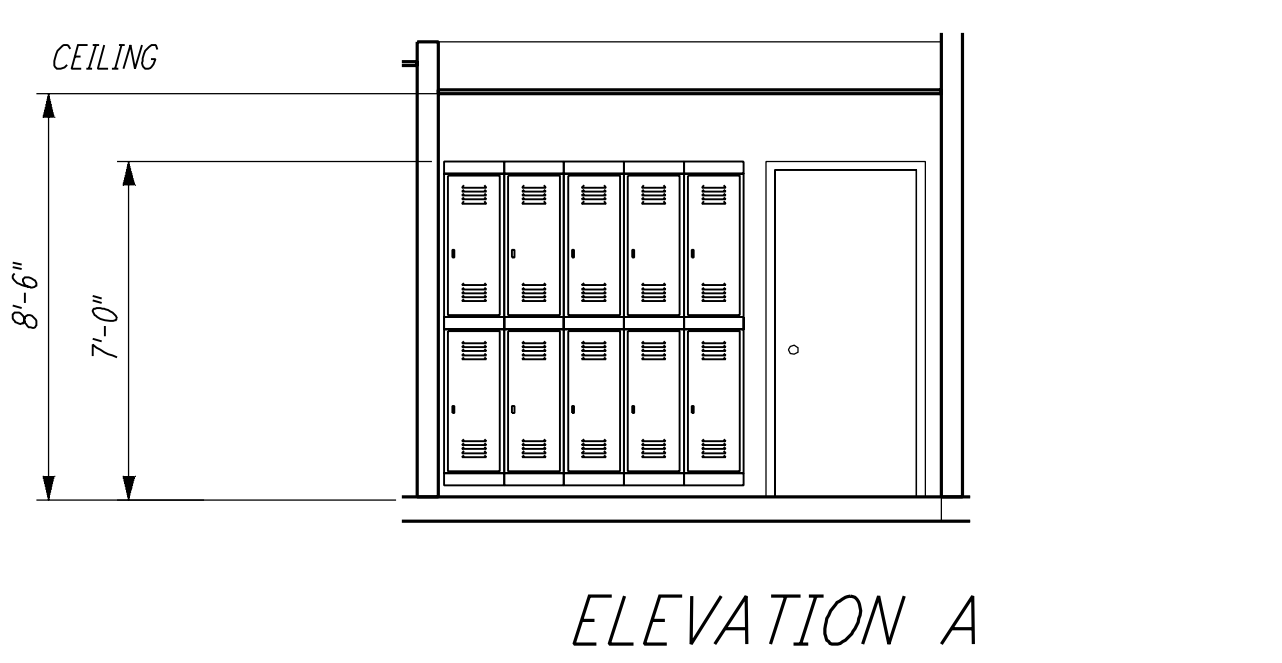

ELEVATION A

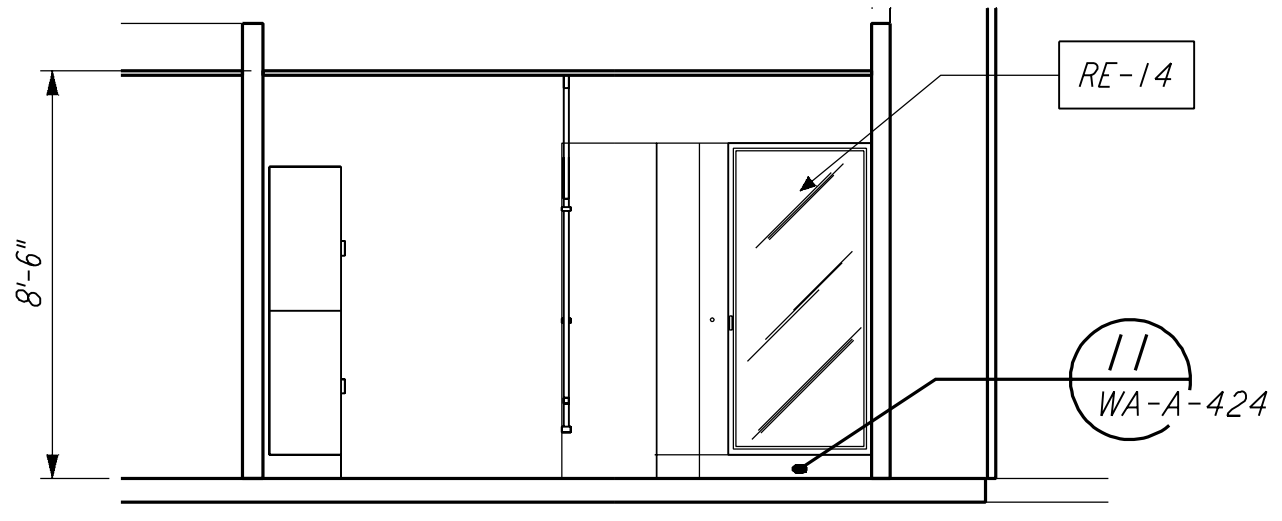


ELEVATION B

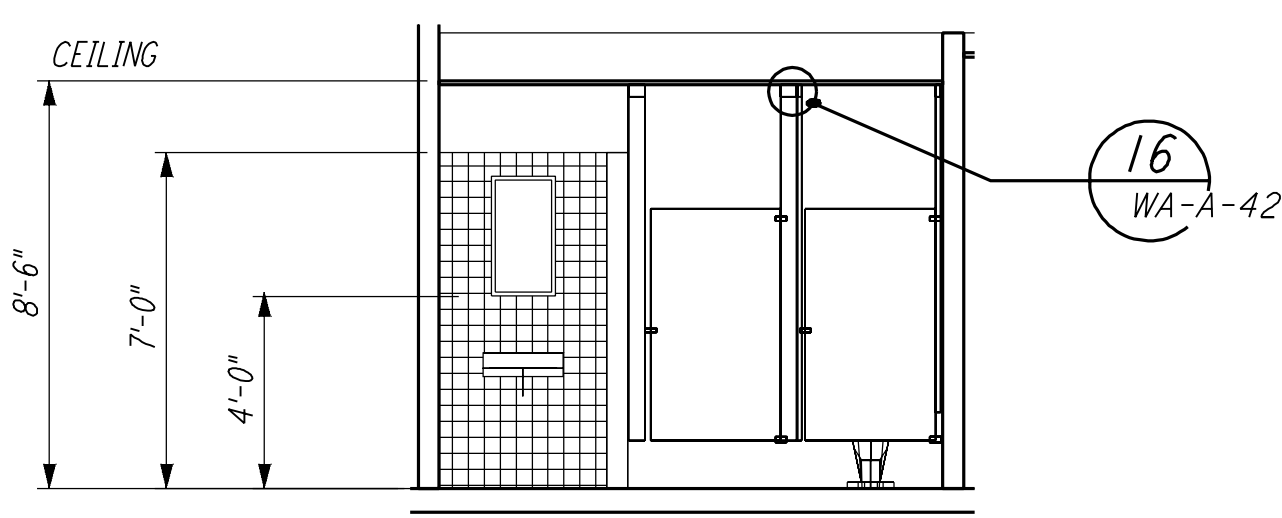


ELEVATION C

1 REF
 WA-A-111 WA-A-108

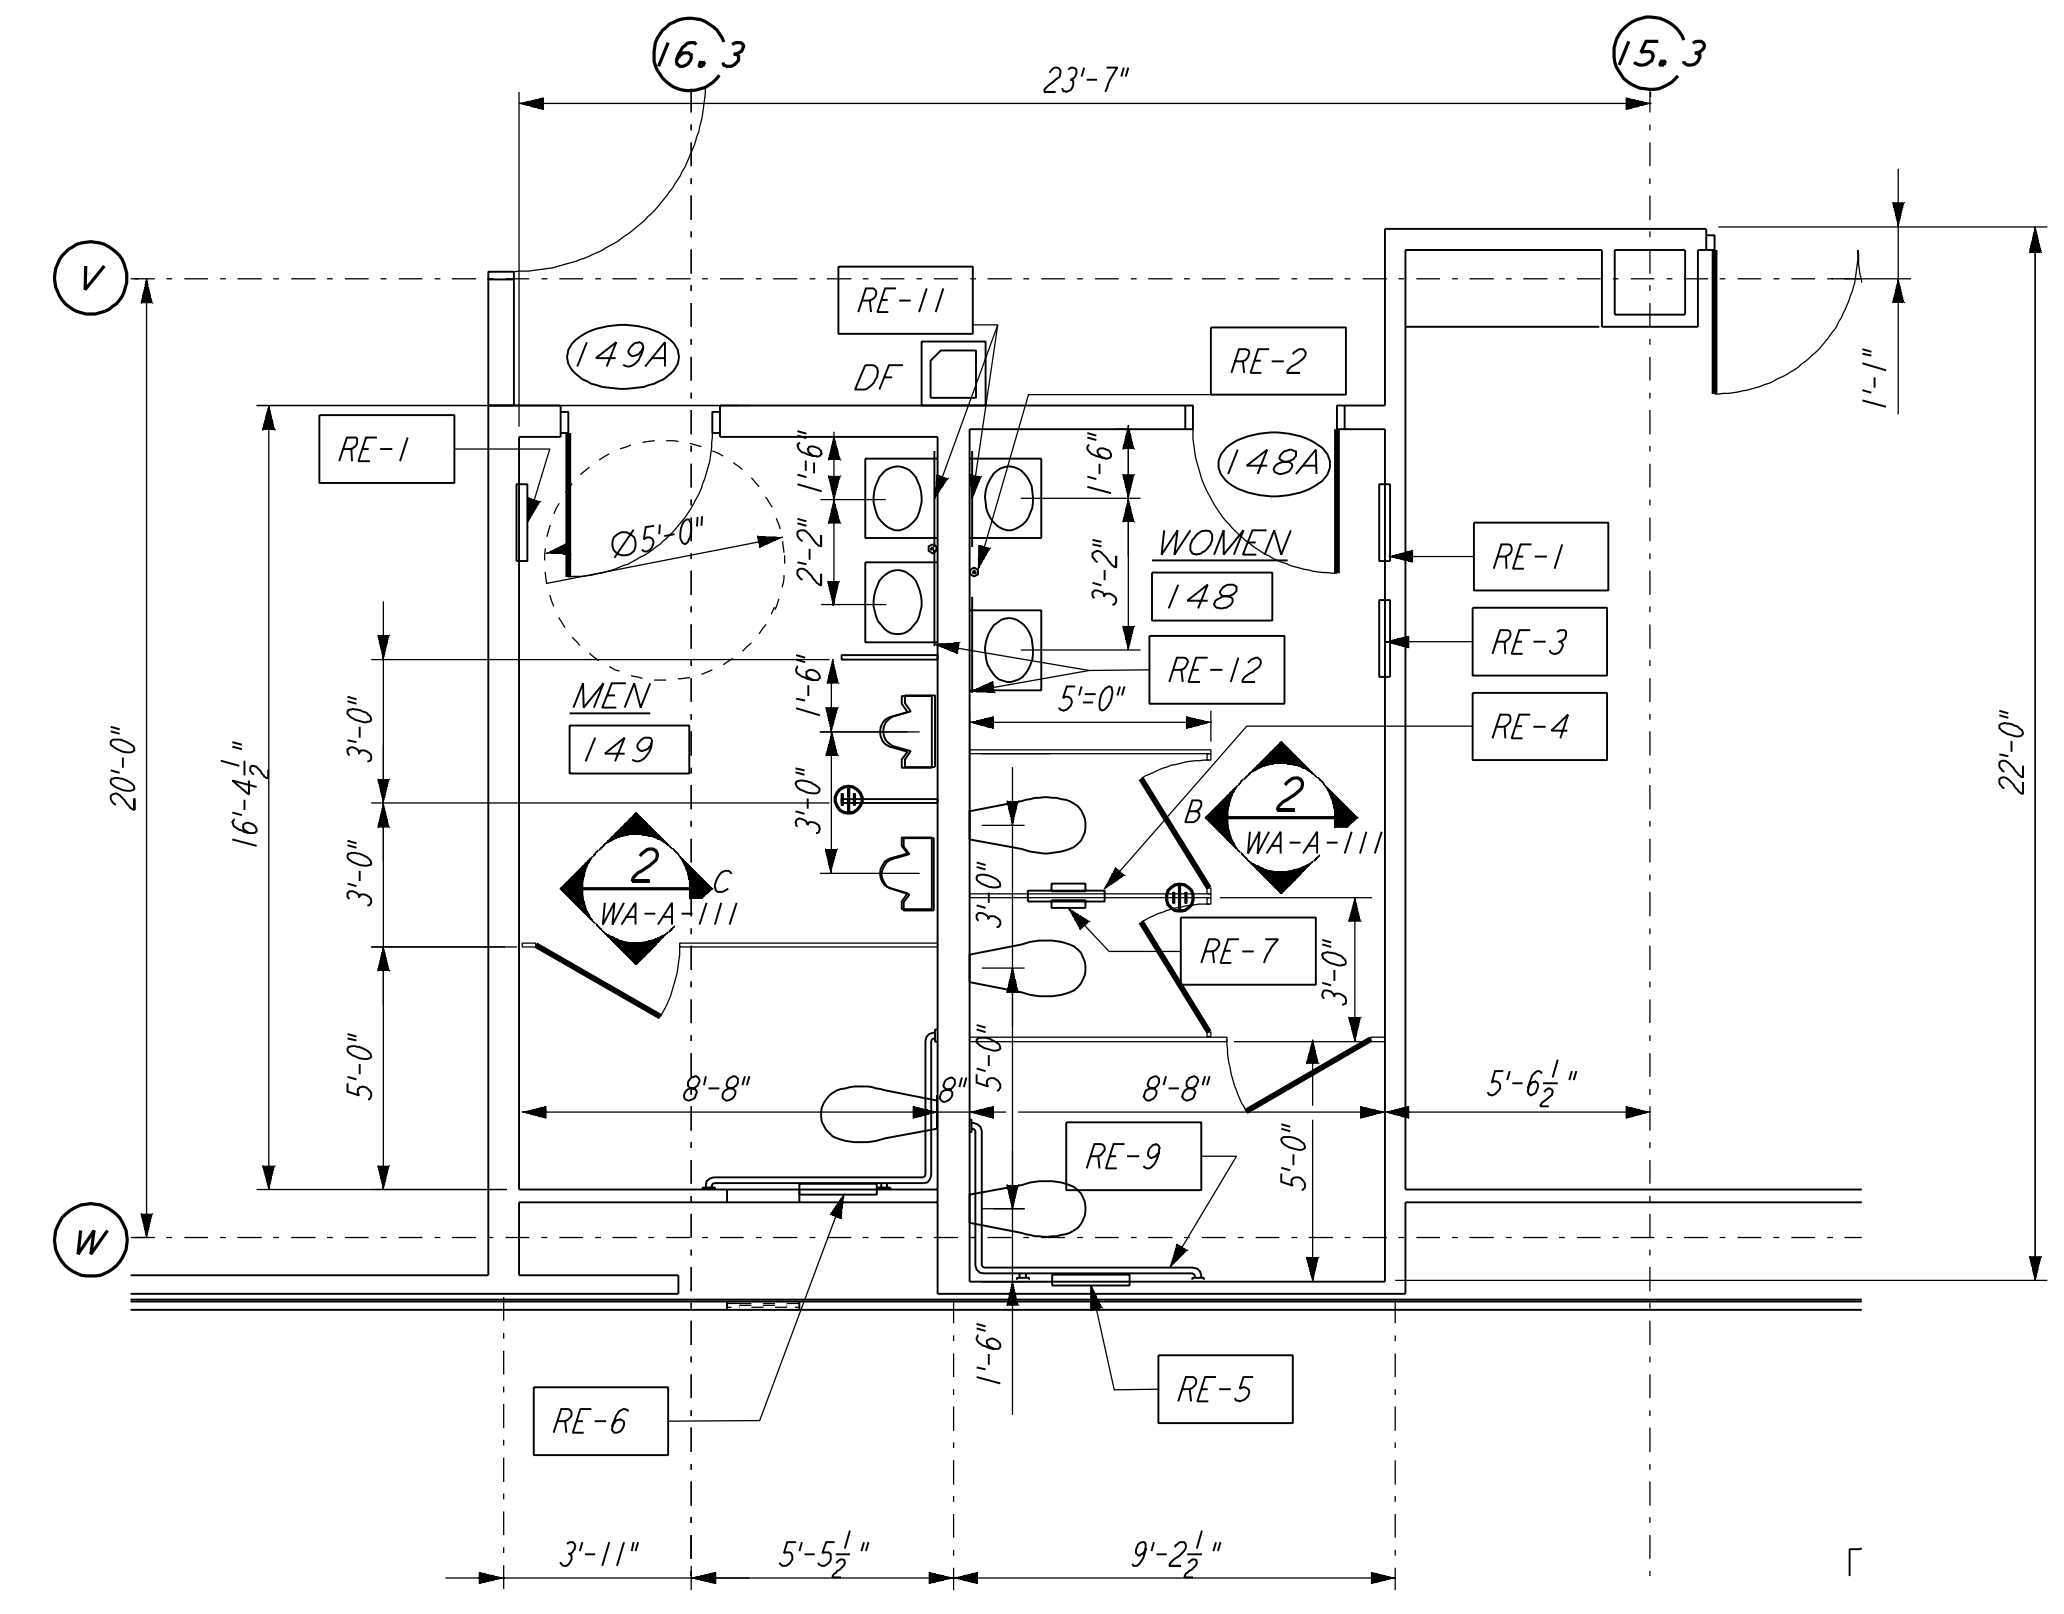


ENLARGED TOILET PLAN

MEN 149 / WOMEN 148
 1/4" = 1'-0"

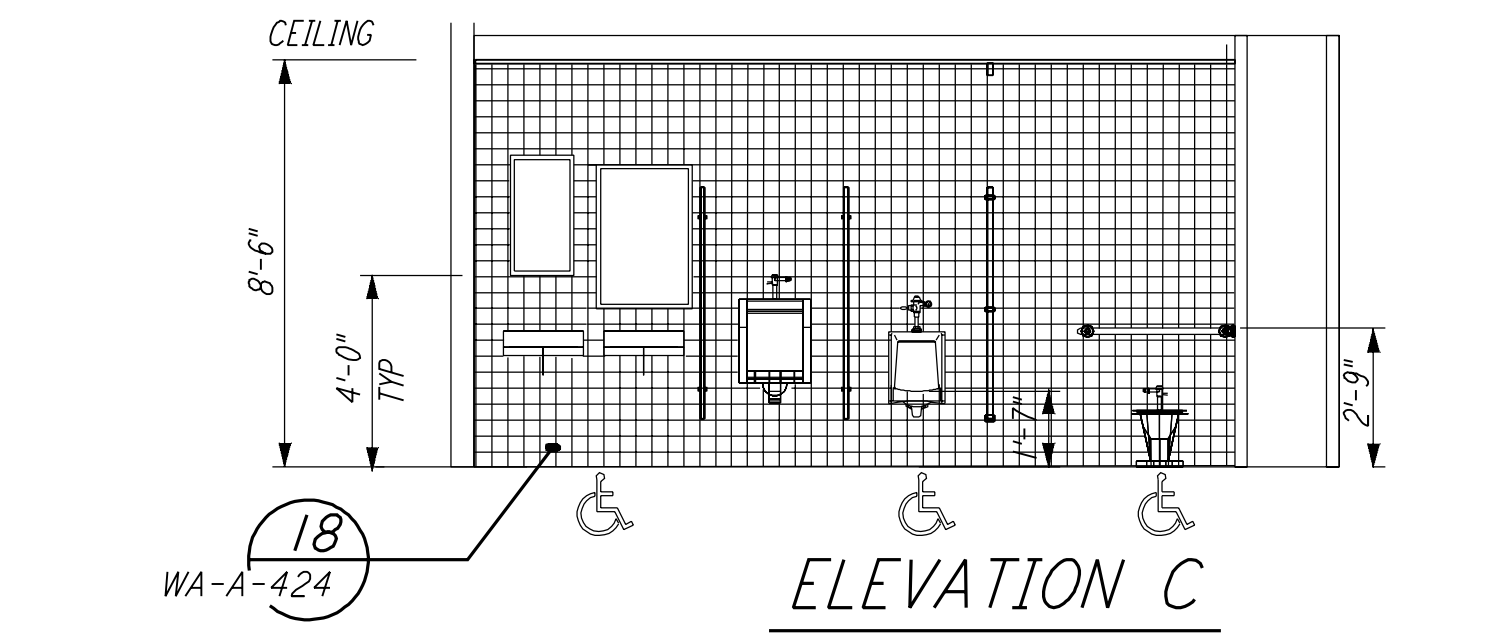


ELEVATION C

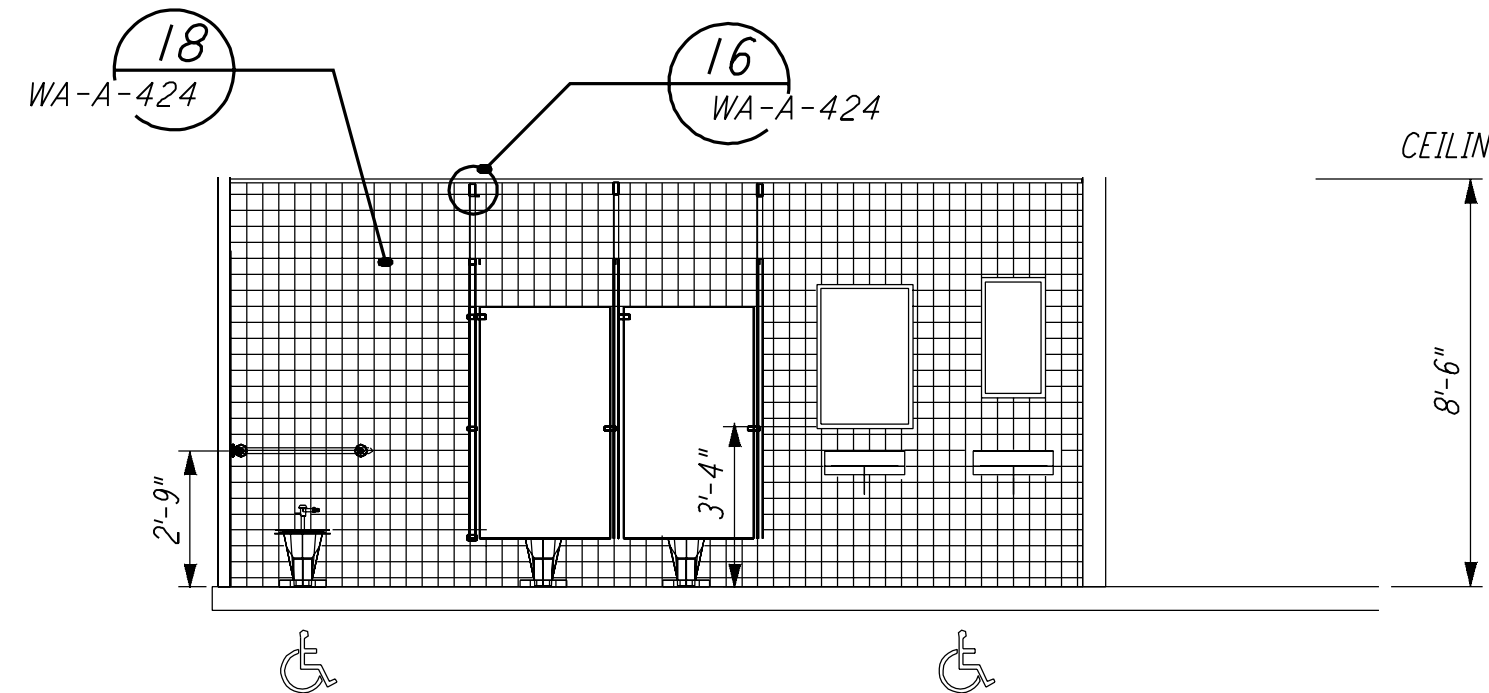


ELEVATION B

2 REF
 WA-A-111 WA-A-108

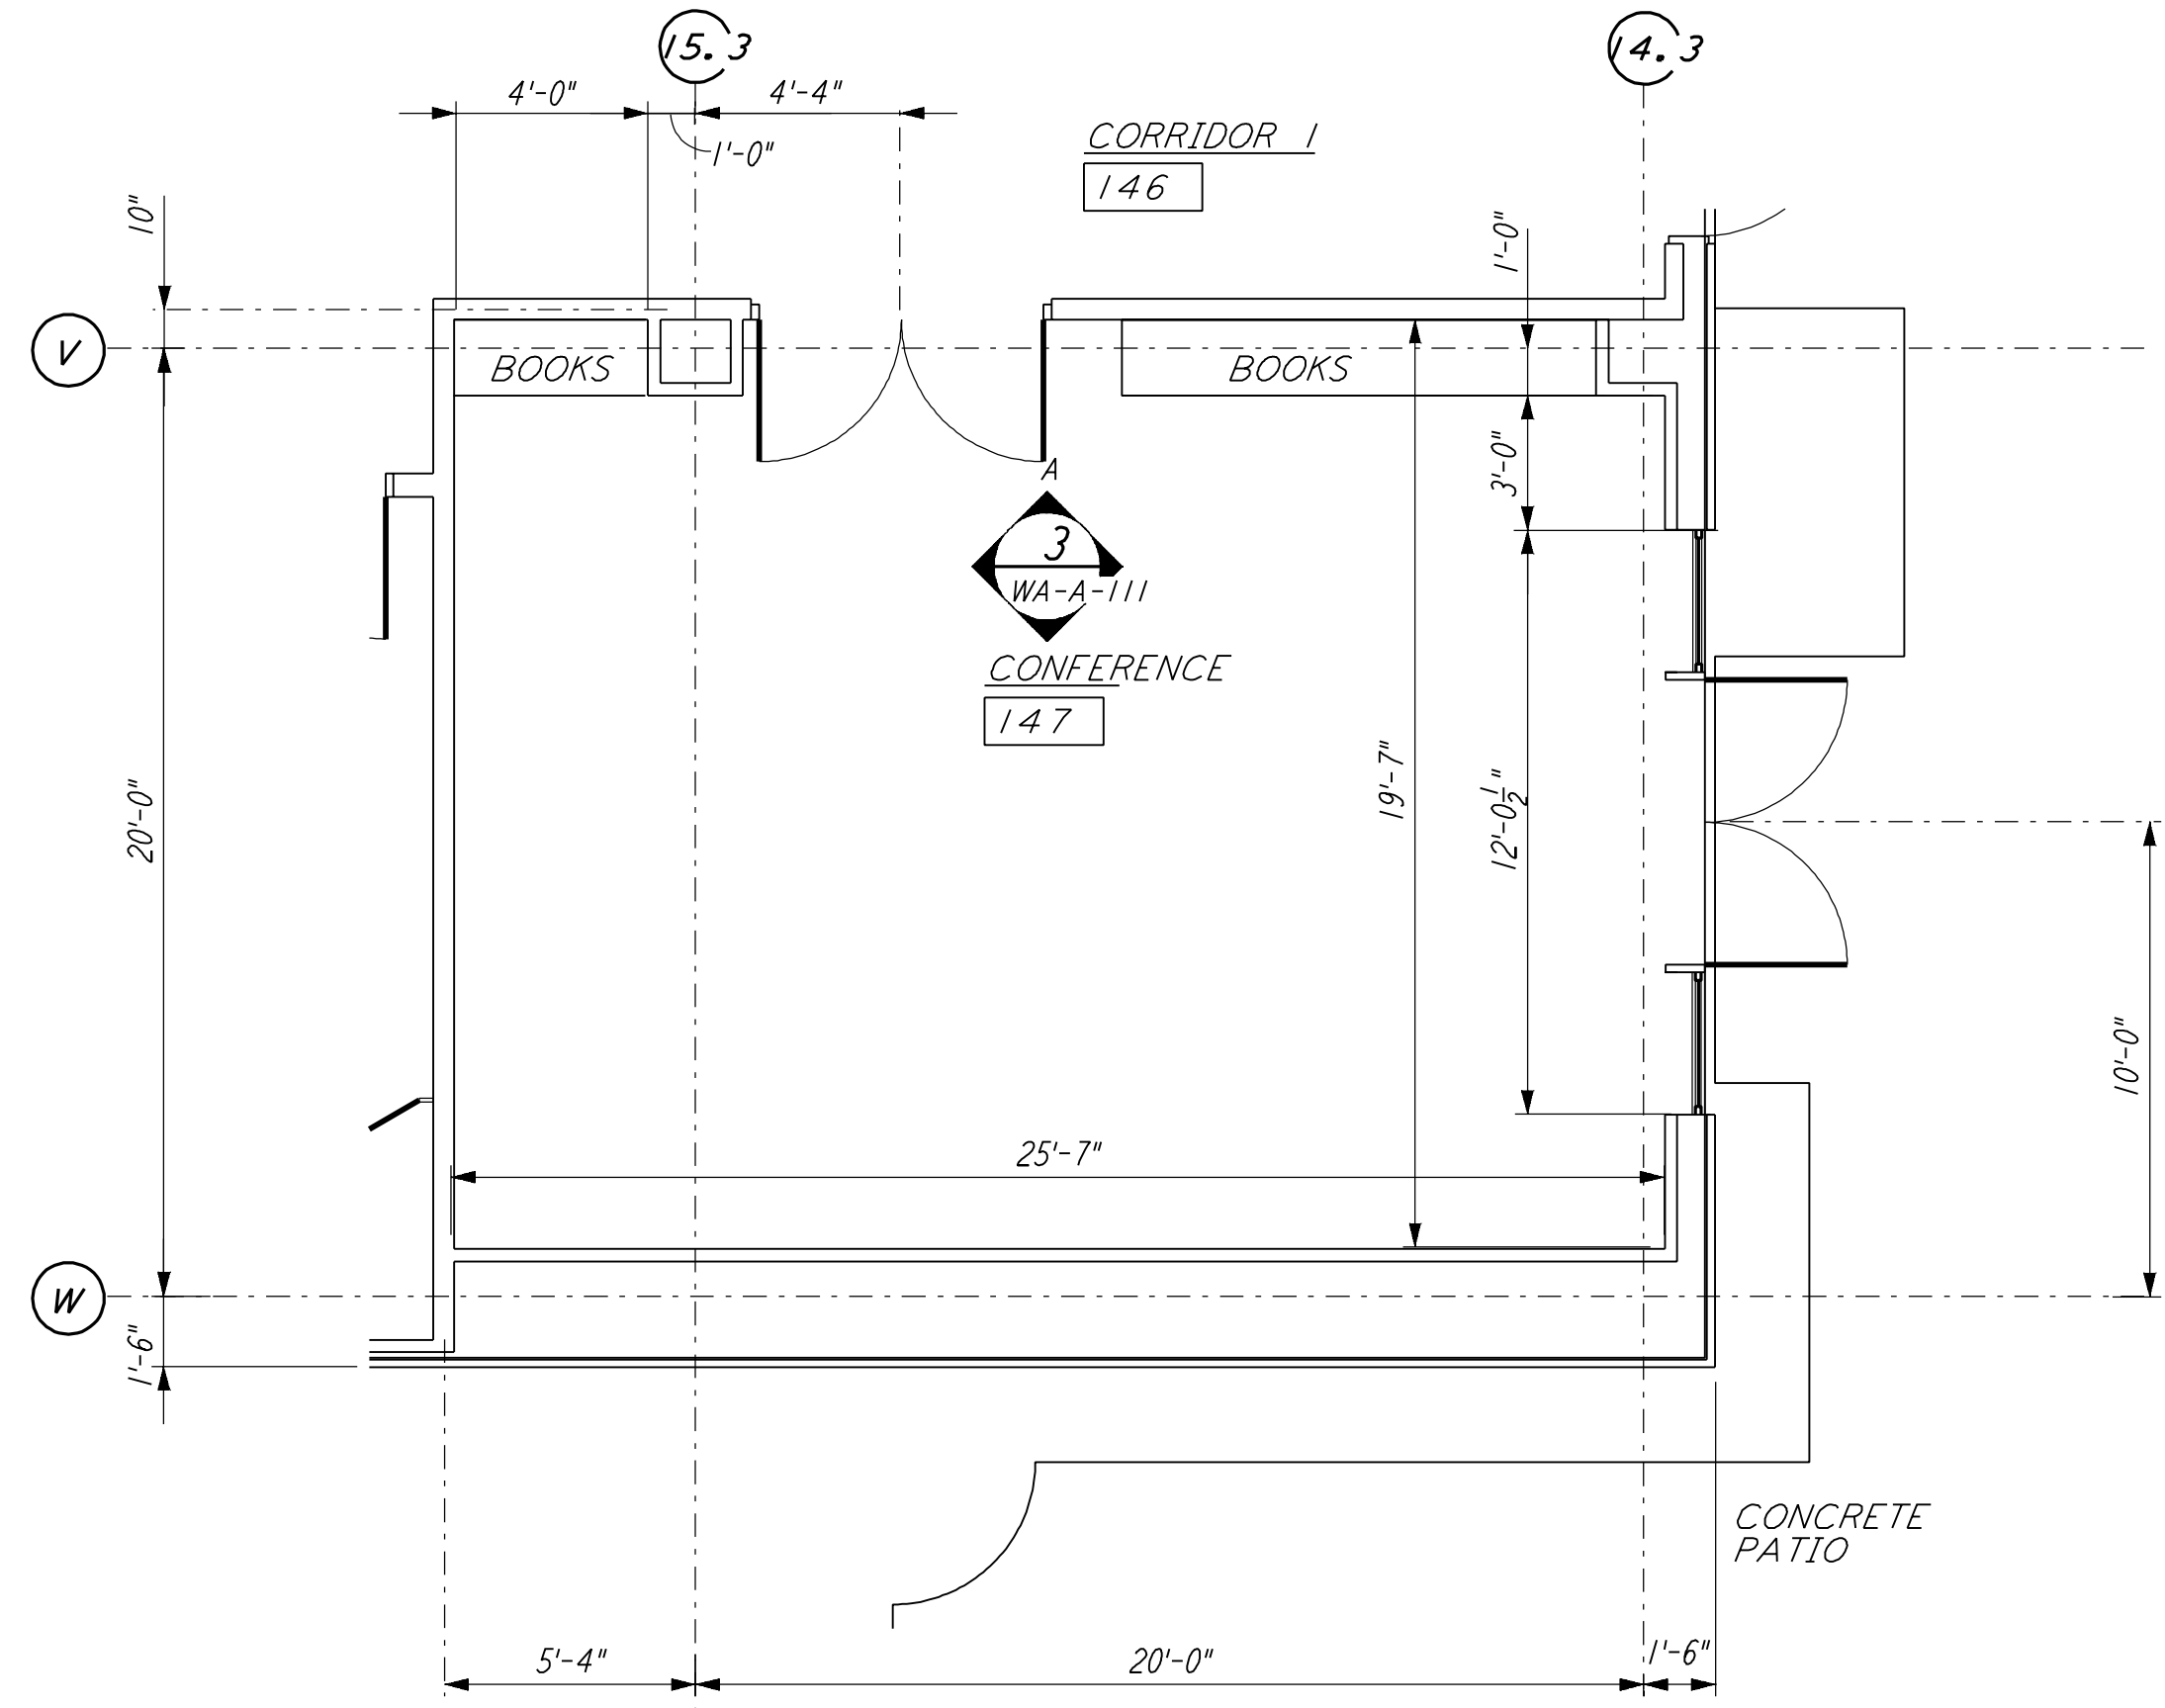


ENLARGED PLAN

CONFERENCE ROOM 147
 1/4" = 1'-0"

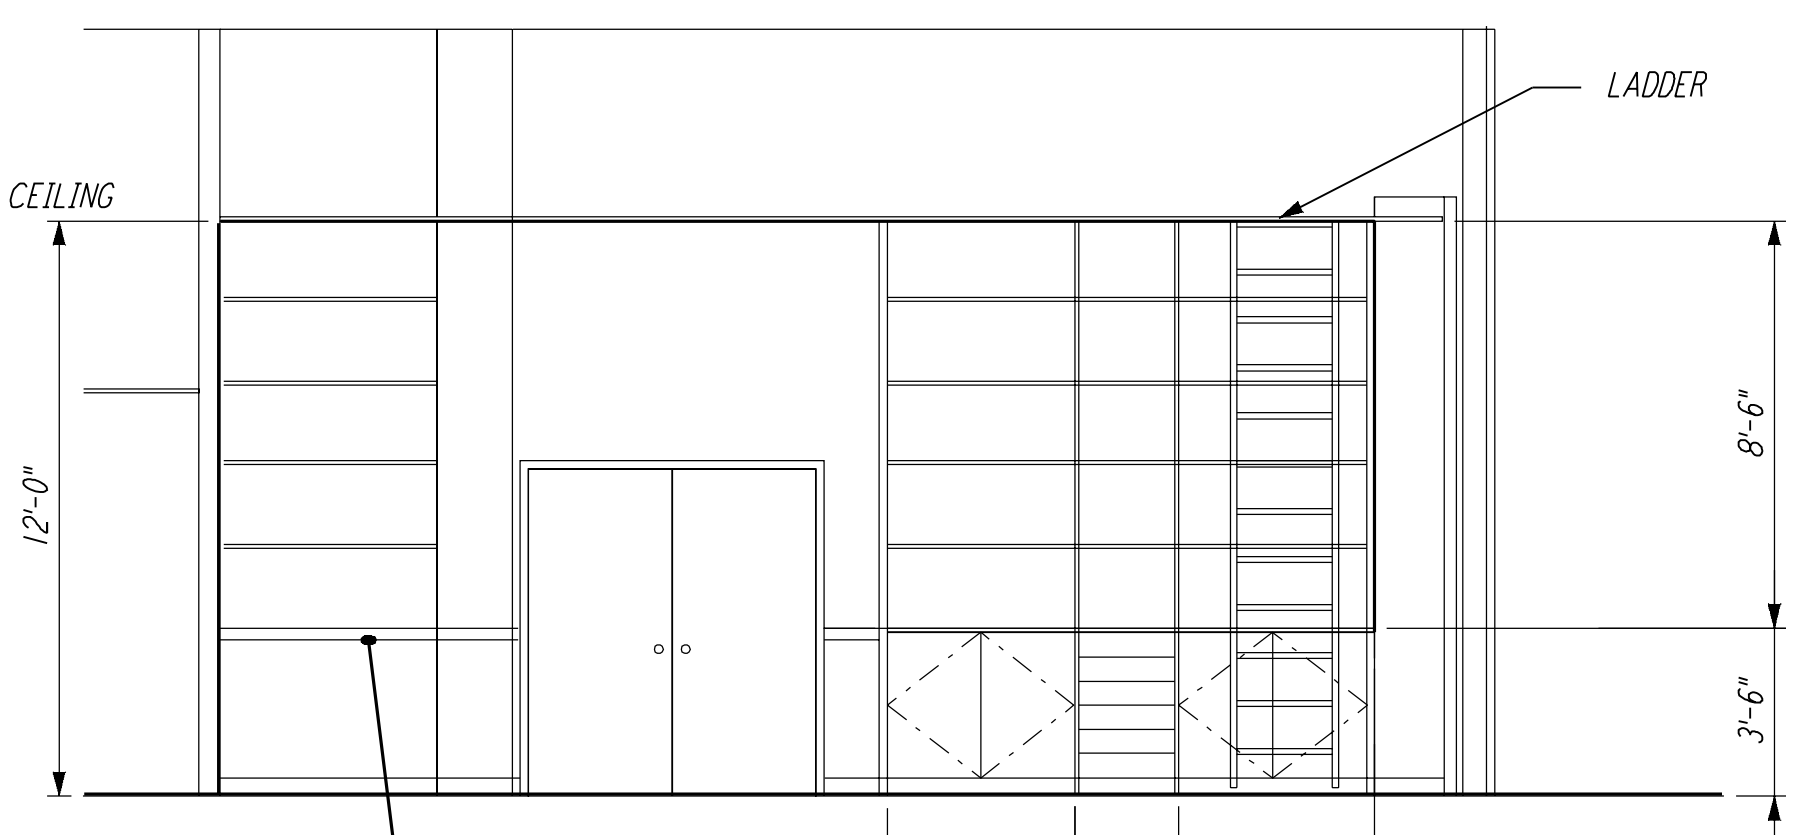


ELEVATION A

3 REF
 WA-A-111 WA-A-108

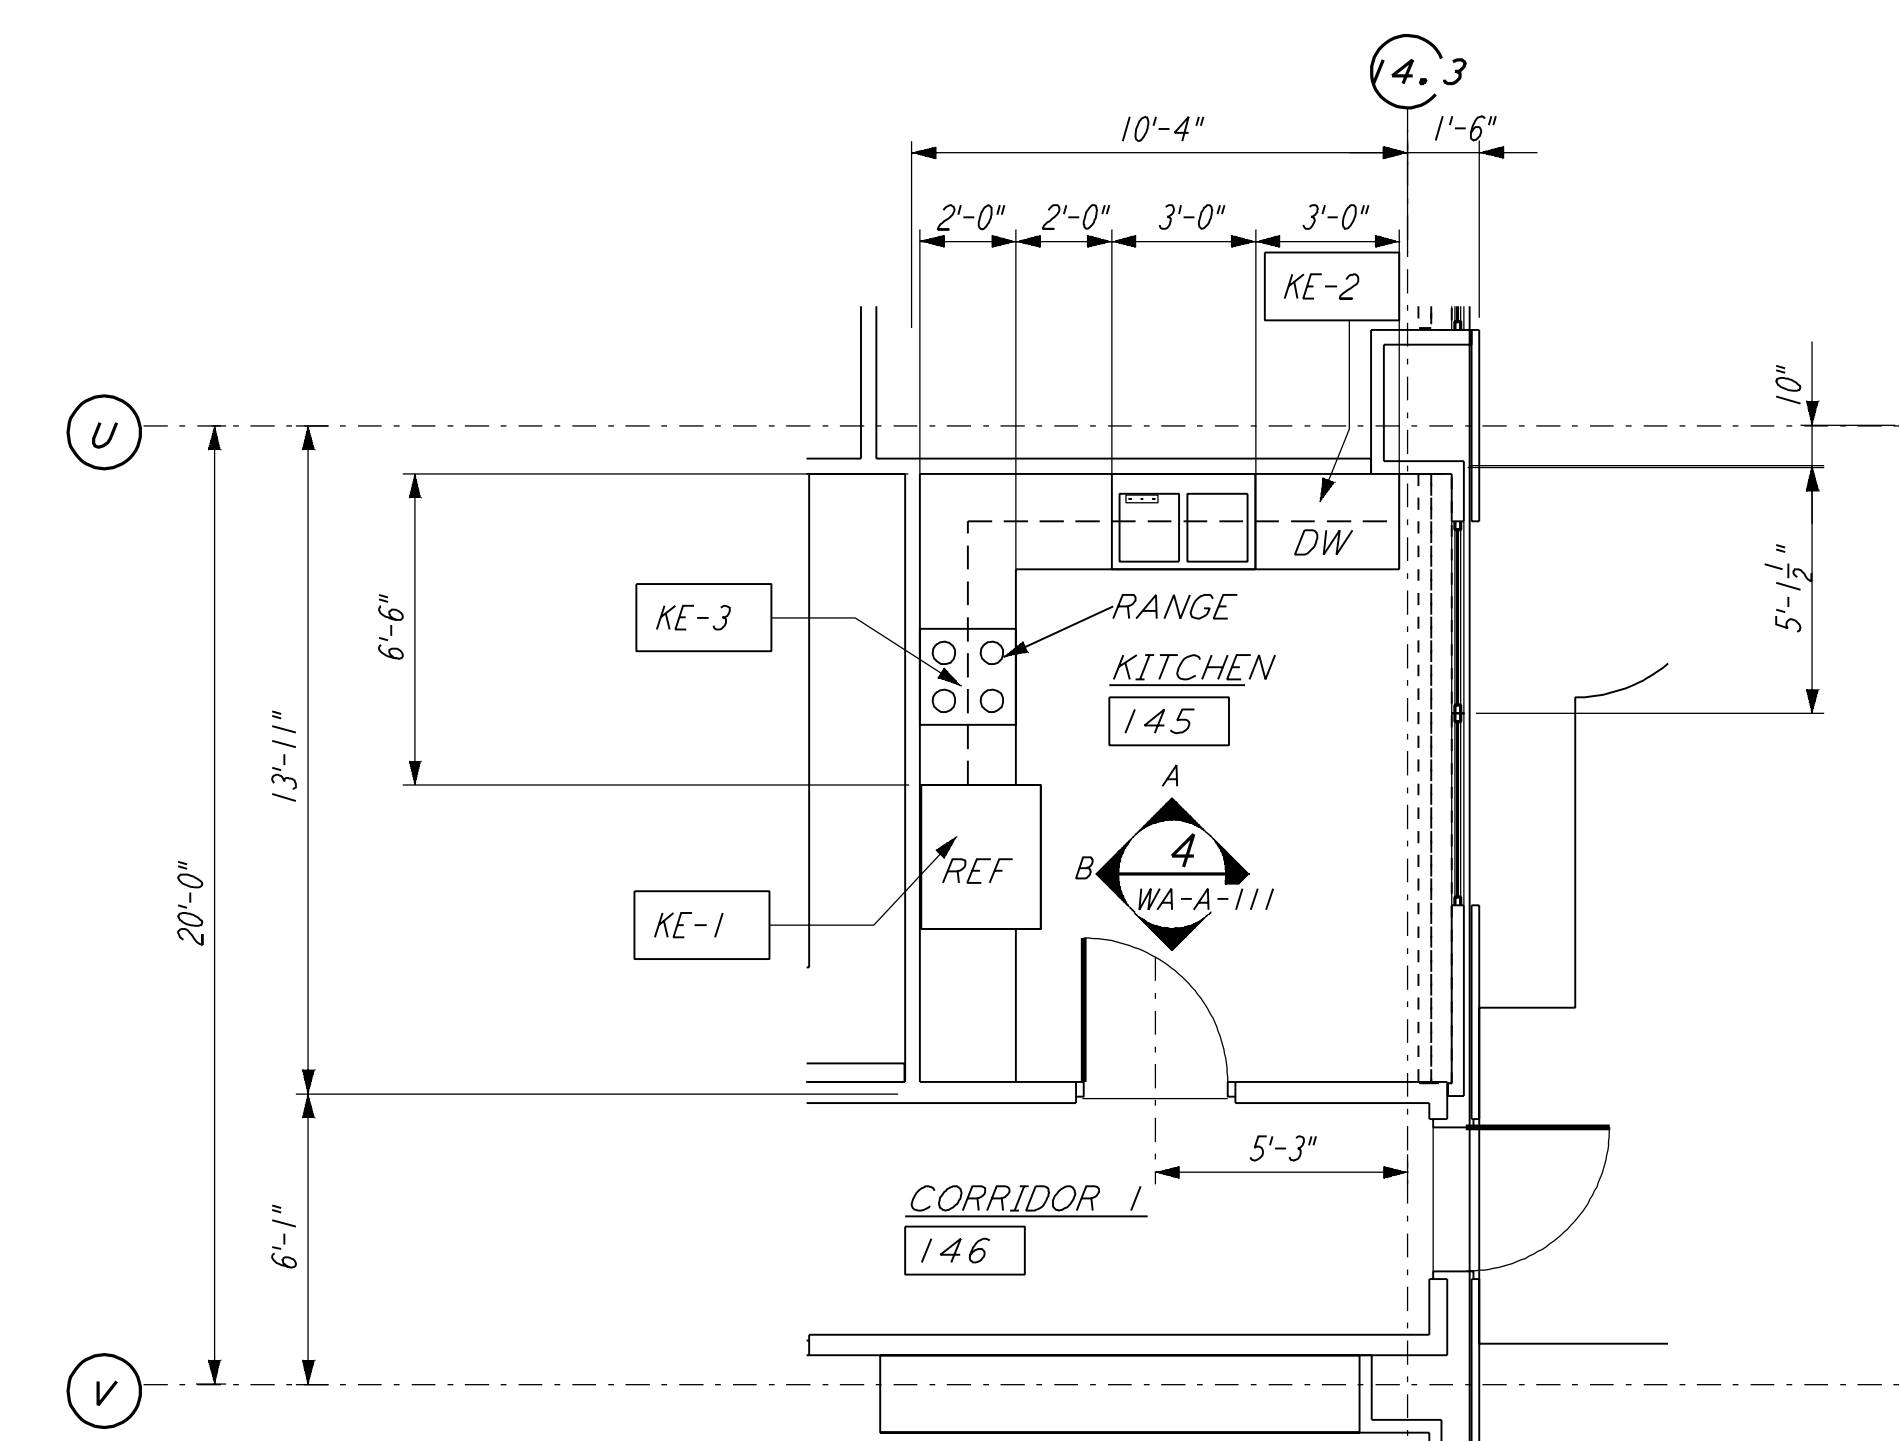


ENLARGED KITCHEN PLAN

KITCHEN PLAN 145
 1/4" = 1'-0"

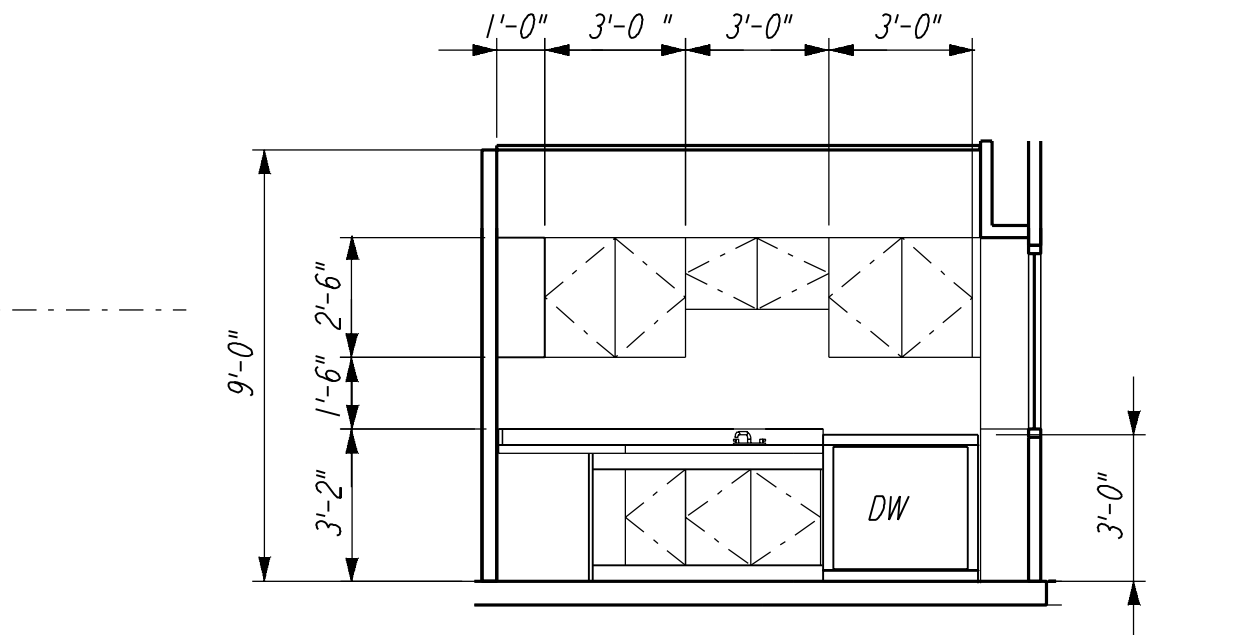


ELEVATION A

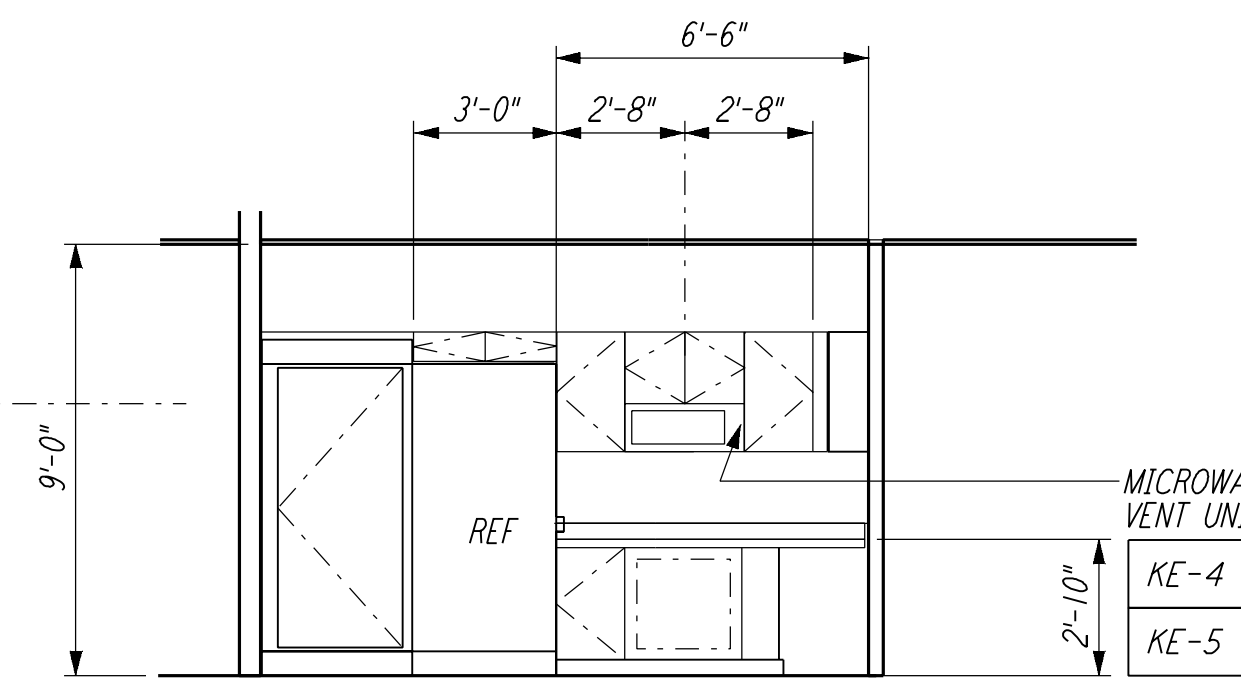

ELEVATION B

4 REF
 WA-A-111 WA-A-108

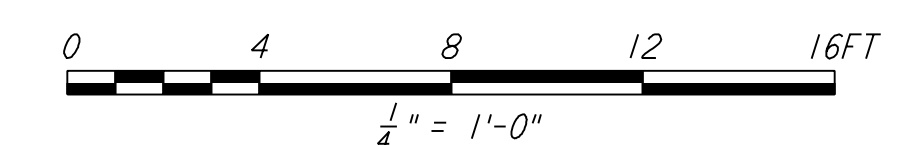

LIGO-D960250-02-0

LASER INTERFEROMETER
 GRAVITATIONAL-WAVE OBSERVATORY
 SITE NO. 1 - HANFORD, WASHINGTON

NO.	DATE	BY	CHKD	ENGR	PROJ	DESCRIPTION
1	2-28-97	CKT	TB	AK	TDM	ISSUED FOR AS-BUILT OSB REVISION
2	5-15-98	CKT				ISSUED FOR CONSTRUCTION

ISSUED FOR CONSTRUCTION	DATE	BY	CHKD	ENGR	PROJ
DRAWN	5-12-96	CKT			
CHECKED	5-26-96	TB			
ENGINEER	7-12-96	bkk			
PROJ	7-12-96	MDW			

AS-BUILT DRAWINGS



100 WEST WALNUT STREET
 PASADENA, CALIFORNIA



CALIFORNIA INSTITUTE OF TECHNOLOGY
 MASSACHUSETTS INSTITUTE OF TECHNOLOGY

ARCHITECTURAL CORNER STATION OSB ENLARGED PLANS
 AS NOTED PP150969 8094
 WA-A-111

This document and the design it covers are the property of PARSONS. They are loaned only with the borrower's expressed written agreement that they will not be reproduced, copied, loaned, exhibited, or used in any other way, except by written consent from PARSONS to the borrower.

This document and the design it covers are the property of PARSONS. They are loaned only with the borrower's expressed written agreement that they will not be reproduced, copied, loaned, exhibited, or used in any other way, except by written consent from PARSONS to the borrower.

I:\ligo\site1\or\wall11.d3z

Note 1, Linda L Turner, 04/13/99 04:21:18 PM
LIGO-D960250-02-O