


This document and the design it covers are the property of PARSONS. They are loaned only with the borrower's expressed written agreement that they will not be reproduced, copied, loaned, exhibited, or used in any other way, except by written consent from PARSONS to the borrower.

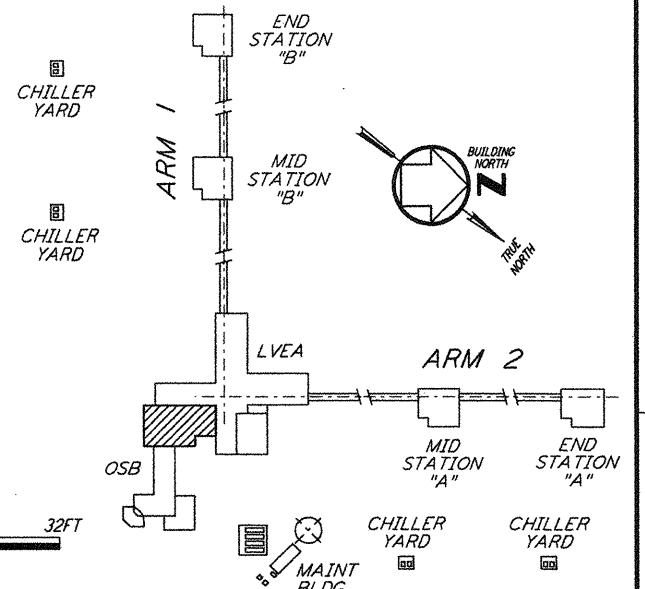

DATUM POINT EL +100.00 = 531.11' (LVEA)  
 DATUM POINT EL +100.00 = 531.11' (OSB)

**KEY PLAN**  
**LIGO-D960253-01-0**

| DRAWING NO. | DESCRIPTION         | NO.     | DATE | BY  | CHKD | ENGR | PROJ | DESCRIPTION         |
|-------------|---------------------|---------|------|-----|------|------|------|---------------------|
| 1           | ISSUED FOR AS-BUILT | 2-28-97 | CKT  | AKK | KAB  | MDW  |      | ISSUED FOR AS-BUILT |

ISSUED FOR CONSTRUCTION  
 DRAWN: CKT 5-12-96  
 CHECKED: TB 5-26-96  
 ENGINEER: DKK 7-12-96  
 PROJ: MDW 7-12-96

**AS-BUILT DRAWINGS**

**PARSONS**  
 100 WEST WALNUT STREET  
 PASADENA, CALIFORNIA

**LIGO**  
 CALIFORNIA INSTITUTE OF TECHNOLOGY  
 MASSACHUSETTS INSTITUTE OF TECHNOLOGY

**LASER INTERFEROMETER  
 GRAVITATIONAL-WAVE OBSERVATORY  
 SITE NO. 1 - HANFORD, WASHINGTON**

ARCHITECTURAL CORNER STATION OSB PARTIAL REFLECTED CEILING PLAN SHEET 2

AS NOTED PP150969 8094  
**WA-A-123**