




This document and the design it covers are the property of PARSONS. They are loaned only with the borrower's expressed written agreement that they will not be reproduced, copied, loaned, exhibited, or used in any other way, except by written consent from PARSONS to the borrower.

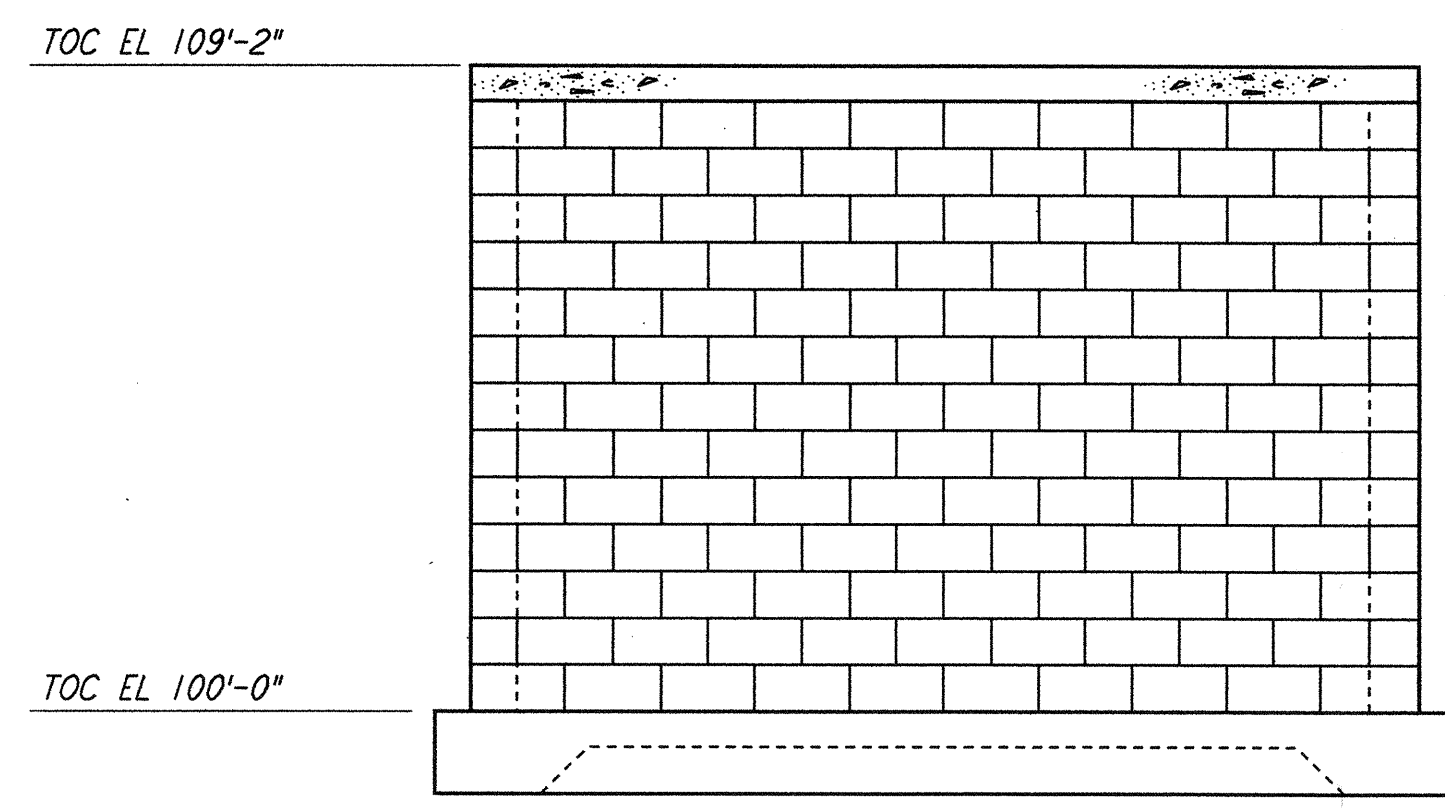


ELEVATION A REF
 $\frac{3}{8}'' = 1'-0''$ WA-S-203 WA-S-202

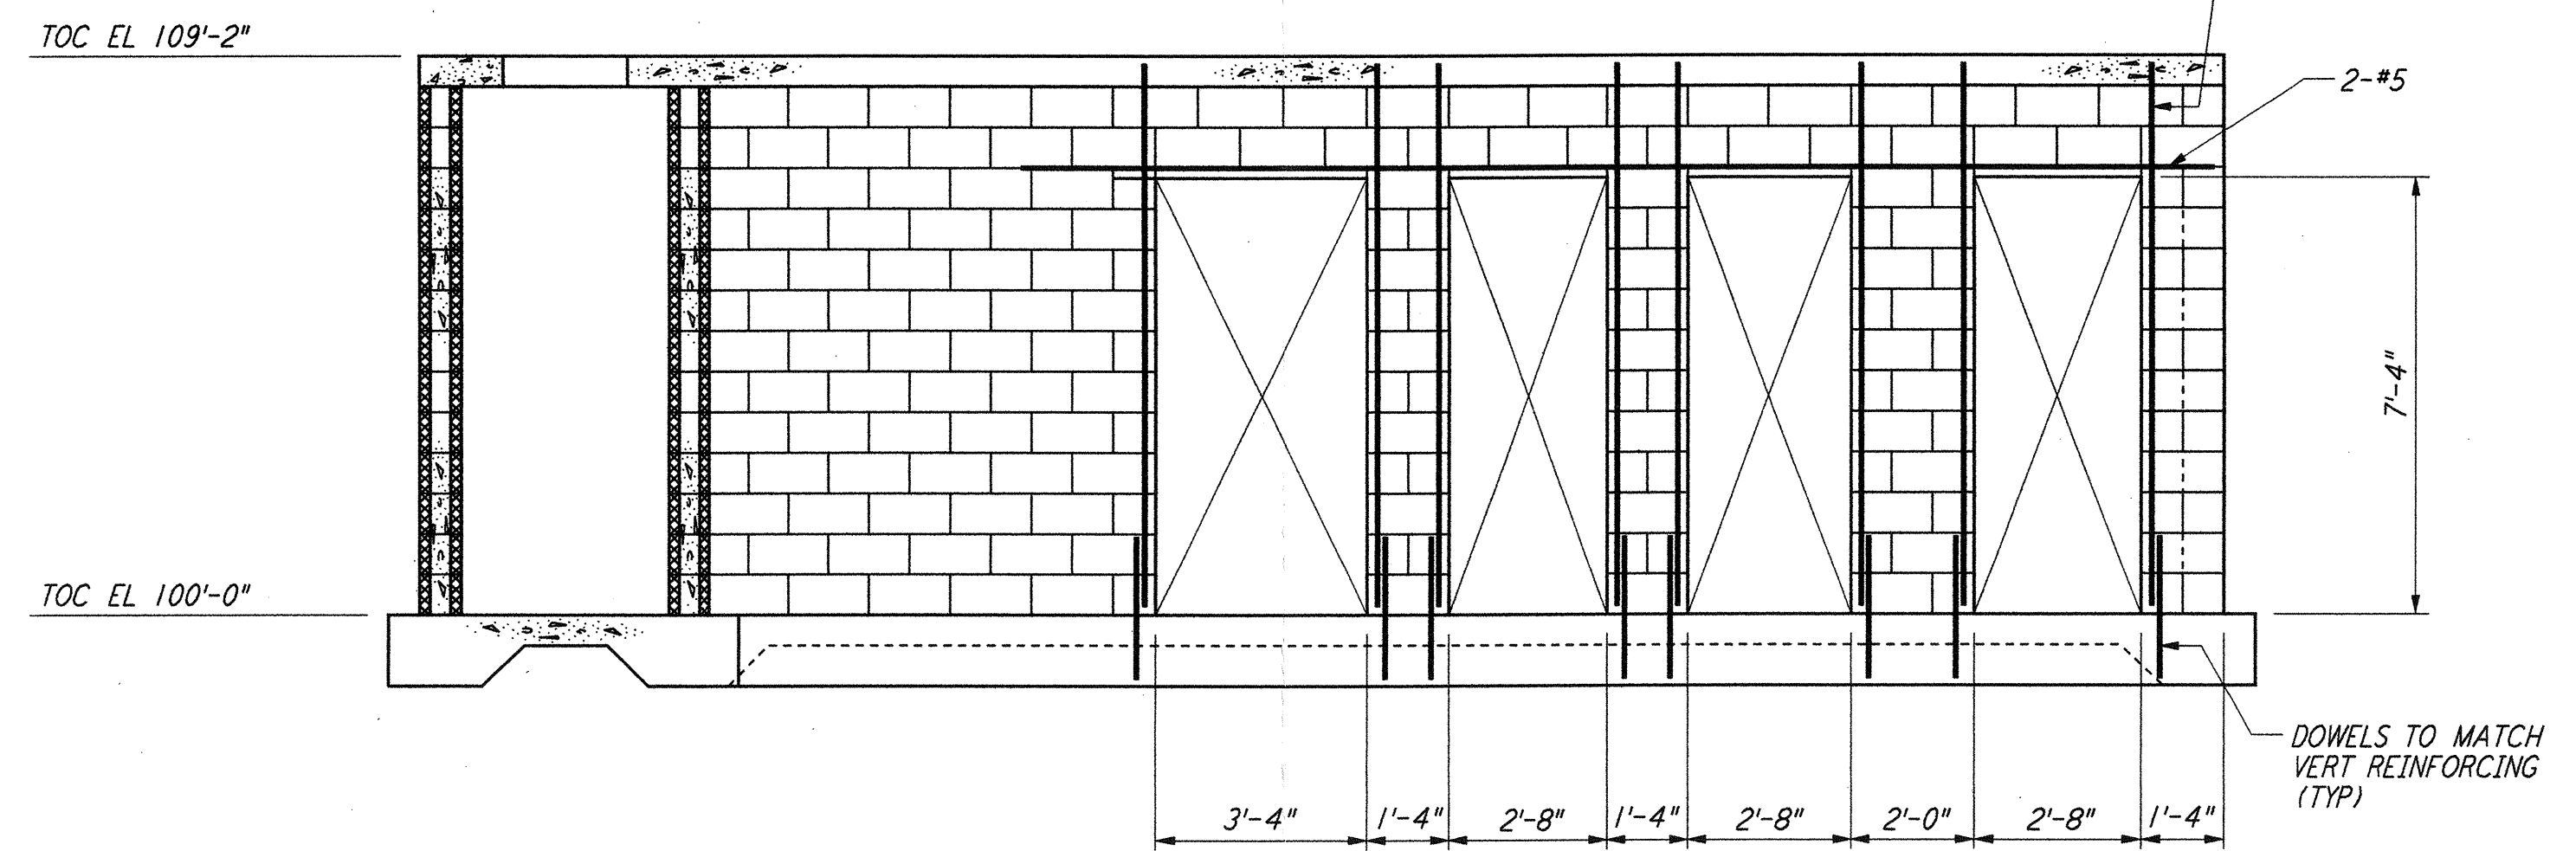


ELEVATION B REF
 $\frac{3}{8}'' = 1'-0''$ WA-S-203 WA-S-202

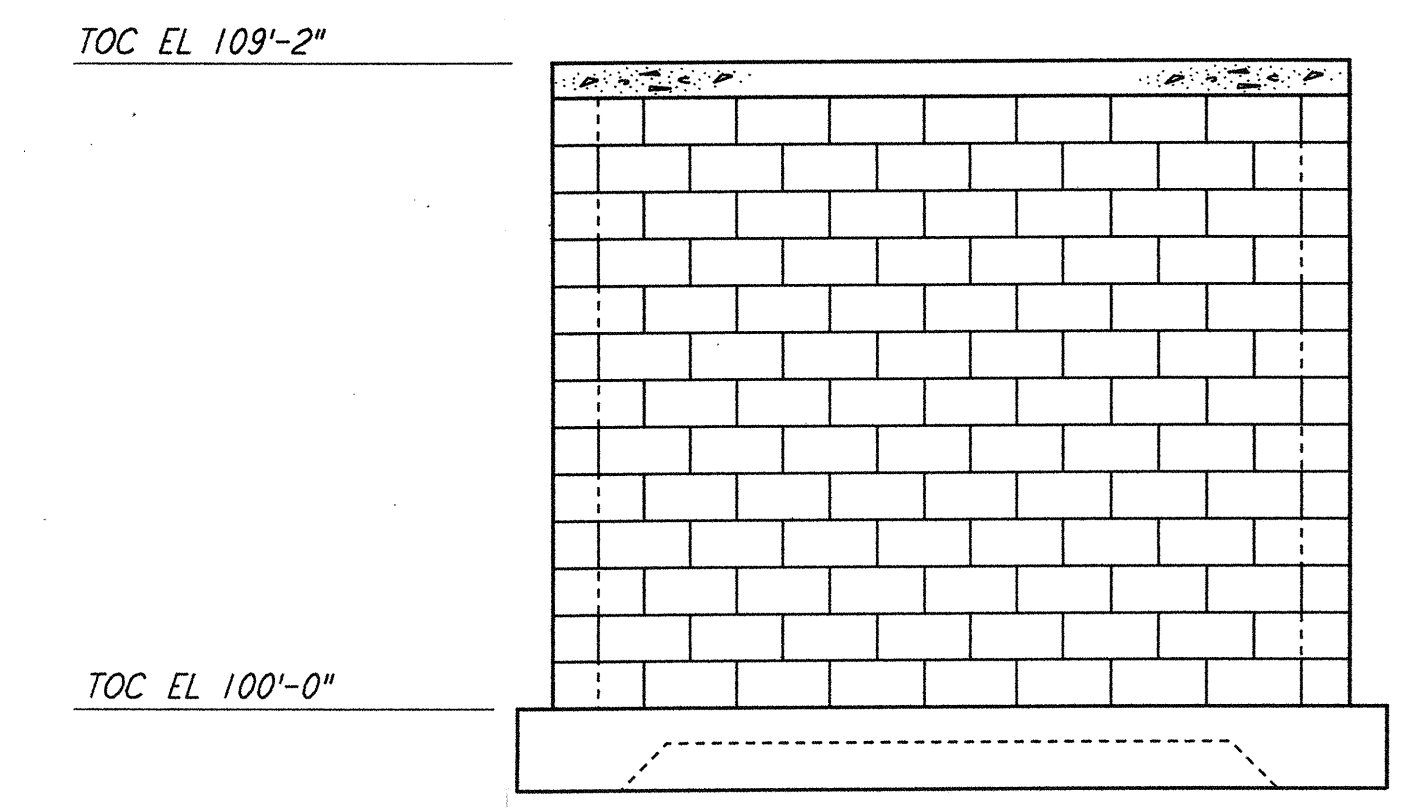


ELEVATION C REF
 $\frac{3}{8}'' = 1'-0''$ WA-S-203 WA-S-202

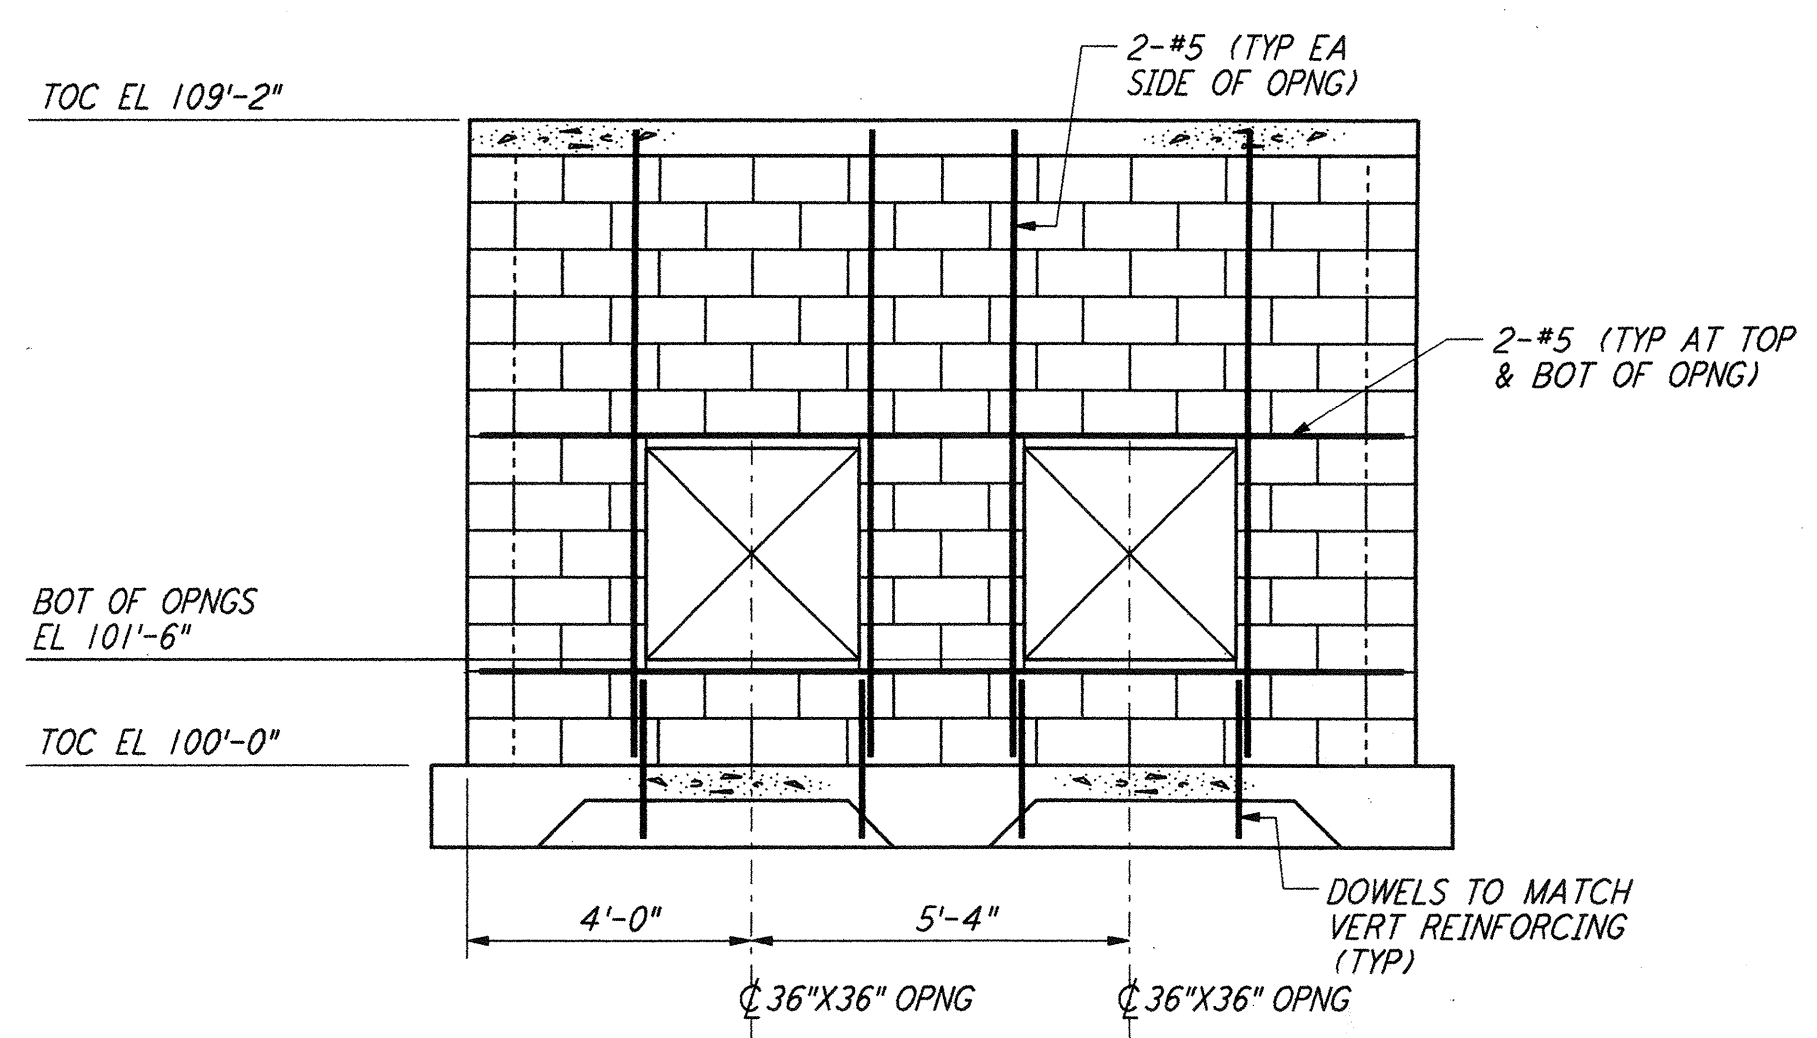


ELEVATION D REF
 $\frac{3}{8}'' = 1'-0''$ WA-S-203 WA-S-202

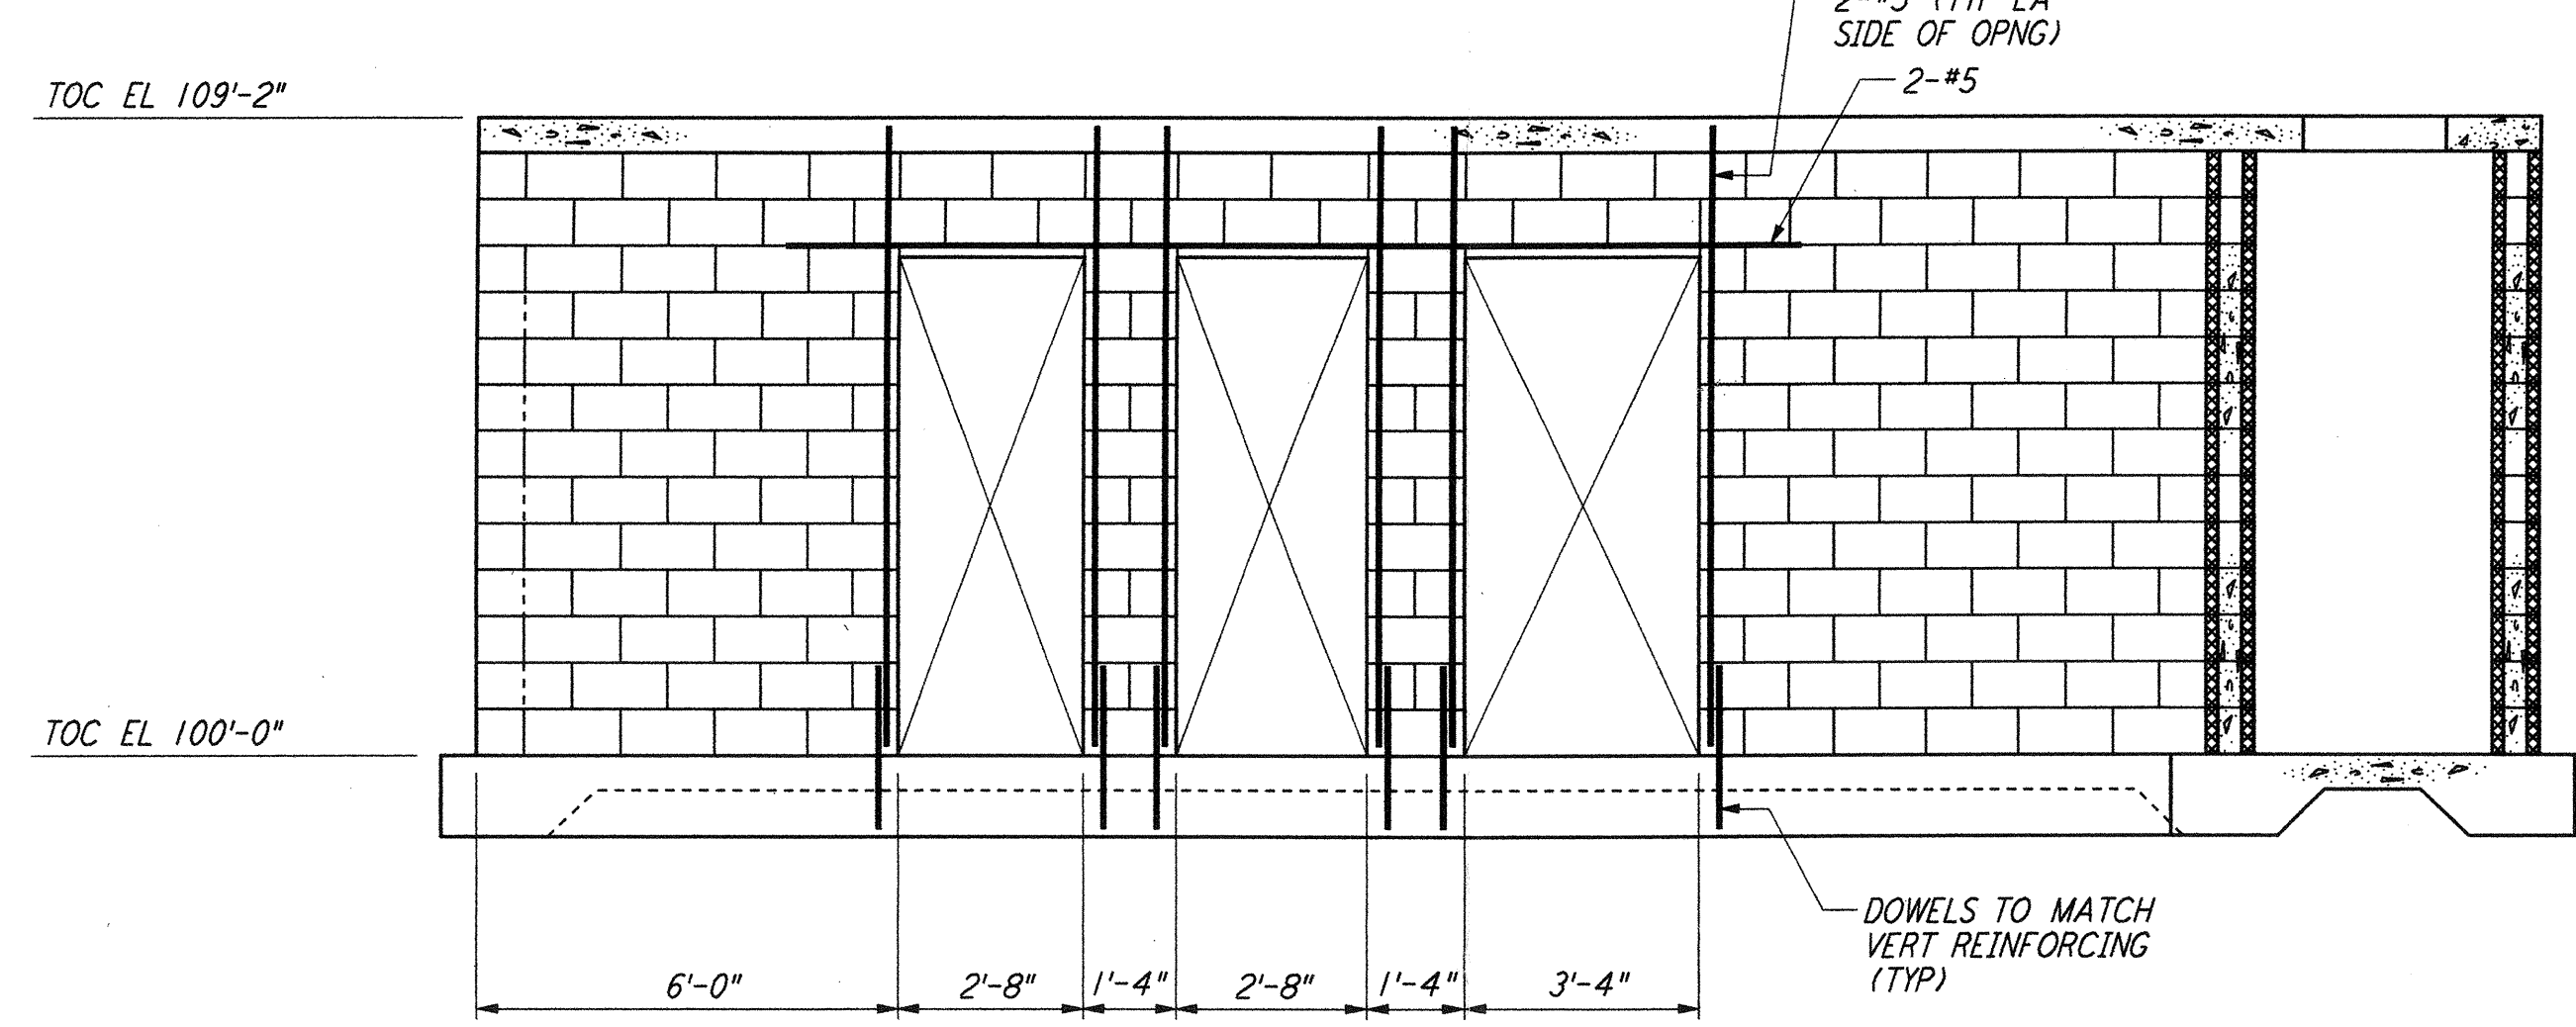


ELEVATION E REF
 $\frac{3}{8}'' = 1'-0''$ WA-S-203 WA-S-202

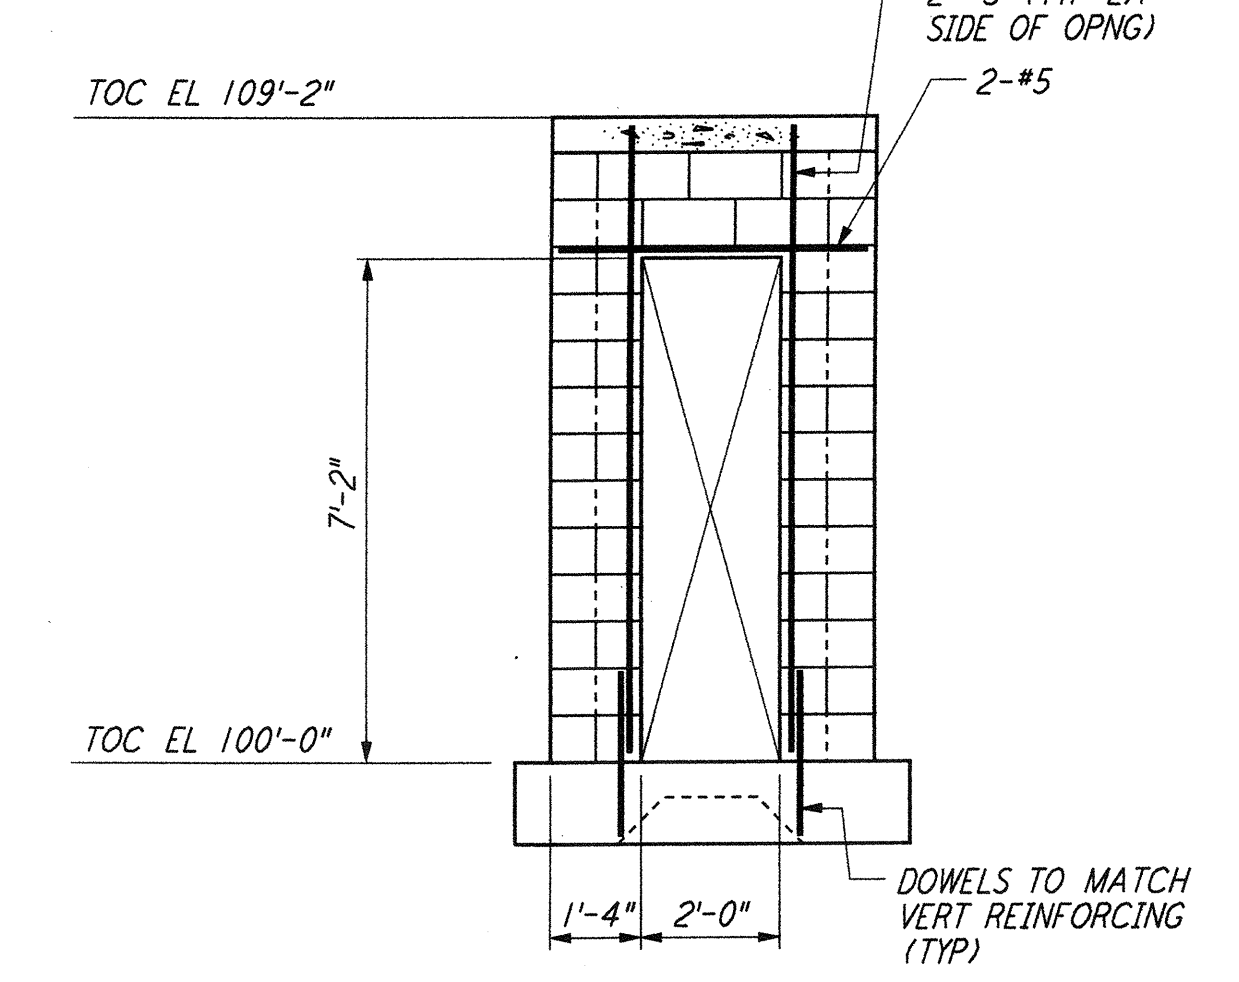


ELEVATION F REF
 $\frac{3}{8}'' = 1'-0''$ WA-S-203 WA-S-202

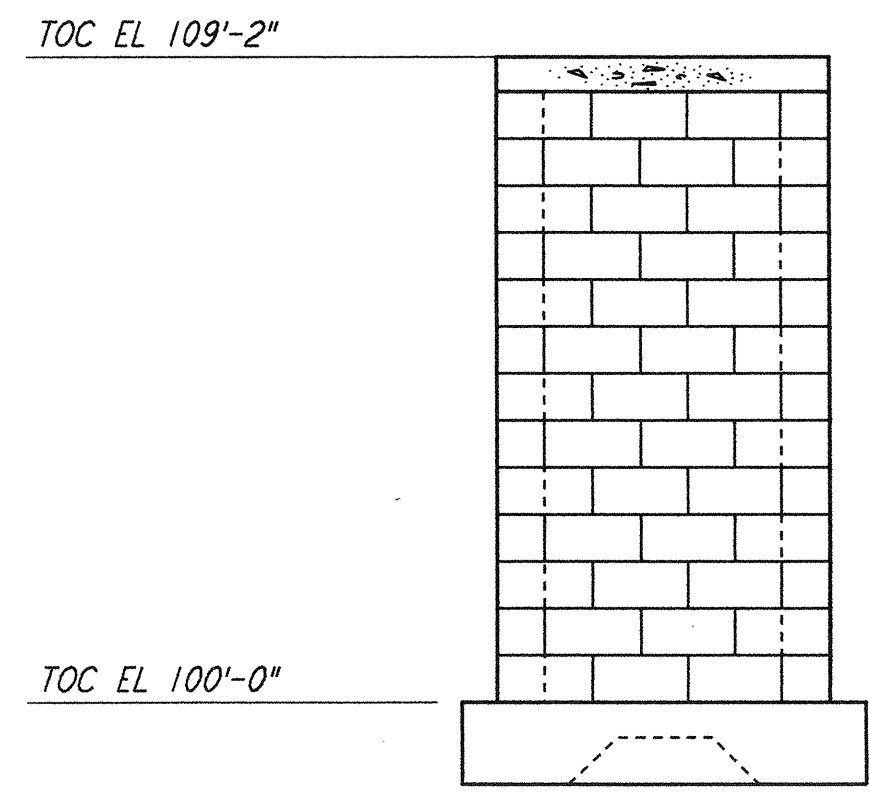

ELEVATION G REF
 $\frac{3}{8}'' = 1'-0''$ WA-S-203 WA-S-202

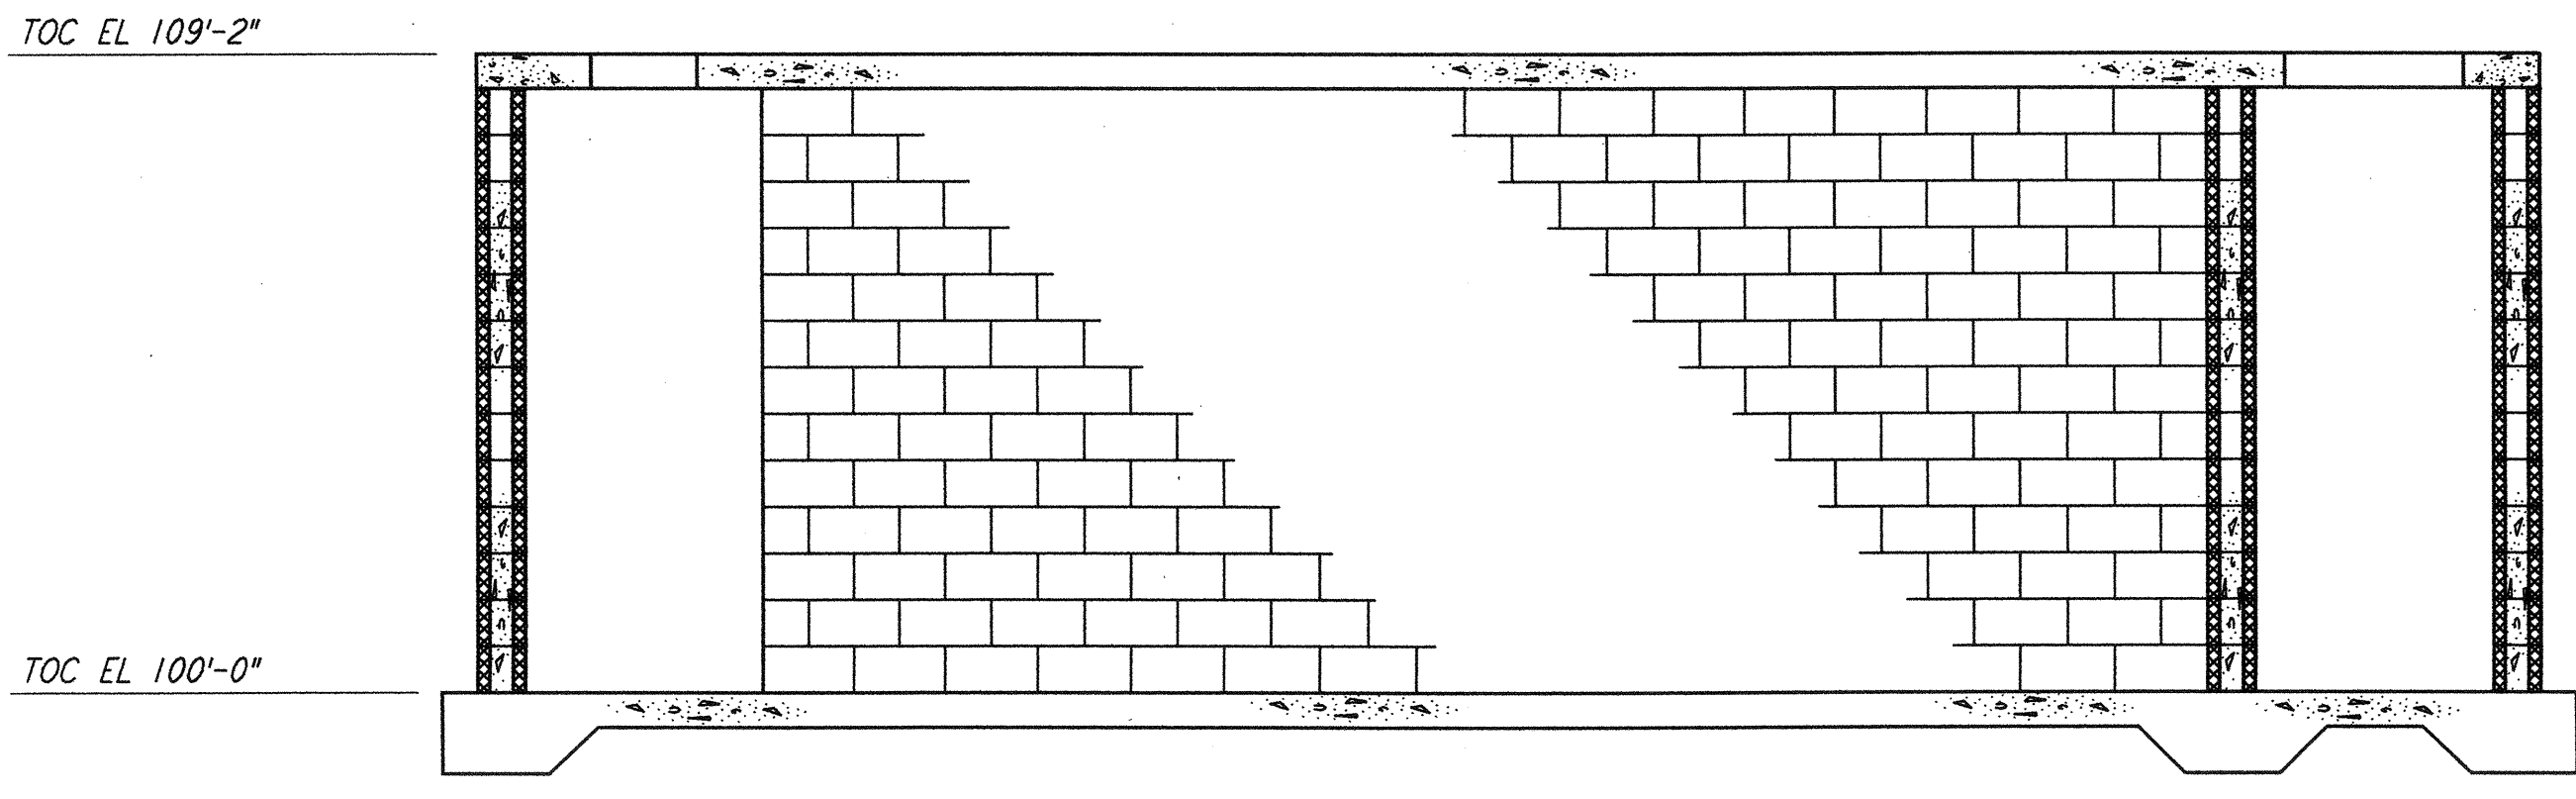

ELEVATION H REF
 $\frac{3}{8}'' = 1'-0''$ WA-S-203 WA-S-202

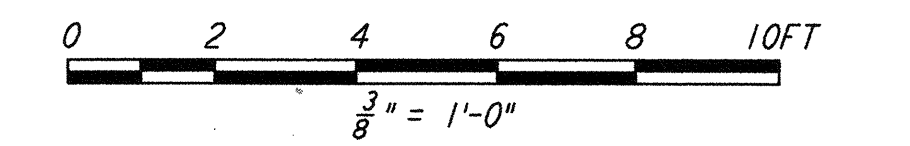

LIGO-D960309-01-0

NO.	DATE	BY	CHKD	ENGR	PROJ	DESCRIPTION
1	6-15-98	CKT	HP	HP	PP	ISSUED FOR AS-BUILT

ISSUED FOR CONSTRUCTION		
DRAWN	MCS	6-24-96
CHECKED	DDM	7-2-96
ENGINEER	BP	6-28-96
PROJ	MDW	7-9-96
AS-BUILT DRAWINGS		

PARSONS
 100 WEST WALNUT STREET
 PASADENA, CALIFORNIA

LIGO
 CALIFORNIA INSTITUTE OF TECHNOLOGY
 MASSACHUSETTS INSTITUTE OF TECHNOLOGY

LASER INTERFEROMETER
 GRAVITATIONAL-WAVE OBSERVATORY
 SITE NO. 1 - HANFORD, WASHINGTON

TITLE	STRUCTURAL MID & END STATIONS AIR HANDLING UNIT ENCLOSURE ELEVS & SECTS	CONTRACT NUMBER AS NOTED PPI50969	PROJECT NUMBER 8094
SHEET NUMBER	WA-S-203	REVISIONS	