

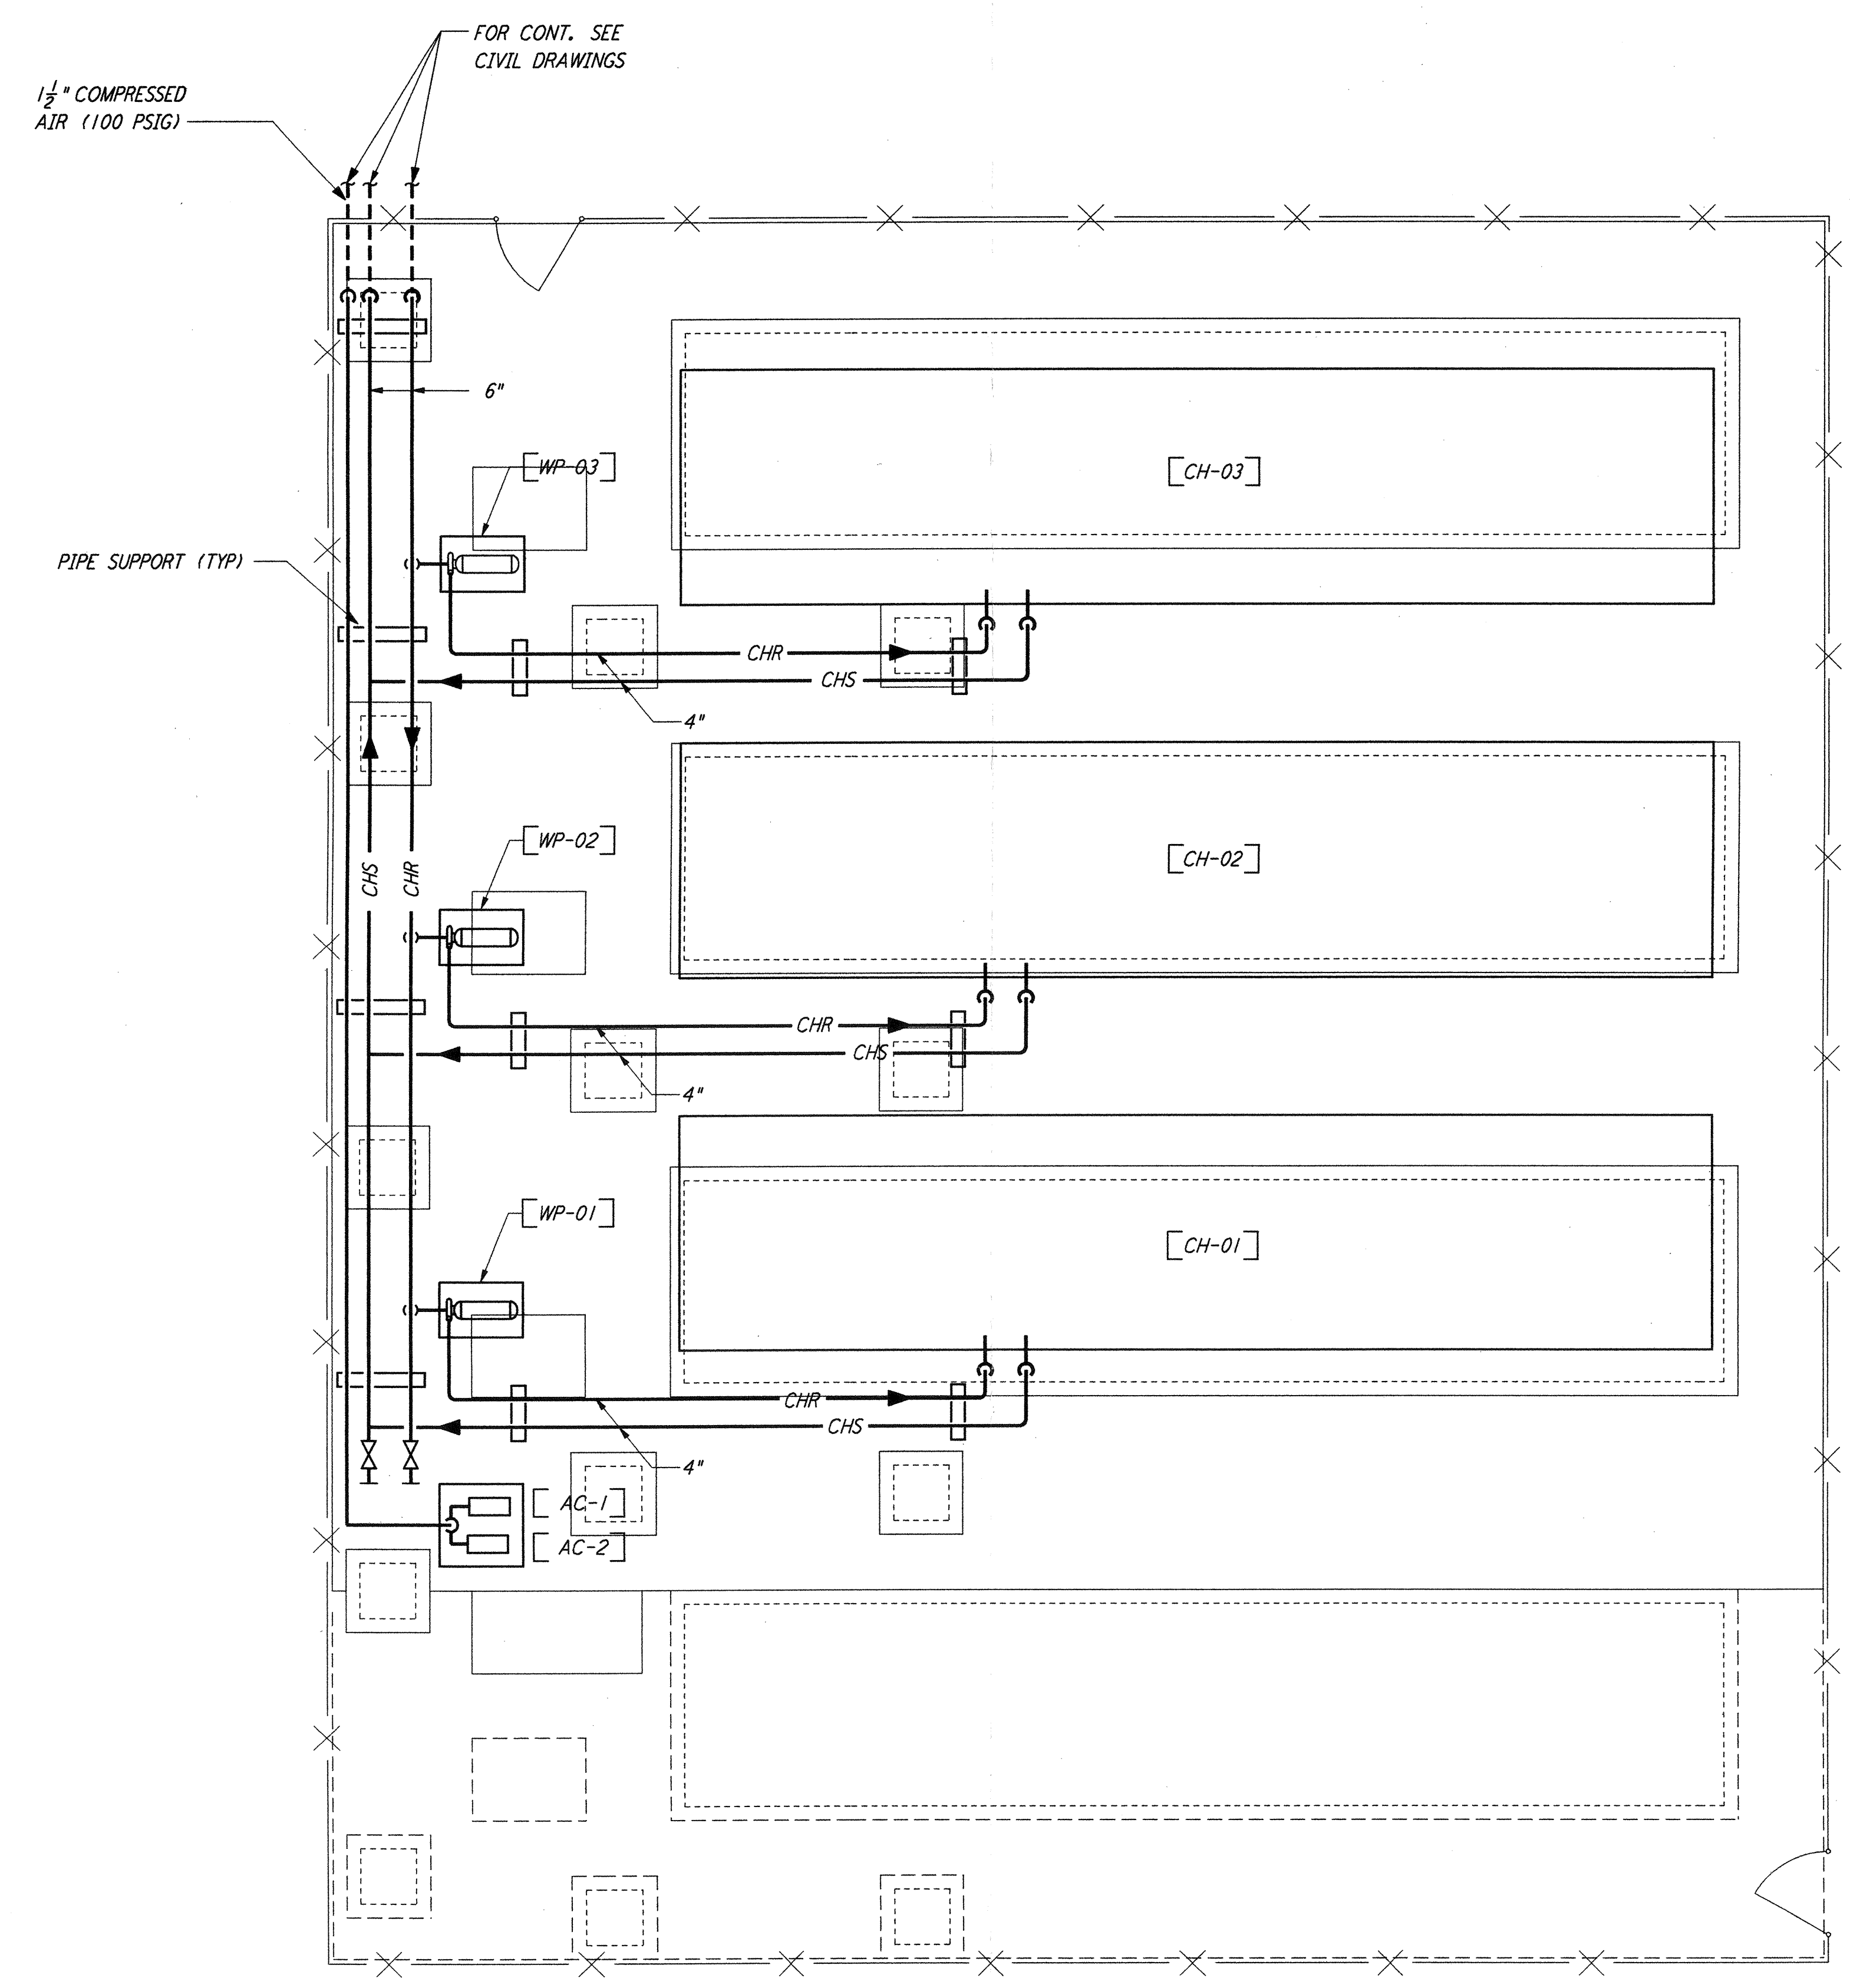


This document and the design it covers are the property of PARSONS. They are loaned only with the borrower's expressed written agreement that they will not be reproduced, copied, loaned, exhibited, or used in any other way, except by written consent from PARSONS to the borrower.

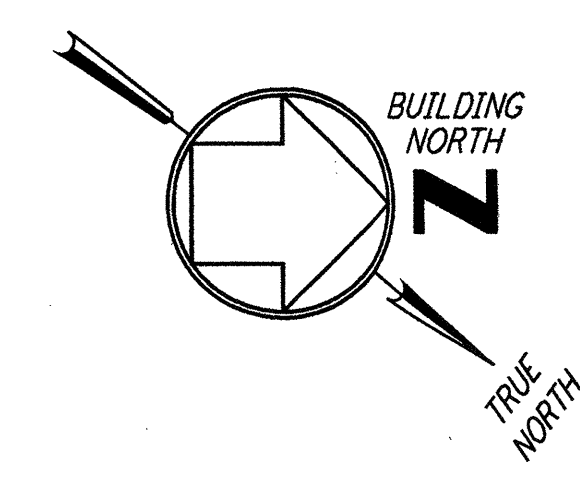


- NOTES:**
- FOR LEGEND, ABBREVIATIONS AND GENERAL NOTES SEE SHEET WA-H-001 AND WA-H-002.
 - MAINTAIN MINIMUM 6'-8" CLEAR HEIGHT UNDER PIPES. FOR PIPE SUPPORT DETAILS SEE STRUCTURAL DRAWING WA-S-407. CONTRACTOR MAY USE SUCTION DIFFUSER/STRAINER.
 - PROVIDE FLOOR MOUNTED ELBOW SUPPORT AT THE PUMP SUCTION.
 - REFER TO SPECIFICATIONS FOR PIPE SUPPORT REQUIREMENTS.
 - SUPPORT PIPING TO ELIMINATE ANY LOADS TRANSMITTED FROM PIPING TO PUMPS AND CHILLERS.
 - FOR PIPING FLOW DIAGRAM SEE SHEET WA-H-121.
 - FOR VALVES AND CONTROL COMPONENTS SEE SHEET WA-H-121.
 - PROVIDE FLEXIBLE CONNECTOR ON THE COMPRESSED AIR DISCHARGE.
 - FOR CHILLERS AND PUMPS PIPING DETAILS SEE SHEETS WA-H-411 AND WA-H-412.
 - FOR EXACT LOCATION OF THE CHILLERS AND PUMPS SEE CIVIL DRAWINGS.

CORNER STATION CHILLER YARD PLAN
 $\frac{1}{4}'' = 1'-0''$

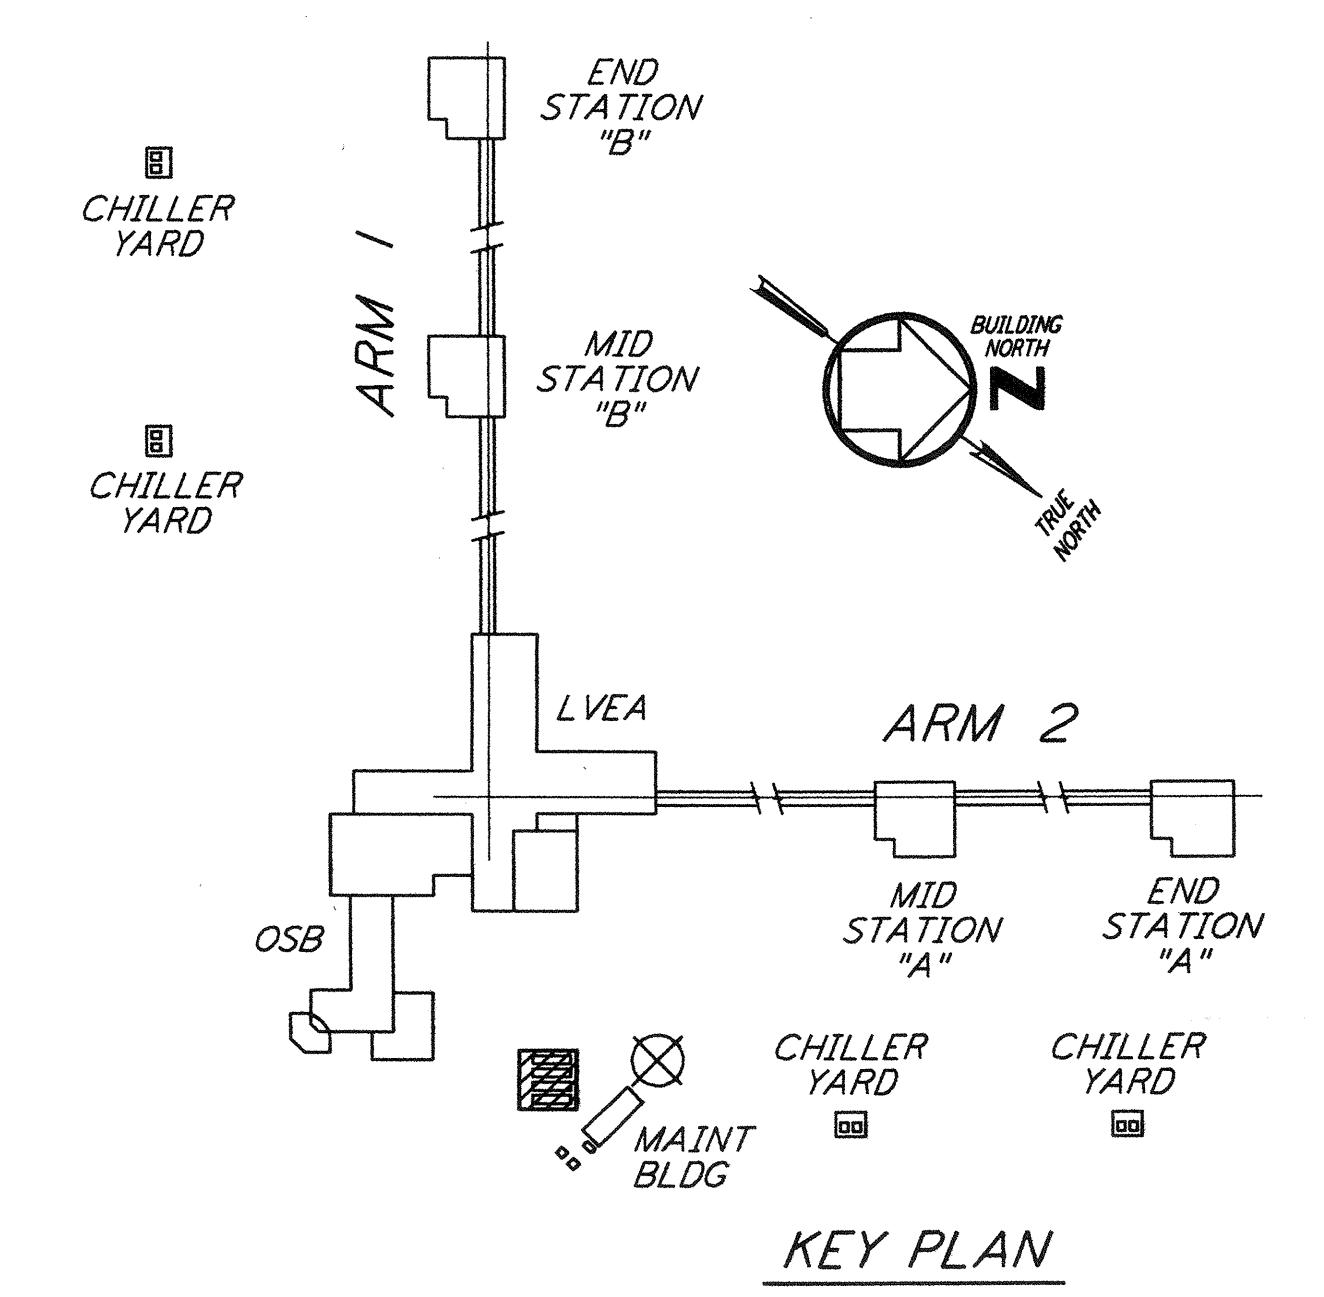

KEY PLAN

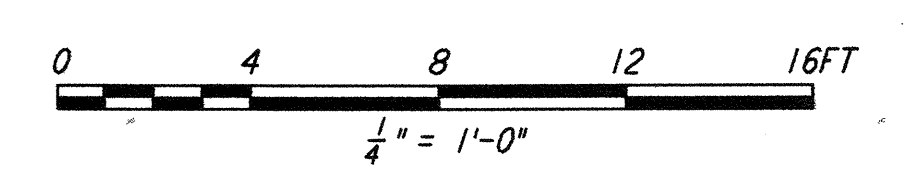

LIGO-D960352-01-0

NO.	DATE	BY	CHKD	ENGR	PROJ	DESCRIPTION
1	5-15-98	CP	AA	AA	MDW	ISSUED FOR AS-BUILT

ISSUED FOR CONSTRUCTION
 DRAWN CLP 6-24-96
 CHECKED ME 7/13/96
 ENGINEER AA 7/13/96
 PROJ MDW 7/13/96

AS-BUILT DRAWINGS

100 WEST WALNUT STREET
 PASADENA, CALIFORNIA

CALIFORNIA INSTITUTE OF TECHNOLOGY
 MASSACHUSETTS INSTITUTE OF TECHNOLOGY

LASER INTERFEROMETER
 GRAVITATIONAL-WAVE OBSERVATORY
 SITE NO. 1 - HANFORD, WASHINGTON

TITLE	SCALE	CONTRACT NUMBER	PROJECT NUMBER
HVAC CORNER STATION CHILLERS YARD FLOOR PLAN	AS NOTED	PP150969	8094
SHEET NUMBER	PROJECT NUMBER		REVISIONS
WA-H-115			