



NOTES:


1. FOR LEGEND, ABBREVIATIONS AND GENERAL NOTES SEE SHEET WA-H-001 AND WA-H-002.
2. SEE INPUT/OUTPUT SUMMARY SHEETS, SHEETS WA-H-141 AND WA-H-142 FOR ALARMS AND EQUIPMENT CONTROL.

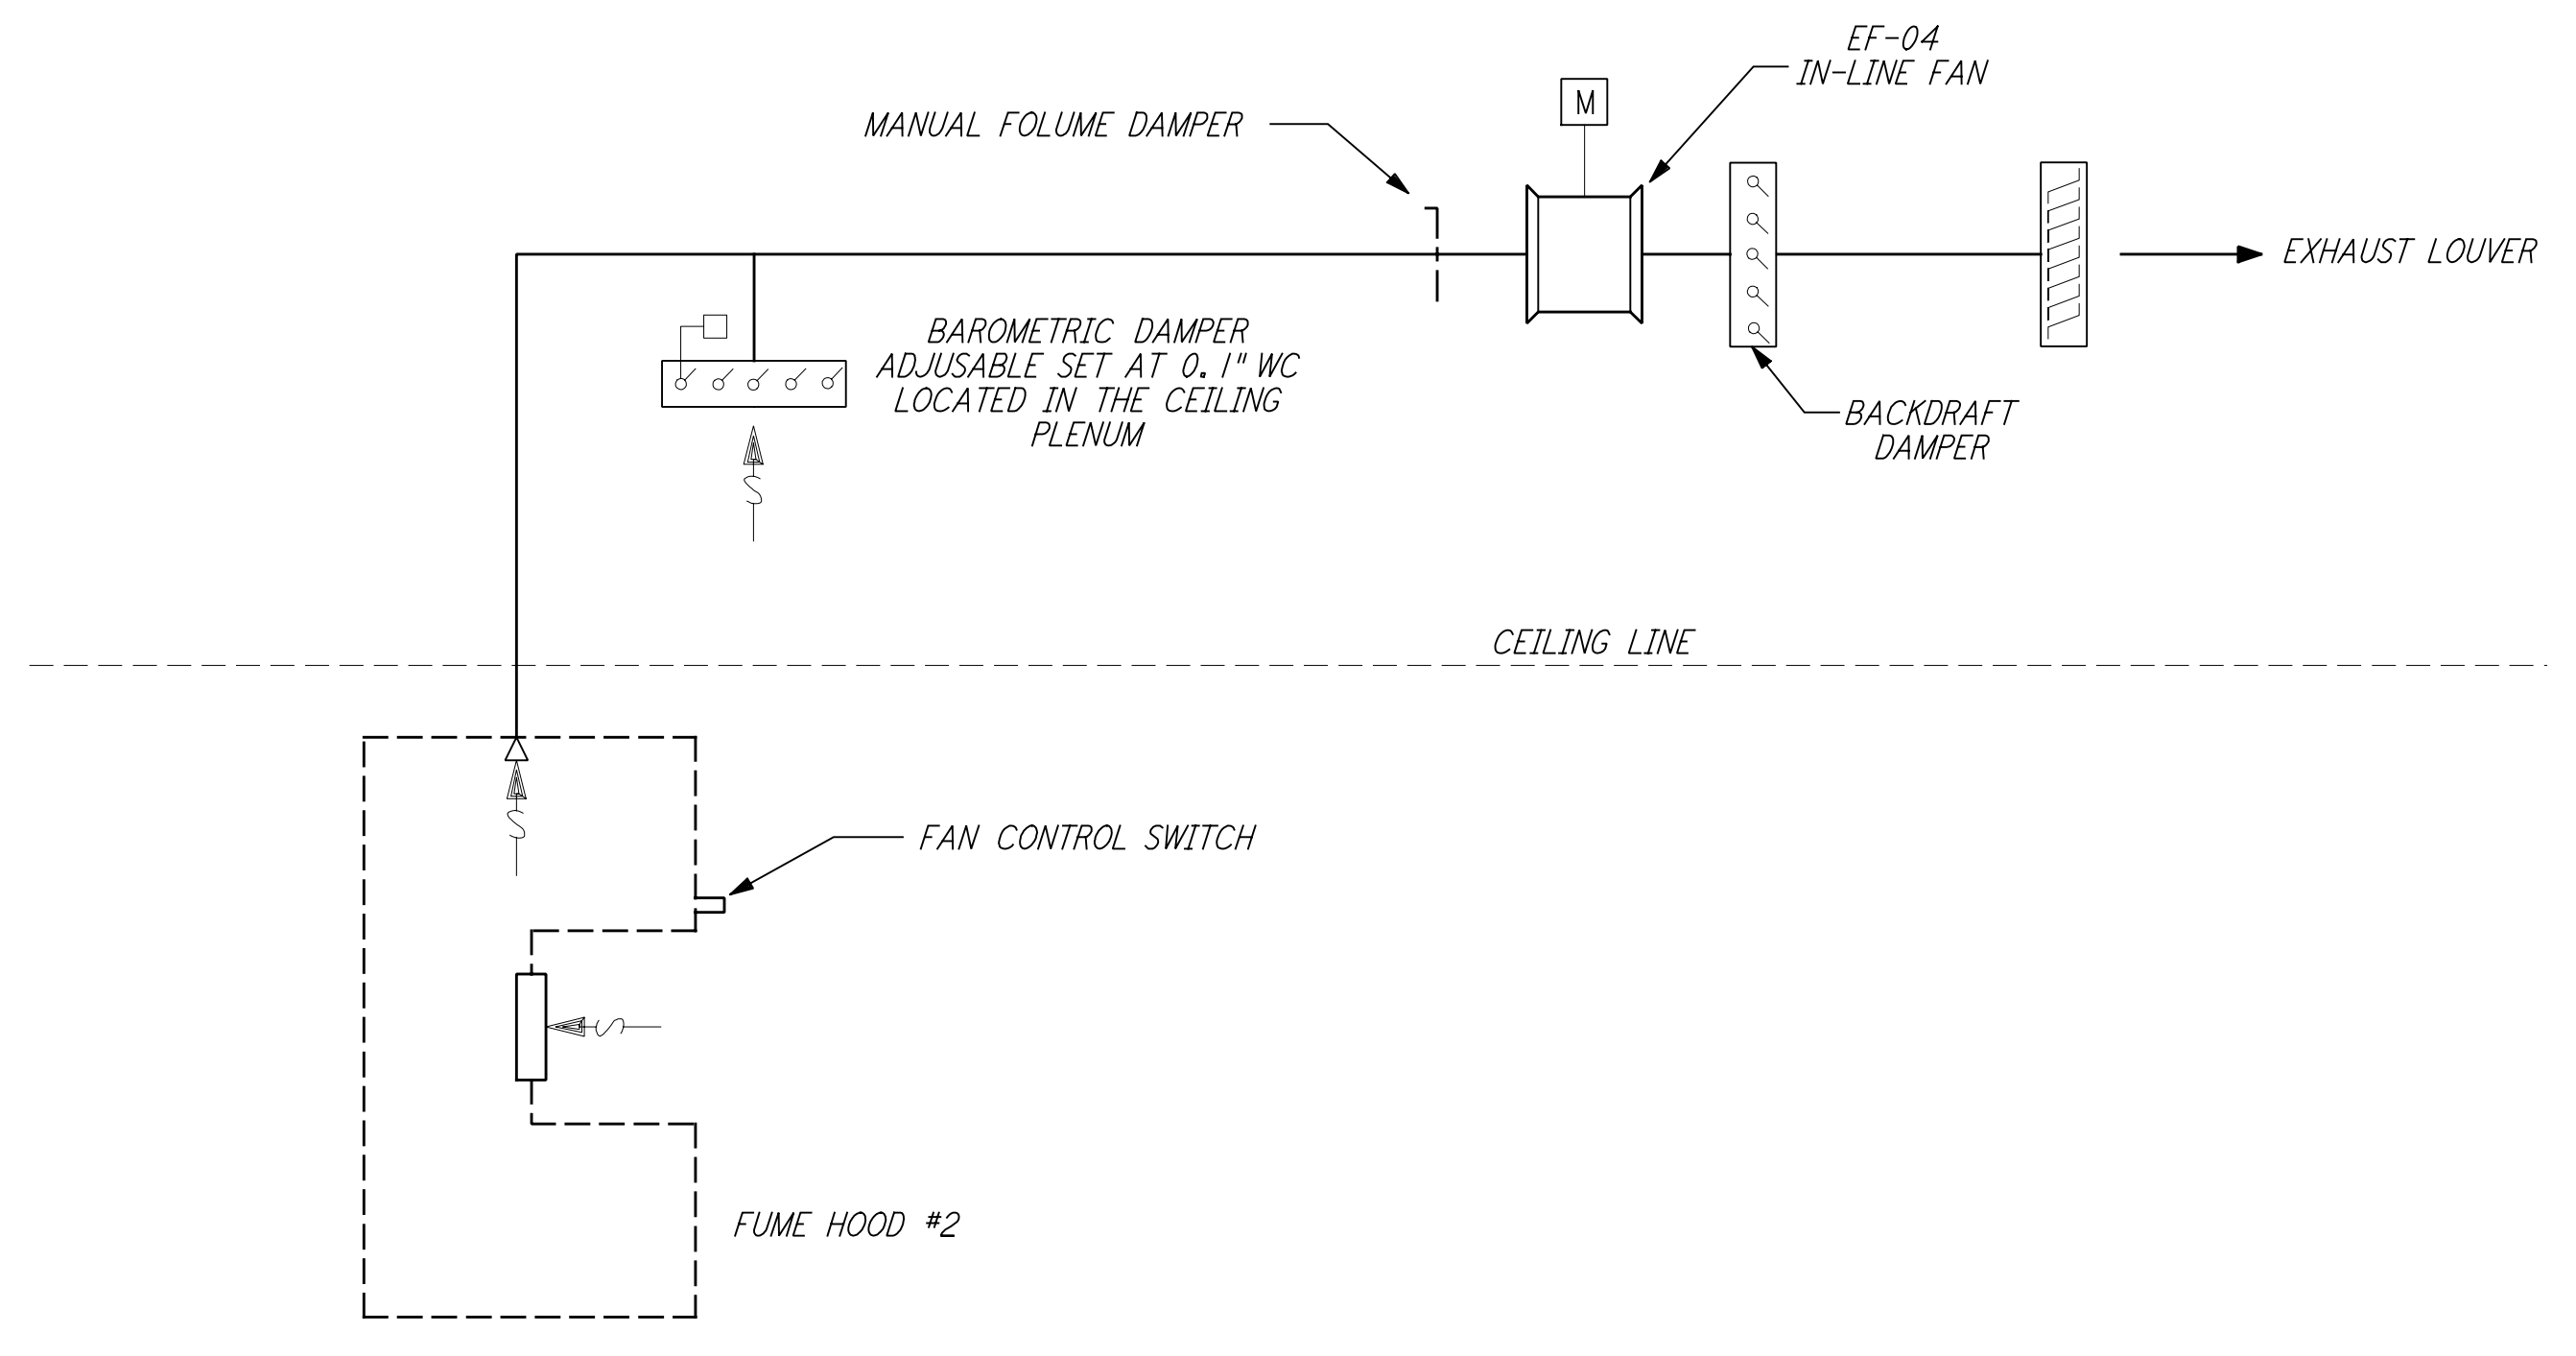

VACUUM PREPARATION FUME HOOD CONTROL DIAGRAM

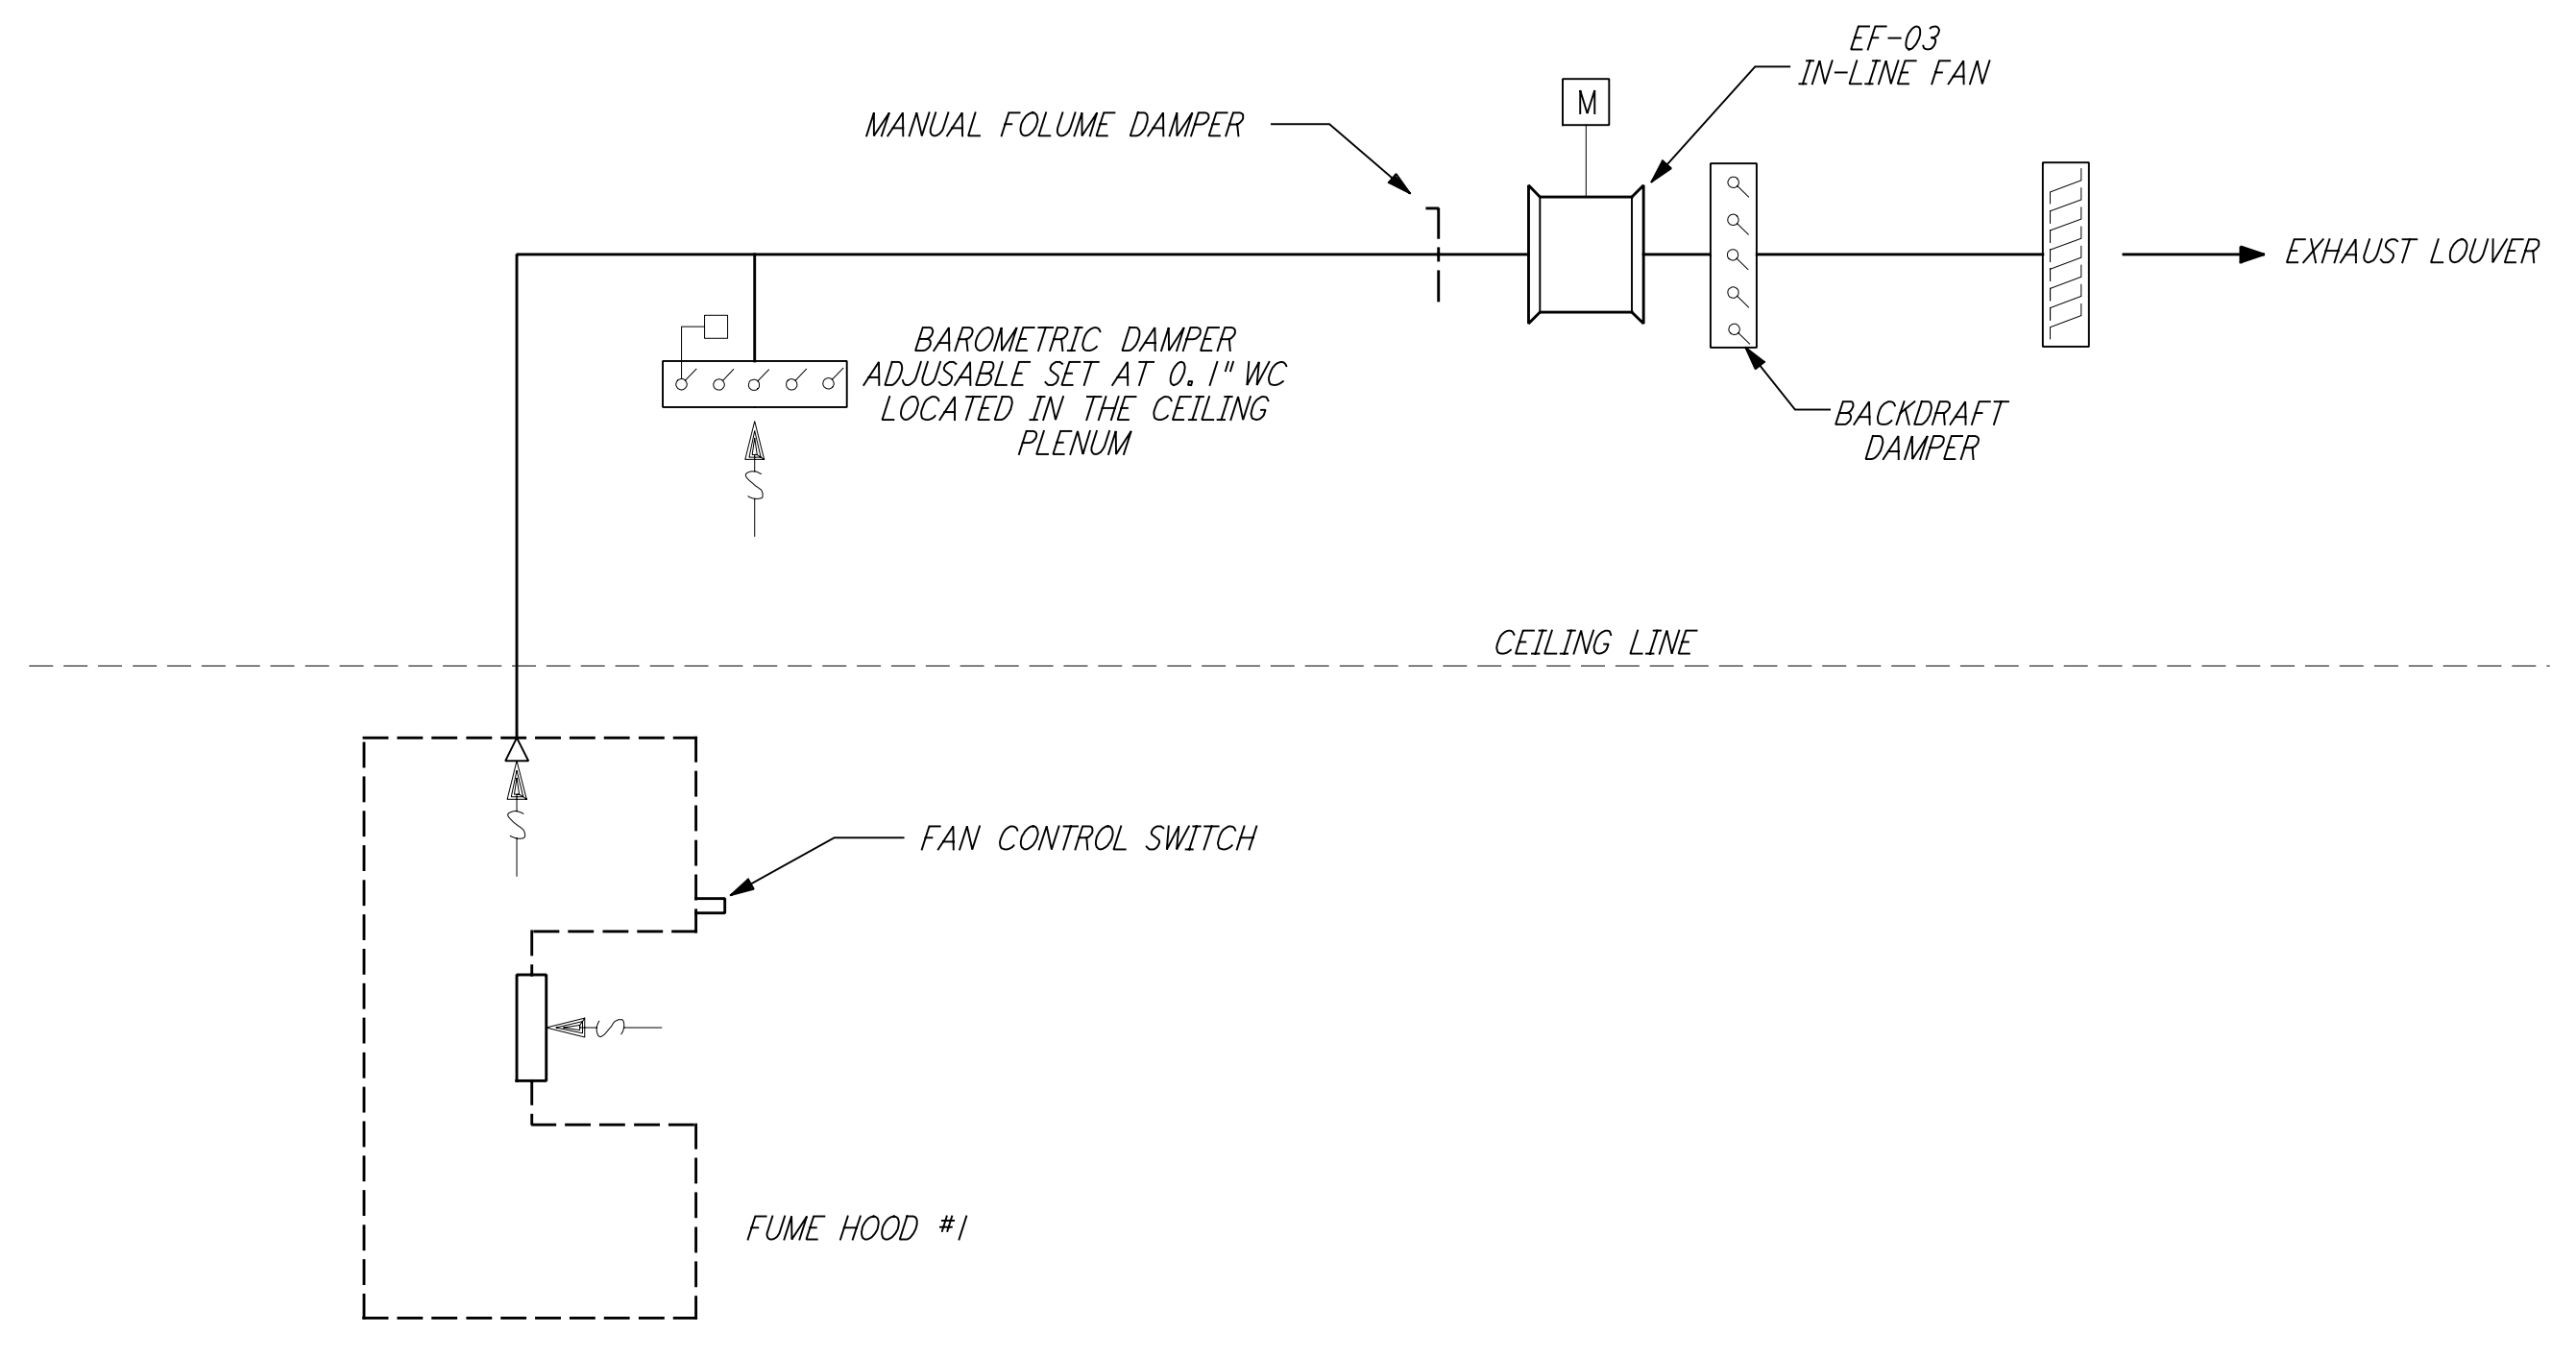

OPTICS LAB FUME HOOD CONTROL DIAGRAM

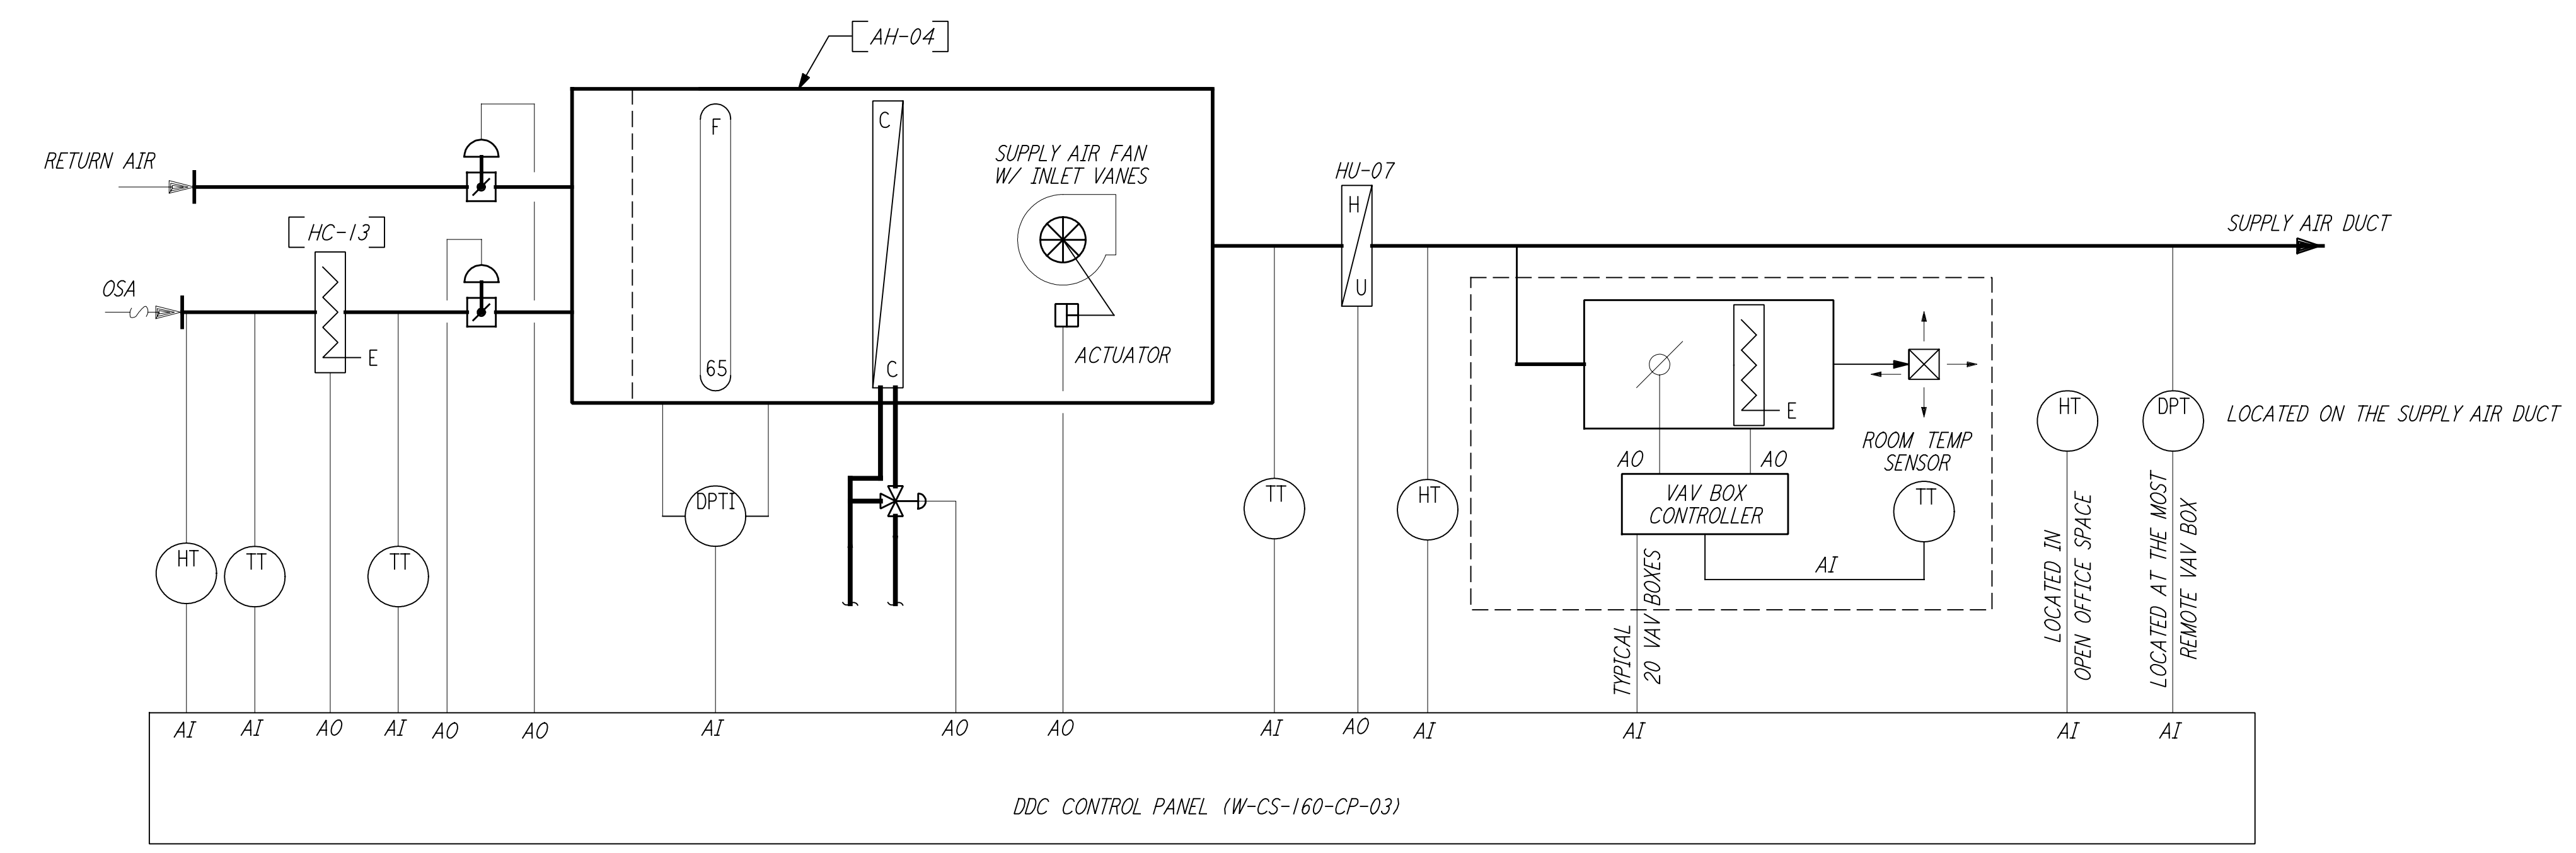

OSB AIR FLOW & CONTROL DIAGRAM
(OFFICES AREA)

not be reproduced, copied, loaned, exhibited, or used in any other way, except by written consent from PARSONS to the borrower.

This document and the design it covers are the property of PARSONS. They are loaned only with the borrower's expressed written agreement that they will

LIGO-D960356-01-0

NO.	DATE	BY	CHKD	ENGR	PROJ	DESCRIPTION
1	5-15-98	CP				ISSUED FOR AS-BUILT

ISSUED FOR CONSTRUCTION
 DRAWN CLP 6-24-96
 CHECKED
 ENGINEER
 PROJ
AS-BUILT DRAWINGS

100 WEST WALNUT STREET
 PASADENA, CALIFORNIA

CALIFORNIA INSTITUTE OF TECHNOLOGY
 MASSACHUSETTS INSTITUTE OF TECHNOLOGY

LASER INTERFEROMETER GRAVITATIONAL-WAVE OBSERVATORY SITE NO. 1 - HANFORD, WASHINGTON			
TITLE	SCALE	CONTRACT NUMBER	PROJECT NUMBER
HVAC CORNER STATION AIR FLOW DIAGRAMS SHEET 2	NONE	PP150969	8094
SHEET NUMBER		REVISIONS	
WA-H-123			