


NOTES:


- 1. FOR LEGEND, ABBREVIATIONS AND GENERAL NOTES SEE SHEET WA-H-001 AND WA-H-002.
- 2. SEE SHEET WA-H-551 FOR APPLICABLE NOTES.
- 3. PERFORATED DUCT LINER INSIDE THE SUPPLY AIR PLENUM OF AH-01 AND AH-02 WILL BE CORRUGATED TYPE.

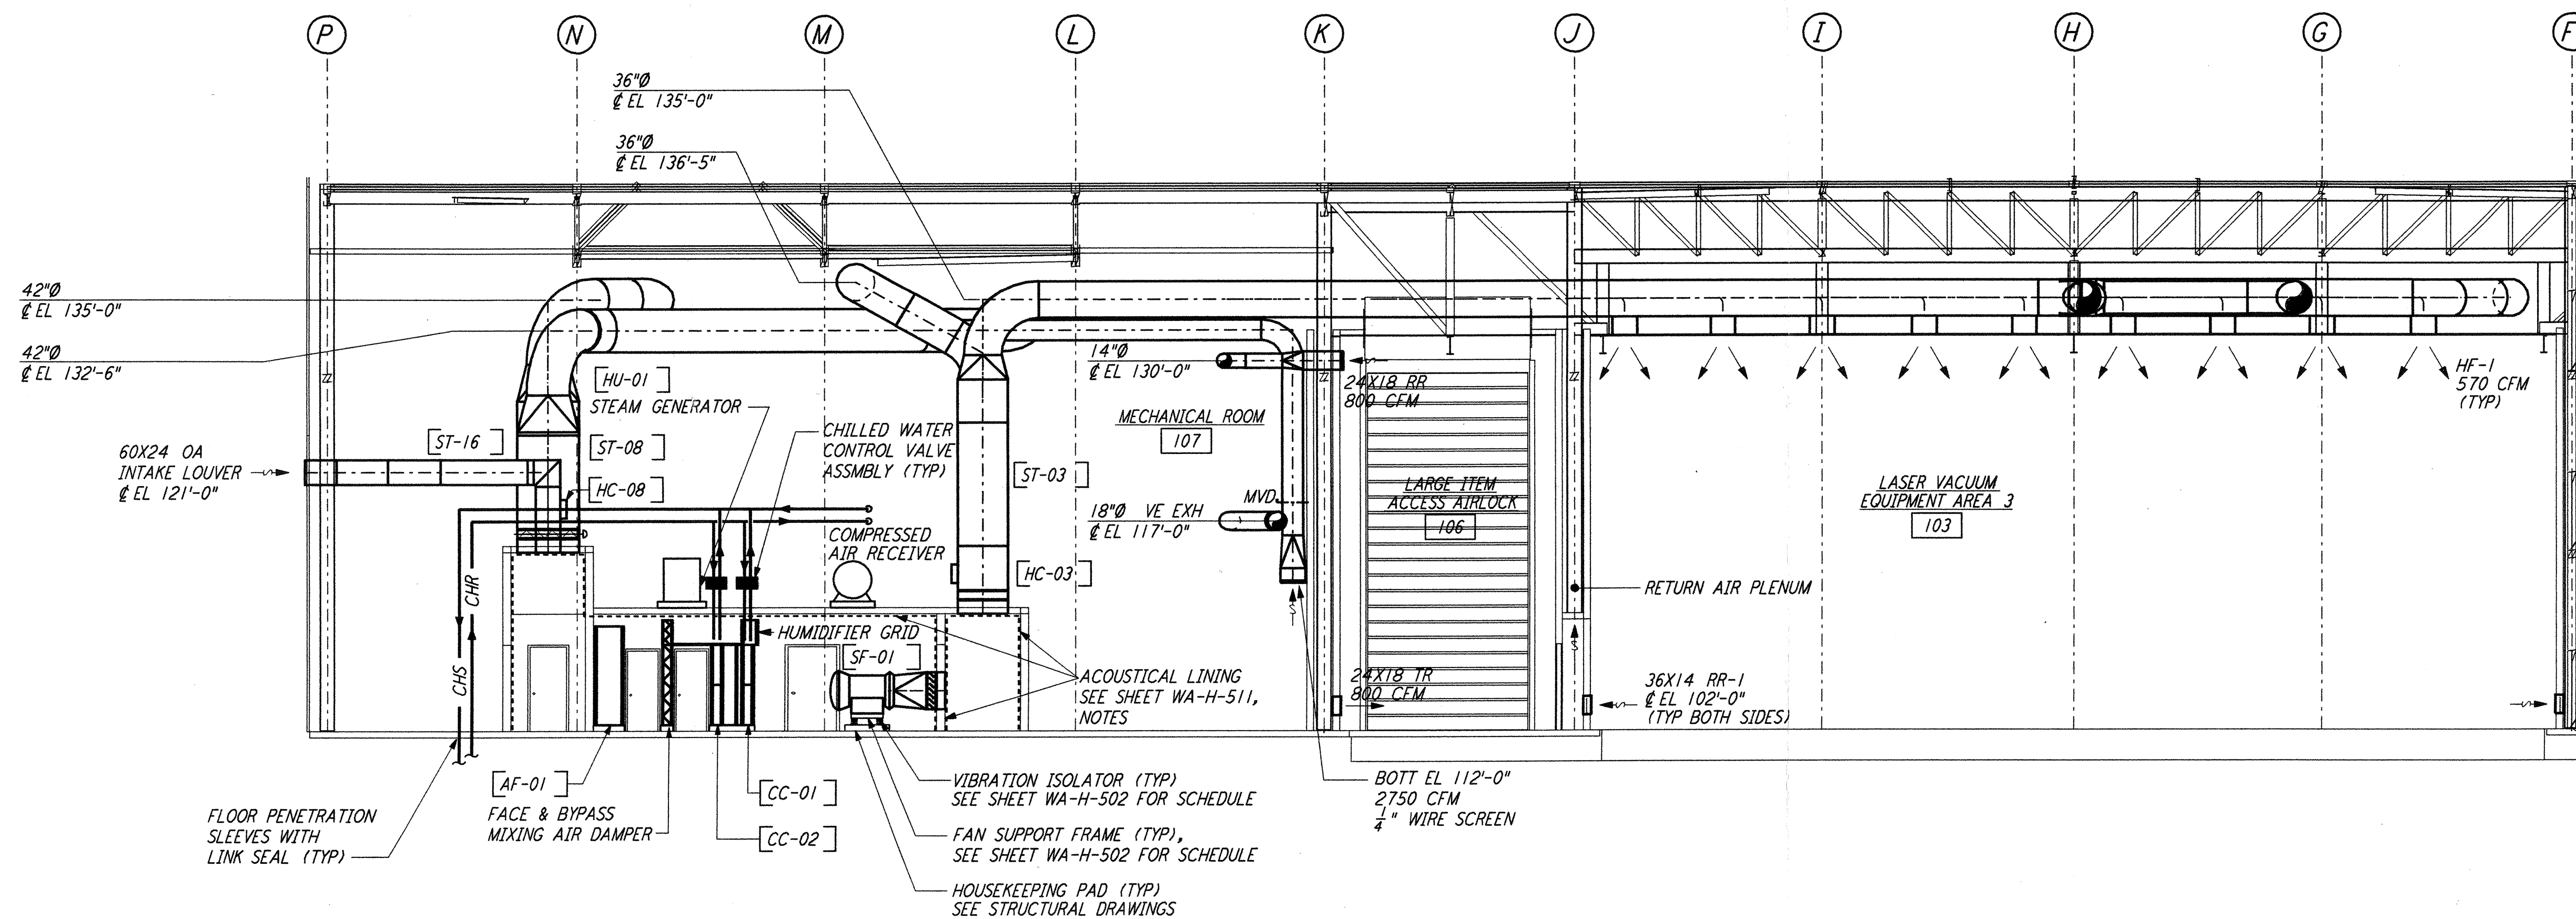

SECTION **B** REF  
 $\frac{1}{8}'' = 1'-0''$  WA-H-552 WA-H-511

not be reproduced, copied, loaned, exhibited, or used in any other way, except by written consent from PARSONS to the borrower.

This document and the design it covers are the property of PARSONS. They are loaned only with the borrower's expressed written agreement that they will

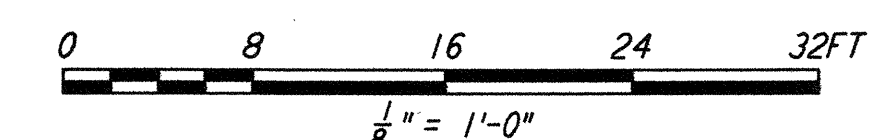

**LIGO-D960387-01-0**

LASER INTERFEROMETER  
GRAVITATIONAL-WAVE OBSERVATORY  
SITE NO. 1 - HANFORD, WASHINGTON

TITLE	SCALE	CONTRACT NUMBER	PROJECT NUMBER
HVAC CORNER STATION SECTIONS SHEET 2	AS NOTED	PP150969	8094
SHEET NUMBER		REVISIONS	
<b>WA-H-552</b>		[Symbol]	



100 WEST WALNUT STREET  
PASADENA, CALIFORNIA



CALIFORNIA INSTITUTE OF TECHNOLOGY  
MASSACHUSETTS INSTITUTE OF TECHNOLOGY

ISSUED FOR CONSTRUCTION			
DRAWN	CLP	6-24-96	
CHECKED	ME	7/31/96	
ENGINEER	AA	7/31/96	
PROJ	mdw	7/1/96	

**AS-BUILT  
DRAWINGS**

NO.	DATE	BY	CHKD	ENGR	PROJ	DESCRIPTION
1	5-15-98	CP	AA	AA	AA	ISSUED FOR AS-BUILT