


- NOTES:**
1. FOR ABBREVIATIONS AND ACRONYMS SEE DWG. WA-E-001.
 2. FOR SYMBOLS SEE DWG. WA-E-002.
 3. FOR GENERAL NOTES, SEE DWG. WA-E-100.
 4. FIXTURES H-95 AND HQ-95 HAVE A FLEXIBLE CABLE (BY VENDOR) CONNECTS WIRES FROM "MASTER" BALLAST TO SATELLITE PLUG-IN CONNECTOR. BOTH BALLASTS ARE IN THE "MASTER" UNIT.
 5. FIXTURES H3-95 SHALL HAVE ITS BALLASTS PARALLEL SWITCHED FROM ASSOCIATED MASTER FIXTURE H-95.
 6. FIXTURES H1-95 SHALL HAVE ITS 2-LAMP BALLAST PARALLEL SWITCH FROM ASSOCIATED MASTER FIXTURE, AND ITS 1-LAMP BALLAST SHALL NOT BE SWITCHED.
 7. LIGHTING FIXTURES LOCATION IN VESTIBULE 121 AND AT ENTRY SHALL BE PHOTO ELECTRIC CONTROL VIA PHOTO CELL LOCATED ON ROOF.
 8. ALL CIRCUITS SHOWN ON THIS DRAWING ARE FROM PANEL W-CS-144-LP-01 UNLESS OTHERWISE NOTED.
 9. CIRCUIT SHOWN FEEDING THESE LIGHTING FIXTURES IS FROM PANEL W-CS-144-RP-01.
 10. FOR ALL PANEL FEEDER CONDUIT AND WIRE SIZES SEE SINGLE LINE DIAGRAM DWG WA-E-006.

- REFERENCE DRAWINGS:**
- WA-E-001 ELECTRICAL SYMBOLS, ABBREVIATION & ACRONYMS
 - WA-E-002 ELECTRICAL STANDARD PLAN SYMBOLS
 - WA-E-100 ELECTRICAL CS LIEA LIGHTING PLAN
 - WA-E-115 LIGHTING AND POWER PANEL SCHEDULES
 - WA-E-116 LIGHTING AND POWER PANEL SCHEDULES

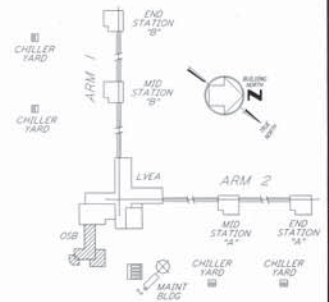

This document and the design it covers are the property of PARSONS. They are loaned only with the borrower's expressed written agreement that they will not be reproduced, copied, loaned, exhibited, or used in any way, except by written consent from PARSONS. In the drawings.

NO.	DATE	BY	CHKD	ENGR	PROJ	DESCRIPTION
2	8-15-98	J.G.	K.R.	R.R.	TOM	ISSUED FOR AS-BUILT
1	3-21-97	J.G.	K.R.	R.R.	TOM	GENERAL REVISIONS

ISSUED FOR CONSTRUCTION			
DRAWN	M. M.	8-25-96	
CHECKED	J. E.	7-3-96	
ENGINEER	K. R.	7-3-96	
PROJ.	M. D. W.	7-8-96	

AS-BUILT DRAWINGS

PARSONS
 100 WEST WALNUT STREET
 PASADENA, CALIFORNIA

LIGO
 CALIFORNIA INSTITUTE OF TECHNOLOGY
 MASSACHUSETTS INSTITUTE OF TECHNOLOGY

LIGO-D960396-02-O

LASER INTERFEROMETER
 GRAVITATIONAL-WAVE OBSERVATORY
 SITE NO. 1 - HANFORD, WASHINGTON

ELECTRICAL CORNER STATION OSB OFFICE AREA LIGHTING PLAN

AS NOTED PP150969 8094
WA-E-107