



NOTES:


1. FOR PLAN SYMBOLS SEE DWG WA-E-002
2. WIRING FOR FIRE DETECTION SHALL BE CLASS "A", FOR FIRE ALARM DEVICES SHALL BE CLASS "B".
3. DUCT MOUNTED SMOKE DETECTORS SHALL BE PROVIDED WITH AN AUXILIARY RELAY CONTACT (N.C.) FOR EQUIPMENT SHUT-DOWN.
4. COORDINATE SMOKE DETECTOR LOCATIONS WITH CLEAN AGENT DISCHARGE NOZZLES.
5. COORDINATE AHU LOCATIONS AND DUCT MOUNTED SMOKE DETECTORS.

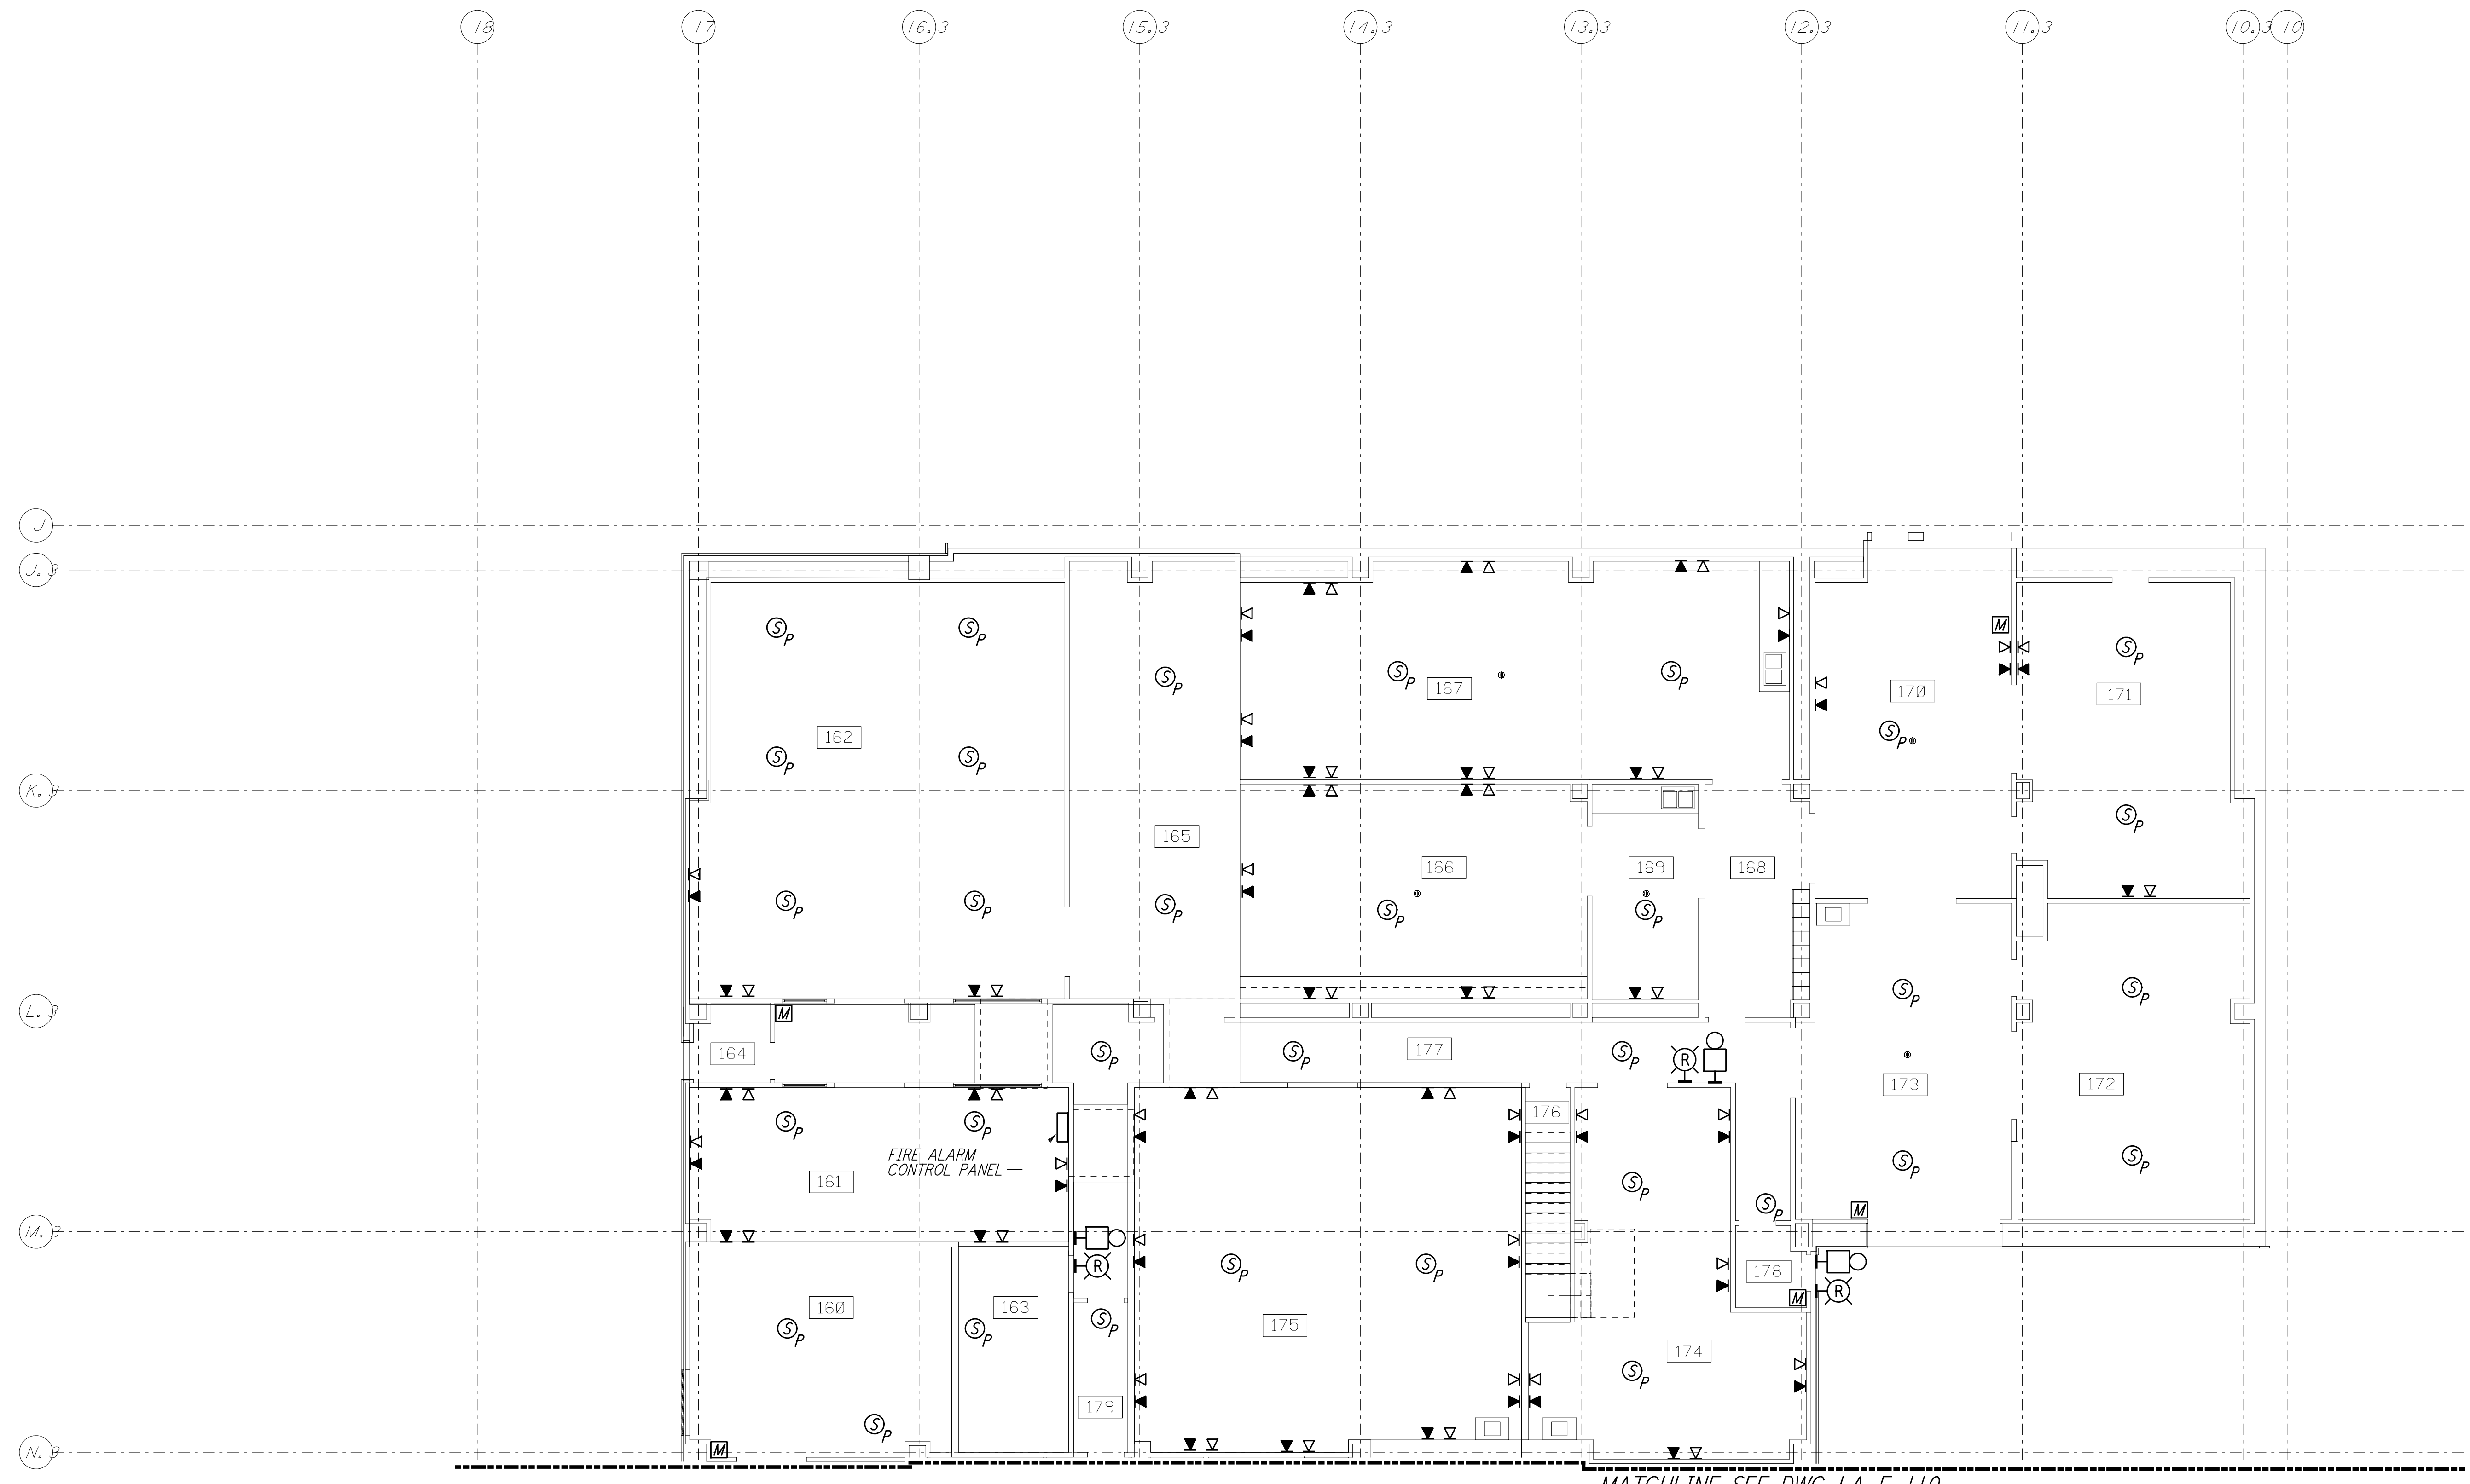

MATCHLINE SEE DWG LA-E-110

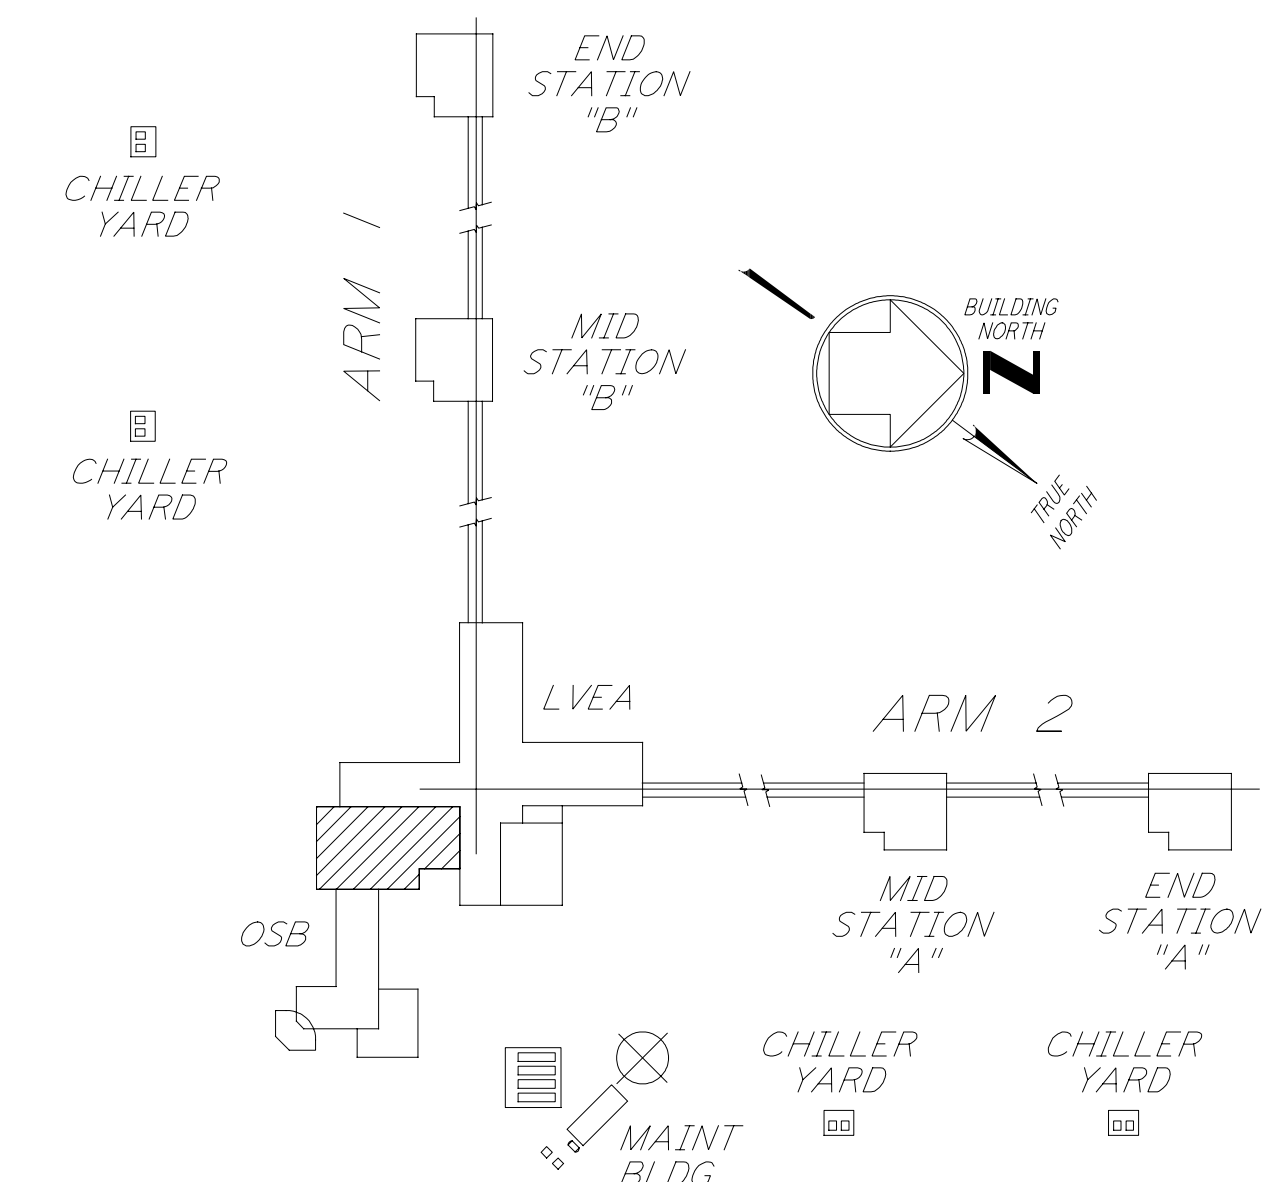

KEY PLAN

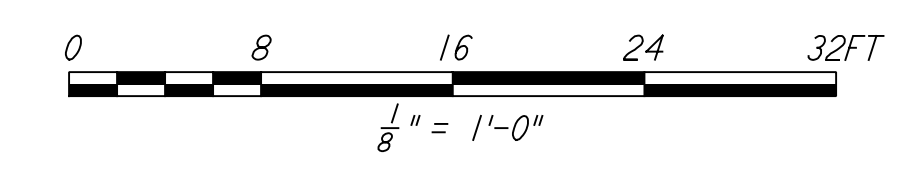

LIGO-D960400-02-0

not be reproduced, copied, loaned, exhibited, or used in any other way, except by written consent from PARSONS to the borrower.

This document and the design it covers are the property of PARSONS. They are loaned only with the borrower's expressed written agreement that they will

NO.	DATE	BY	CHKD	ENGR	PROJ	TDM	DESCRIPTION
2	6-15-98	J. G.					ISSUED FOR AS-BUILT
1	3-21-97	J. G.	K. R.	K. R.	TDM		GENERAL REVISIONS

ISSUED FOR CONSTRUCTION			
DRAWN	M. M.	6-25-96	
CHECKED	J. K.	7-3-96	
ENGINEER	K. R.	7-3-96	
PROJ	M. D. W.	7-8-96	

AS-BUILT DRAWINGS

100 WEST WALNUT STREET
PASADENA, CALIFORNIA

CALIFORNIA INSTITUTE OF TECHNOLOGY
MASSACHUSETTS INSTITUTE OF TECHNOLOGY

LASER INTERFEROMETER
GRAVITATIONAL-WAVE OBSERVATORY
SITE NO. 1 - HANFORD, WASHINGTON

TITLE	AS NOTED	PP150969	8094
ELECTRICAL CORNER STATION OSB LAB AREA FIRE DET & SECURITY PLAN	SHEET NUMBER	WA-E-111	REVISIONS