

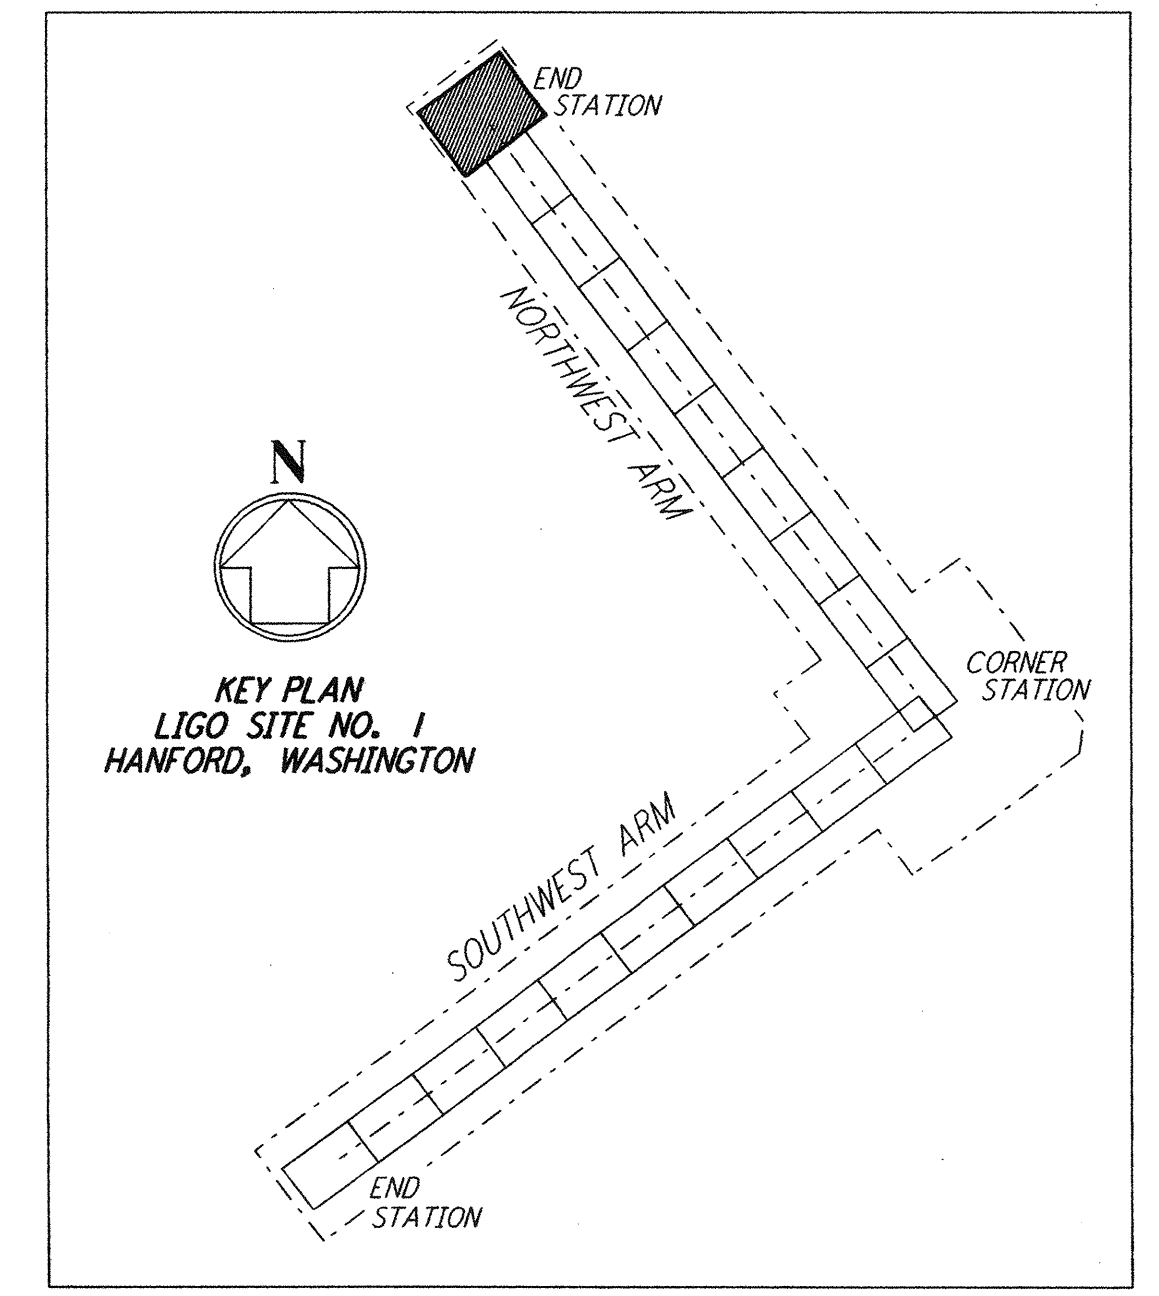


**NOTES:**

1. SEE SHEET WA-C-002 FOR GENERAL NOTES, LEGEND AND ABBREVIATIONS.

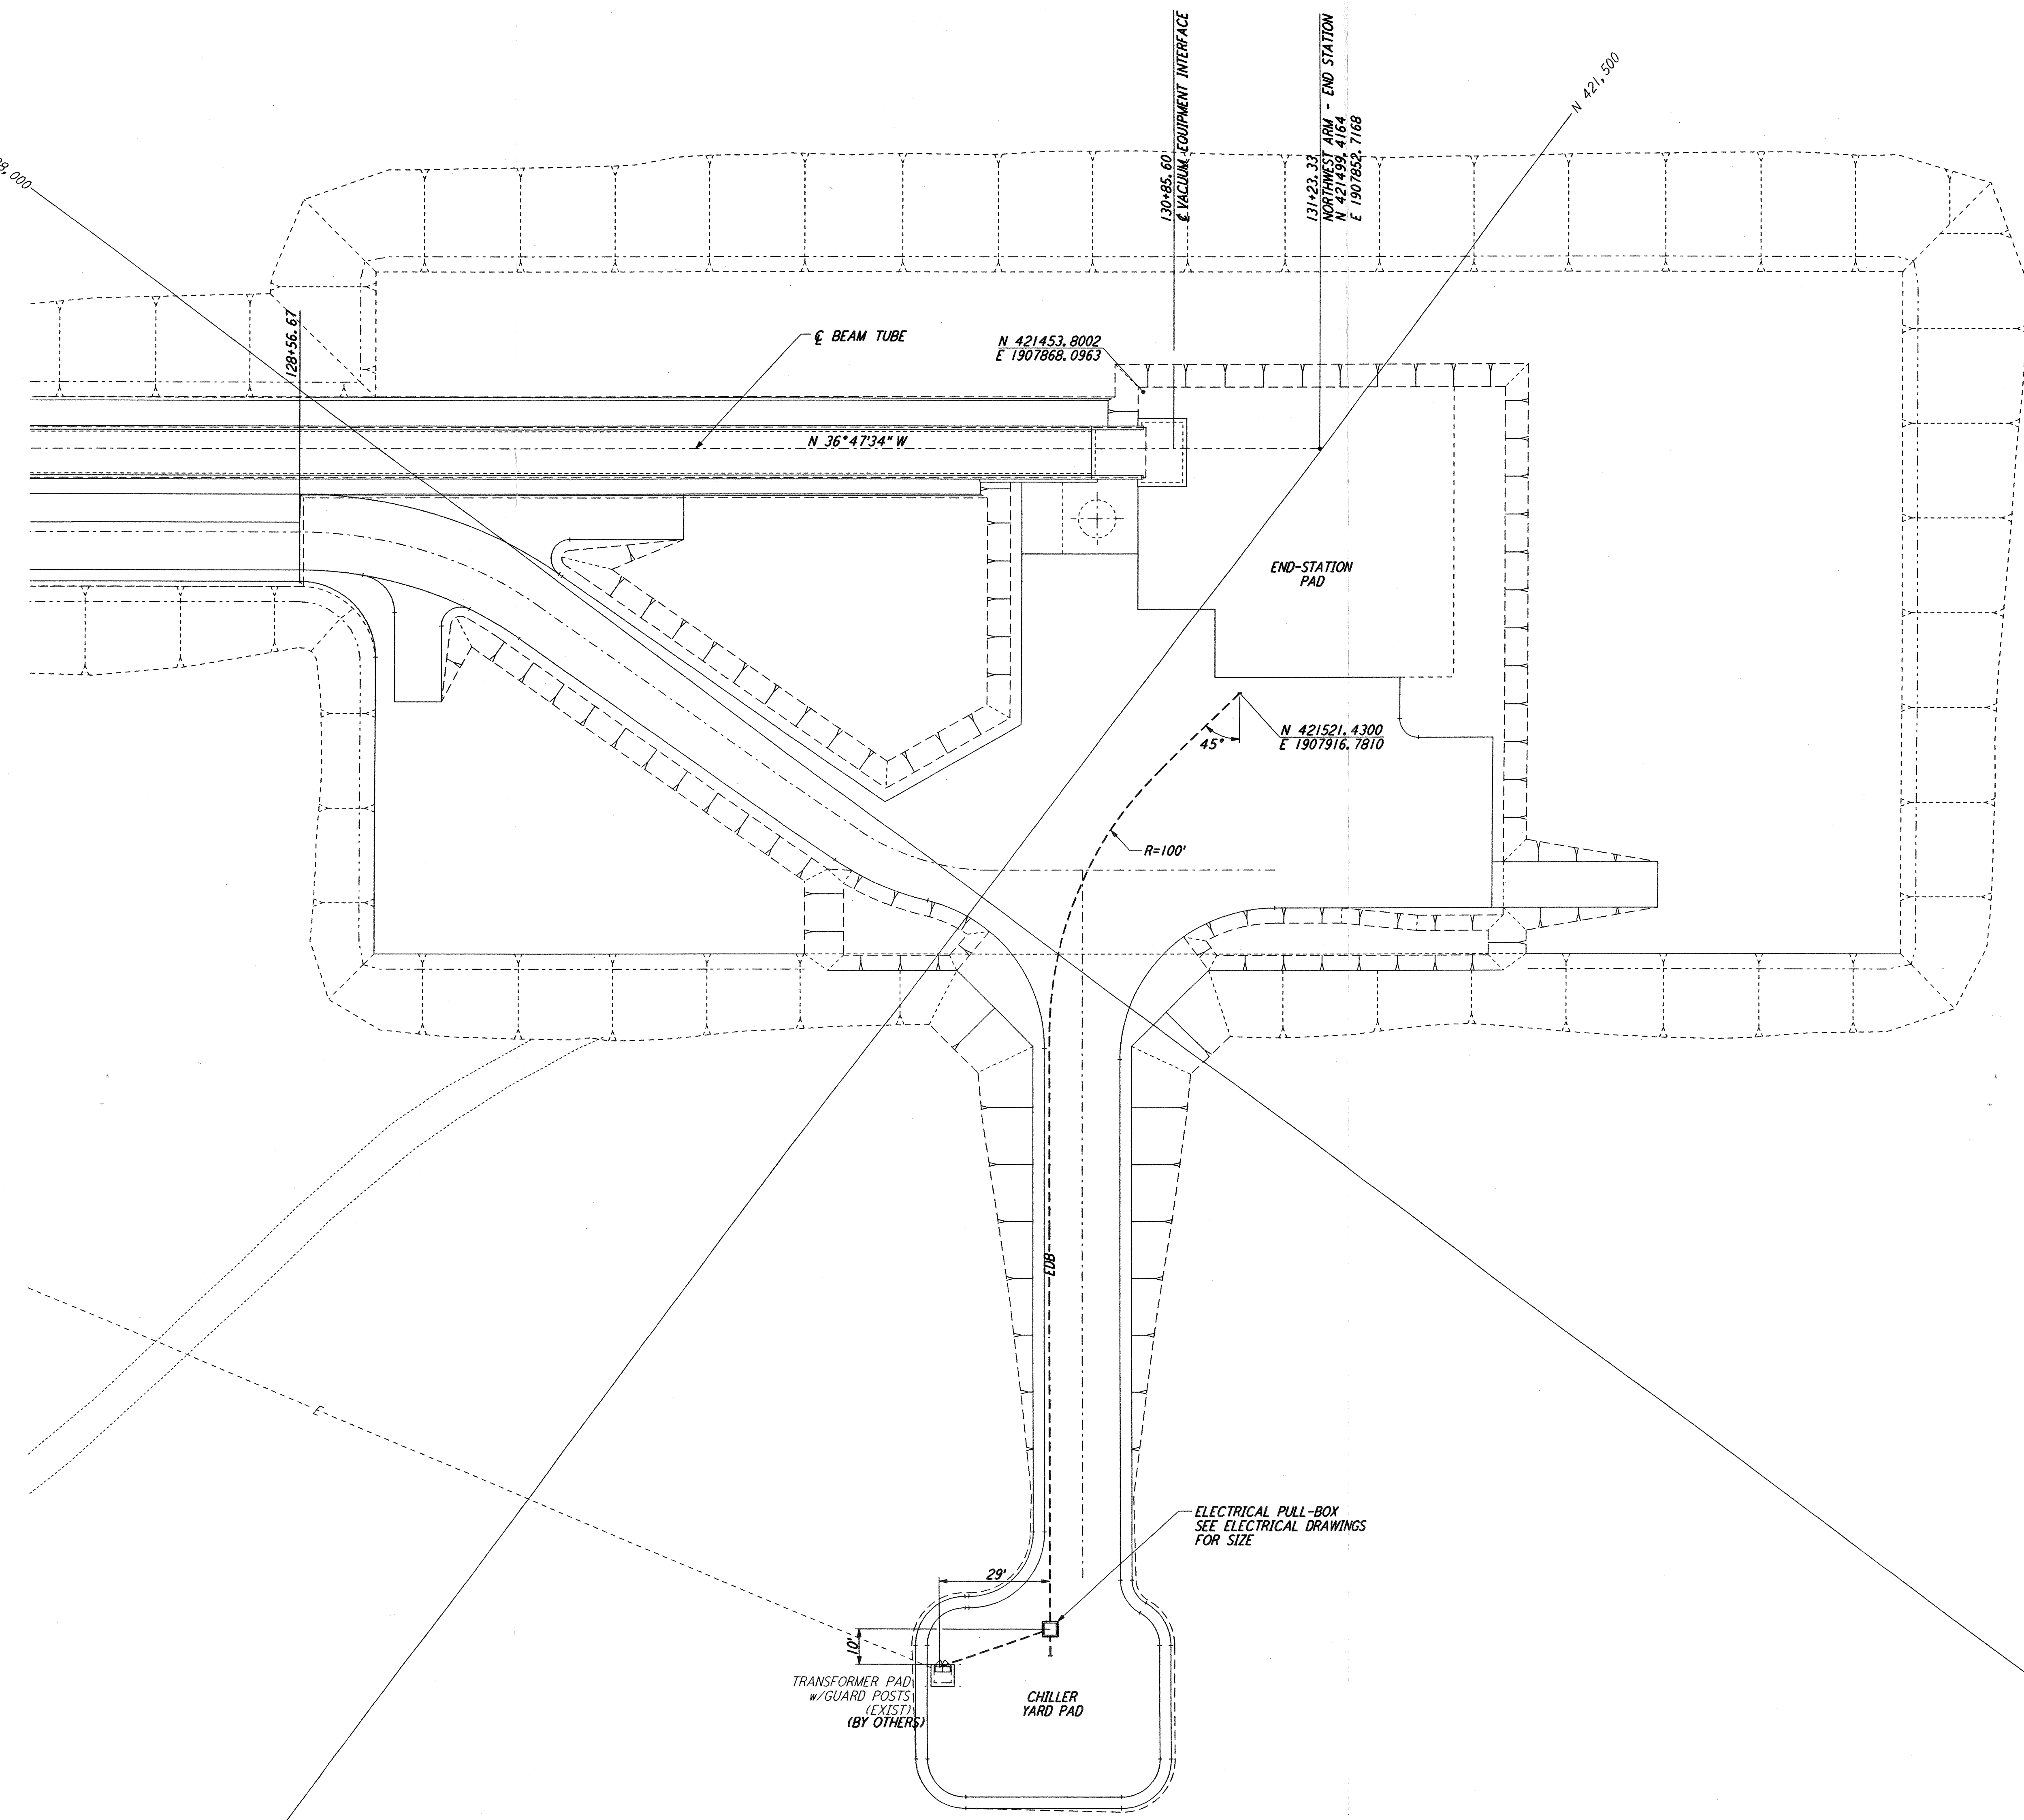

**LIGO-D960721-00-0**

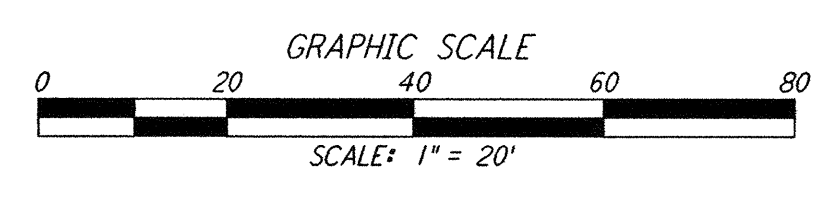

This document and the design it covers are the property of **PARSONS**. They are loaned only with the borrower's expressed written agreement that they will not be reproduced, copied, loaned, exhibited, or used in any other way, except by written consent from **PARSONS** to the borrower.

This document and the design it covers are the property of **PARSONS**. They are loaned only with the borrower's expressed written agreement that they will not be reproduced, copied, loaned, exhibited, or used in any other way, except by written consent from **PARSONS** to the borrower.

NO.	DATE	BY	CHKD	ENGR	PROJ	DESCRIPTION
0	1-22-99	MEI	--	--	MDW	ISSUED FOR AS BUILT
A	4-19-96	WRB	TDM		MDW	CHANGE ORDER NO. 4

DRAWN WRB  
 CHECKED  
 ENGINEER  
 PROJ  
**AS-BUILT DRAWINGS**


**PARSONS**  
 100 WEST WALNUT STREET  
 PASADENA, CALIFORNIA


**LIGO**  
 CALIFORNIA INSTITUTE OF TECHNOLOGY  
 MASSACHUSETTS INSTITUTE OF TECHNOLOGY

LASER INTERFEROMETER  
 GRAVITATIONAL-WAVE OBSERVATORY  
**BTE SITWORK & FABRICATION - HANFORD, WA**  
 TITLE: **CIVIL NORTHWEST ARM END-STATION UTILITY PLAN**  
 SCALE: 1" = 20'  
 SHEET NUMBER: **BT-C-027**  
 CONTRACT NUMBER: PP150969  
 PROJECT NUMBER: 8094  
 REVISIONS: