

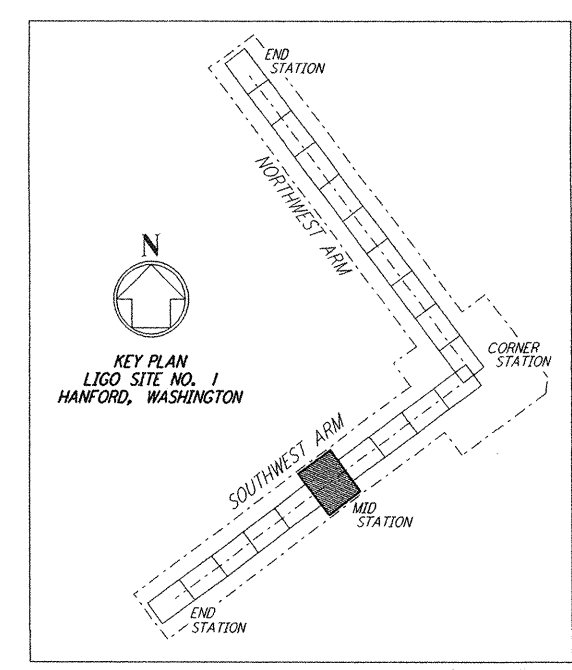
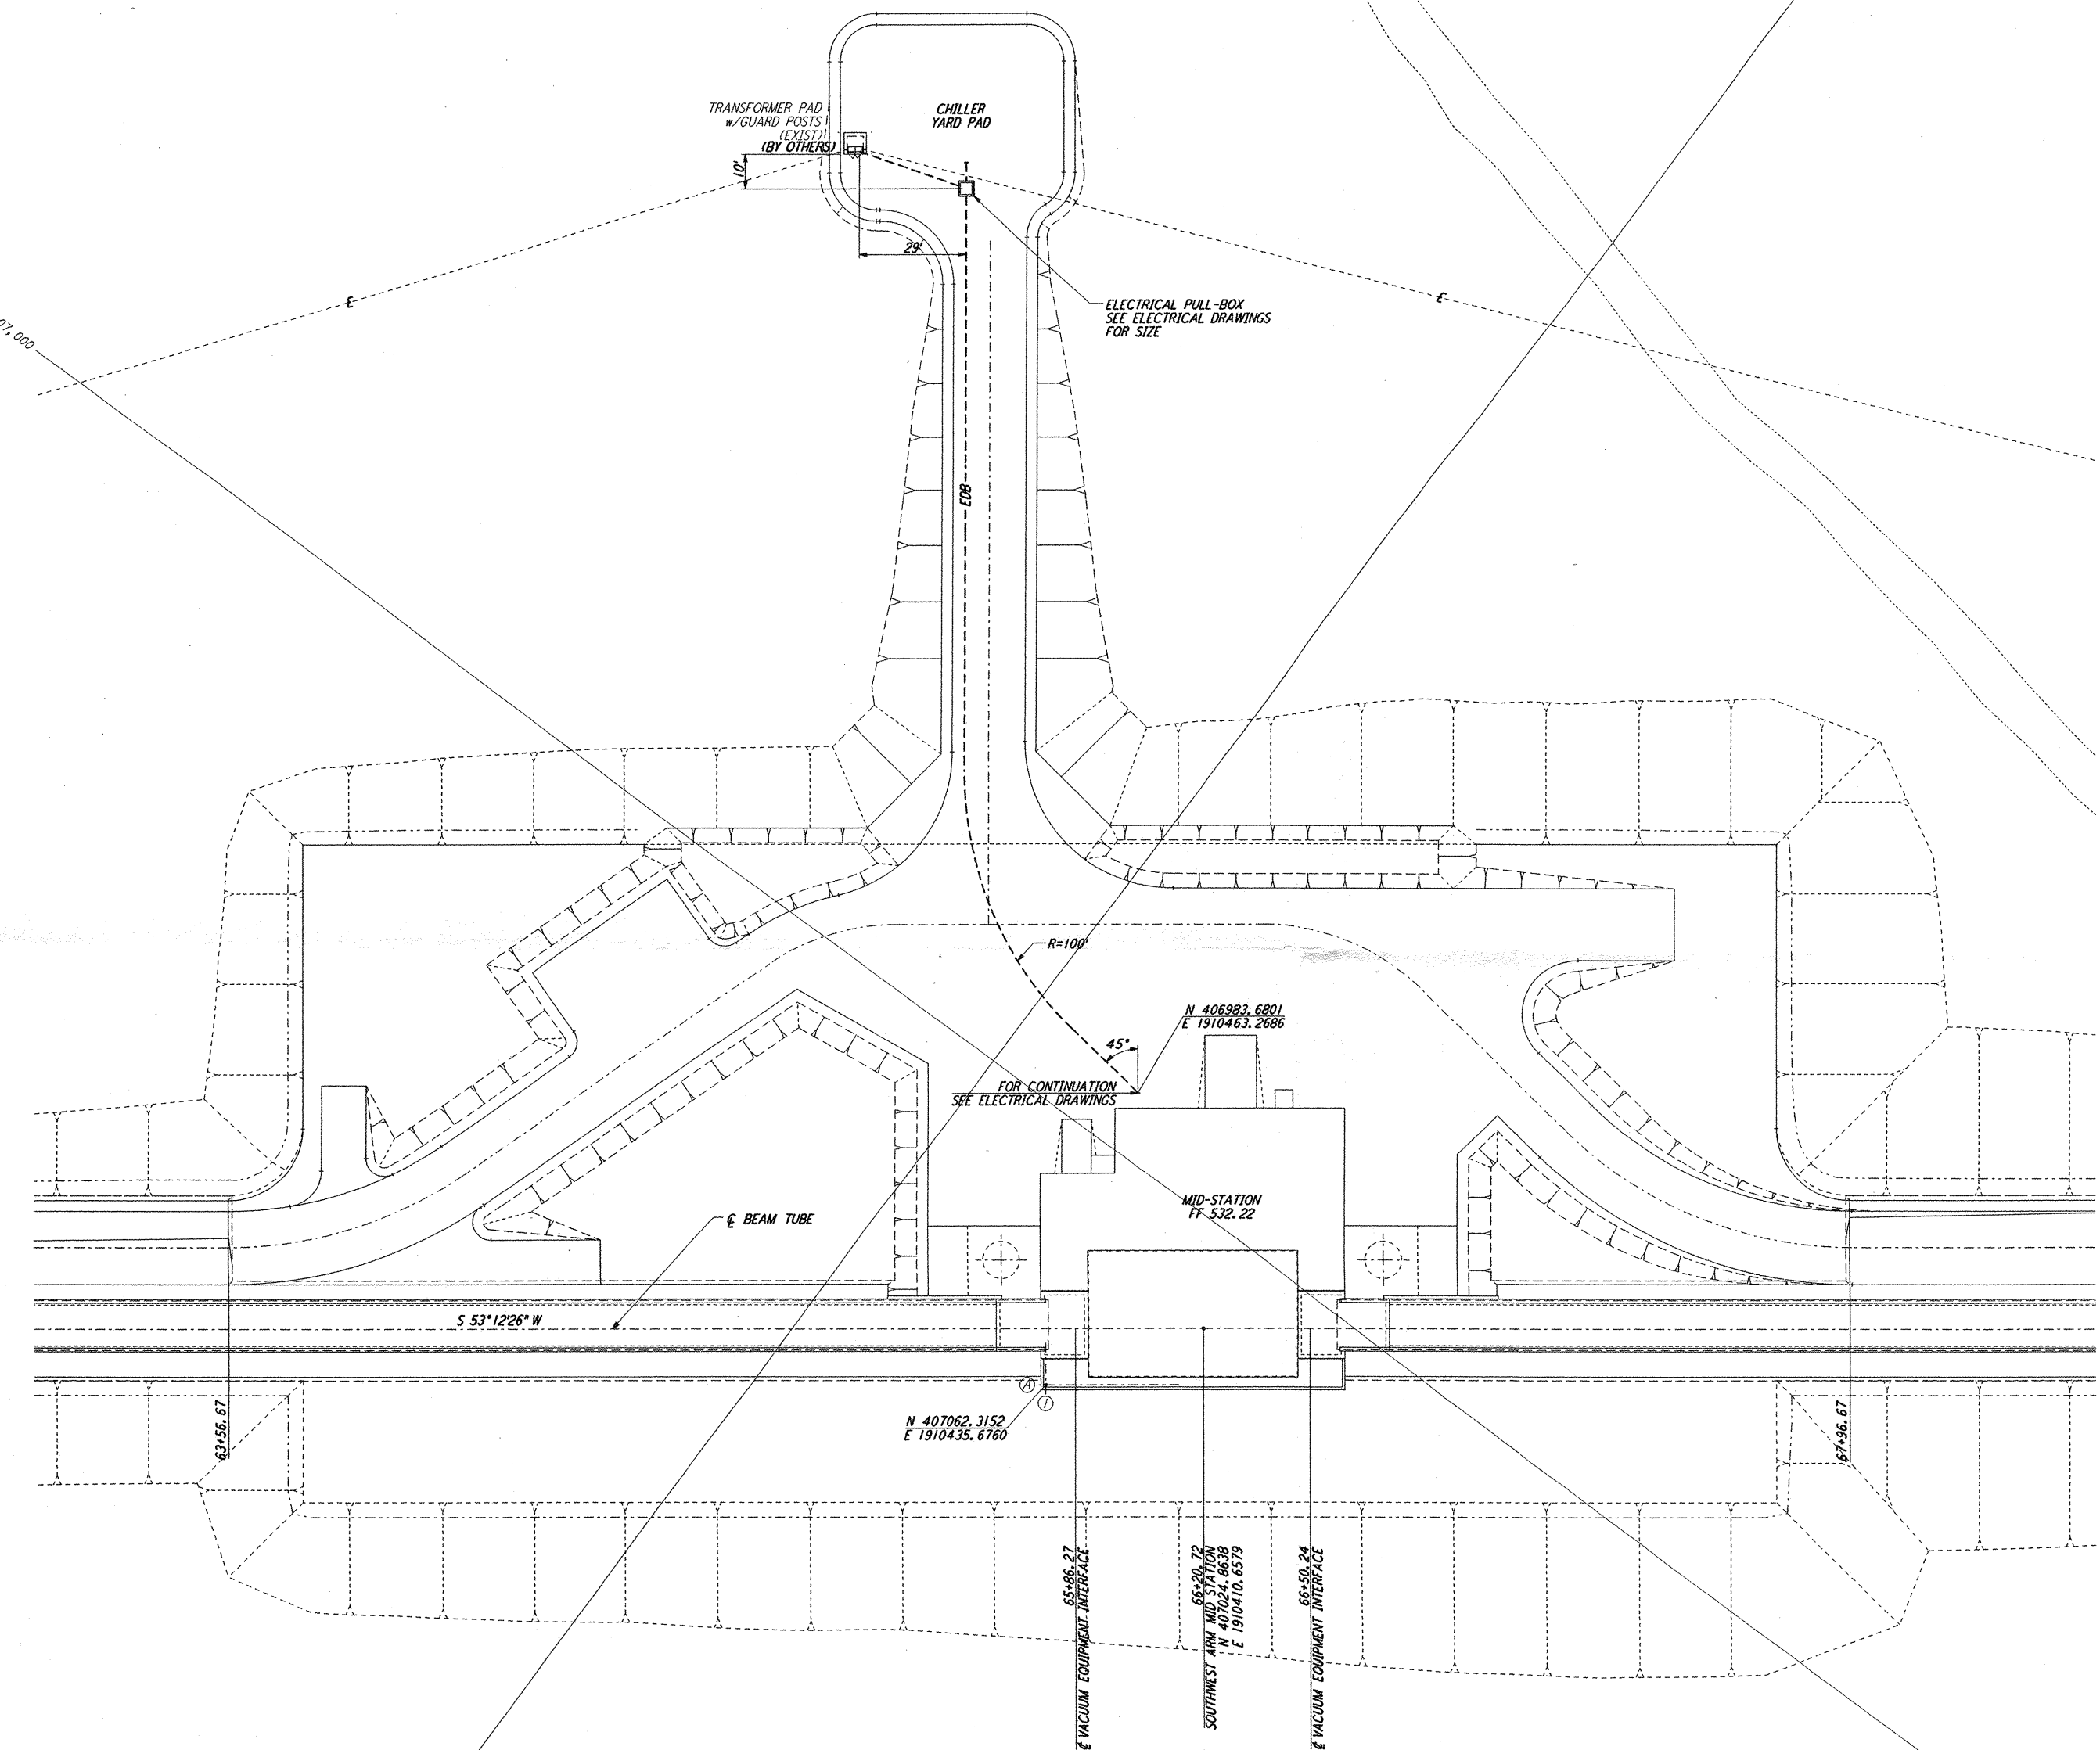


NOTES:
 1. SEE SHEET WA-C-002 FOR GENERAL NOTES, LEGEND AND ABBREVIATIONS.

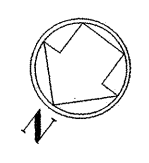

LIGO-D960729-00-O

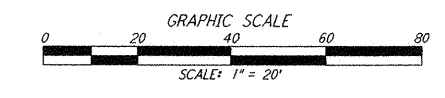

REFERENCES		REVISIONS		DRAWN		CHECKED		ENGINEER		PROJ.	
NO.	DESCRIPTION	NO.	DATE	BY	CHKD	ENGR	PROJ				
0	ISSUED FOR AS BUILT										
A	CHANGE ORDER NO. 4										

AS-BUILT DRAWINGS

PARSONS
 100 WEST WALNUT STREET
 PASADENA, CALIFORNIA

LIGO
 CALIFORNIA INSTITUTE OF TECHNOLOGY
 MASSACHUSETTS INSTITUTE OF TECHNOLOGY

**LASER INTERFEROMETER
 GRAVITATIONAL-WAVE OBSERVATORY
 BTE SITework & FABRICATION - HANFORD, WA**

**CIVIL
 SOUTHWEST ARM
 MID-STATION
 UTILITY PLAN**

SCALE: 1" = 20'
 SHEET NUMBER: BT-C-043
 CONTRACT NUMBER: PP150969
 PROJECT NUMBER: 8094

This document and the design it covers are the property of PARSONS. They are loaned only with the borrower's expressed written agreement that they will not be reproduced, copied, loaned, exhibited, or used in any other way, except by written consent from PARSONS to the borrower.

This document and the design it covers are the property of PARSONS. They are loaned only with the borrower's expressed written agreement that they will not be reproduced, copied, loaned, exhibited, or used in any other way, except by written consent from PARSONS to the borrower.

E
 D
 C
 B
 A
 LIG0BT3.BDR