



**NOTES:**  
 1. SEE SHEET BT-C-002 FOR GENERAL NOTES, LEGEND AND ABBREVIATIONS.

CURVE DATA						
Δ	RADIUS	LENGTH	TANGENT	REMARK		
1	35°00'00"	110'	67.19'	34.68'	PI	EDGE OF PAD (EXIST)
2	35°00'00"	60'	36.65'	18.92'	PI	EDGE OF PAD (EXIST)
3	90°00'00"	20'	31.42'	20.00'	PI	EDGE OF PAD (EXIST)
4	21°32'41"	70'	26.32'	13.32'	PI	EDGE OF PAD (EXIST)
5	76°32'48"	40'	53.44'	31.56'	PI	EDGE OF PAD (EXIST)
6	90°00'00"	40'	62.83'	40.00'	PI	EDGE OF PAD (EXIST)
7	90°00'00"	5'	7.85'	5.00'	PI	EDGE OF PAD (EXIST)
8	90°00'00"	17'	26.70'	17.00'	PI	EDGE OF PAD (EXIST)
9	90°00'00"	13'	20.42'	13.00'	PI	EDGE OF PAD (EXIST)
10	60°00'00"	13'	13.61'	7.51'	PI	EDGE OF PAD (EXIST)
11	60°00'00"	7'	7.33'	4.04'	PI	EDGE OF PAD (EXIST)

COORDINATES			
Δ	NORTH	EAST	REMARK
1	403288.9810	1905392.6680	PI EDGE OF PAD (EXIST)
2	403315.4070	1905372.9040	PI EDGE OF PAD (EXIST)
3	403248.9398	1905422.6147	PI EDGE OF PAD (EXIST)
4	403171.2620	1905480.7100	PI EDGE OF PAD (EXIST)
5	402931.6922	1905160.3876	PI EDGE OF PAD (EXIST)
6	403075.8373	1905052.5815	PI EDGE OF PAD (EXIST)
7	403251.6246	1905402.2720	PI
8	403103.8631	1905353.6693	PI
9	403077.9173	1905318.9776	PI

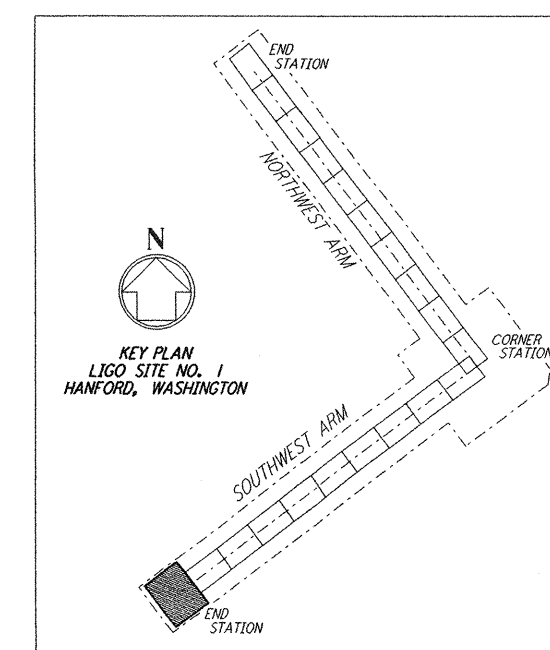

LIGO-D960730-00-0

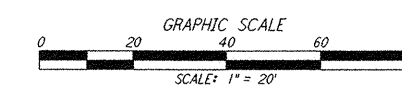

NO.	DATE	BY	CHKD	ENGR	PROJ	DESCRIPTION
0	1-22-99	MEI	--	--	MDW	ISSUED FOR AS BUILT
A	4-19-96	WRB	TDM	--	MDW	CHANGE ORDER NO. 4

**AS-BUILT DRAWINGS**

DRAWN: WRB  
 CHECKED:  
 ENGINEER:  
 PROJ:

**PARSONS**  
 100 WEST WALNUT STREET  
 PASADENA, CALIFORNIA

**LIGO**  
 CALIFORNIA INSTITUTE OF TECHNOLOGY  
 MASSACHUSETTS INSTITUTE OF TECHNOLOGY

LASER INTERFEROMETER  
 GRAVITATIONAL-WAVE OBSERVATORY  
 BTE SITENETWORK & FABRICATION - HANFORD, WA

CIVIL  
 SOUTHWEST ARM  
 END-STATION  
 PLOT PLAN

SCALE: 1" = 20'  
 SHEET NUMBER: PP150969  
 PROJECT NUMBER: 8094  
**BT-C-045**

This document and the design it covers are the property of PARSONS. They are loaned only with the borrower's expressed written agreement that they will not be reproduced, copied, loaned, exhibited, or used in any other way, except by written consent from PARSONS to the borrower.

This document and the design it covers are the property of PARSONS. They are loaned only with the borrower's expressed written agreement that they will not be reproduced, copied, loaned, exhibited, or used in any other way, except by written consent from PARSONS to the borrower.

The Jan 21 14:47:52 1999 C:\PLOT\GUE\33-19882\0CF 52885 KLV36822.e045.prf LIGOBTF3.BDR