

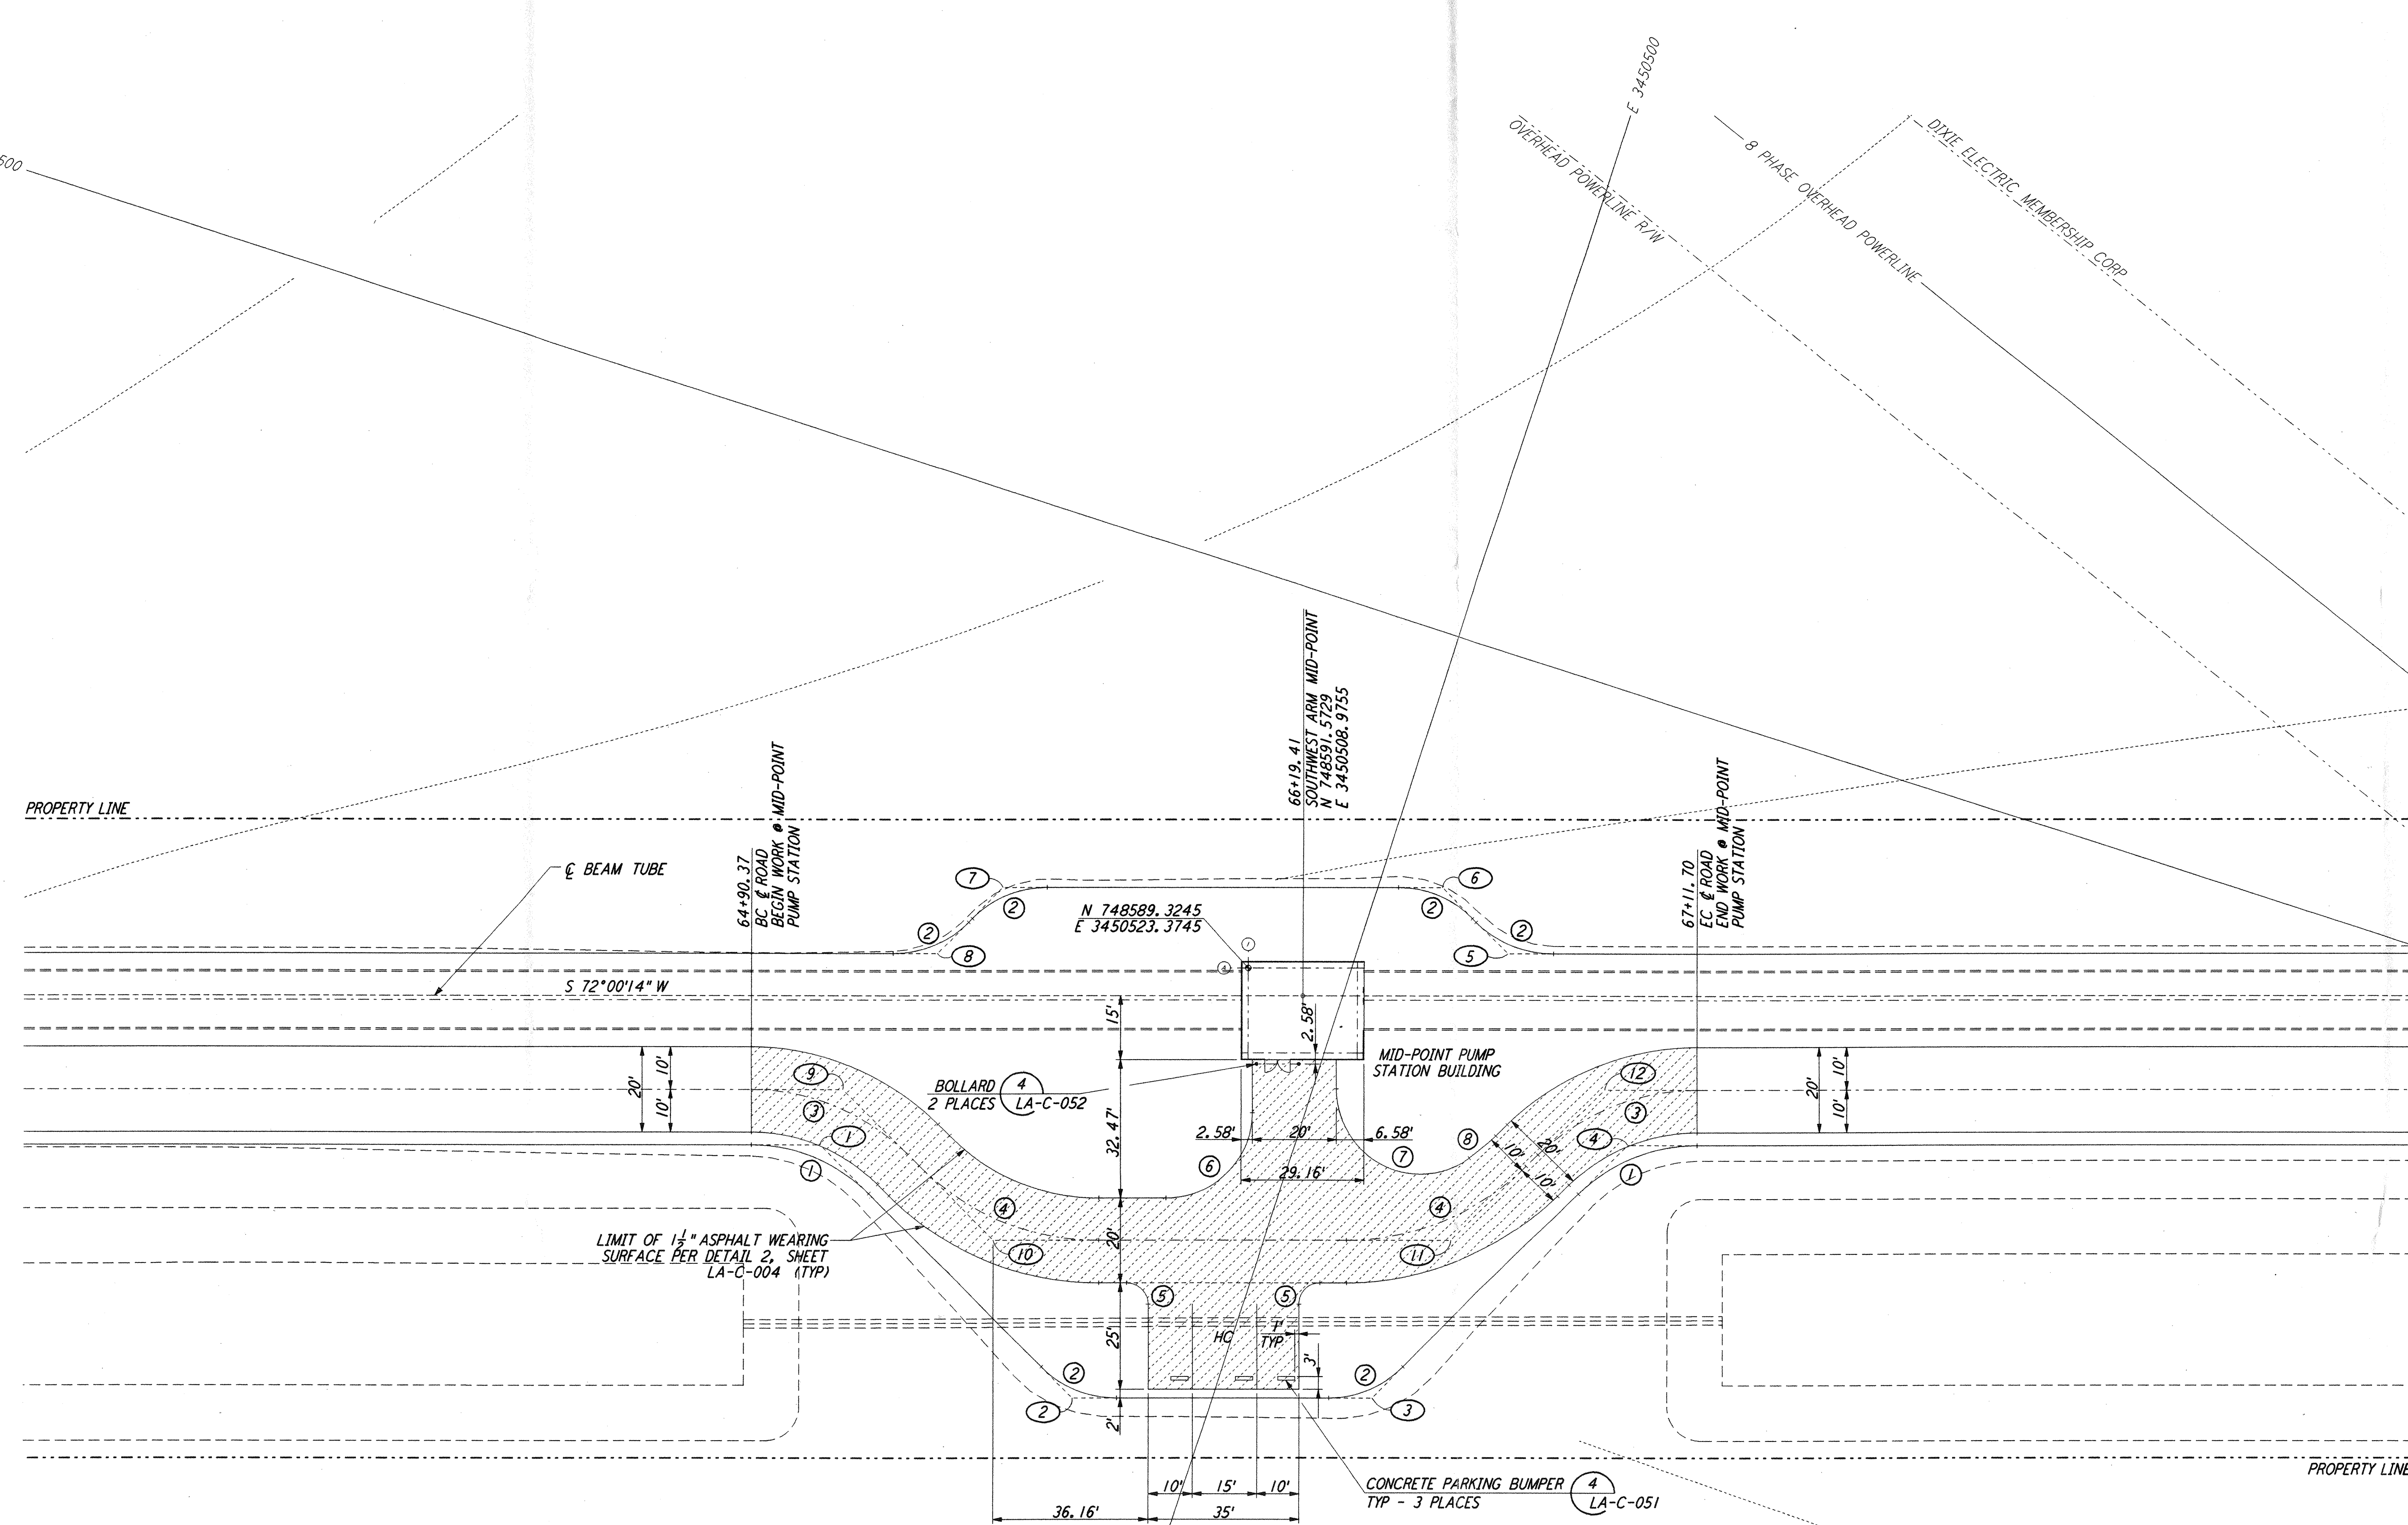
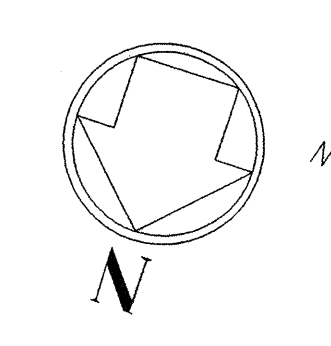


NOTES:
 1. SEE SHEET LA-C-002 FOR GENERAL NOTES, LEGEND AND ABBREVIATIONS.

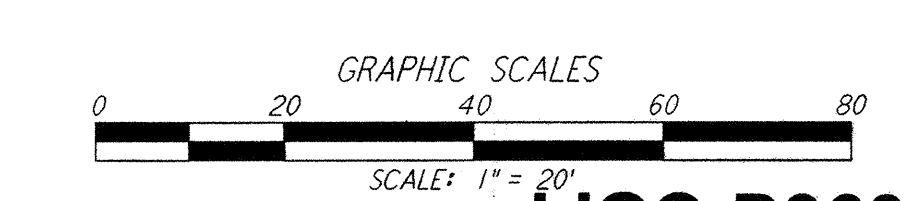

CURVE DATA					
Δ	RADIUS	LENGTH	TANGENT	REMARK	
1	45°00'00"	39'	30.63'	16.16'	EDGE OF PAD (EXIST)
2	45°00'00"	25'	19.63'	10.36'	EDGE OF PAD (EXIST)
3	45°00'00"	52'	40.84'	21.54'	℄ ROAD
4	45°00'00"	60'	47.12'	24.85'	℄ ROAD
5	90°00'00"	5'	7.85'	5.00'	
6	90°00'00"	20'	31.42'	20.00'	
7	125°49'51"	20'	43.92'	39.11'	
8	9°10'08"	50'	8.00'	4.01'	

COORDINATES			
Δ	NORTH	EAST	REMARK
1	748659.7365	3450605.5239	PI EDGE OF PAD (EXIST)
2	748697.9299	3450530.5654	PI EDGE OF PAD (EXIST)
3	748676.2822	3450463.9403	PI EDGE OF PAD (EXIST)
4	748601.3395	3450425.7549	PI EDGE OF PAD (EXIST)
5	748567.0308	3450465.7924	PI EDGE OF PAD (EXIST)
6	748557.0626	3450485.3564	PI EDGE OF PAD (EXIST)
7	748588.8911	3450583.3149	PI EDGE OF PAD (EXIST)
8	748608.4436	3450593.2774	PI EDGE OF PAD (EXIST)
9	748645.7089	3450604.4199	PI ℄ ROAD
10	748668.4802	3450559.7285	PI ℄ ROAD
11	748635.3154	3450457.6570	PI ℄ ROAD
12	748590.6389	3450434.8926	PI ℄ ROAD

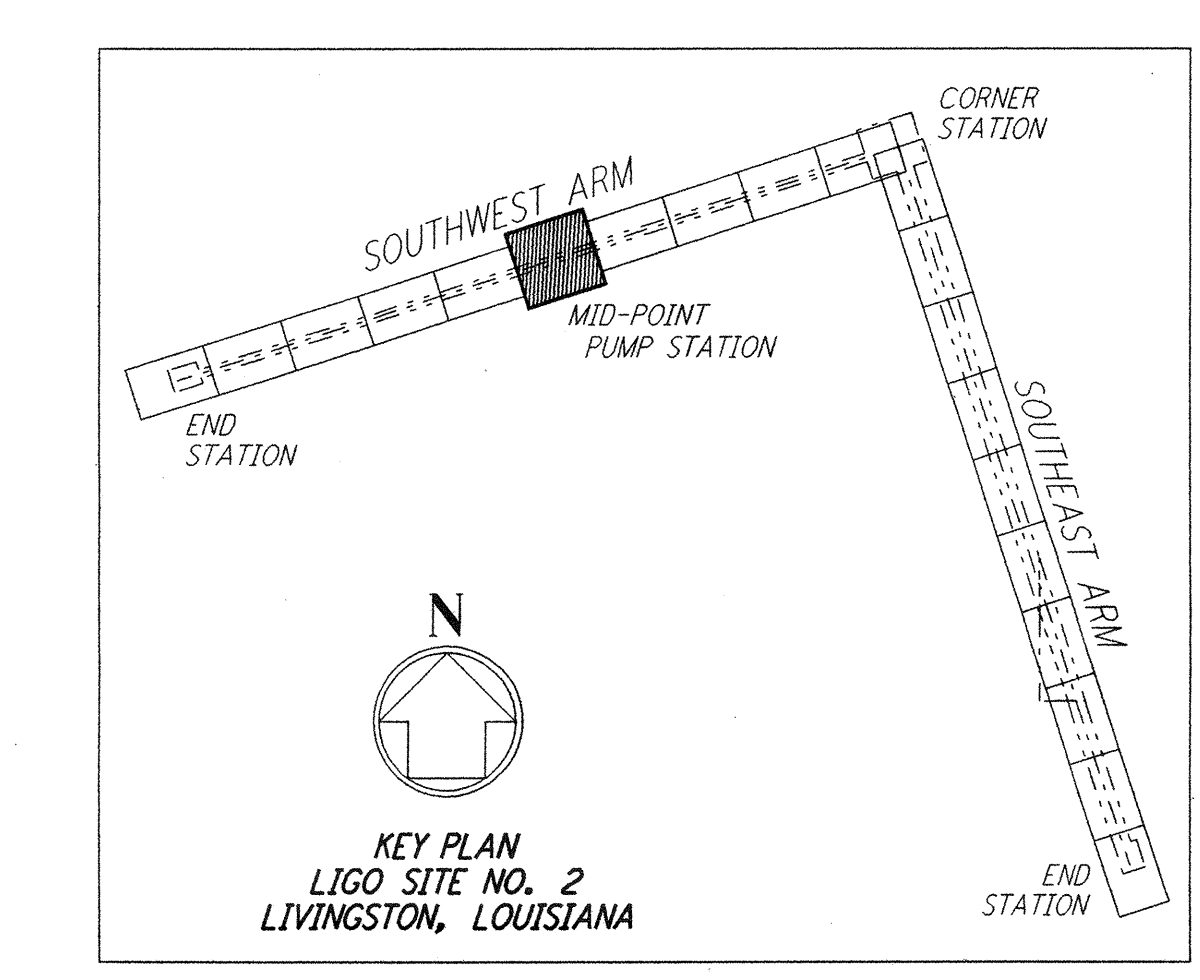

LIGO-D960839-02-0

LASER INTERFEROMETER
 GRAVITATIONAL-WAVE OBSERVATORY
 SITE NO. 2 - LIVINGSTON, LOUISIANA

CIVIL
 SOUTHWEST ARM
 PUMP STATION
 PLOT PLAN

SCALE: 1" = 20'
 CONTRACT NUMBER: PPI50969
 PROJECT NUMBER: 8094
 SHEET NUMBER: **LA-C-021**

PARSONS
 100 WEST WALNUT STREET
 PASADENA, CALIFORNIA

LIGO
 CALIFORNIA INSTITUTE OF TECHNOLOGY
 MASSACHUSETTS INSTITUTE OF TECHNOLOGY

ISSUED FOR CONSTRUCTION	DRAWN	WRB	11-15-96
	CHECKED	ML	11-15-96
	ENGINEER	JB	11-15-96
	PROJ	TDM	11-15-96

AS-BUILT DRAWINGS

NO.	DATE	BY	CHKD	ENGR	PROJ	DESCRIPTION
2	08-07-98	WRB	ML	JB	TDM	ISSUED FOR AS-BUILT
1	2-3-97	WRB	ML	JB	TDM	REVISED MID STATION, CURVE DATA

This document and the design it covers are the property of PARSONS. They are loaned only with the borrower's expressed written agreement that they will not be reproduced, copied, loaned, exhibited, or used in any other way, except by written consent from PARSONS to the borrower.