

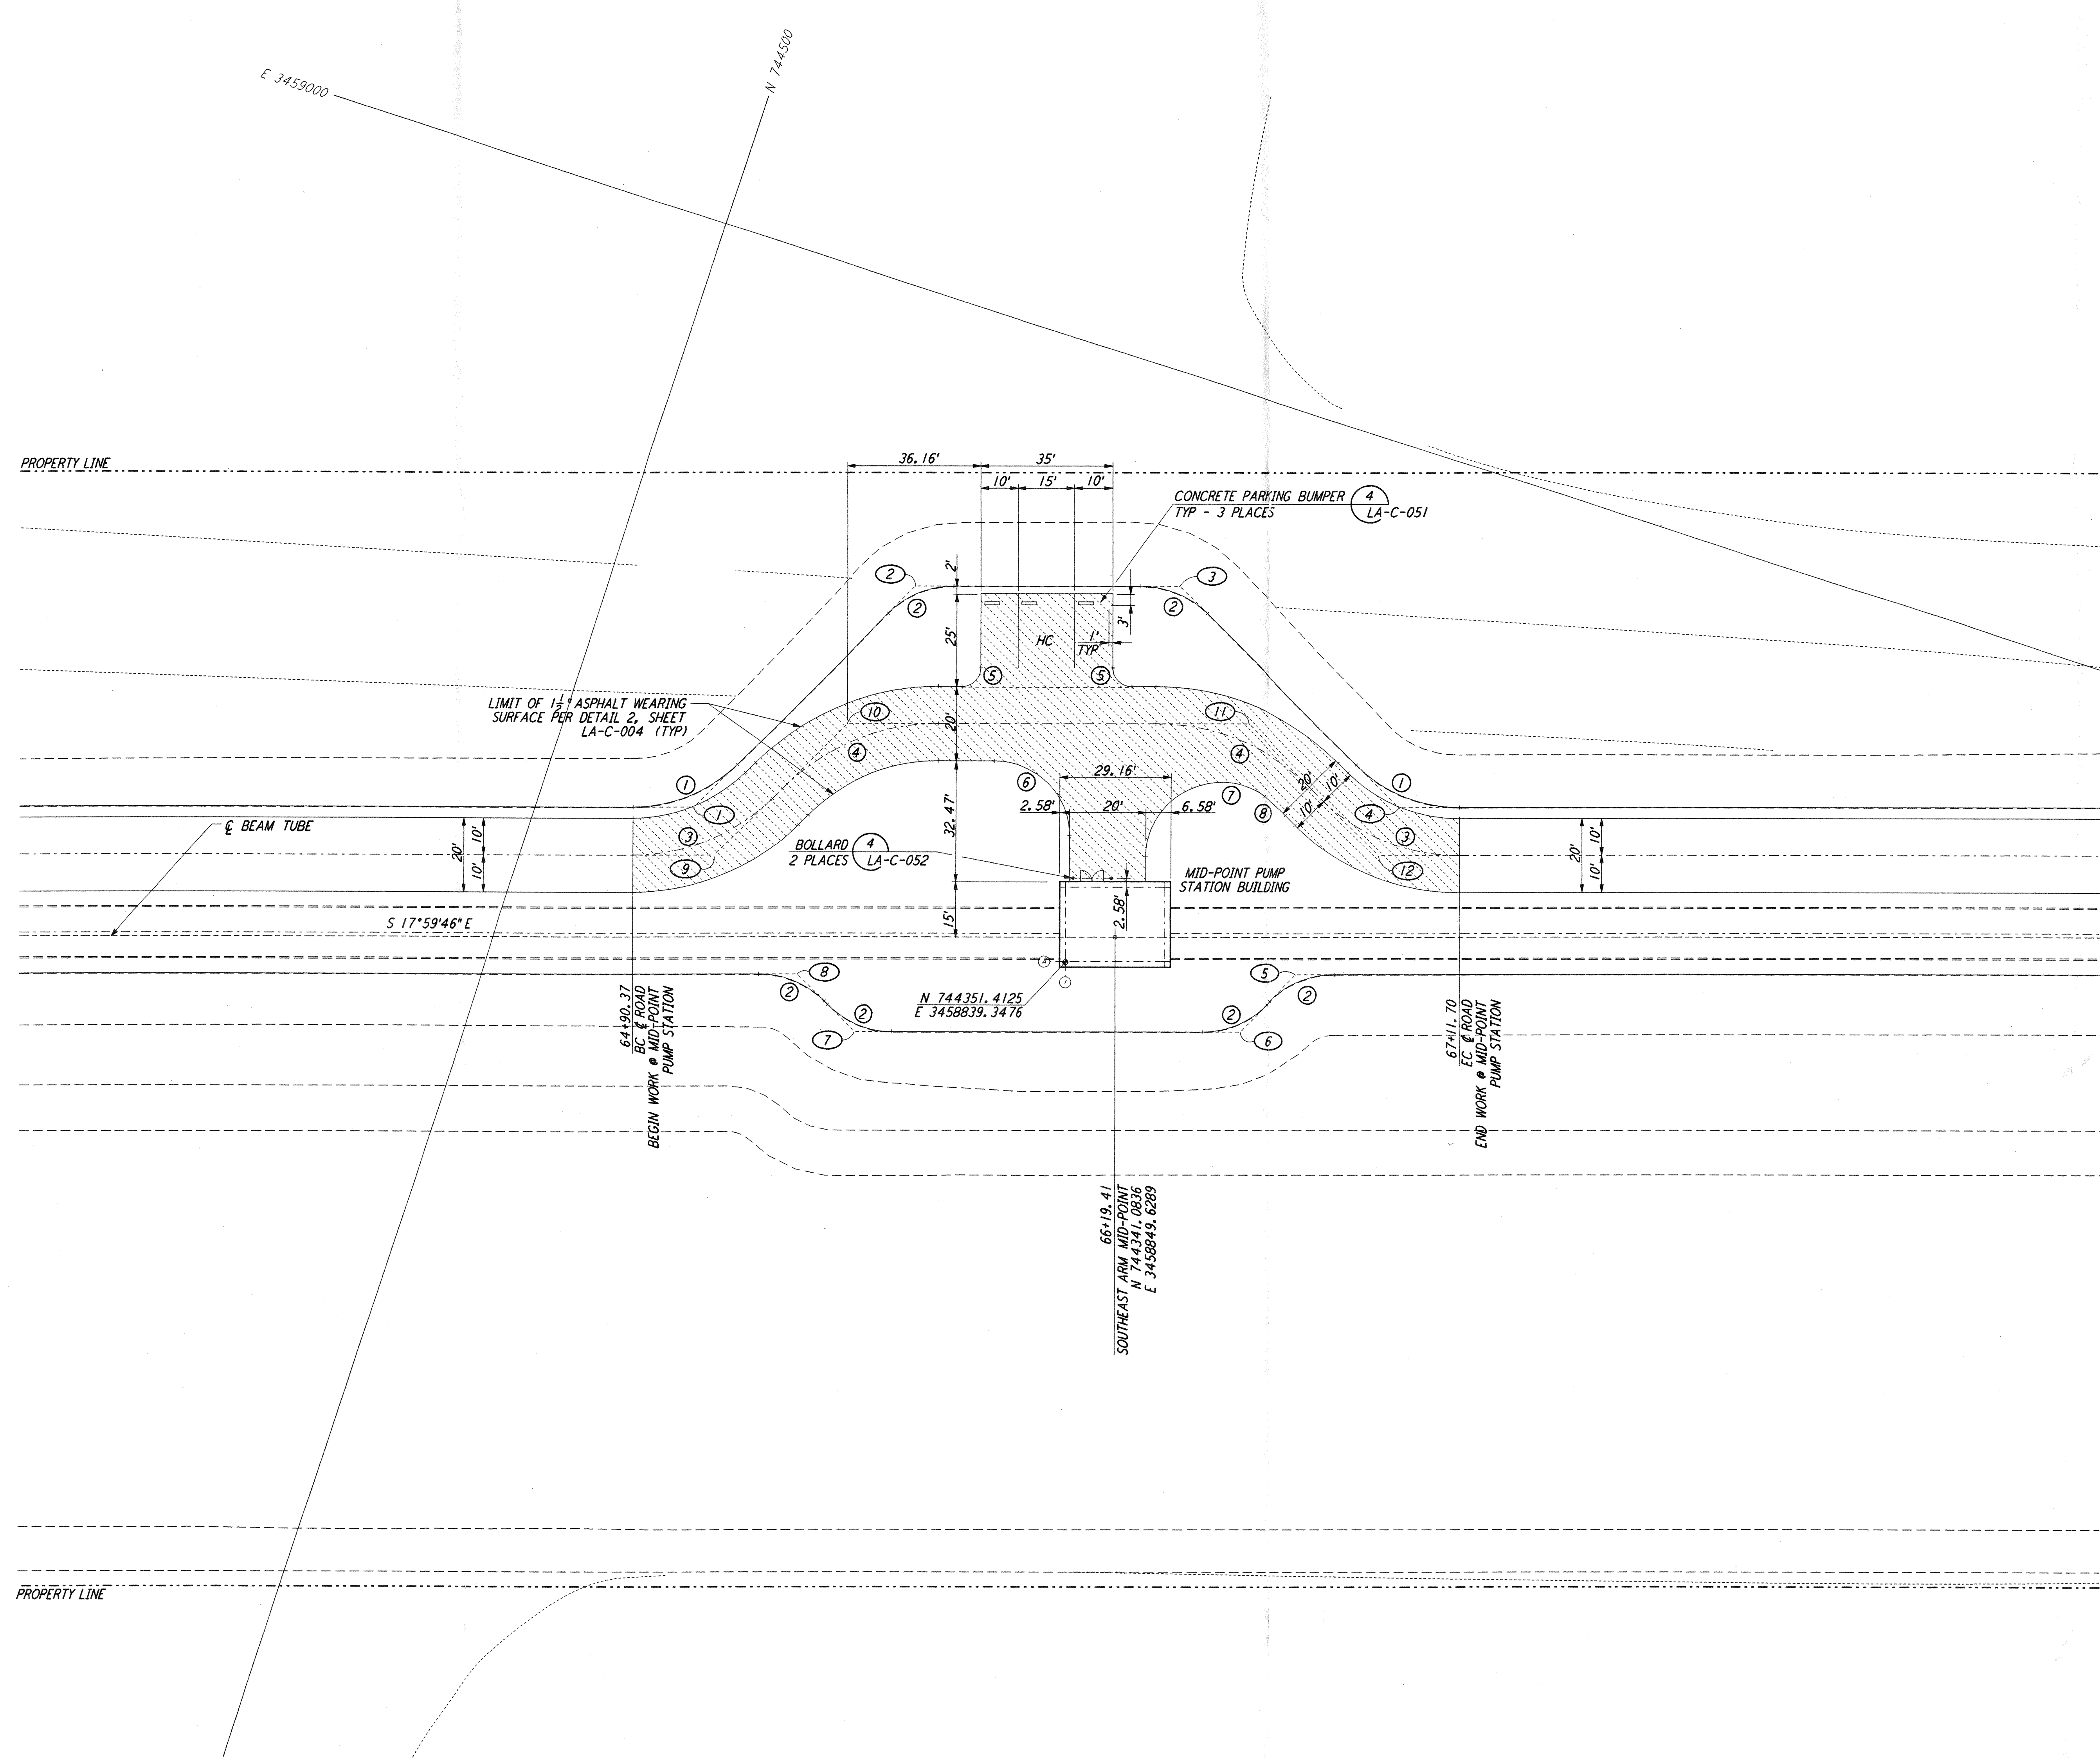
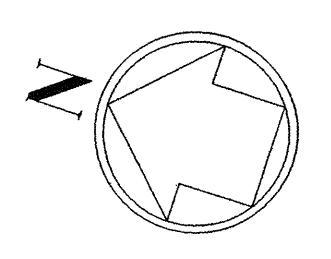


NOTES:
 1. SEE SHEET LA-C-002 FOR GENERAL NOTES, LEGEND AND ABBREVIATIONS.

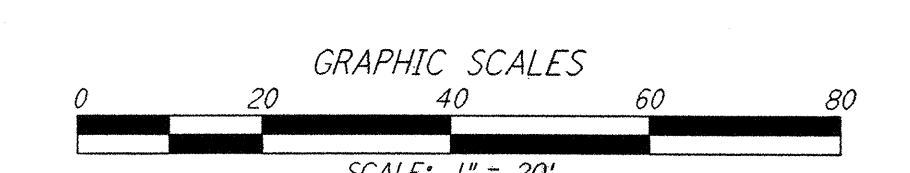

CURVE DATA					
Δ	RADIUS	LENGTH	TANGENT	REMARK	
1	45°00'00"	39'	30.63'	16.16'	EDGE OF PAD (EXIST)
2	45°00'00"	25'	19.63'	10.36'	EDGE OF PAD (EXIST)
3	45°00'00"	52'	40.84'	21.54'	℄ ROAD
4	45°00'00"	60'	47.12'	24.85'	℄ ROAD
5	90°00'00"	5'	7.85'	5.00'	
6	90°00'00"	20'	31.42'	20.00'	
7	125°50'09"	20'	43.92'	39.11'	
8	9°09'53"	50'	8.00'	4.01'	

COORDINATES			
Δ	NORTH	EAST	REMARK
1	744459.2558	3458848.0417	PI EDGE OF PAD (EXIST)
2	744421.0616	3458922.9895	PI EDGE OF PAD (EXIST)
3	744354.4348	3458944.6329	PI EDGE OF PAD (EXIST)
4	744279.4870	3458906.4386	PI EDGE OF PAD (EXIST)
5	744291.7284	3458855.1473	PI EDGE OF PAD (EXIST)
6	744301.6935	3458835.5930	PI EDGE OF PAD (EXIST)
7	744399.6545	3458803.7709	PI EDGE OF PAD (EXIST)
8	744419.2088	3458813.7361	PI EDGE OF PAD (EXIST)
9	744450.1181	3458837.3414	PI ℄ ROAD
10	744427.3479	3458882.0229	PI ℄ ROAD
11	744325.2733	3458915.1812	PI ℄ ROAD
12	744280.5922	3458892.4109	PI ℄ ROAD

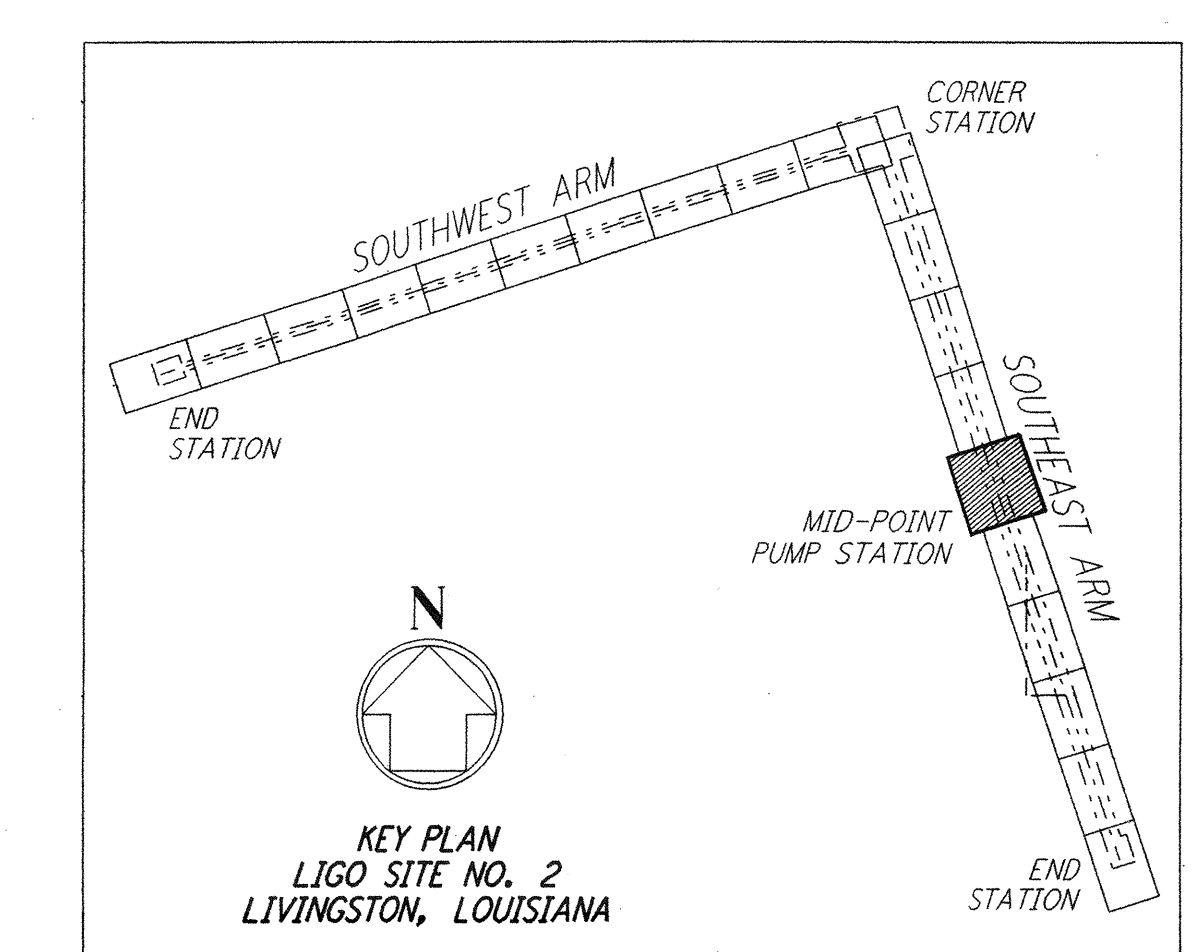

This document and the design it covers are the property of PARSONS. They are loaned only with the borrower's expressed written agreement that they will not be reproduced, copied, loaned, exhibited, or used in any other way, except by written consent from PARSONS to the borrower.

NO.	DATE	BY	CHKD	ENGR	PROJ	DESCRIPTION
2	08-07-98	WRB	CP	JB	WJW	ISSUED FOR AS-BUILT
1	2-3-97	WRB	ML	JB	TDM	REVISED MID STATION, CURVE DATA

ISSUED FOR CONSTRUCTION	
DRAWN	WRB 11-15-96
CHECKED	ML 11-15-96
ENGINEER	JB 11-15-96
PROJ	TDM 11-15-96

AS-BUILT DRAWINGS

100 WEST WALNUT STREET
PASADENA, CALIFORNIA

CALIFORNIA INSTITUTE OF TECHNOLOGY
MASSACHUSETTS INSTITUTE OF TECHNOLOGY

LIGO-D960855-02-0

LASER INTERFEROMETER
GRAVITATIONAL-WAVE OBSERVATORY
SITE NO. 2 - LIVINGSTON, LOUISIANA

TITLE	CIVIL SOUTHWEST ARM PUMP STATION PLOT PLAN	SCALE	1" = 20'	CONTRACT NUMBER	PP150969	PROJECT NUMBER	8094
SHEET NUMBER	LA-C-041	REVISIONS					