


RM. No.	ROOM NAME
121	VESTIBULE #1
122	MULTI-USE
123	ADMIN. ASSISTANT
124	OFFICE
125	OFFICE
126	OFFICE
127	OFFICE
128	OFFICE
129	OFFICE
130	OFFICE
131	OFFICE
132	OFFICE
133	OFFICE
134	OFFICE
135	OFFICE
136	JANITOR
137	SHOWER/ TOILET
138	OPEN OFFICE
139	OPEN OFFICE
140	OFFICE
141	OFFICE
142	OFFICE
143	OFFICE
144	STORAGE
145	KITCHEN
146	CORRIDOR #1
147	CONFERENCE
148	WOMEN
149	MEN
150	STORAGE
151	STORAGE
152	OFFICE

160	MECHANICAL ROOM
161	COMPUTER USERS ROOM
162	FACILITY CONTROL ROOM
163	GENERAL COMPUTING
164	VESTIBULE #3
165	TAPE & COMPUTER MASS STORAGE RM
166	VACUUM PREP ASSEMBLY AREA
167	OPTICS LAB
168	CHANGE ROOM
169	CLEANING ROOM
170	CLEANING AREA
171	ACTIVE STORAGE
172	LONG TERM STORAGE
173	INSPECTION/ SHIPPING RECEIVING
174	MECHANICAL SHOP
175	ELECTRONICS TEST & MAINTENANCE
176	STAIR #1
177	CORRIDOR #2
178	VESTIBULE #4
179	VESTIBULE #2

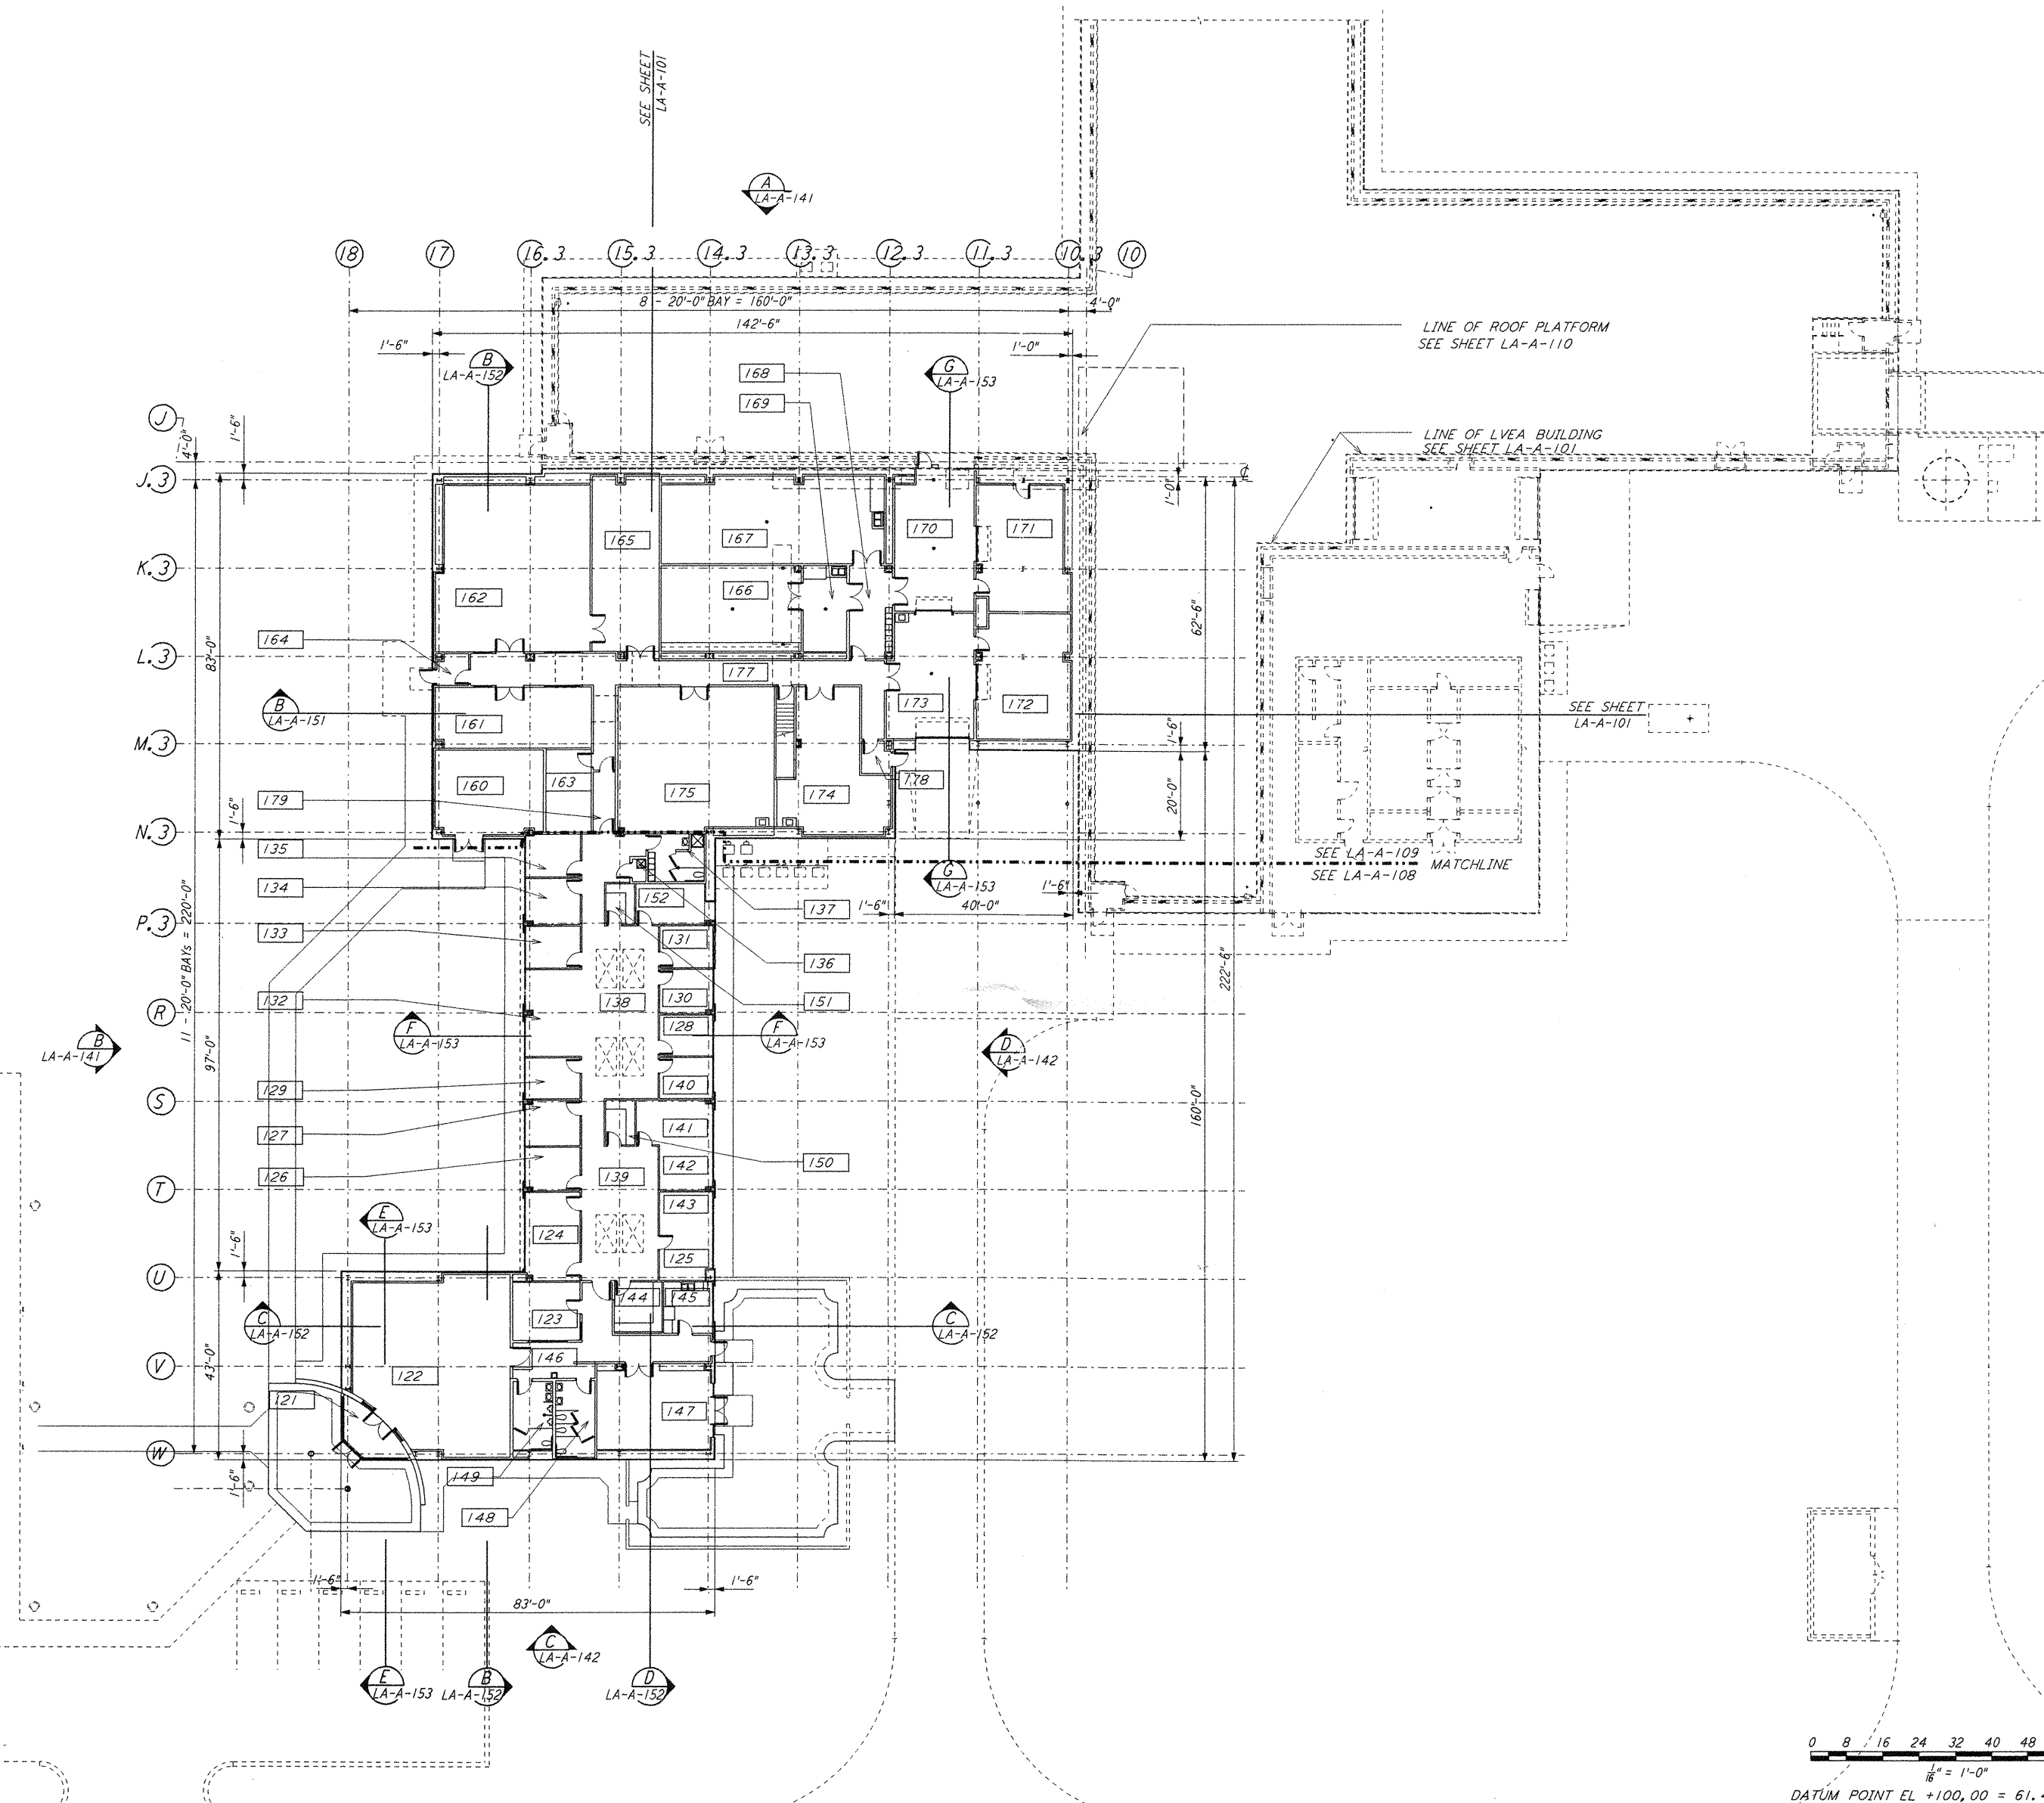

This document and the design it covers are the property of PARSONS. They are loaned only with the borrower's expressed written agreement that they will not be reproduced, copied, loaned, exhibited, or used in any other way, except by written consent from PARSONS to the borrower.

NO.	DATE	BY	CHKD	ENGR	PROJ	DESCRIPTION
2	08-07-98	SJM	AKT	AK	TDM	ISSUED FOR AS-BUILT OSB REVISION
1	2-28-97	CKT	TB	SF	MDW	

ISSUED FOR CONSTRUCTION	
DRAWN	CKT 11-15-96
CHECKED	TB 11-15-96
ENGINEER	SF 11-15-96
PROJ	MDW 11-15-96

AS-BUILT DRAWINGS

PARSONS
 100 WEST WALNUT STREET
 PASADENA, CALIFORNIA

LIGO
 CALIFORNIA INSTITUTE OF TECHNOLOGY
 MASSACHUSETTS INSTITUTE OF TECHNOLOGY

LIGO-D960872-02-0
 LASER INTERFEROMETER
 GRAVITATIONAL-WAVE OBSERVATORY
 SITE NO. 2 - LIVINGSTON, LOUISIANA

ARCHITECTURAL CORNER STATION OSB FLOOR PLAN

AS NOTED PP150969 8094
LA-A-107