




NOTE: SEE SPECIFICATIONS FOR ADDITIONAL INFORMATION AND SCHEDULES

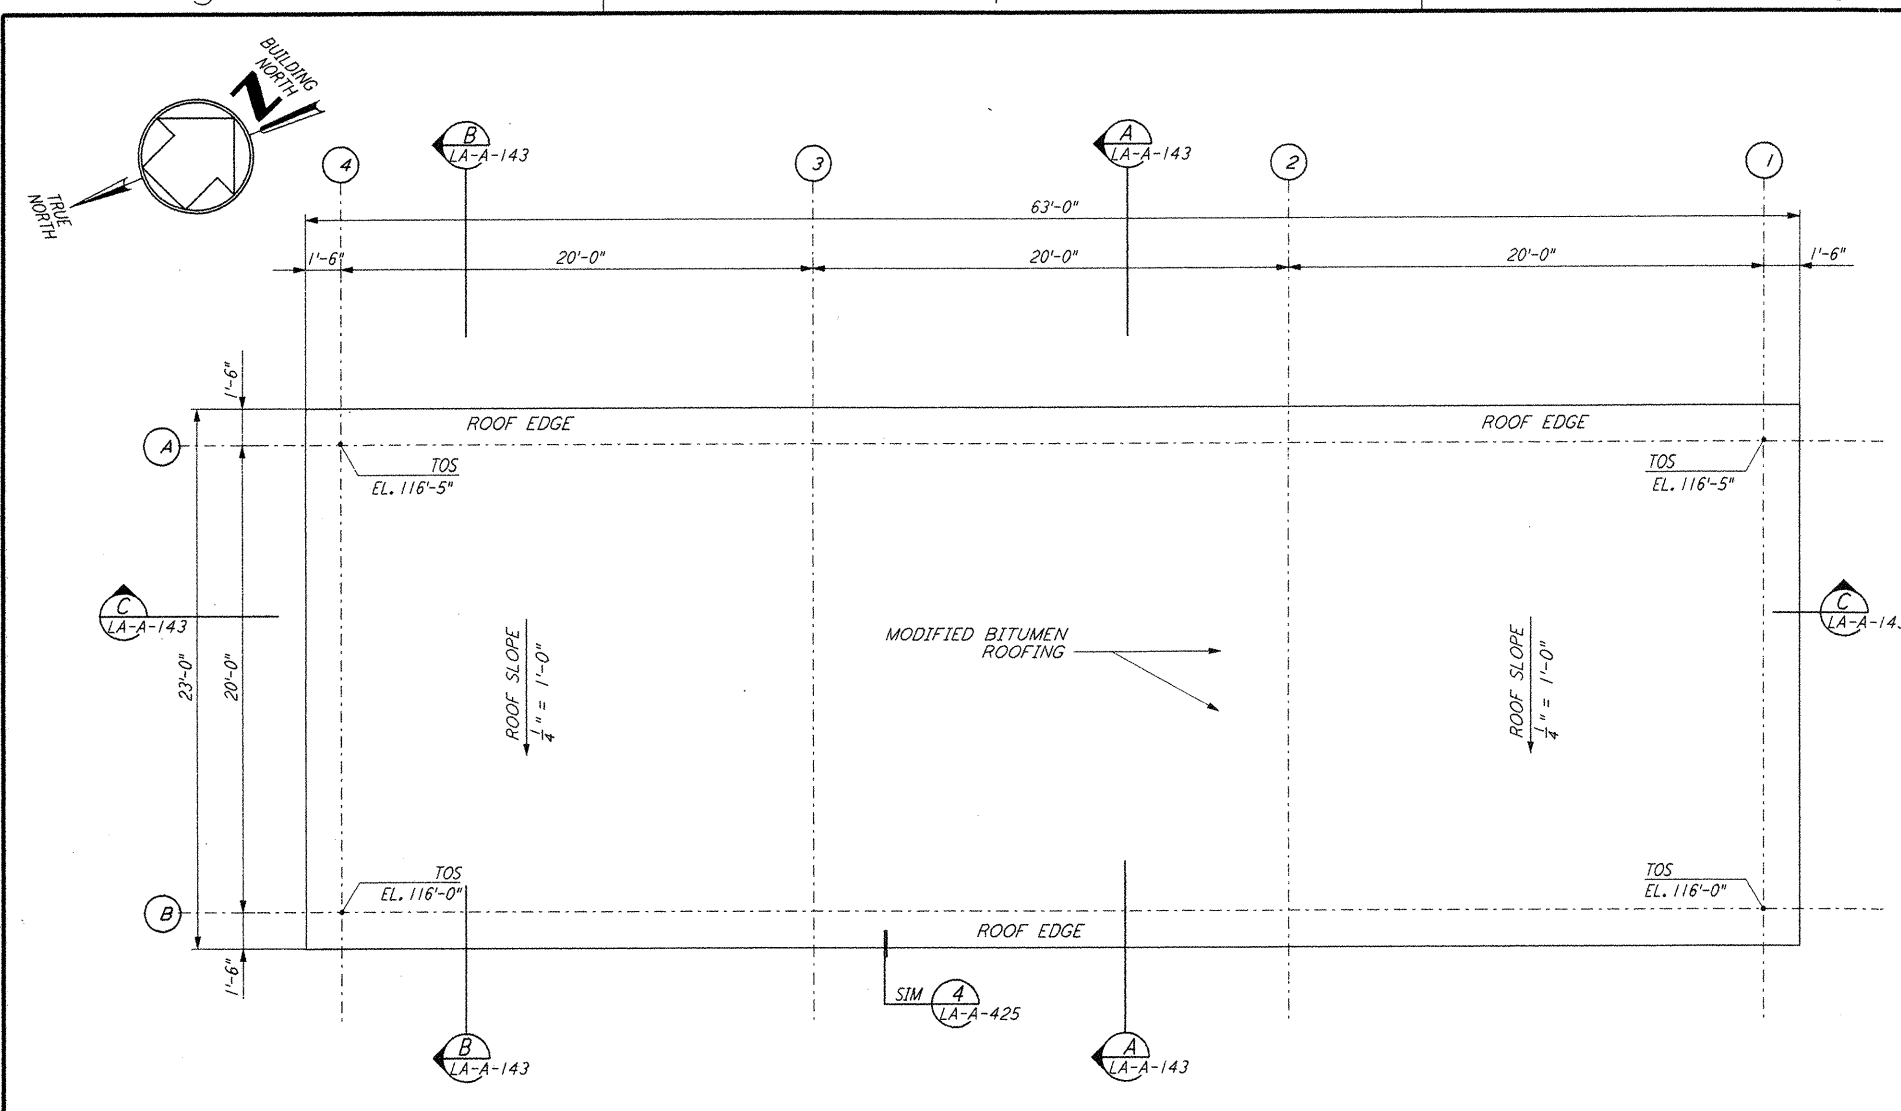


MAINTENANCE BUILDING ROOF PLAN
 1/4" = 1'-0" LA-A-112

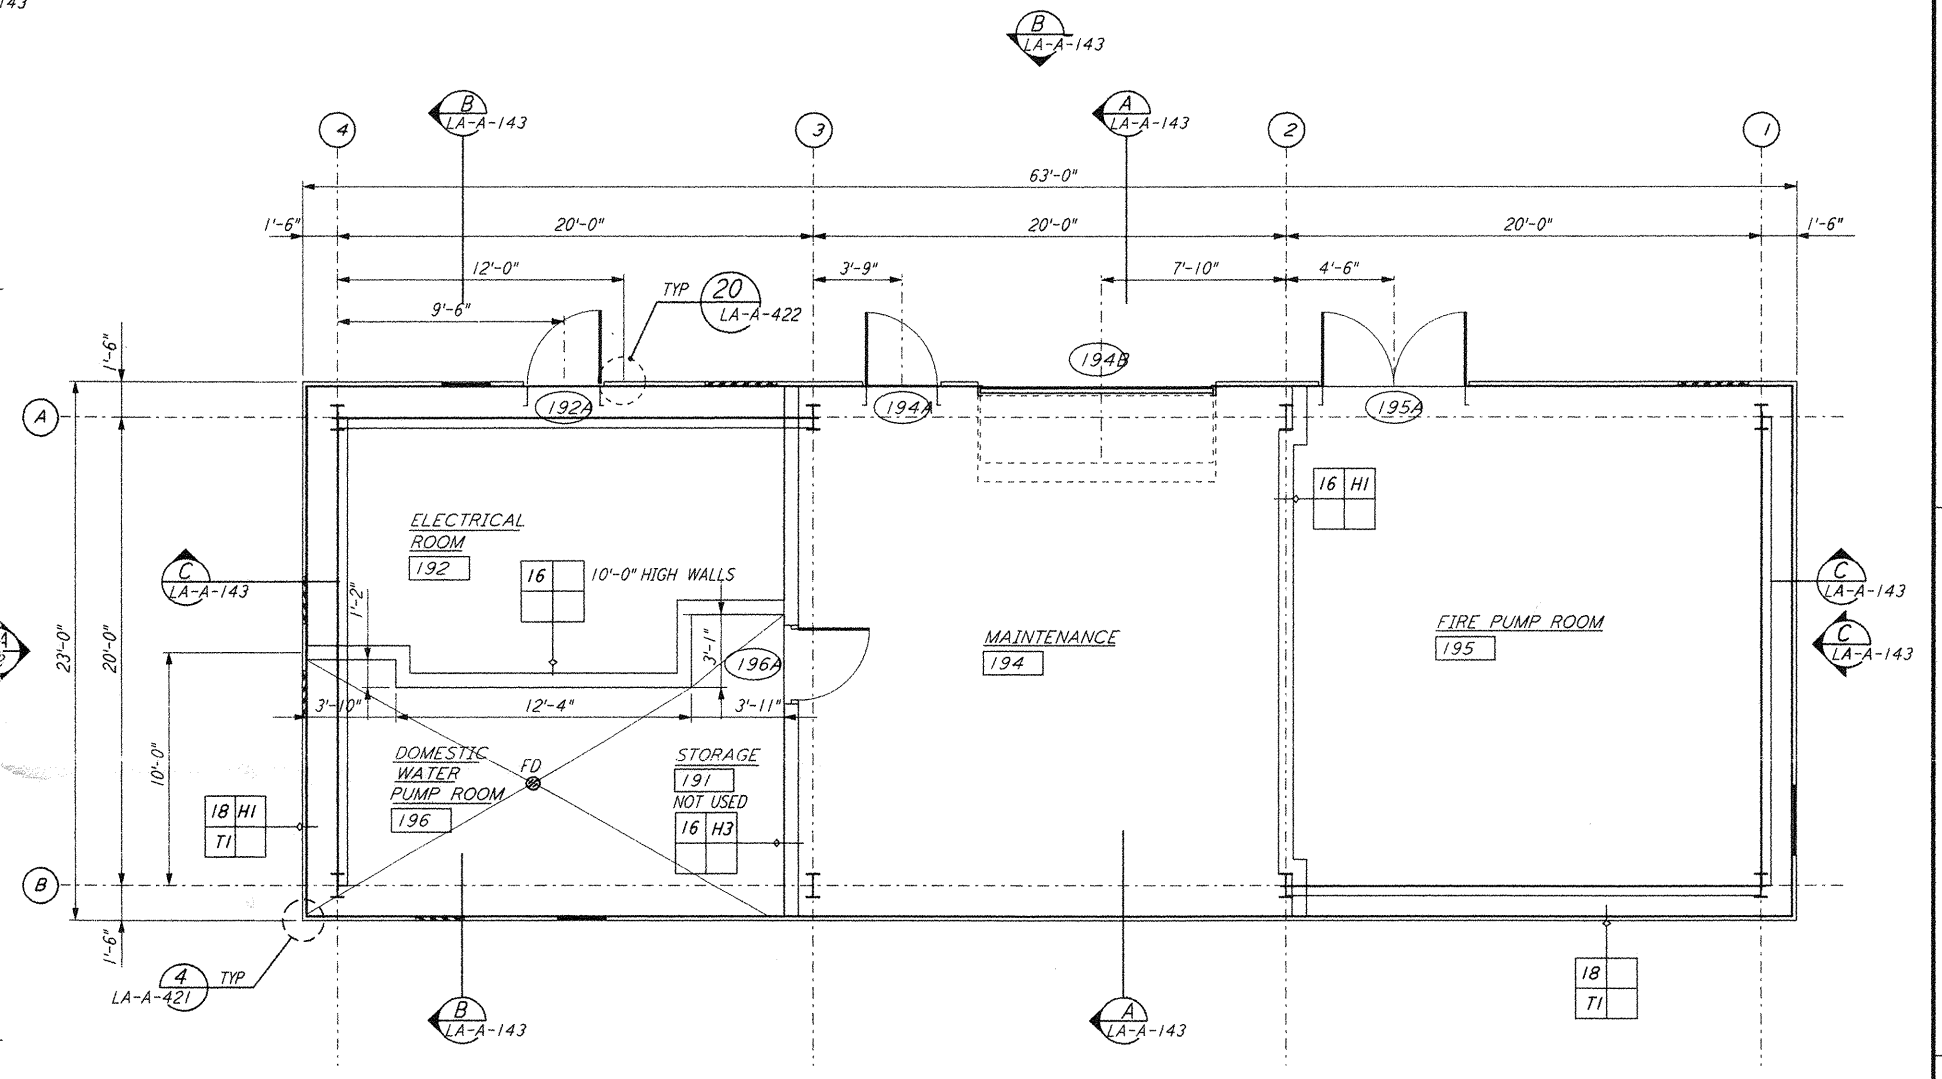

MAINTENANCE BUILDING PLAN
 1/4" = 1'-0" LA-A-112

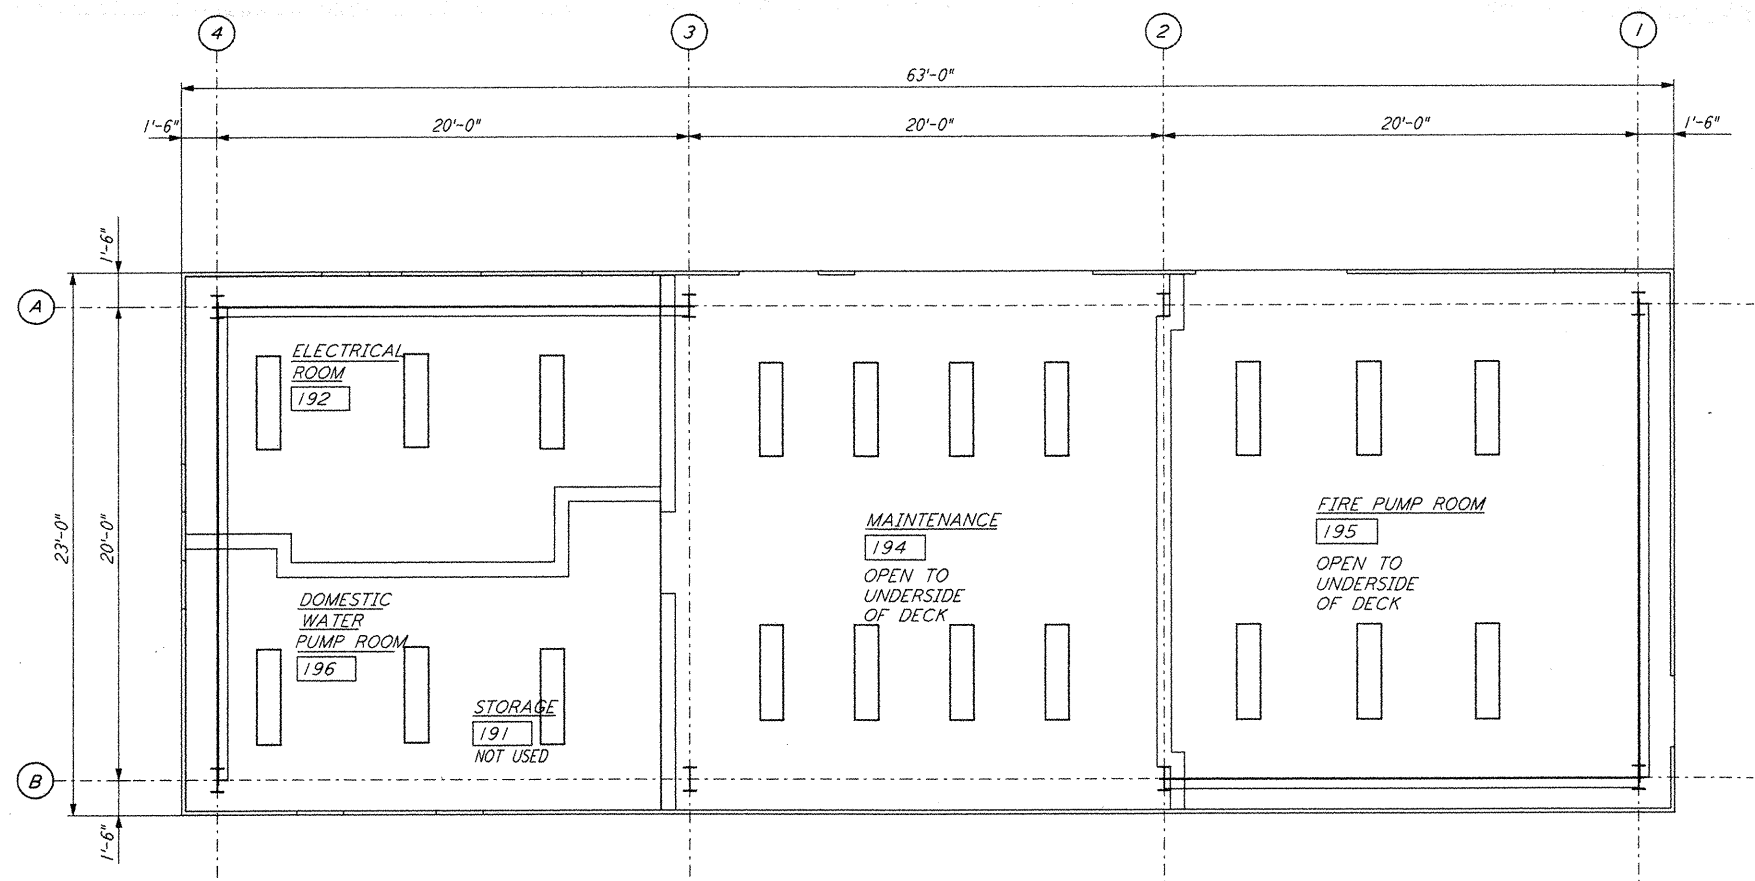

MAINTENANCE BUILDING REFLECTED CEILING PLAN
 1/4" = 1'-0" LA-A-112

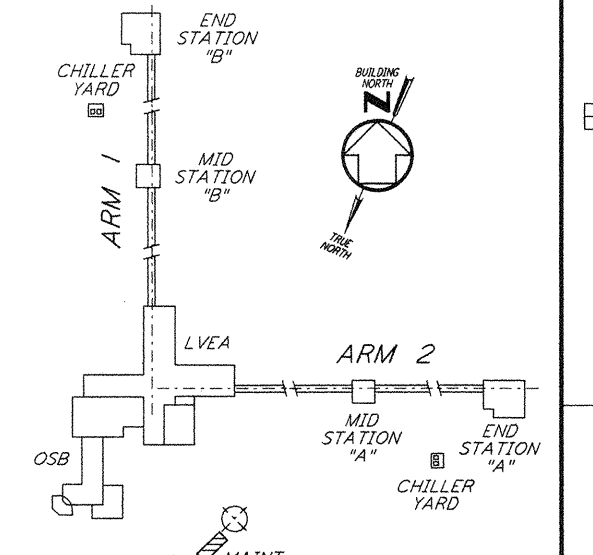

KEY PLAN

DATUM POINT EL +100.00 = 63.12' (MAINTENANCE BLDG)
 0 4 8 12 16 FT
 1/4" = 1'-0"

not be reproduced, copied, loaned, exhibited, or used in any other way, except by written consent from PARSONS to the borrower.

This document and the design it covers are the property of PARSONS. They are loaned only with the borrower's expressed written agreement that they will

NO.	DATE	BY	CHKD	ENGR	PROJ	DESCRIPTION
1	08-07-98	SJM	CKT	TDM		ISSUED FOR AS-BUILT

ISSUED FOR CONSTRUCTION
 DRAWN CKT 11-15-96
 CHECKED TB 11-15-96
 ENGINEER SF 11-15-96
 PROJ TDM 11-15-96

AS-BUILT DRAWINGS

PARSONS
 100 WEST WALNUT STREET
 PASADENA, CALIFORNIA

LIGO
 CALIFORNIA INSTITUTE OF TECHNOLOGY
 MASSACHUSETTS INSTITUTE OF TECHNOLOGY

LASER INTERFEROMETER
 GRAVITATIONAL-WAVE OBSERVATORY
 SITE NO. 2 - LIVINGSTON, LOUISIANA

ARCHITECTURAL CORNER STATION MAINTENANCE BUILDING PLANS

AS NOTED PPI50969 8094
LA-A-112