


NOTE:  
 CEILING GRID TO  
 FRAME AROUND CRANE  
 SUPPORTS EVERY 20'-0" O. C. SEE 17  
 LA-A-424

not be reproduced, copied, loaned, exhibited, or used in  
 any other way, except by written consent from  
**PARSONS** to the borrower.

This document and the design it covers are the property  
 of **PARSONS**. They are loaned only with the  
 borrower's expressed written agreement that they will

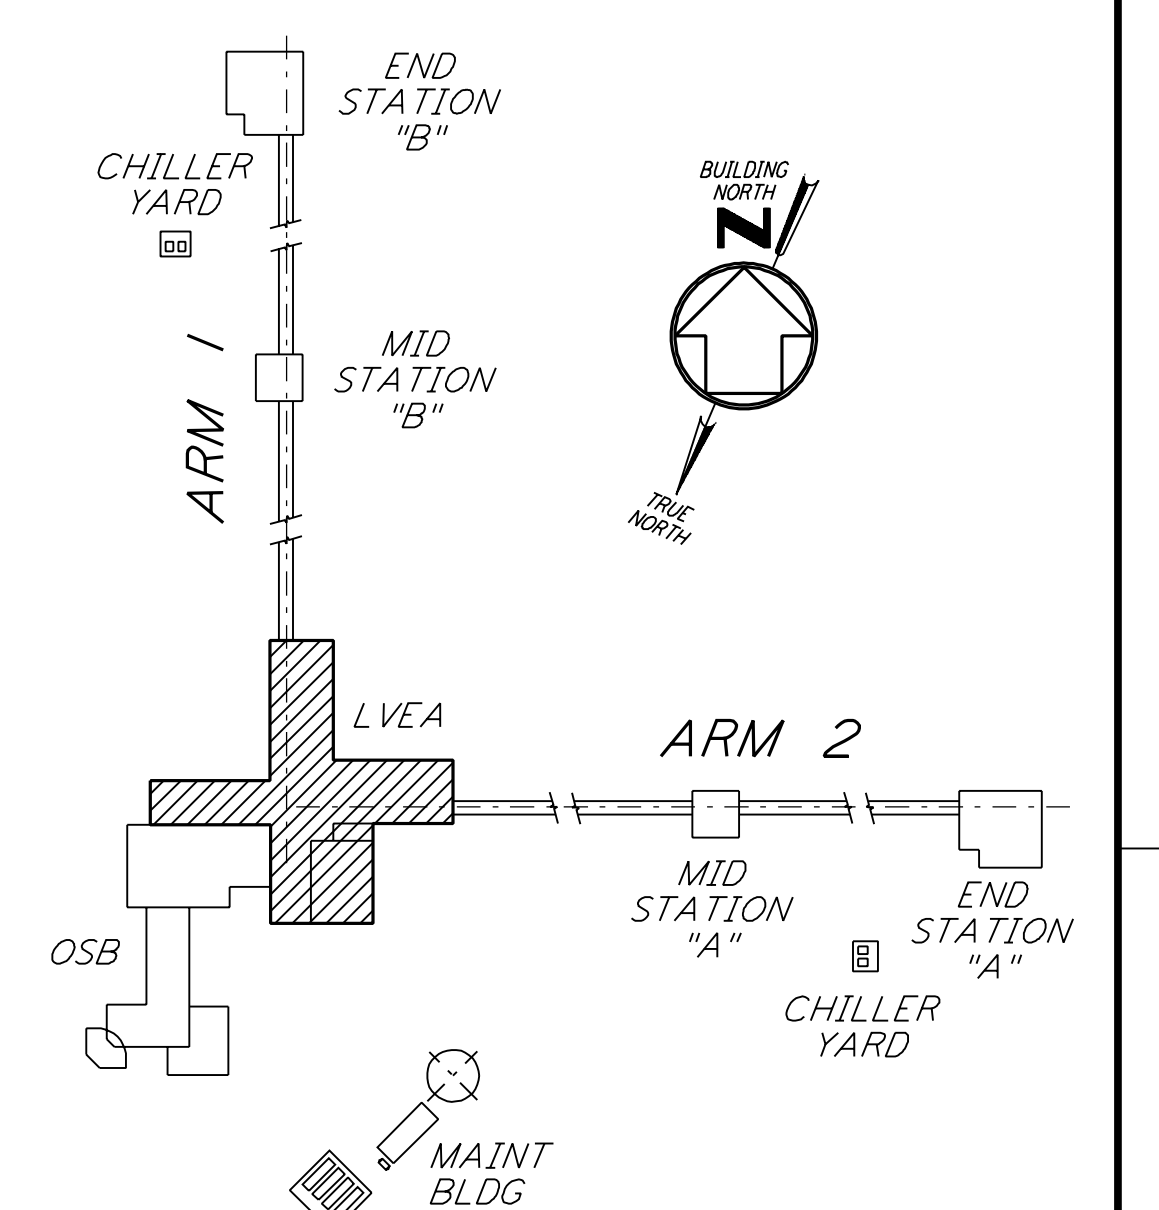

0 8 16 24 32 40 48 56 64 FT  
 1/16" = 1'-0"  
 DATUM POINT EL +100.00 = 61.44' (LVEA)  
 DATUM POINT EL +100.00 = 61.44' (OSB)

KEY PLAN  
**LIGO-D960878-01-0**

NO.	DATE	BY	CHKD	ENGR	PROJ	DESCRIPTION
1	08-07-98	SJM				ISSUED FOR AS-BUILT

ISSUED FOR CONSTRUCTION		
DRAWN	CKT	11-15-96
CHECKED	TB	11-15-96
ENGINEER	SF	11-15-96
PROJ	TDM	11-15-96

**AS-BUILT DRAWINGS**

**PARSONS**  
 100 WEST WALNUT STREET  
 PASADENA, CALIFORNIA

**LIGO**  
 CALIFORNIA INSTITUTE OF TECHNOLOGY  
 MASSACHUSETTS INSTITUTE OF TECHNOLOGY

LASER INTERFEROMETER  
 GRAVITATIONAL-WAVE OBSERVATORY  
 SITE NO. 2 - LIVINGSTON, LOUISIANA

TITLE	SCALE	CONTRACT NUMBER	PROJECT NUMBER
ARCHITECTURAL CORNER STATION LVEA REFLECTED CEILING PLAN	AS NOTED	PP150969	8094
SHEET NUMBER	REVISIONS		
<b>LA-A-121</b>			