



SEE SHEET LA-A-107

SEE SHEET LA-A-107

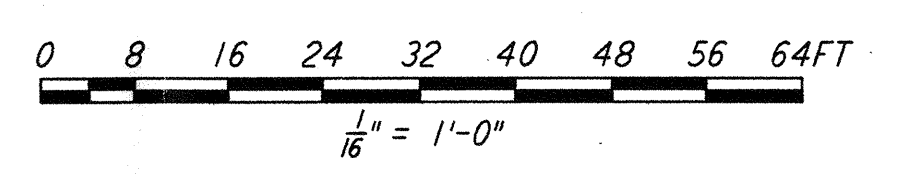

DATUM POINT EL +100.00 = 61.44' (LVEA)
 DATUM POINT EL +100.00 = 61.44' (OSB)

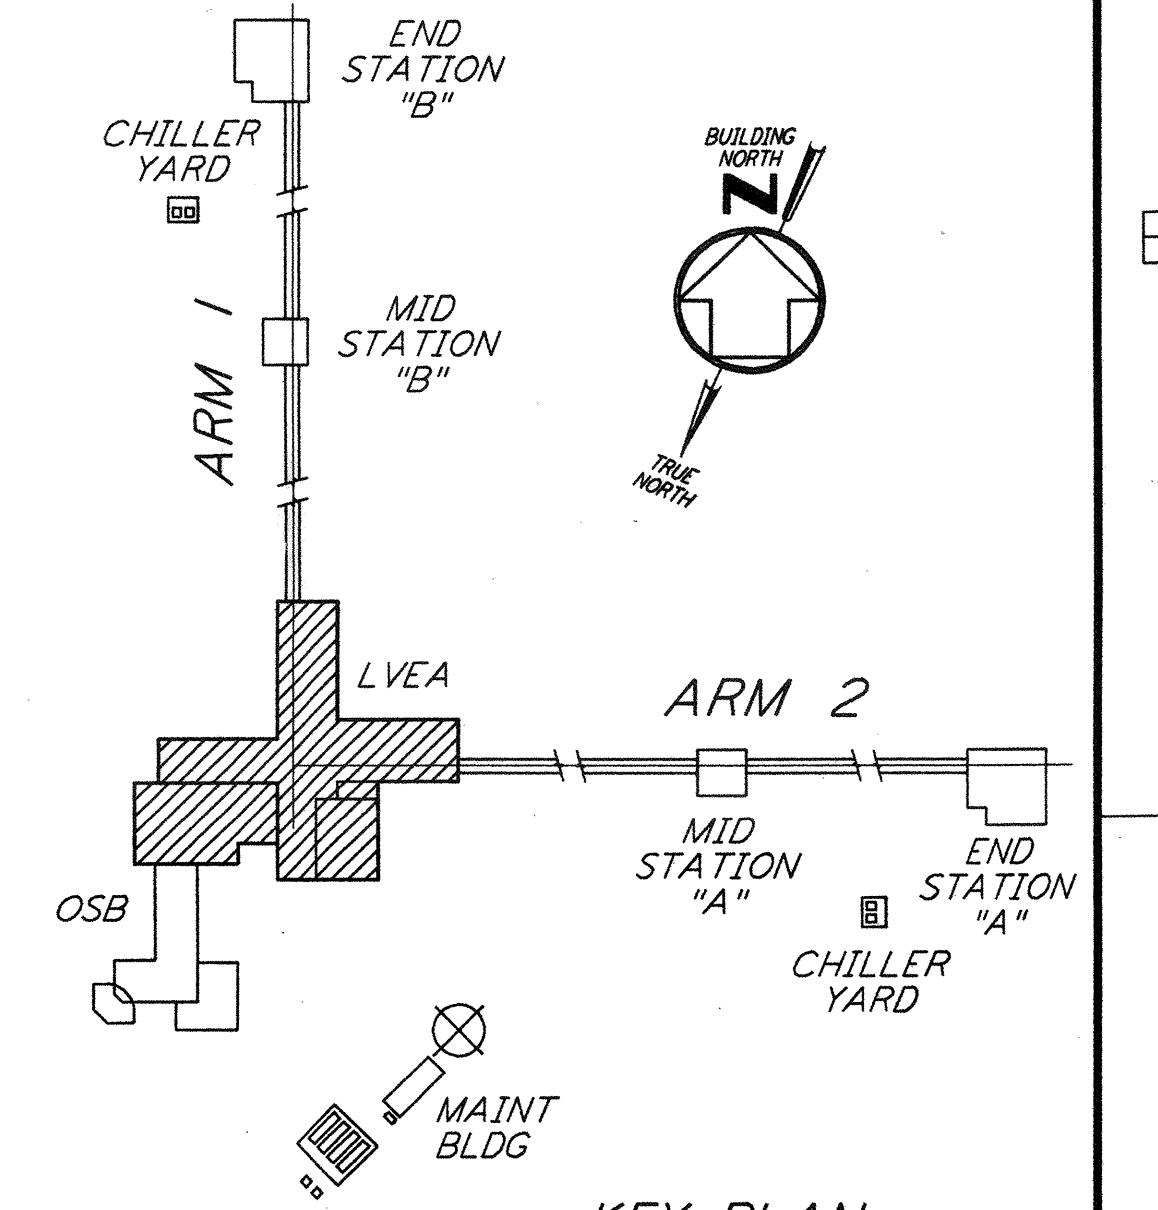

KEY PLAN

LIGO-D960881-01-0

NO.	DATE	BY	CHKD	ENGR	PROJ	DESCRIPTION
1	08-07-98	SJM	CKT	RED	MMW	ISSUED FOR AS-BUILT

ISSUED FOR CONSTRUCTION
DRAWN CKT 11-15-96
CHECKED TB 11-15-96
ENGINEER SF 11-15-96
PROJ TDM 11-15-96

AS-BUILT DRAWINGS

100 WEST WALNUT STREET
 PASADENA, CALIFORNIA

CALIFORNIA INSTITUTE OF TECHNOLOGY
 MASSACHUSETTS INSTITUTE OF TECHNOLOGY

LASER INTERFEROMETER
 GRAVITATIONAL-WAVE OBSERVATORY
 SITE NO. 2 - LIVINGSTON, LOUISIANA

TITLE	SCALE	CONTRACT NUMBER	PROJECT NUMBER							
ARCHITECTURAL CORNER STATION LVEA ROOF PLAN		PP150969	8094							
SHEET NUMBER	REVISIONS									
LA-A-131	<table border="1"> <tr> <td>NO.</td> <td>DATE</td> <td>BY</td> <td>CHKD</td> <td>ENGR</td> <td>PROJ</td> <td>DESCRIPTION</td> </tr> </table>			NO.	DATE	BY	CHKD	ENGR	PROJ	DESCRIPTION
NO.	DATE	BY	CHKD	ENGR	PROJ	DESCRIPTION				

This document and the design it covers are the property of PARSONS. They are loaned only with the borrower's expressed written agreement that they will not be reproduced, copied, loaned, exhibited, or used in any other way, except by written consent from PARSONS to the borrower.