



This document and the design it covers are the property of PARSONS. They are loaned only with the borrower's expressed written agreement that they will not be reproduced, copied, loaned, exhibited, or used in any other way, except by written consent from PARSONS to the borrower.

This document and the design it covers are the property of PARSONS. They are loaned only with the borrower's expressed written agreement that they will not be reproduced, copied, loaned, exhibited, or used in any other way, except by written consent from PARSONS to the borrower.

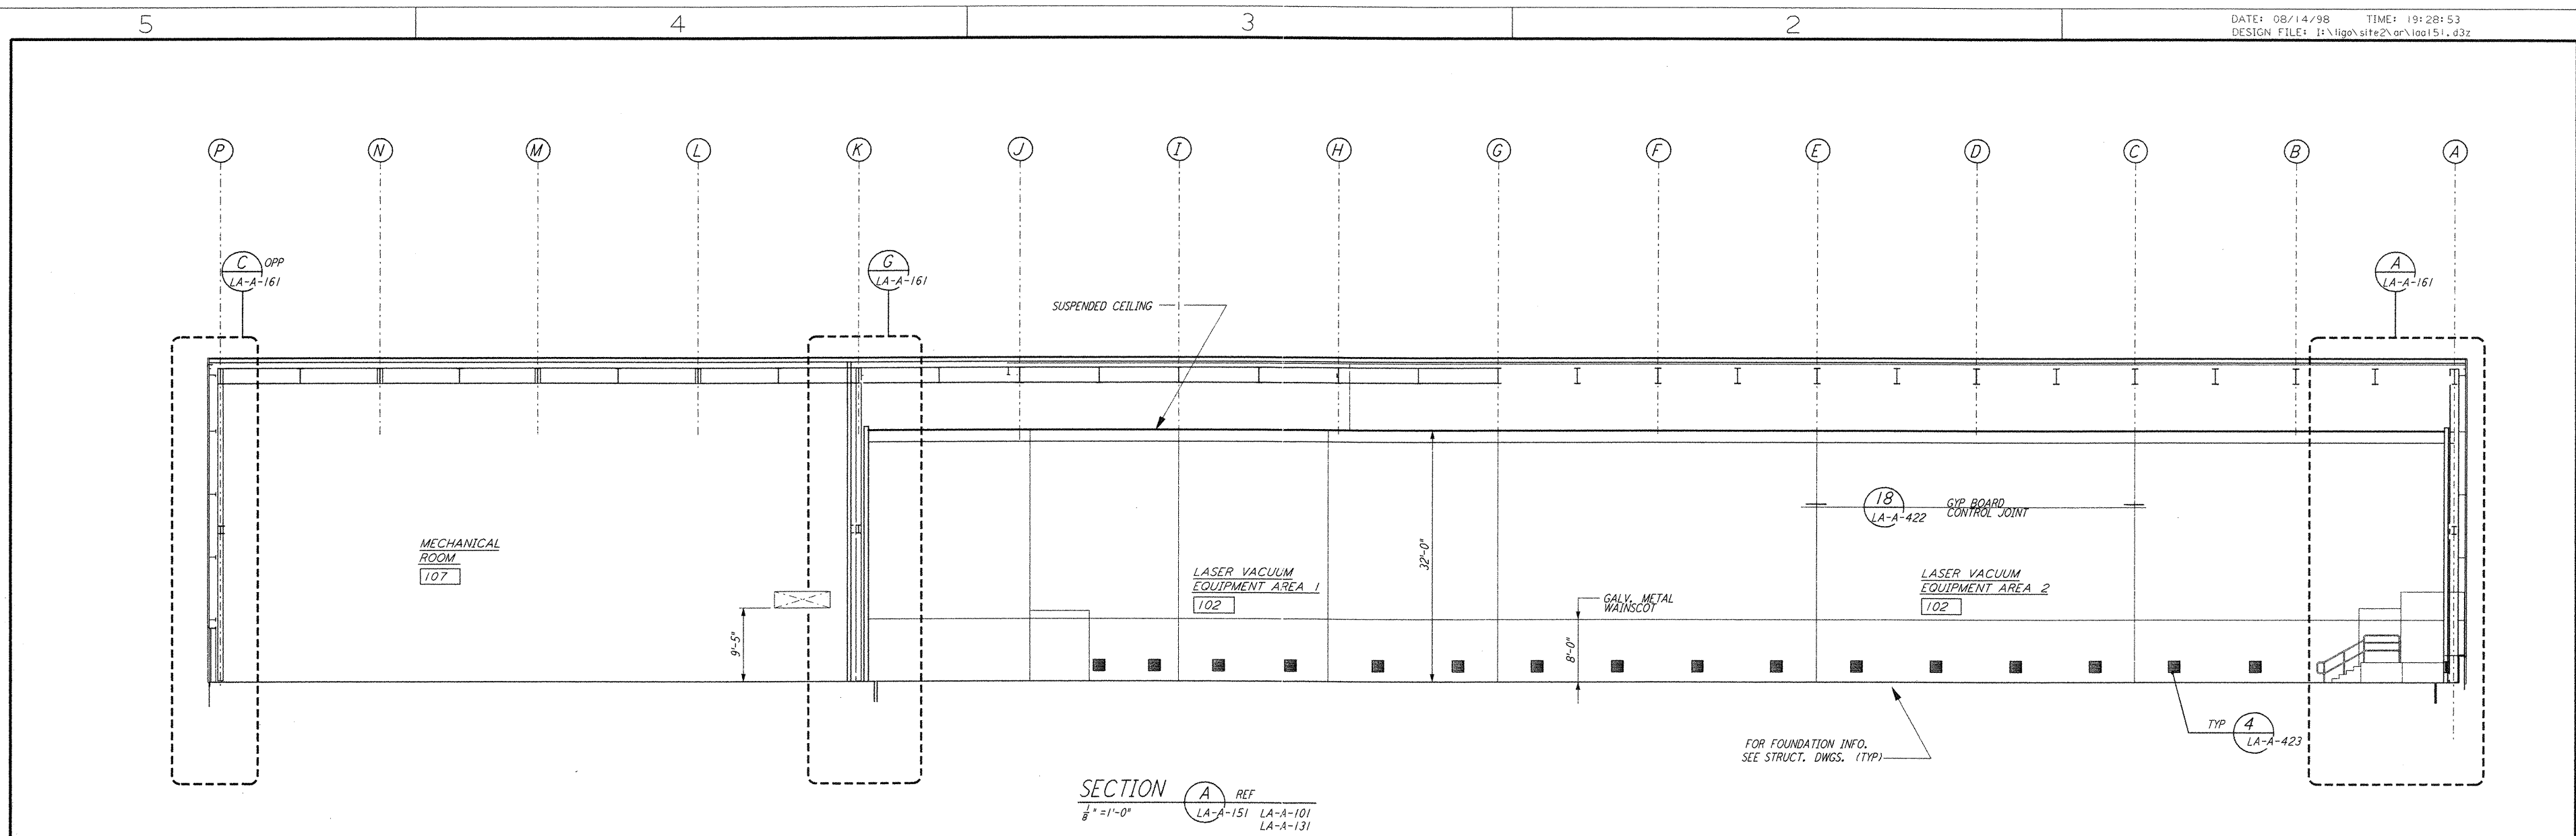


SECTION A REF
 LA-A-151 LA-A-101 LA-A-131
 1/8" = 1'-0"

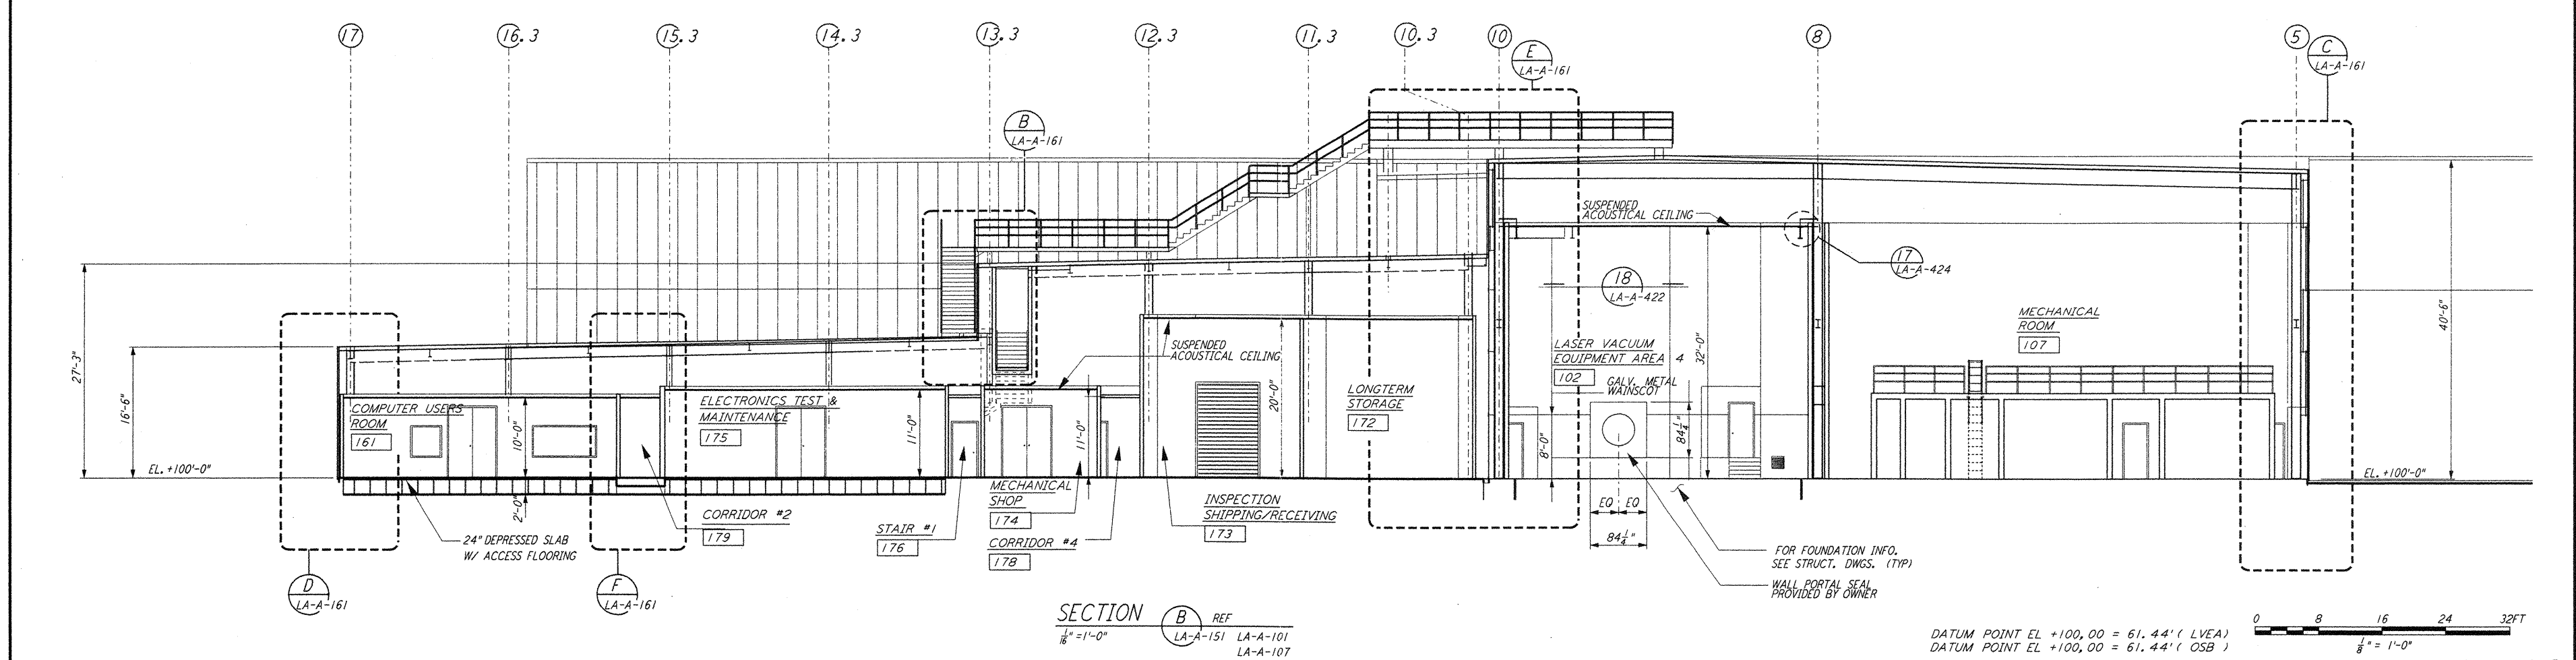

SECTION B REF
 LA-A-151 LA-A-101 LA-A-107
 1/8" = 1'-0"

DATUM POINT EL +100.00 = 61.44' (LVEA)
 DATUM POINT EL +100.00 = 61.44' (OSB)

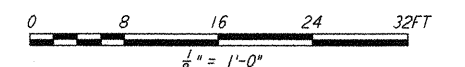

NO.	DATE	BY	CHKD	ENGR	PROJ	DESCRIPTION
2	08-07-98	SJM	CKT	AK	TOM	ISSUED FOR AS-BUILT
1	2-28-97	CKT	TB	AK	TOM	DELETE INTERIOR LADDER CAGE

ISSUED FOR CONSTRUCTION
 DRAWN CKT/ZDS 11-15-96
 CHECKED TB 11-15-96
 ENGINEER SF 11-15-96
 PROJ MDW 11-15-96

AS-BUILT DRAWINGS

PARSONS
 100 WEST WALNUT STREET
 PASADENA, CALIFORNIA

LIGO
 CALIFORNIA INSTITUTE OF TECHNOLOGY
 MASSACHUSETTS INSTITUTE OF TECHNOLOGY

LIGO-D960886-02-0

LASER INTERFEROMETER
 GRAVITATIONAL-WAVE OBSERVATORY
 SITE NO. 2 - LIVINGSTON, LOUISIANA

TITLE ARCHITECTURAL CORNER STATION LVEA & OSB SECTIONS SHEET 1

SCALE AS NOTED

CONTRACT NUMBER PP150969

PROJECT NUMBER 8094

SHEET NUMBER **LA-A-151**