



This document and the design it covers are the property of PARSONS. They are loaned only with the borrower's expressed written agreement that they will not be reproduced, copied, loaned, exhibited, or used in any other way, except by written consent from PARSONS to the borrower.

NO.	DATE	BY	CHKD	ENGR	PROJ	ISSUED FOR AS-BUILT	DESCRIPTION
1	08-07-98	SJM	CACT	LAM	WMM	ISSUED FOR AS-BUILT	

ISSUED FOR CONSTRUCTION		
DRAWN	SH/RR	11-15-96
CHECKED	TB	11-15-96
ENGINEER	SF	11-15-96
PROJ	TOM	11-15-96

AS-BUILT DRAWINGS

100 WEST WALNUT STREET
 PASADENA, CALIFORNIA

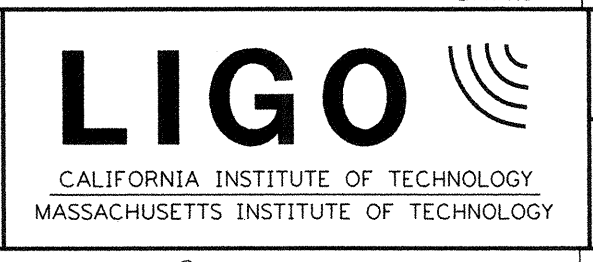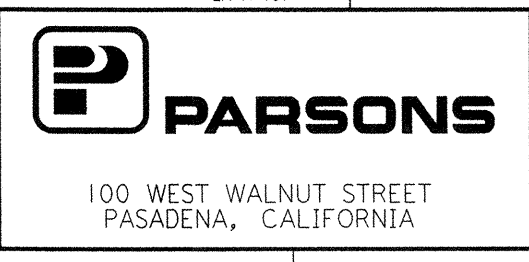

LIGO-D960898-01-0

LASER INTERFEROMETER
 GRAVITATIONAL-WAVE OBSERVATORY
 SITE NO. 2 - LIVINGSTON, LOUISIANA

SCALE: AS NOTED	CONTRACT NUMBER: PPI50969	PROJECT NUMBER: 8094
SHEET NUMBER: LA-A-421	REVISIONS:	

ARCHITECTURAL EXTERIOR WALL DETAILS

7-1 Aug 14 1998 4:55 1998 CA\PLOT\JOB\53-10882\JOB 532885 K:\V9823\ar\421a.rvt