


ABBREVIATIONS

AB	ANCHOR BOLT	MAX	MAXIMUM
ACI	AMERICAN CONCRETE INSTITUTE	MB	MACHINE BOLT
AISC	AMERICAN INSTITUTE OF STEEL CONSTRUCTION	MECH	MECHANICAL
APPROX	APPROXIMATE	MEZZ	MEZZANINE
ARCH	ARCHITECTURAL	MFR	MANUFACTURER
ASTM	AMERICAN SOCIETY FOR TESTING AND MATERIALS	MEN	MINIMUM
AWS	AMERICAN WELDING SOCIETY	MISC	MISCELLANEOUS
B/B	BACK TO BACK	MPH	MILES PER HOUR
B/P	BASE PLATE	NS	NEAR SIDE
BM	BEAM	NTS	NOT TO SCALE
BOF	BOTTOM OF FOOTING	OC	ON CENTER
BOS	BOTTOM OF STEEL	OD	OUTSIDE DIAMETER
BRCC	BRACING	OH	OPPOSITE HAND
C	CAMBER	OPNG	OPENING
CC OR C/C	CENTER TO CENTER	OPP	OPPOSITE
CJ	CENTER OF GRAVITY	OSB	OPERATIONS SUPPORT BUILDING
CLG	CONSTRUCTION JOINT	OTO	OUT TO OUT
CLM	CLEAR	PCF	POUNDS PER CUBIC FOOT
CMU	CONCRETE MASONRY UNIT	PL	PLATE
COL	COLUMN	PSF	POUNDS PER SQUARE FOOT
CONC	CONCRETE	PSI	POUNDS PER SQUARE INCH
CONT	CONTINUOUS	PT	POINT
CUBIC	CUBIC	R	RADIUS
DET	DETAIL	RD	ROOF DRAIN
DIAG	DIAGONAL	REF	REFERENCE
DIM	DIMENSION	REF	REINFORCING STEEL
DL	DEAD LOAD	REQD	REQUIRED
DO	DITCH	REV	REVISE OR REVISION
DWG	DRAWING	SCHED	SCHEDULE
DWL	DOWEL	SECT	SECTION
EA	EACH	SHT	SHEET
EF	EACH FACE	SIM	SIMILAR
EL	ELEVATION	SLV	SHORT LEG VERTICAL
ENCL	ENCLOSURE	SPA	SPACED
ENGR	ENGINEER	ST STL	STAINLESS STEEL
EQ	EQUAL	STD	STANDARD
EQUIP	EQUIPMENT	STIF	STIFFENER
ETC	ETCETERA	SYM	SYMMETRICAL
EW	EACH WAY	T&B	TOP AND BOTTOM
EXIST	EXISTING	THK	THICKNESS
FD	FLOOR DRAIN	THC	TOP OF CONCRETE
FDN	FOUNDATION	TOC	TOP OF FOOTING
FIN	FINISH	TOS	TOP OF STEEL
FLR	FLOOR	TOW	TOP OF WALL
FLSHG	FLASHING	TYP	TYPICAL
FOC	FACE OF CONCRETE	UON	UNLESS OTHERWISE NOTED
FRMG	FRAMING	VERT	VERTICAL
FS	FACE SIDE	W/	WITH
FT	FOOT, FEET	WPF	WATER PROOF
FTG	FOOTING	WP	WORKING POINT
GA	GAUGE	WS	WEIGHT
GALV	GALVANIZED	WT	WEIGHT
GR	GRADE	WWF	WELDED WIRE FABRIC
HORIZ	HORIZONTAL	WWW	WELDED WIRE MESH
HP	HIGH POINT		
HR	HANDRAIL		
HSB	HIGH STRENGTH BOLT		
ID	INSIDE DIAMETER		
IN	INCH		
INFO	INFORMATION		
INSUL	INSULATION		
JST	JOIST		
JT	JOINT		
LB	POUND		
LC	LENGTH		
LL	LIVE LOAD		
LLH	LONG LEG HORIZONTAL		
LLV	LONG LEG VERTICAL		
LVA	LASER AND VACUUM EQUIPMENT AREA		
LWC	LIGHT WEIGHT CONCRETE		

SYMBOLS

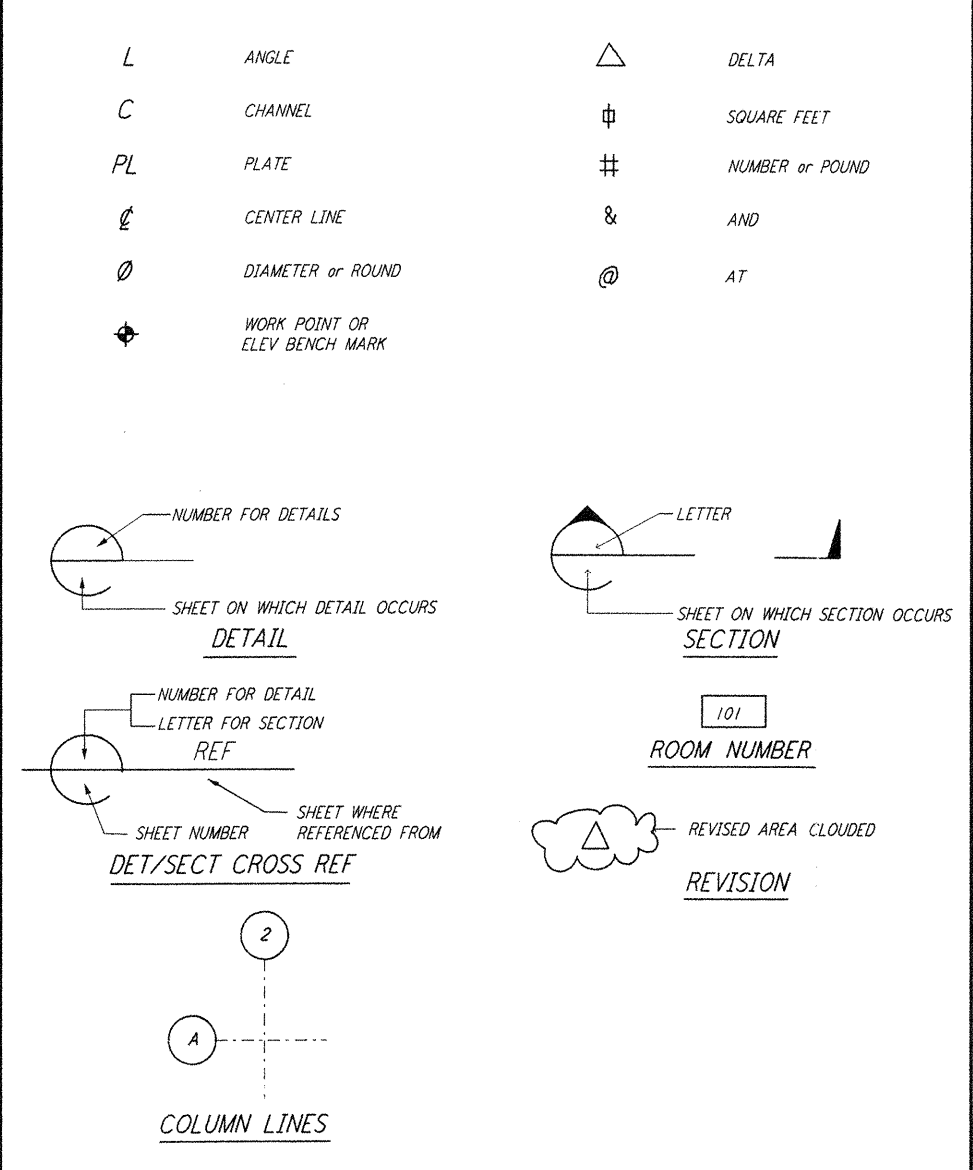

NOTES


INSPECTIONS AND APPROVALS

- GENERAL**
- PROFESSIONAL SOILS ENGINEER REGISTERED IN THE STATE OF WASHINGTON SHALL INSPECT AND APPROVE ALL FOOTING EXCAVATIONS PRIOR TO PLACING CONCRETE ACCORDING TO SECTION 2200 OF THE SPECIFICATION.
 - CONTINUOUS INSPECTION BY AN INSPECTOR, APPROVED BY THE DEPARTMENT OF BUILDING AND SAFETY SHALL BE PROVIDED FOR THE FOLLOWING FIELD WORK:
 - A) PLACEMENT OF COMPACTED FILL.
 - B) PLACEMENT OF CONCRETE AND REINFORCING STEEL AND ANCHOR BOLTS.
 - C) EXPANSION TYPE CONCRETE ANCHORS.
 - D) FIELD WELDING.
 - E) INSTALLATION OF HIGH STRENGTH BOLTS.
 - FIELD WELDERS AND WELDING OPERATORS SHALL BE FULLY QUALIFIED IN ACCORDANCE WITH AWS D1.1 AND BE APPROVED BY THE DEPARTMENT OF BUILDING AND SAFETY.
 - THE CONSTRUCTION SHALL COMPLY WITH REQUIREMENTS OF THE BUILDING CODE.
- GENERAL**
- ALL STRUCTURAL WORK AND MATERIALS SHALL CONFORM TO THE REQUIREMENTS OF THE JOB SPECIFICATIONS AND STANDARDS.
 - ALL SHOP DRAWINGS SHALL BE REVIEWED AND APPROVED BY THE ENGINEER OF RECORD PRIOR TO FABRICATION.
 - NO HOLES OTHER THAN THOSE SPECIFICALLY DETAILED, SHALL BE ALLOWED THROUGH STRUCTURAL STEEL MEMBERS. NO CUTTING OR BURNING OF STEEL SHALL BE PERMITTED WITHOUT APPROVAL OF THE ENGINEER OF RECORD.
 - PAINTING AND SHOP PRIMING WHERE REQUIRE SHALL BE IN ACCORDANCE WITH THE SPECIFICATIONS.
 - FOR TYPICAL DETAILS SEE DRAWINGS LA-S-002 THROUGH LA-S-009.
 - CONTRACTOR SHALL PROVIDE TEMPORARY BRACING AND SHORING AS REQUIRED TO MAINTAIN THE ALIGNMENT OF BUILDING AND RETAINING WALLS UNTIL ALL CONNECTIONS ARE COMPLETED AND SLAB AND WALLS CONSTRUCTED.
 - PRIOR TO PLACING FOUNDATIONS & SLABS, REFER TO UNDERDRAIN SYSTEM DRAWINGS, ARCHITECTURAL DWGS FOR SLOPES & ELECTRICAL DWGS FOR GROUNDING.
 - FOR BUILDING COLUMN LOCATION COORDINATES SEE CIVIL DWGS.
 - USE 100 LBS/FT FOR LIVE LOAD OF STAIR AND ROOF PLATFORM.

NOTES

- FOUNDATIONS**
- FOUNDATION AND SOIL REQUIREMENTS ARE BASED ON SOIL REPORT BY DAMES AND MOORE, REPORT NO. 177-004-0016 DATED: FEBRUARY 10, 1993.
- CONCRETE**
- ALL CONCRETE MATERIALS AND CONSTRUCTION SHALL CONFORM TO THE REQUIREMENTS OF DIVISION 3 (CONCRETE) OF THE SPECIFICATIONS. (REGULAR WEIGHT AND LIGHT WEIGHT)
 - STRUCTURAL CONCRETE SHALL HAVE AN ULTIMATE COMPRESSIVE STRENGTH OF 4000 PSI AT 28 DAYS UNLESS OTHERWISE NOTED. ALL CONCRETE SHALL BE REGULAR WEIGHT CONCRETE UNLESS OTHERWISE NOTED.
 - ALL REINFORCING STEEL SHALL BE DEFORMED BARS CONFORMING TO ASTM A615 GRADE 60 (UNLESS OTHERWISE NOTED). SPLICES AND HOOKS SHALL CONFORM TO ACI 318-89. SPLICES SHALL BE CLASS B UNLESS OTHERWISE NOTED. MINIMUM LAP SHALL BE 30 DIAMETERS. STIRRUP AND TIE HOOKS SHALL HAVE 135-DEGREE BLENDS.
 - LOCATION OF ALL CONSTRUCTION JOINTS OR OTHER TYPES OF JOINTS, OTHER THAN SPECIFIED, SHALL BE APPROVED BY THE CONSTRUCTION MANAGER BEFORE PLACING.
 - MINIMUM CONCRETE COVER PROVIDED FOR REINFORCEMENT SHALL BE IN ACCORDANCE WITH THE SPECIFICATION.
 - ALL REINFORCING STEEL, ANCHOR BOLTS, DOWELS AND OTHER INSERTS SHALL BE WELL SECURED IN POSITION AND INSPECTED BY QUALIFIED INSPECTOR PRIOR TO PLACING CONCRETE.
 - EXISTING PAVEMENT SHALL BE SAW CUT AND BROKEN OUT TO CLEAN, STRAIGHT EDGES OF DEMOLITION AREAS.
 - EXPOSED EDGES OF CONCRETE SHALL HAVE A 3/4" CHAMFER UNLESS OTHERWISE NOTED ON DRAWINGS.
 - EXCAVATING AND BACKFILLING SHALL BE IN ACCORDANCE WITH THE SPECIFICATIONS.
 - PROVIDE REINFORCEMENT IN WALLS AT CORNER AND INTERSECTIONS AS PER DETAIL (1) LA-S-002
- STRUCTURAL STEEL**
- THE DESIGN, FABRICATION AND ERECTION OF ALL STRUCTURAL STEEL SHALL CONFORM TO AISC "MANUAL OF STEEL CONSTRUCTION" AND WITH THE SPECIFICATIONS. STRUCTURAL STEEL SHAPES & PLATES SHALL CONFORM TO ASTM A36 UNLESS OTHERWISE NOTED ON PLAN.
 - PROVIDE FILLERS AT SPLICES OF PARTS HAVING MORE THAN 1/8" DIFFERENCE IN THICKNESS.
 - ALL BEARING STIFFENER PLATES SHALL HAVE A CLOSE BEARING AGAINST THE INNER SURFACES OF BOTH FLANGES.
- CONNECTIONS**
- PLATE FOR BOLTED SHEAR PLATE CONNECTIONS SHALL BE THE SAME THICKNESS AS THE BEAM WEB WITH A MINIMUM THICKNESS OF 3/8" UNLESS OTHERWISE NOTED. DIAGONAL GUSSET PLATE CONNECTIONS SHALL HAVE A MINIMUM THICKNESS OF 3/8" (UNLESS OTHERWISE NOTED) AND THE NET AREA THROUGH THE BOLTS SHALL DEVELOP TOTAL SHEAR CAPACITY OF THE BOLTS. ALL CONNECTIONS SHALL HAVE A MINIMUM OF TWO BOLTS. LOAD INDICATOR WASHERS SHALL BE USED WITH ALL ASTM A325SC BOLTS.
 - ALL BOLTS SHALL BE ASTM A325SC, CLASS A, UNLESS OTHERWISE NOTED. 3/4" BOLTS SHALL BE USED FOR MID & END STATION, OSB BUILDING AND MAINTENANCE BUILDING AND 3/8" BOLTS SHALL BE USED FOR CORNER AREA BUILDING, UNLESS OTHERWISE NOTED.
 - ALL STIFFENERS SHALL HAVE A MINIMUM THICKNESS OF 3/8", UNLESS OTHERWISE NOTED.
 - GIRT CONNECTIONS SHALL HAVE A MINIMUM OF 2-3/8" Ø ASTM A307 BOLTS.
 - ALL CONNECTIONS REQUIRE SLIP CRITICAL CONNECTION BOLTS EXCEPT GIRT CONNECTIONS.
 - SPLICE CONNECTION FOR CRANE GIRDERS MAY BE AT ANY CONVENIENT LOCATION.
- WELDING**
- ALL WELDING SHALL CONFORM TO THE REQUIREMENTS OF AWS D1.1-90 STRUCTURAL WELDING CODE AND THE SPECIFICATION.
 - ALL WELDING PROCEDURE SPECIFICATIONS AND WELDING PROCEDURE QUALIFICATIONS, WELDERS, AND WELDING OPERATORS SHALL BE FULLY QUALIFIED IN ACCORDANCE WITH AWS D1.1-90.
 - LENGTHS OF WELDS SHOWN ARE EFFECTIVE LENGTHS AS SPECIFIED IN AISC SPECIFICATIONS. WHERE LENGTH OF WELD IS NOT SHOWN, IT SHALL BE FULL LENGTH OF JOINT. ALL BUTT WELDS SHALL BE FULL PENETRATION WELDS, UNLESS OTHERWISE NOTED.
 - ALL WELDING ELECTRODES SHALL BE E70XX.
 - WITH REFERENCE TO MINIMUM SIZE OF FILLET WELD REQUIREMENTS IN SECTION 1.17 OF AISC SPECIFICATIONS, MINIMUM SIZE OF FILLET WELDS WHEN NOT SPECIFIED ON WELD SYMBOLS SHALL BE AS FOLLOWS:
 - 1/4" WELD FOR MATERIAL THICKNESS UP TO AND INCLUDING 3/8"
 - 3/8" WELD FOR MATERIAL THICKNESS OVER 3/8" TO 1 1/2"
 - WELDING PROCEDURES AND SEQUENCES SHALL BE PLANNED TO MINIMIZE WELD SHRINKAGE THAT COULD RESULT IN LAMELLAR TEARING, AND APPROVED BY OWNERS REPRESENTATIVE.
 - GRIND SMOOTH WELDED JOINTS WHERE FLUSH SURFACE IS REQUIRED.
- METAL DECK**
- ALL METAL DECKING SHALL BE IN ACCORDANCE WITH SECTION 5312 OF THE SPECIFICATIONS.
 - ROOF DECK SHALL HAVE SINGLE RIBS 3" DEEP AND MADE OUT OF 20 GAGE STEEL WITH MINIMUM I=0.837 IN⁴/FOOT OF WIDTH AND MINIMUM S(+)=0.508 IN 3/FOOT WIDTH AND S(-)=0.562 IN 3/FOOT WIDTH. ATTACHMENT OF ROOF DECK TO SUPPORTS SHALL BE PER MANUFACTURERS RECOMMENDATIONS. THE ATTACHMENT SHALL BE CAPABLE OF RESISTING 80 PSF NET UPLIFT AND 300 POUNDS PER LINEAR FOOT OF SHEAR.
 - ACOUSTICAL ROOF DECK OF SAME SECTION PROPERTIES AS INDICATED IN ITEM 2 ABOVE SHALL BE USED FOR THE ROOF OVER MULTIPURPOSE ROOM OF THE OSB BLDG AS INDICATED ON THE DWG.
 - ROOF DECK SHALL HAVE A MINIMUM OF TWO (2) SPANS UNLESS OTHERWISE NOTED.

MATERIALS LEGEND

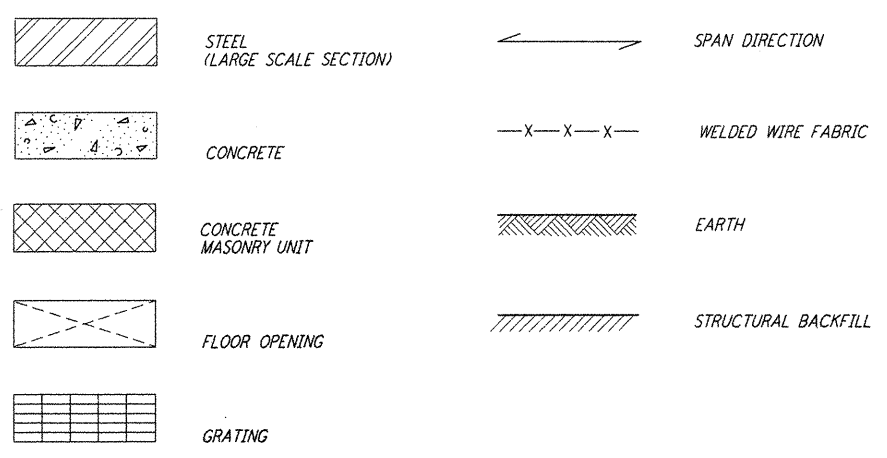

LIGO-D960907-01-O

LASER INTERFEROMETER
 GRAVITATIONAL-WAVE OBSERVATORY
 SITE NO. 2 - LIVINGSTON, LOUISIANA

TITLE	SCALE	CONTRACT NUMBER	PROJECT NUMBER
STRUCTURAL GENERAL NOTES, ABBREVIATIONS & LEGEND	NONE	PP150969	8094
DRAWING NO.	DESCRIPTION	NO.	DATE
LA-S-001		1	08-07-98
		BY	WA
		CHKD	ENGR
		PROJ	ISSUED FOR AS-BUILT

PARSONS

LIGO

CALIFORNIA INSTITUTE OF TECHNOLOGY
 MASSACHUSETTS INSTITUTE OF TECHNOLOGY

100 WEST WALNUT STREET
 PASADENA, CALIFORNIA

ISSUED FOR CONSTRUCTION

DRAWN	MCS	11-15-96
CHECKED	DDM	11-15-96
ENGINEER	BP	11-15-96
PROJ	TDM	11-15-96

AS-BUILT DRAWINGS

This document and the design it covers are the property of PARSONS. They are loaned only with the borrower's expressed written agreement that they will not be reproduced, copied, loaned, exhibited, or used in any other way, except by written consent from PARSONS to the borrower.

The Aug 13 10:30:24 1998 C:\PLOT\QUE\35-V\986206F 52085 K1V3862A\A001.dwg