


This document and the design it covers are the property of PARSONS. They are loaned only with the borrower's expressed written agreement that they will not be reproduced, copied, loaned, exhibited, or used in any other way, except by written consent from PARSONS to the borrower.

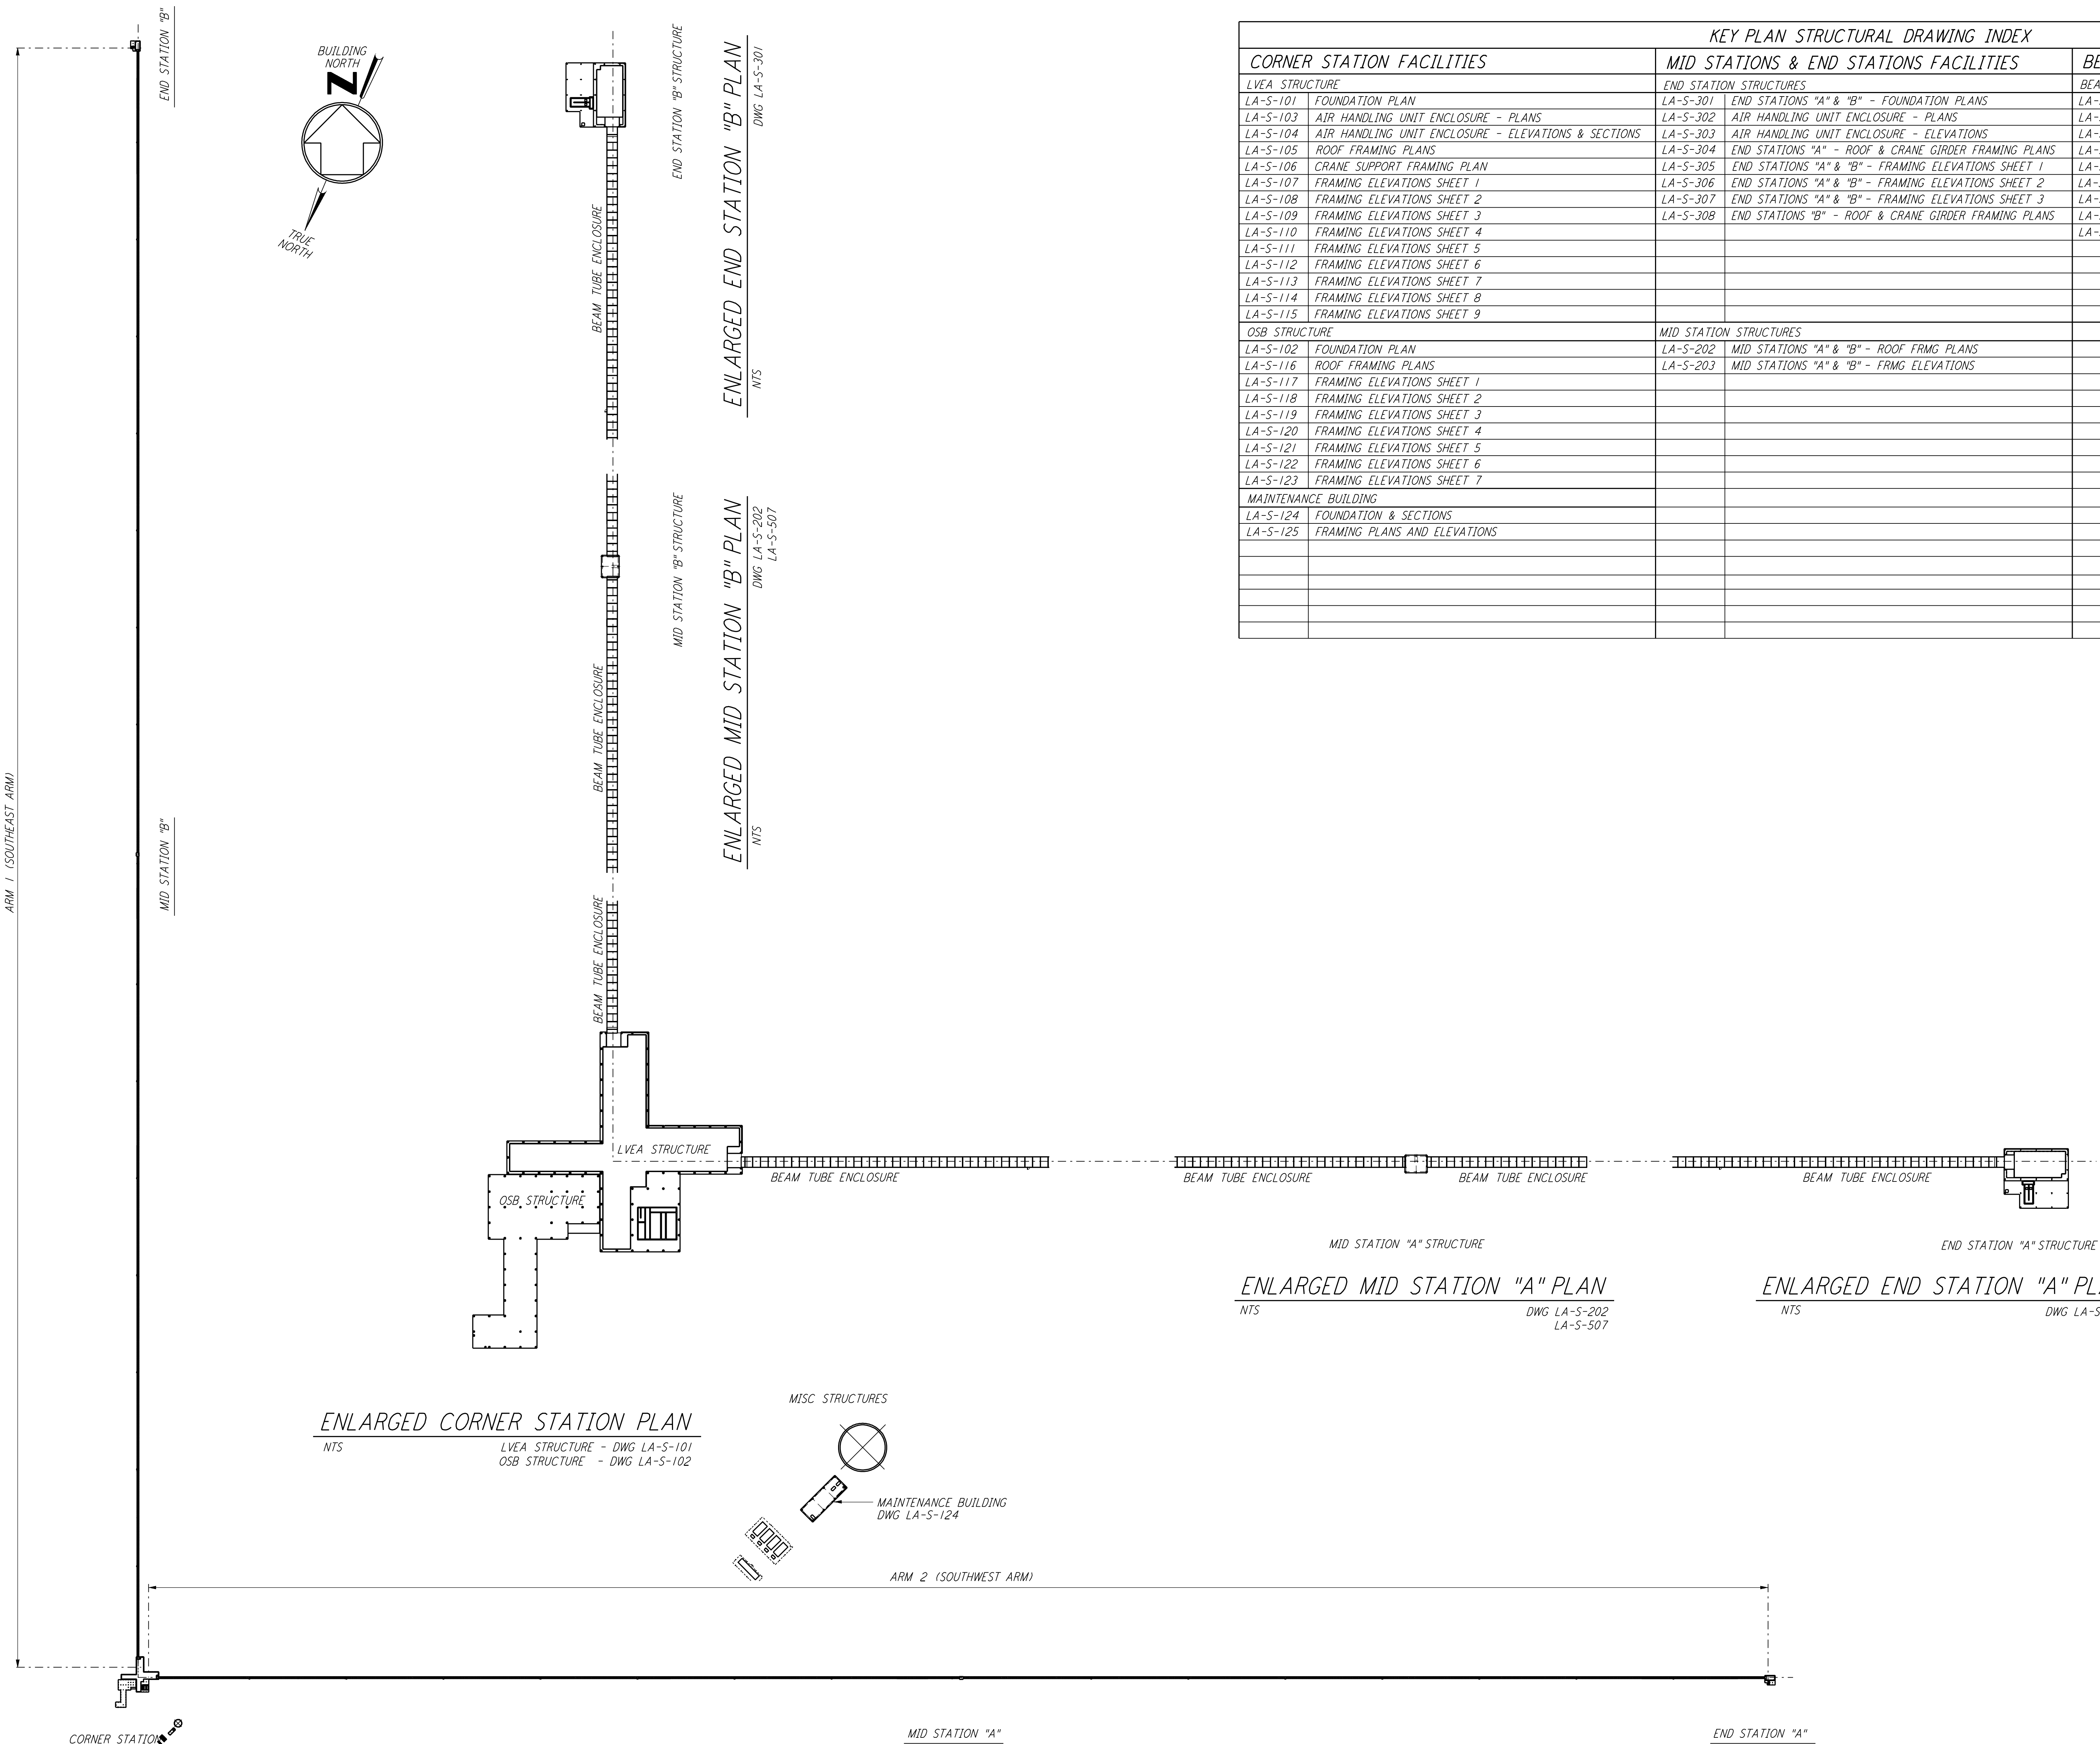

KEY PLAN STRUCTURAL DRAWING INDEX		
CORNER STATION FACILITIES	MID STATIONS & END STATIONS FACILITIES	BEAM TUBE ENCLOSURE
<b>LVEA STRUCTURE</b>	<b>END STATION STRUCTURES</b>	<b>BEAM TUBE ENCLOSURE STRUCTURE</b>
LA-S-101 FOUNDATION PLAN	LA-S-301 END STATIONS "A" & "B" - FOUNDATION PLANS	LA-S-501 GENERAL NOTES, ABBREVIATIONS & LEGEND
LA-S-103 AIR HANDLING UNIT ENCLOSURE - PLANS	LA-S-302 AIR HANDLING UNIT ENCLOSURE - PLANS	LA-S-502 KEY PLAN & PARTIAL ENLARGED PLANS
LA-S-104 AIR HANDLING UNIT ENCLOSURE - ELEVATIONS & SECTIONS	LA-S-303 AIR HANDLING UNIT ENCLOSURE - ELEVATIONS	LA-S-502A PARTIAL ENLARGED PLANS
LA-S-105 ROOF FRAMING PLANS	LA-S-304 END STATIONS "A" - ROOF & CRANE GIRDER FRAMING PLANS	LA-S-503 PLANS, SECTIONS & DETAILS
LA-S-106 CRANE SUPPORT FRAMING PLAN	LA-S-305 END STATIONS "A" & "B" - FRAMING ELEVATIONS SHEET 1	LA-S-504 FOUNDATION KEY PLAN & PARTIAL ENLARGED PLANS
LA-S-107 FRAMING ELEVATIONS SHEET 1	LA-S-306 END STATIONS "A" & "B" - FRAMING ELEVATIONS SHEET 2	LA-S-505 SECTIONS & DETAILS SHEET 1
LA-S-108 FRAMING ELEVATIONS SHEET 2	LA-S-307 END STATIONS "A" & "B" - FRAMING ELEVATIONS SHEET 3	LA-S-506 SECTIONS & DETAILS SHEET 2
LA-S-109 FRAMING ELEVATIONS SHEET 3	LA-S-308 END STATIONS "B" - ROOF & CRANE GIRDER FRAMING PLANS	LA-S-507 MID STATIONS "A" & "B" - FOUNDATION PLANS
LA-S-110 FRAMING ELEVATIONS SHEET 4		LA-S-508 CONCRETE SLAB & JOINT DETAILS
LA-S-111 FRAMING ELEVATIONS SHEET 5		
LA-S-112 FRAMING ELEVATIONS SHEET 6		
LA-S-113 FRAMING ELEVATIONS SHEET 7		
LA-S-114 FRAMING ELEVATIONS SHEET 8		
LA-S-115 FRAMING ELEVATIONS SHEET 9		
<b>OSB STRUCTURE</b>	<b>MID STATION STRUCTURES</b>	
LA-S-102 FOUNDATION PLAN	LA-S-202 MID STATIONS "A" & "B" - ROOF FRMG PLANS	
LA-S-116 ROOF FRAMING PLANS	LA-S-203 MID STATIONS "A" & "B" - FRMG ELEVATIONS	
LA-S-117 FRAMING ELEVATIONS SHEET 1		
LA-S-118 FRAMING ELEVATIONS SHEET 2		
LA-S-119 FRAMING ELEVATIONS SHEET 3		
LA-S-120 FRAMING ELEVATIONS SHEET 4		
LA-S-121 FRAMING ELEVATIONS SHEET 5		
LA-S-122 FRAMING ELEVATIONS SHEET 6		
LA-S-123 FRAMING ELEVATIONS SHEET 7		
<b>MAINTENANCE BUILDING</b>		
LA-S-124 FOUNDATION & SECTIONS		
LA-S-125 FRAMING PLANS AND ELEVATIONS		

**ENLARGED CORNER STATION PLAN**  
 NTS  
 LVEA STRUCTURE - DWG LA-S-101  
 OSB STRUCTURE - DWG LA-S-102

**ENLARGED MID STATION "A" PLAN**  
 NTS  
 DWG LA-S-202  
 LA-S-507

**ENLARGED END STATION "A" PLAN**  
 NTS  
 DWG LA-S-301

REFERENCES	REVISIONS	ISSUED FOR CONSTRUCTION						
		DRAWN MCS 11-15-96						
		CHECKED DDM 11-15-96						
		ENGINEER BP 11-15-96						
		PROJ TDM 11-15-96						
		<b>AS-BUILT DRAWINGS</b>						
		<b>ISSUED FOR AS-BUILT</b>						
DRAWING NO.	DESCRIPTION	NO.	DATE	BY	CHKD	ENGR	PROJ	DESCRIPTION
		1	08-07-98	WA				ISSUED FOR AS-BUILT

ARM 1 (SOUTHEAST ARM)  
 ARM 2 (SOUTHWEST ARM)  
 CORNER STATION  
 MID STATION "A"  
 END STATION "A"

**PARSONS**  
 100 WEST WALNUT STREET  
 PASADENA, CALIFORNIA

**LIGO**  
 CALIFORNIA INSTITUTE OF TECHNOLOGY  
 MASSACHUSETTS INSTITUTE OF TECHNOLOGY

**LIGO-D960916-01-0**

LASER INTERFEROMETER  
 GRAVITATIONAL-WAVE OBSERVATORY  
 SITE NO. 2 - LIVINGSTON, LOUISIANA

TITLE	SCALE	CONTRACT NUMBER	PROJECT NUMBER
STRUCTURAL KEY PLAN	NONE	PP150969	8094
	SHEET NUMBER		REVISIONS
	<b>LA-S-010</b>		

Wed Oct 7 15:21:50 1998 c:\lola\laser\stf\los010.dwg