


This document and the design it covers are the property of PARSONS. They are loaned only with the borrower's expressed written agreement that they will not be reproduced, copied, loaned, exhibited, or used in any other way, except by written consent from PARSONS to the borrower.

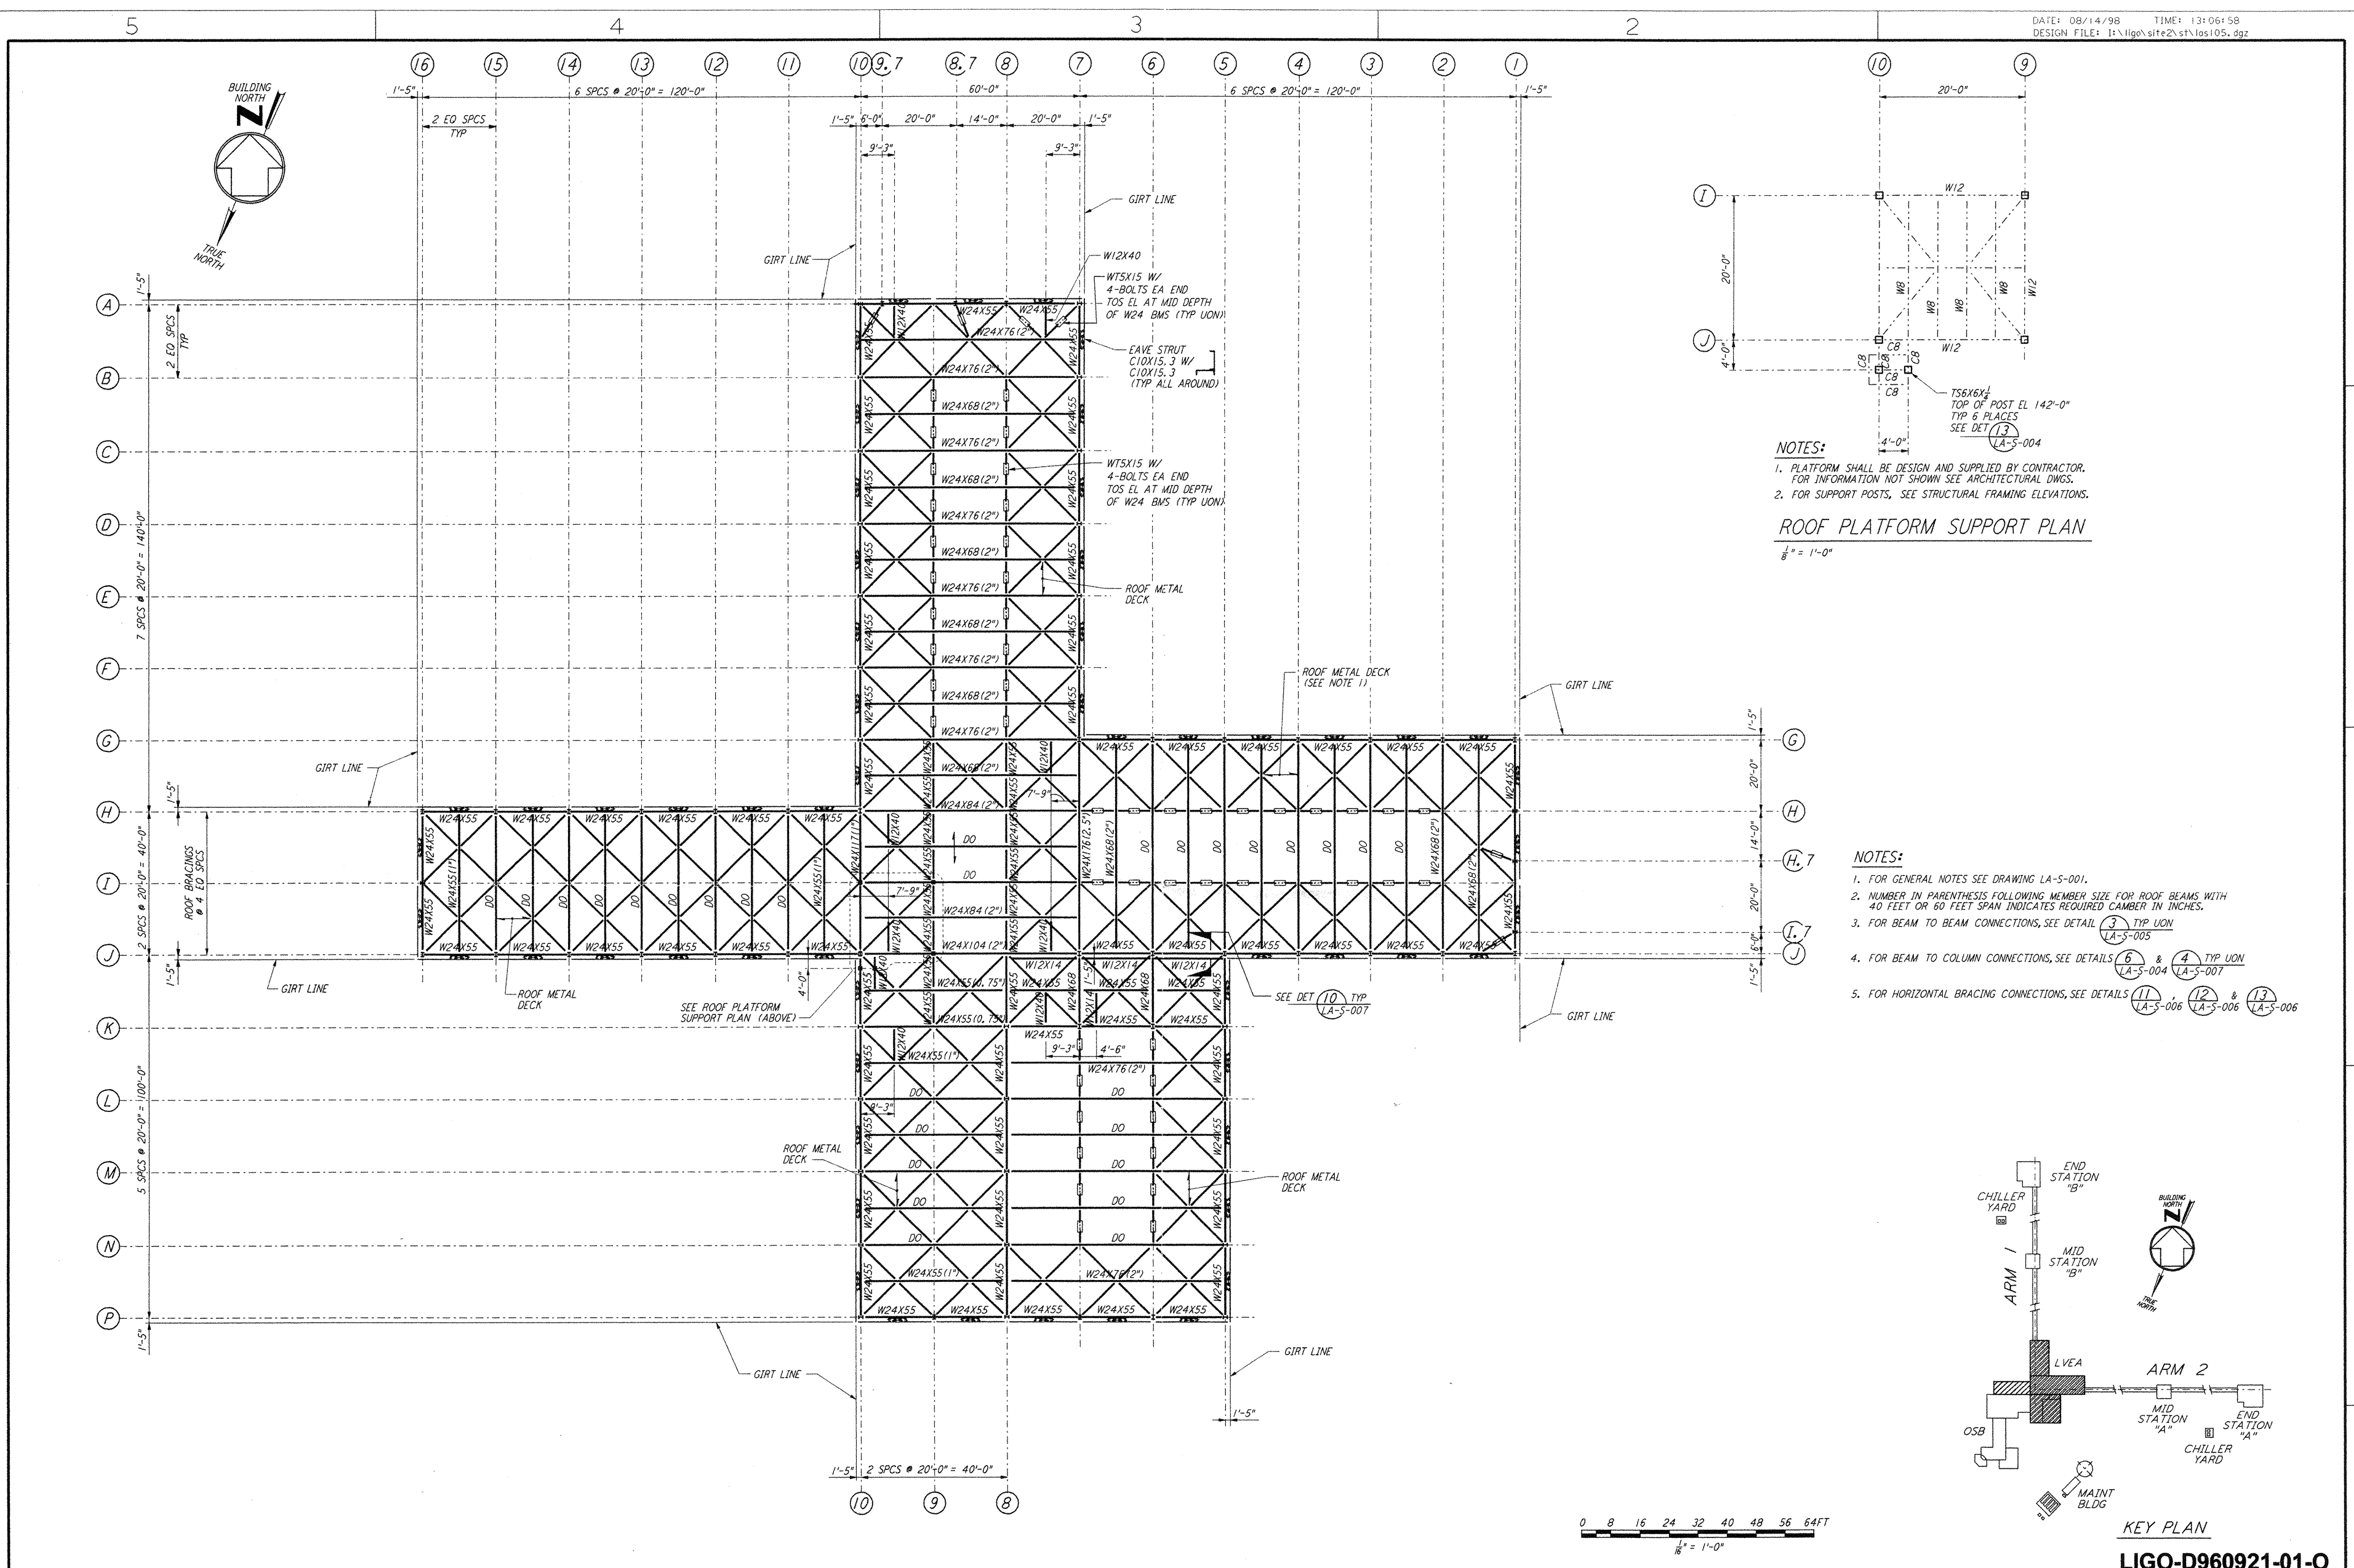

NOTES:
 1. PLATFORM SHALL BE DESIGN AND SUPPLIED BY CONTRACTOR. FOR INFORMATION NOT SHOWN SEE ARCHITECTURAL DWGS.
 2. FOR SUPPORT POSTS, SEE STRUCTURAL FRAMING ELEVATIONS.
ROOF PLATFORM SUPPORT PLAN
 1/8" = 1'-0"

NOTES:
 1. FOR GENERAL NOTES SEE DRAWING LA-S-001.
 2. NUMBER IN PARENTHESIS FOLLOWING MEMBER SIZE FOR ROOF BEAMS WITH 40 FEET OR 60 FEET SPAN INDICATES REQUIRED CAMBER IN INCHES.
 3. FOR BEAM TO BEAM CONNECTIONS, SEE DETAIL (3) TYP UON LA-S-005
 4. FOR BEAM TO COLUMN CONNECTIONS, SEE DETAILS (6) & (4) TYP UON LA-S-004 & LA-S-007
 5. FOR HORIZONTAL BRACING CONNECTIONS, SEE DETAILS (11) & (12) & (13) TYP UON LA-S-006 & LA-S-006 & LA-S-006

NO.	DATE	BY	CHKD	ENGR	PROJ	DESCRIPTION
1	08-07-98	WA	SPH	SPH	WVV	ISSUED FOR AS-BUILT

ISSUED FOR CONSTRUCTION	DRAWN	MCS	11-15-96
CHECKED	DDM	11-15-96	
ENGINEER	BP	11-15-96	
PROJ	TDM	11-15-96	

AS-BUILT DRAWINGS

PARSONS
 100 WEST WALNUT STREET
 PASADENA, CALIFORNIA

LIGO
 CALIFORNIA INSTITUTE OF TECHNOLOGY
 MASSACHUSETTS INSTITUTE OF TECHNOLOGY

LIGO-D960921-01-0
 LASER INTERFEROMETER
 GRAVITATIONAL-WAVE OBSERVATORY
 SITE NO. 2 - LIVINGSTON, LOUISIANA

TITLE	SCALE	CONTRACT NUMBER	PROJECT NUMBER
STRUCTURAL CORNER STATION LVEA ROOF FRAMING PLAN	AS NOTED	PP150969	8094
SHEET NUMBER		REVISIONS	
LA-S-105			