



not be reproduced, copied, loaned, exhibited, or used in any other way, except by written consent from PARSONS to the borrower.

This document and the design it covers are the property of PARSONS. They are loaned only with the borrower's expressed written agreement that they will

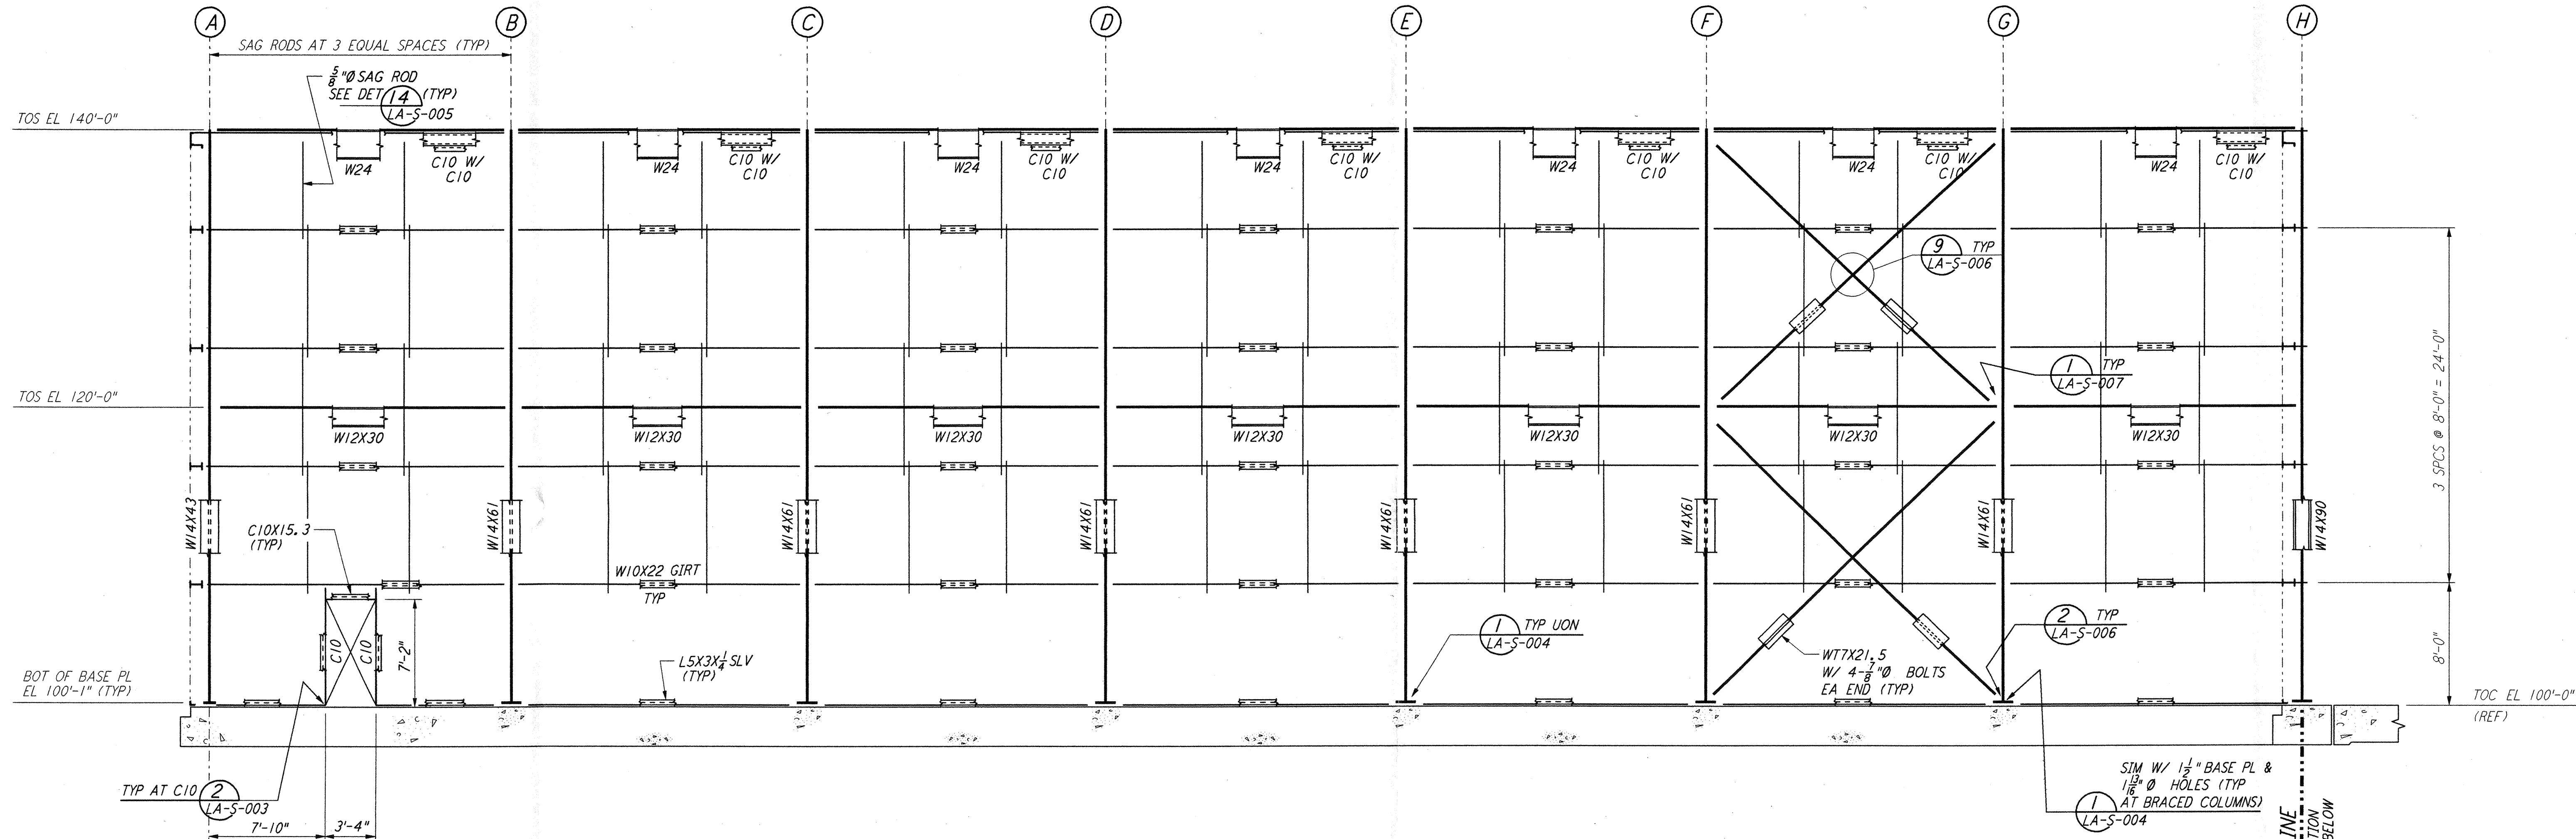


PARTIAL ELEVATION AT COLUMN LINE 10  
 $\frac{3}{16}'' = 1'-0''$

CONTRACTOR SHALL DESIGN, FABRICATE AND INSTALL PLATFORM INCLUDING HANDRAILS & FLOORING AS PER ARCHITECTURAL LAYOUT.

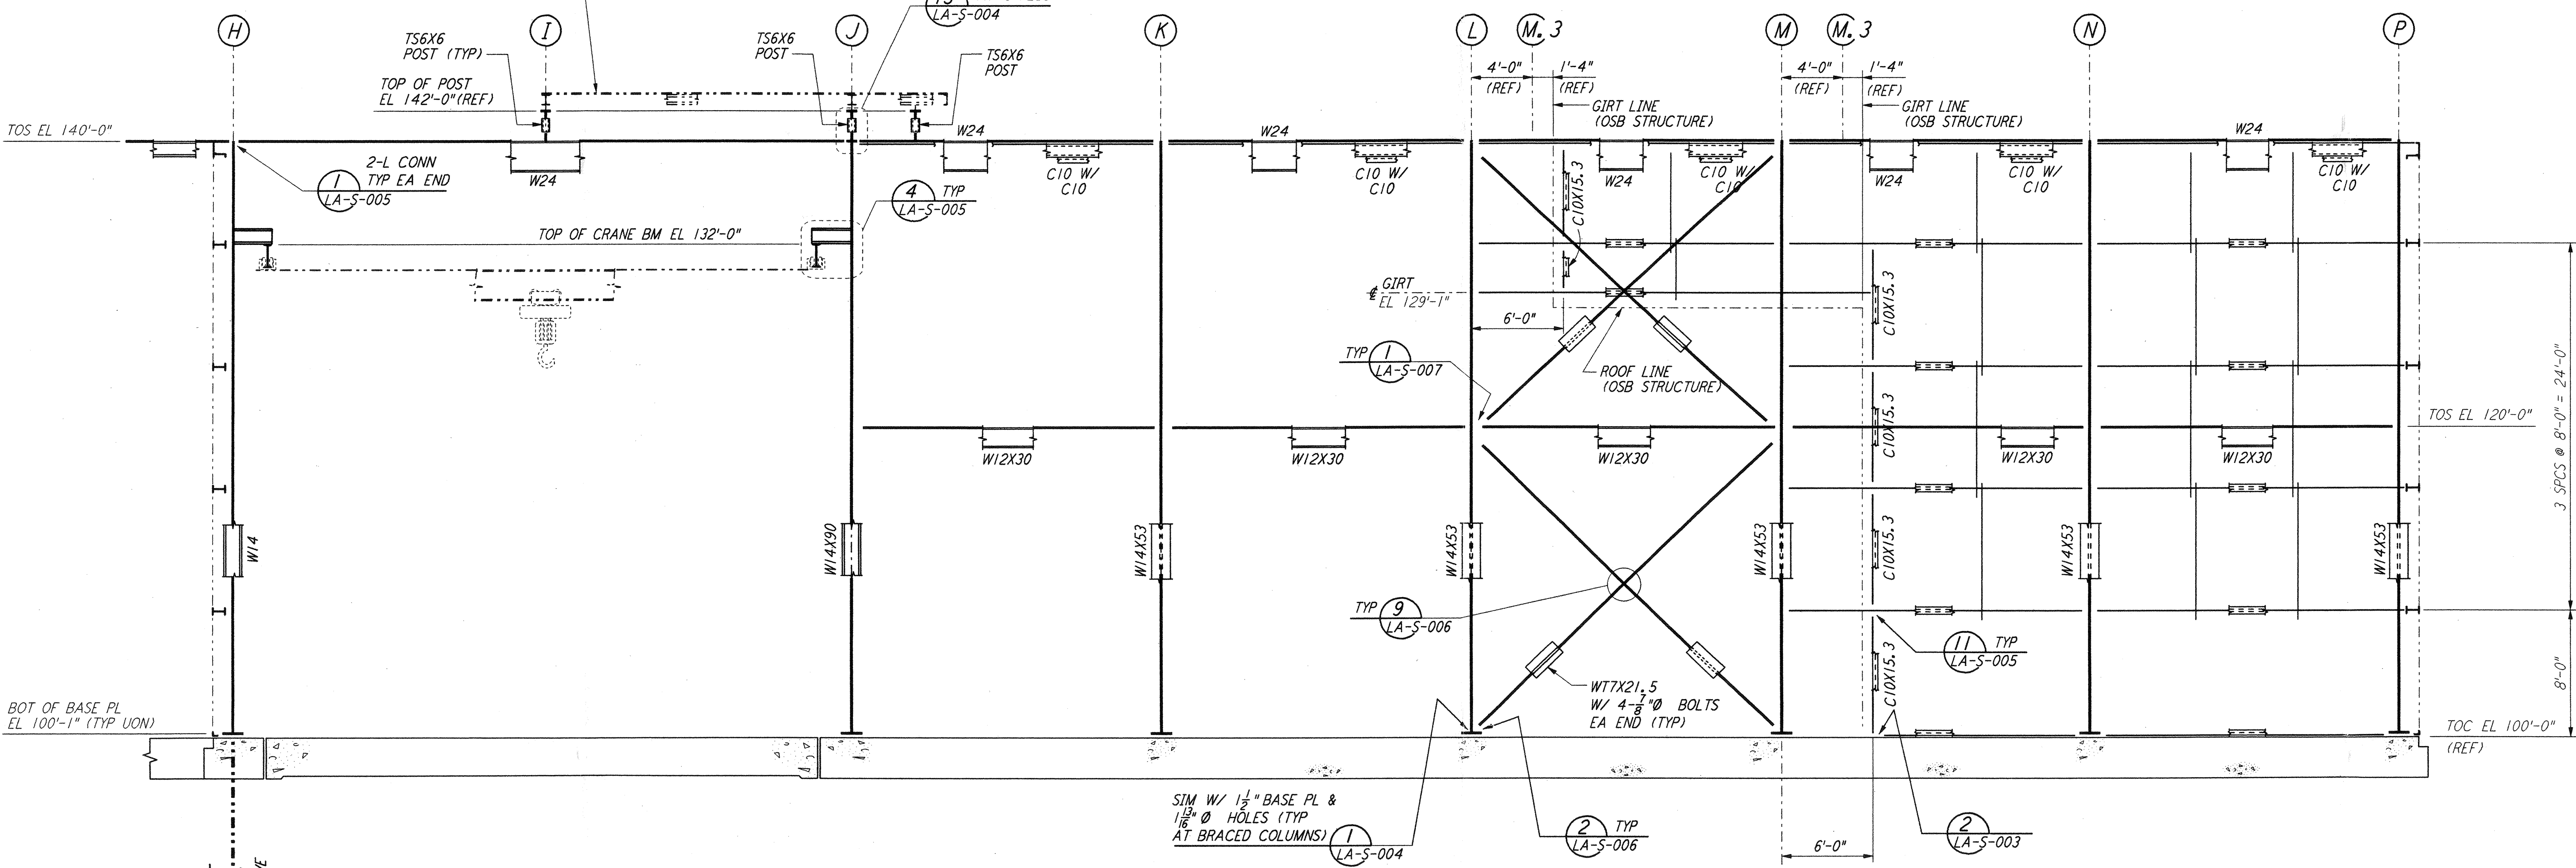

PARTIAL ELEVATION AT COLUMN LINE 10  
 $\frac{3}{16}'' = 1'-0''$

NOTE:  
 1. FOR NOTES SEE DRAWING LA-S-107.

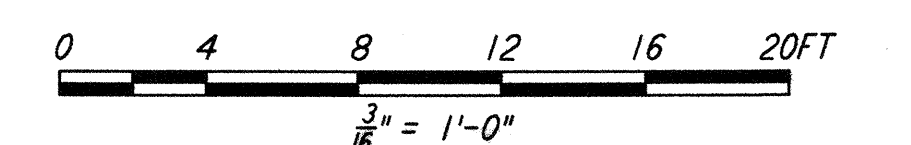

DRAWING NO.	DESCRIPTION

NO.	DATE	BY	CHKD	ENGR	PROJ	DESCRIPTION
1	08-07-98	WA				ISSUED FOR AS-BUILT

ISSUED FOR CONSTRUCTION	DRAWN	MCS	11-15-96
CHECKED	DDM	11-15-96	
ENGINEER	BP	11-15-96	
PROJ	TDM	11-15-96	

**AS-BUILT DRAWINGS**

100 WEST WALNUT STREET  
 PASADENA, CALIFORNIA

CALIFORNIA INSTITUTE OF TECHNOLOGY  
 MASSACHUSETTS INSTITUTE OF TECHNOLOGY

**LIGO-D960926-01-0**

LASER INTERFEROMETER  
 GRAVITATIONAL-WAVE OBSERVATORY  
 SITE NO.2 - LIVINGSTON, LOUISIANA

TITLE	SCALE	CONTRACT NUMBER	PROJECT NUMBER
STRUCTURAL CORNER STATION LVEA FRAMING ELEVATIONS SHEET 4	AS NOTED	PP150969	8094
SHEET NUMBER		REVISIONS	
<b>LA-S-110</b>			