



FRAMING ELEVATION AT COLUMN LINE J. 3
 $\frac{3}{8}'' = 1'-0''$

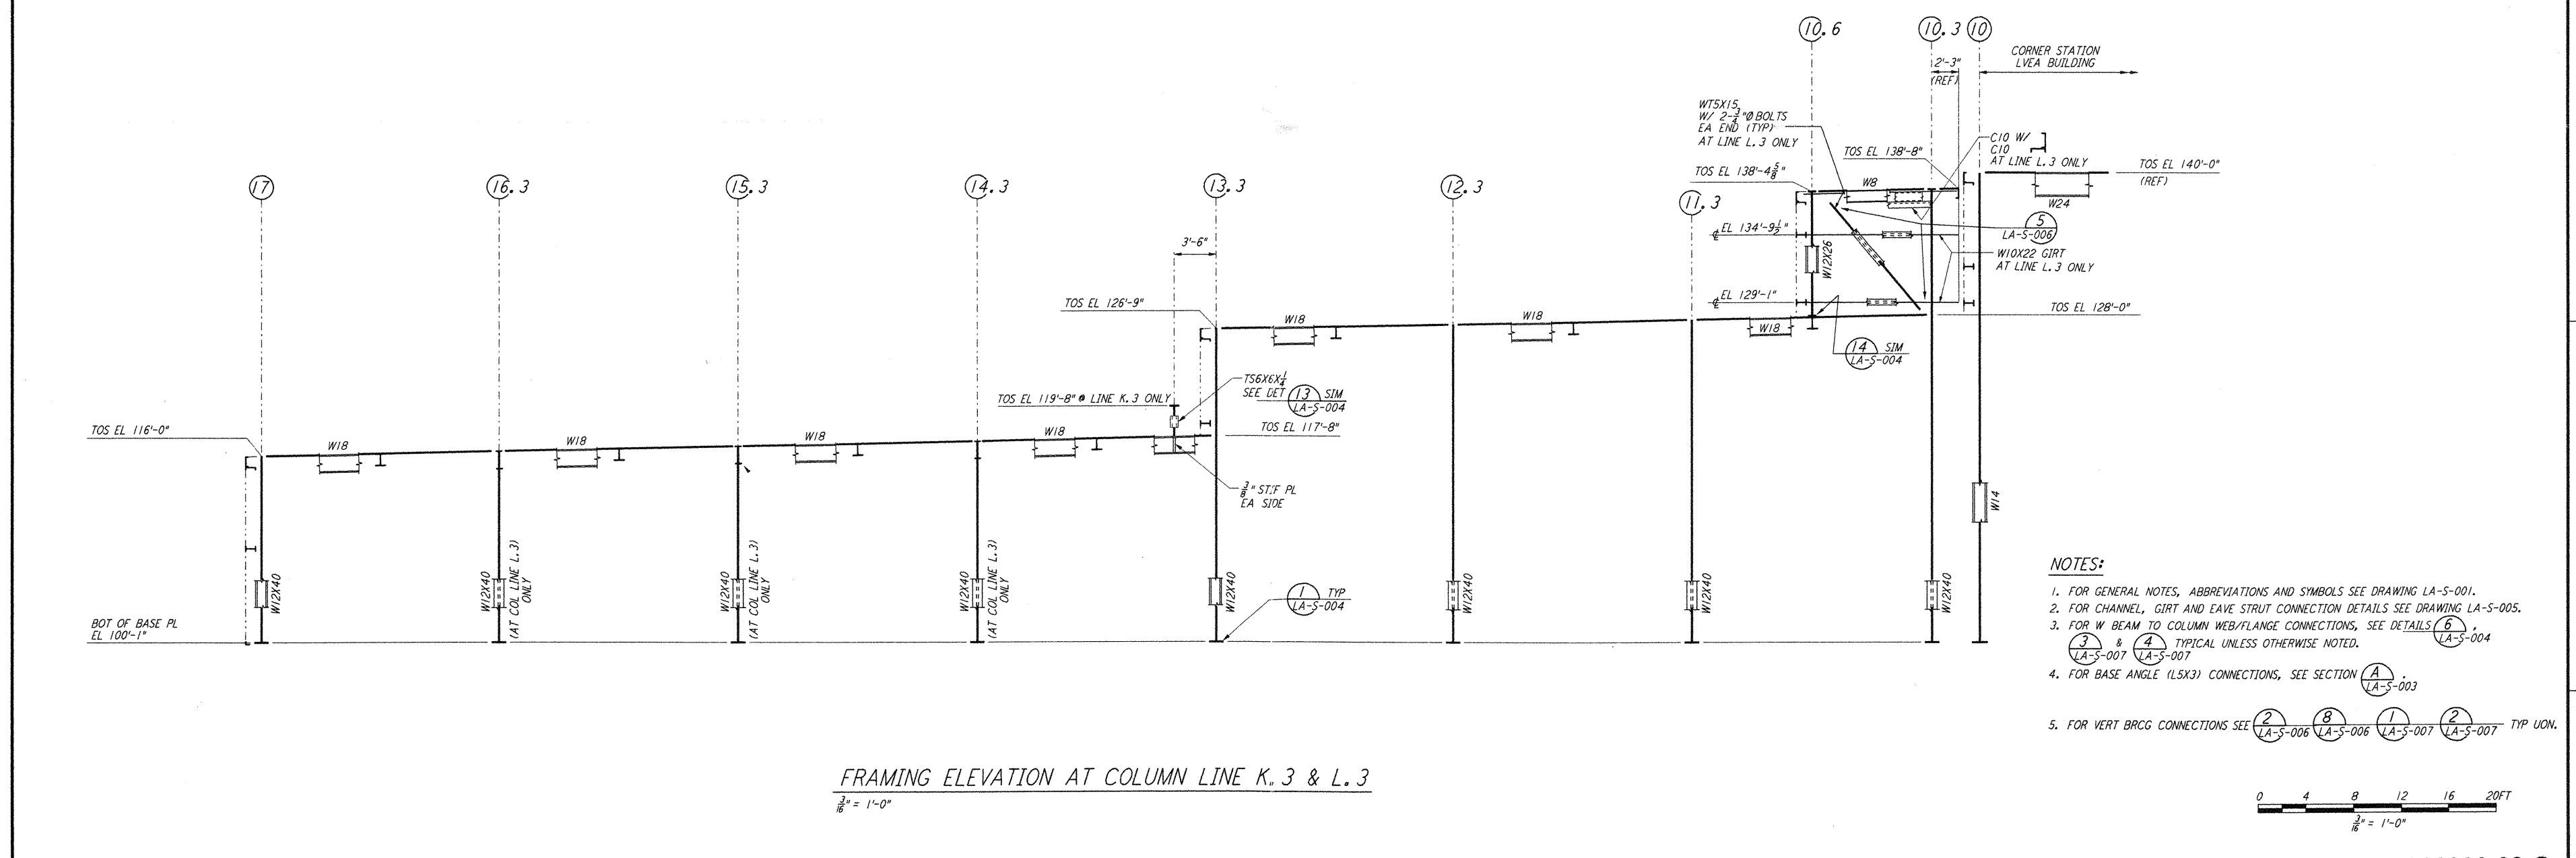

FRAMING ELEVATION AT COLUMN LINE K. 3 & L. 3
 $\frac{3}{8}'' = 1'-0''$

- NOTES:**
1. FOR GENERAL NOTES, ABBREVIATIONS AND SYMBOLS SEE DRAWING LA-5-001.
 2. FOR CHANNEL, GIRT AND EAVE STRUT CONNECTION DETAILS SEE DRAWING LA-5-005.
 3. FOR W BEAM TO COLUMN WEB/FLANGE CONNECTIONS, SEE DETAILS (6) LA-5-004 & (7) LA-5-007 & (4) LA-5-007 TYPICAL UNLESS OTHERWISE NOTED.
 4. FOR BASE ANGLE (LSX3) CONNECTIONS, SEE SECTION (A) LA-5-003.
 5. FOR VERT BRGC CONNECTIONS SEE (2) LA-5-006 & (8) LA-5-006 & (1) LA-5-007 & (2) LA-5-007 TYP UNON.

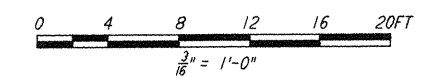


This document and the design it covers are the property of PARSONS. They are loaned only with the borrower's expressed written agreement that they will not be reproduced, copied, loaned, exhibited, or used in any other way, except by written consent from PARSONS to the borrower.

NO.	DATE	BY	CHKD	ENGR	PROJ	DESCRIPTION
2	08-07-98	WA	MM	MM	MM	ISSUED FOR AS-BUILT
1	2-28-97	RM	AB	BP	MM	REV GIRT EL AT ELEV LN K. 3 & L. 3

ISSUED FOR CONSTRUCTION
 DRAWN MCS 11-15-96
 CHECKED DDM 11-15-96
 ENGINEER BP 11-15-96
 PROJ TDM 11-15-96

AS-BUILT DRAWINGS

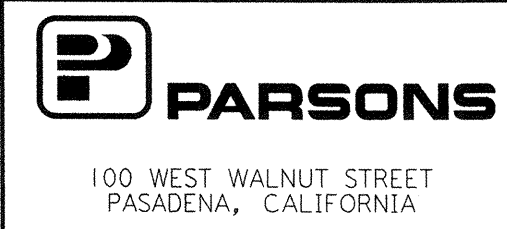

LIGO-D960933-02-0

LASER INTERFEROMETER GRAVITATIONAL-WAVE OBSERVATORY
 SITE NO. 2 - LIVINGSTON, LOUISIANA

TITLE: STRUCTURAL CORNER STATION OSB FRAMING ELEVATIONS SHEET 1

SCALE: AS NOTED
 CONTRACT NUMBER: PP150969
 PROJECT NUMBER: 8094

SHEET NUMBER: LA-S-117

Thu Aug 13 15:03:58 1998 C:\PLOT\JOB\AS3\3\B62.DWG 52885 K:\V38B2\1117.dwg LIGOLAF.BOR