


PARTIAL FRAMING ELEVATION AT COLUMN LINE 16.3


3/8" = 1'-0"

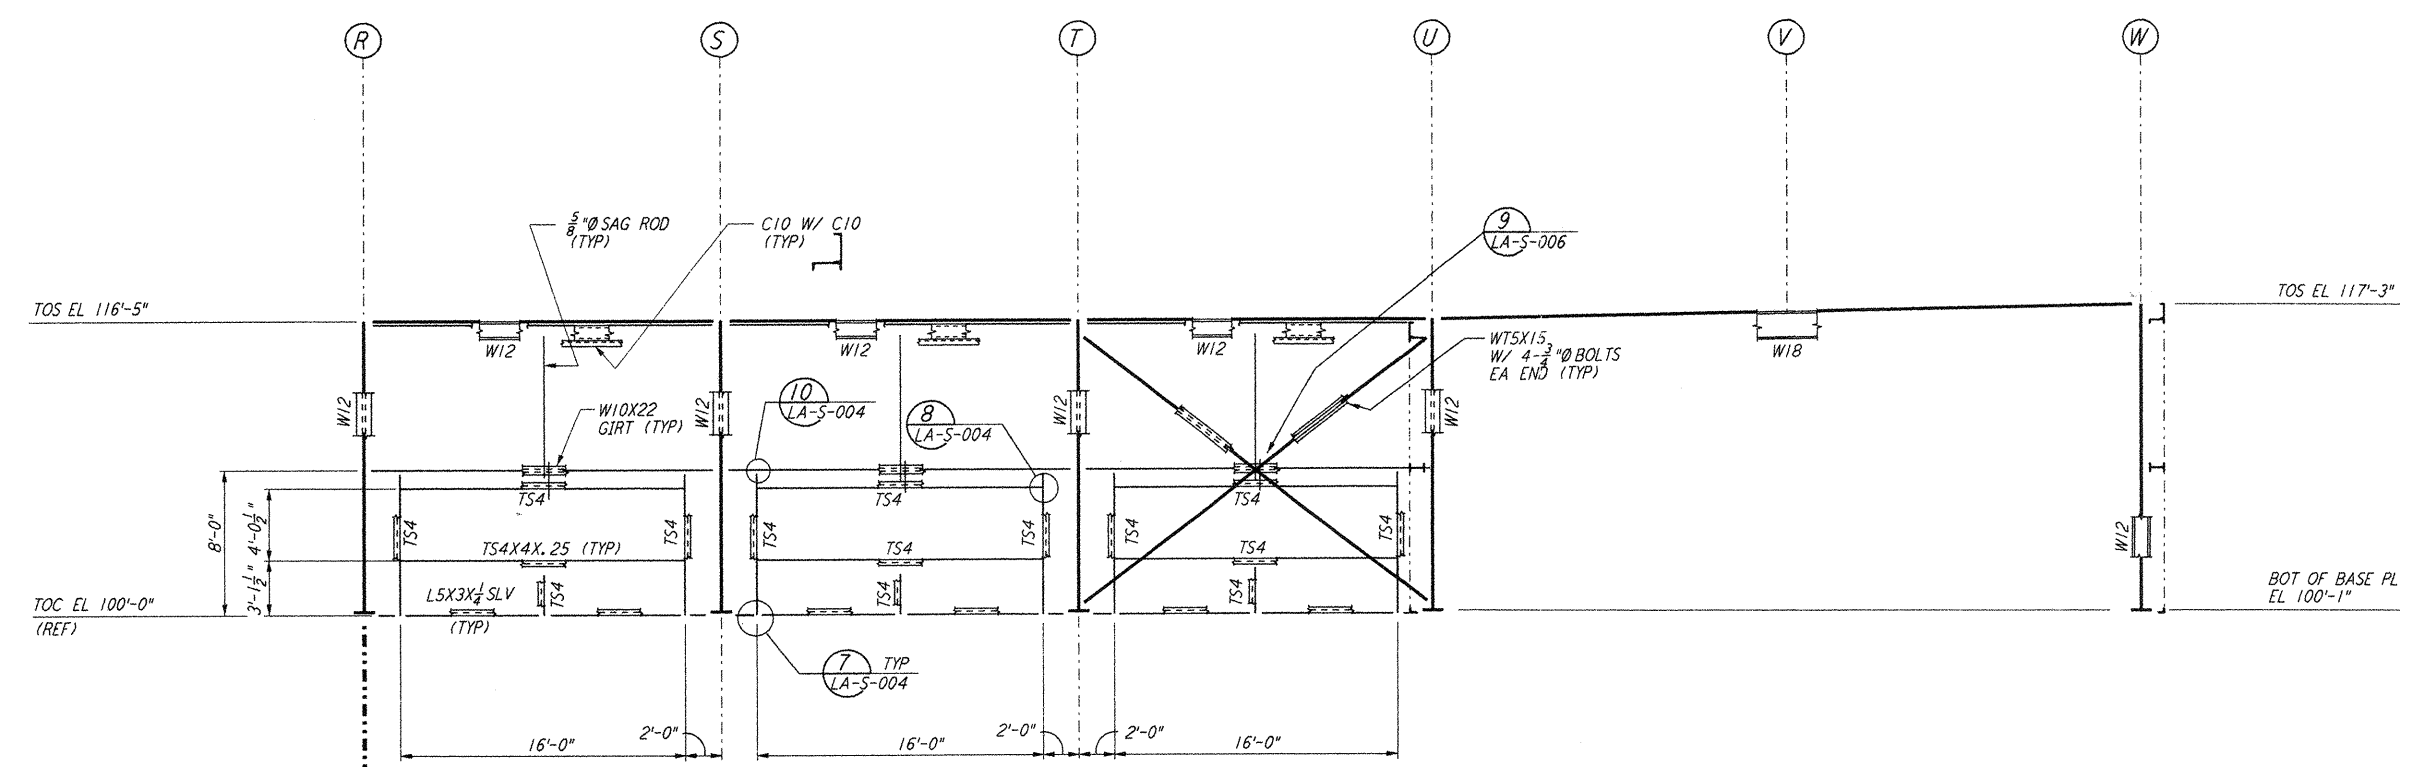

PARTIAL FRAMING ELEVATION AT COLUMN LINE 16.3

3/8" = 1'-0"

- NOTES:**
- FOR GENERAL NOTES, ABBREVIATIONS AND SYMBOLS SEE DRAWING LA-S-001.
 - FOR CHANNEL, GIRT AND EAVE STRUT CONNECTION DETAILS SEE DRAWING LA-S-005.
 - FOR W BEAM TO COLUMN WEB/FLANGE CONNECTIONS, SEE DETAILS 1, 2, 3, 999, 1000.

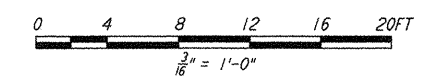

LIGO-D960938-02-O

NO.	DATE	BY	CHKD	ENGR	PROJ	DESCRIPTION
2	08-07-98	WA	RM	BP	WJW	ISSUED FOR AS-BUILT
1	2-28-97	RM	AB	BP		REV DIM AT ELEV LN 16.3

ISSUED FOR CONSTRUCTION	DRAWN	MCS	11-15-96
CHECKED	DDM	11-15-96	
ENGINEER	BP	11-15-96	
PROJ	TDM	11-15-96	

AS-BUILT DRAWINGS

100 WEST WALNUT STREET
PASADENA, CALIFORNIA

CALIFORNIA INSTITUTE OF TECHNOLOGY
MASSACHUSETTS INSTITUTE OF TECHNOLOGY

LASER INTERFEROMETER
GRAVITATIONAL-WAVE OBSERVATORY
SITE NO. 2 - LIVINGSTON, LOUISIANA

TITLE	STRUCTURAL CORNER STATION OSB FRAMING ELEVATIONS SHEET 6	SCALE	AS NOTED	CONTRACT NUMBER	PPI 50969	PROJECT NUMBER	8094
SHEET NUMBER	LA-S-122	REVISIONS					

not be reproduced, copied, loaned, exhibited, or used in any other way, except by written consent from PARSONS to the borrower.

This document and the design it covers are the property of PARSONS. They are loaned only with the borrower's expressed written agreement that they will not be reproduced, copied, loaned, exhibited, or used in any other way, except by written consent from PARSONS to the borrower.

E
D
C
B
A
LIGOLAF.BDR