



NOTES:

1. FOR LEGEND, ABBREVIATIONS AND GENERAL NOTES SEE SHEETS LA-H-001 AND LA-H-002.
2. PROVIDE HIGH PRESSURE FLEX CONNECTION AT THE POINT OF CONNECTION OF DUCTS AND THE AIR HANDLING UNITS.
3. SEE FLOOR PLAN (SHEET LA-H-131) FOR LOCATION OF COMPRESSED AIR RECEIVER AND HUMIDIFIERS ABOVE THE AIR HANDLING UNITS.
4. SEE FLOOR PLAN NOTES FOR DUCT INSULATION.
5. LOCATE ROOM TEMPERATURE SENSOR / TRANSMITTER FOR THE MECHANICAL ROOM AT 4'-6" ABOVE FINISHED FLOOR LEVEL.

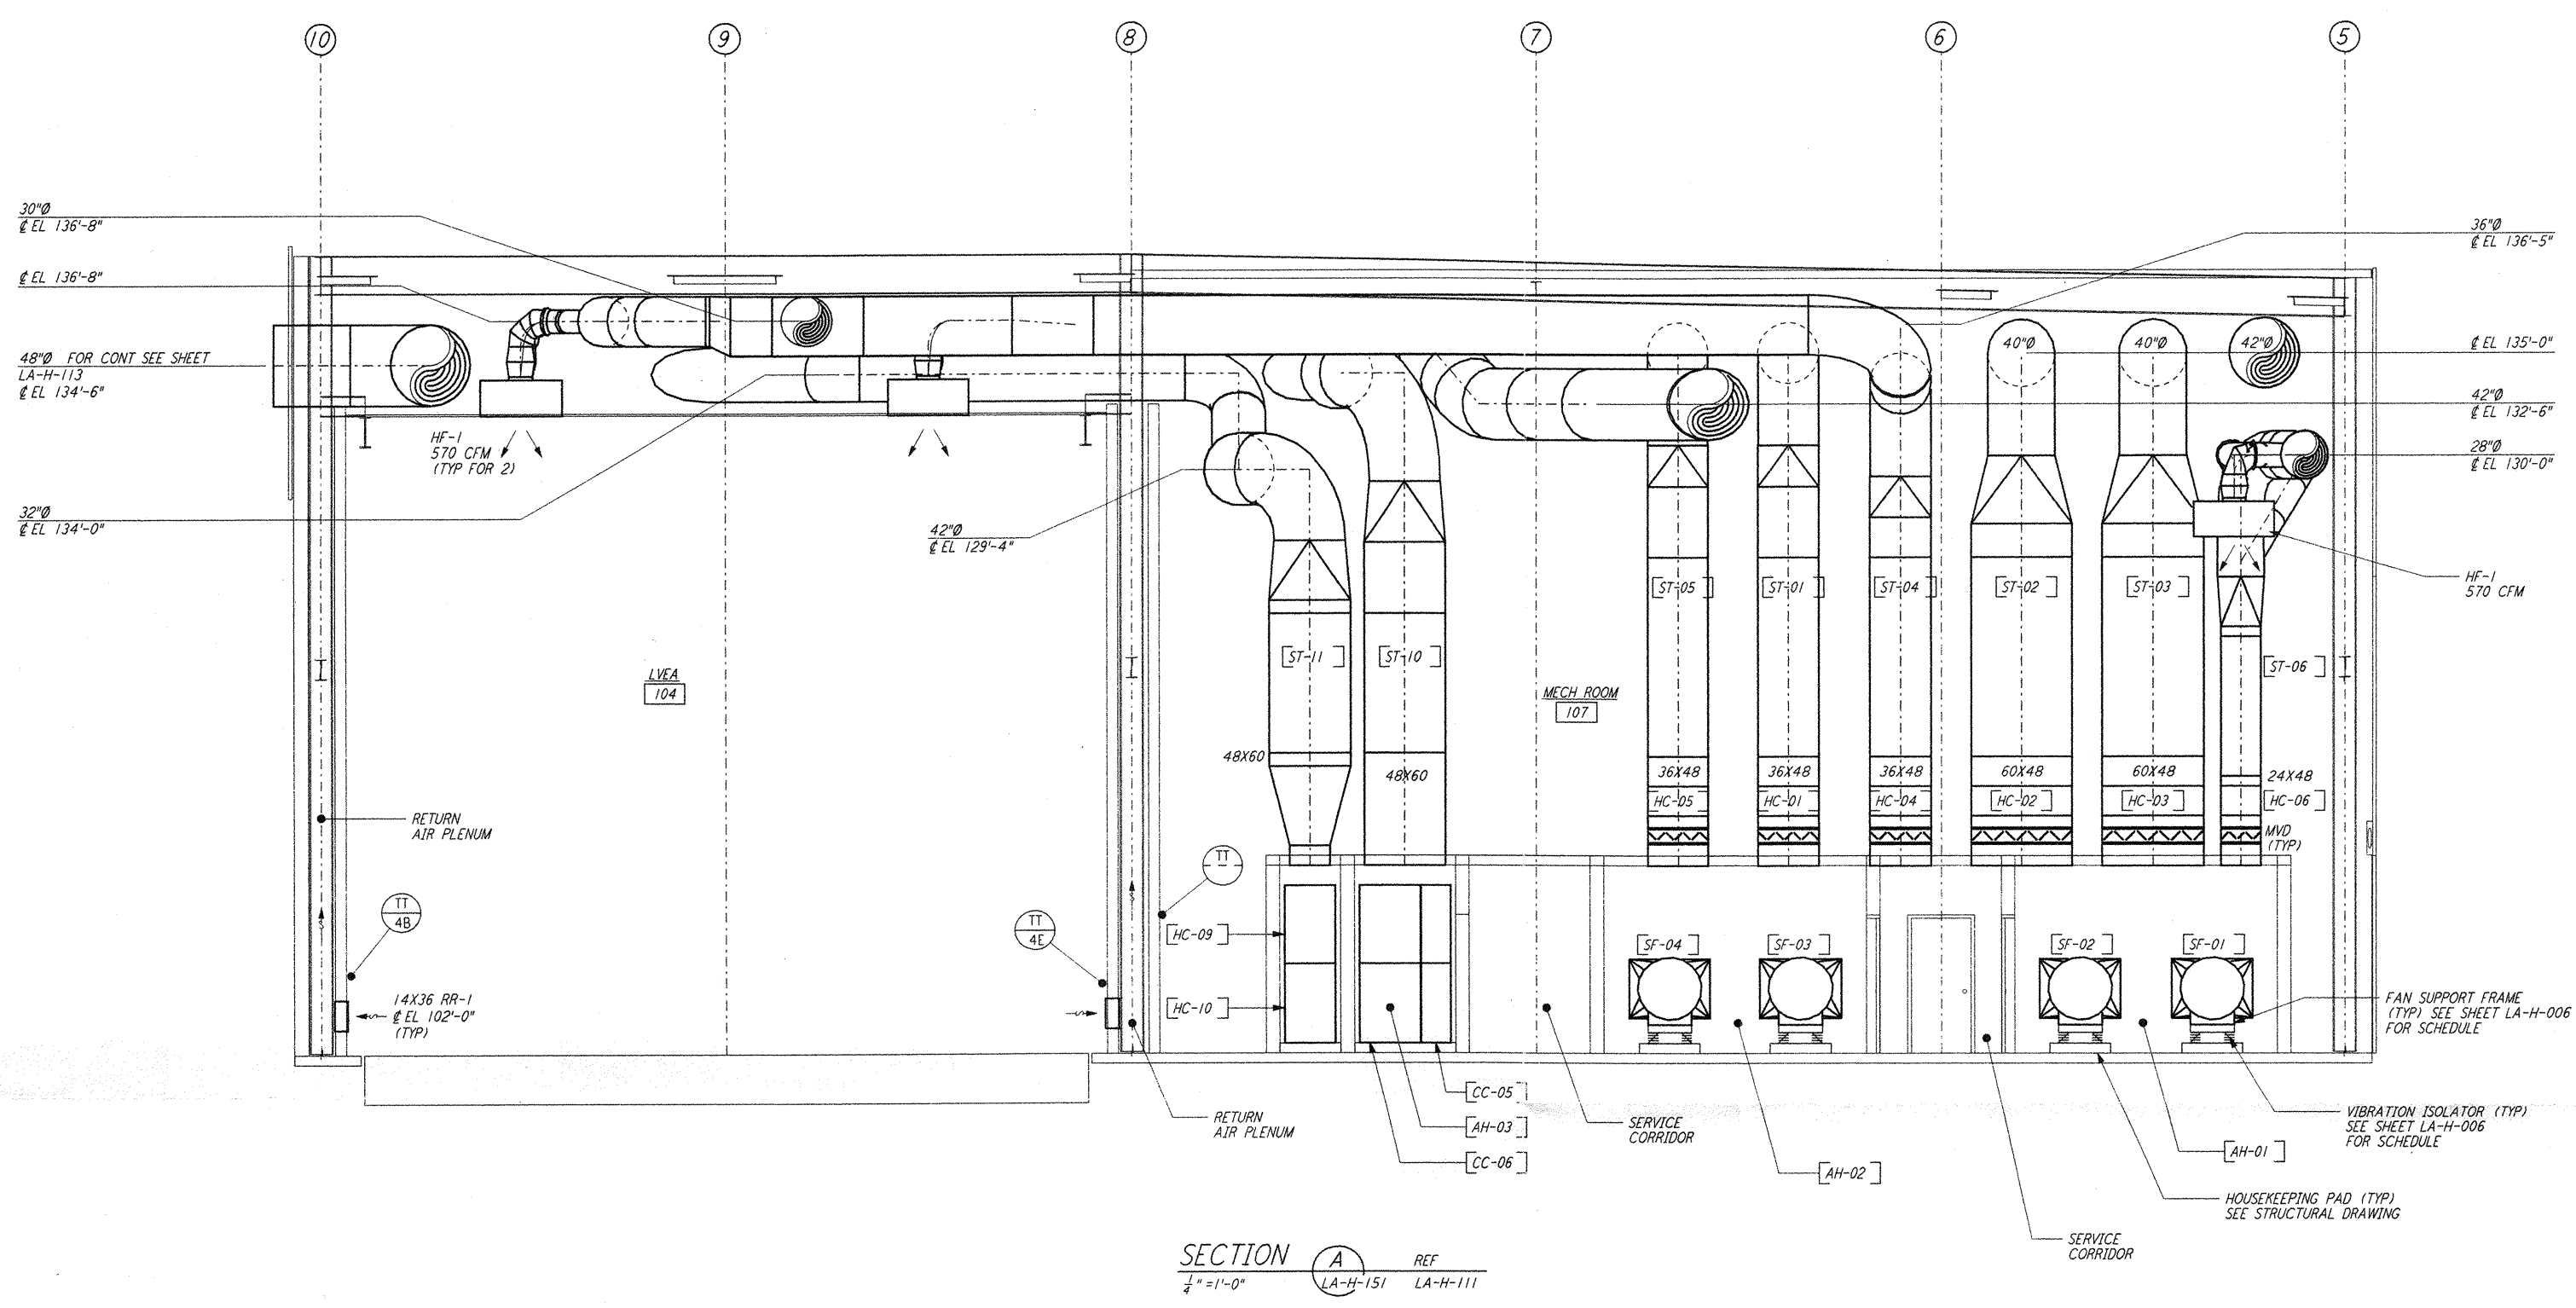

SECTION A
 REF LA-H-151 LA-H-111
 1/4" = 1'-0"

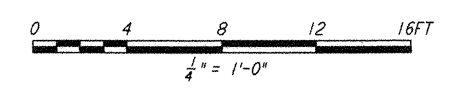

LIGO-D960979-01-O

LASER INTERFEROMETER
 GRAVITATIONAL-WAVE OBSERVATORY
 SITE NO.2 - LIVINGSTON, LOUISIANA

| | | | |
|--|----------|-----------------|----------------|
| TITLE | SCALE | CONTRACT NUMBER | PROJECT NUMBER |
| HVAC CORNER STATION SECTIONS SHEET 1 | AS NOTED | PP150969 | 8094 |
| SHEET NUMBER | | REVISIONS | |
| LA-H-151 | | | |

LIGO
 CALIFORNIA INSTITUTE OF TECHNOLOGY
 MASSACHUSETTS INSTITUTE OF TECHNOLOGY

PARSONS
 100 WEST WALNUT STREET
 PASADENA, CALIFORNIA

| | | | |
|--------------------------|-----|----------|--|
| ISSUED FOR CONSTRUCTION | | | |
| DRAWN | CLP | 11-15-96 | |
| CHECKED | MN | 10-25-96 | |
| ENGINEER | AA | 1-23-96 | |
| PROJ | TDM | 11-15-96 | |
| AS-BUILT DRAWINGS | | | |

| NO. | DATE | BY | CHKD | ENGR | PROJ | DESCRIPTION |
|-----|--------|-----|------|------|------|---------------------|
| 1 | 8-7-98 | DJB | AA | AA | W | ISSUED FOR AS-BUILT |

| DRAWING NO. | DESCRIPTION |
|-------------|-------------|
| | |
| | |
| | |

This document and the design it covers are the property of PARSONS. They are loaned only with the borrower's expressed written agreement that they will not be reproduced, copied, loaned, exhibited, or used in any other way, except by written consent from PARSONS to the borrower.