




**PLAN SYMBOLS**

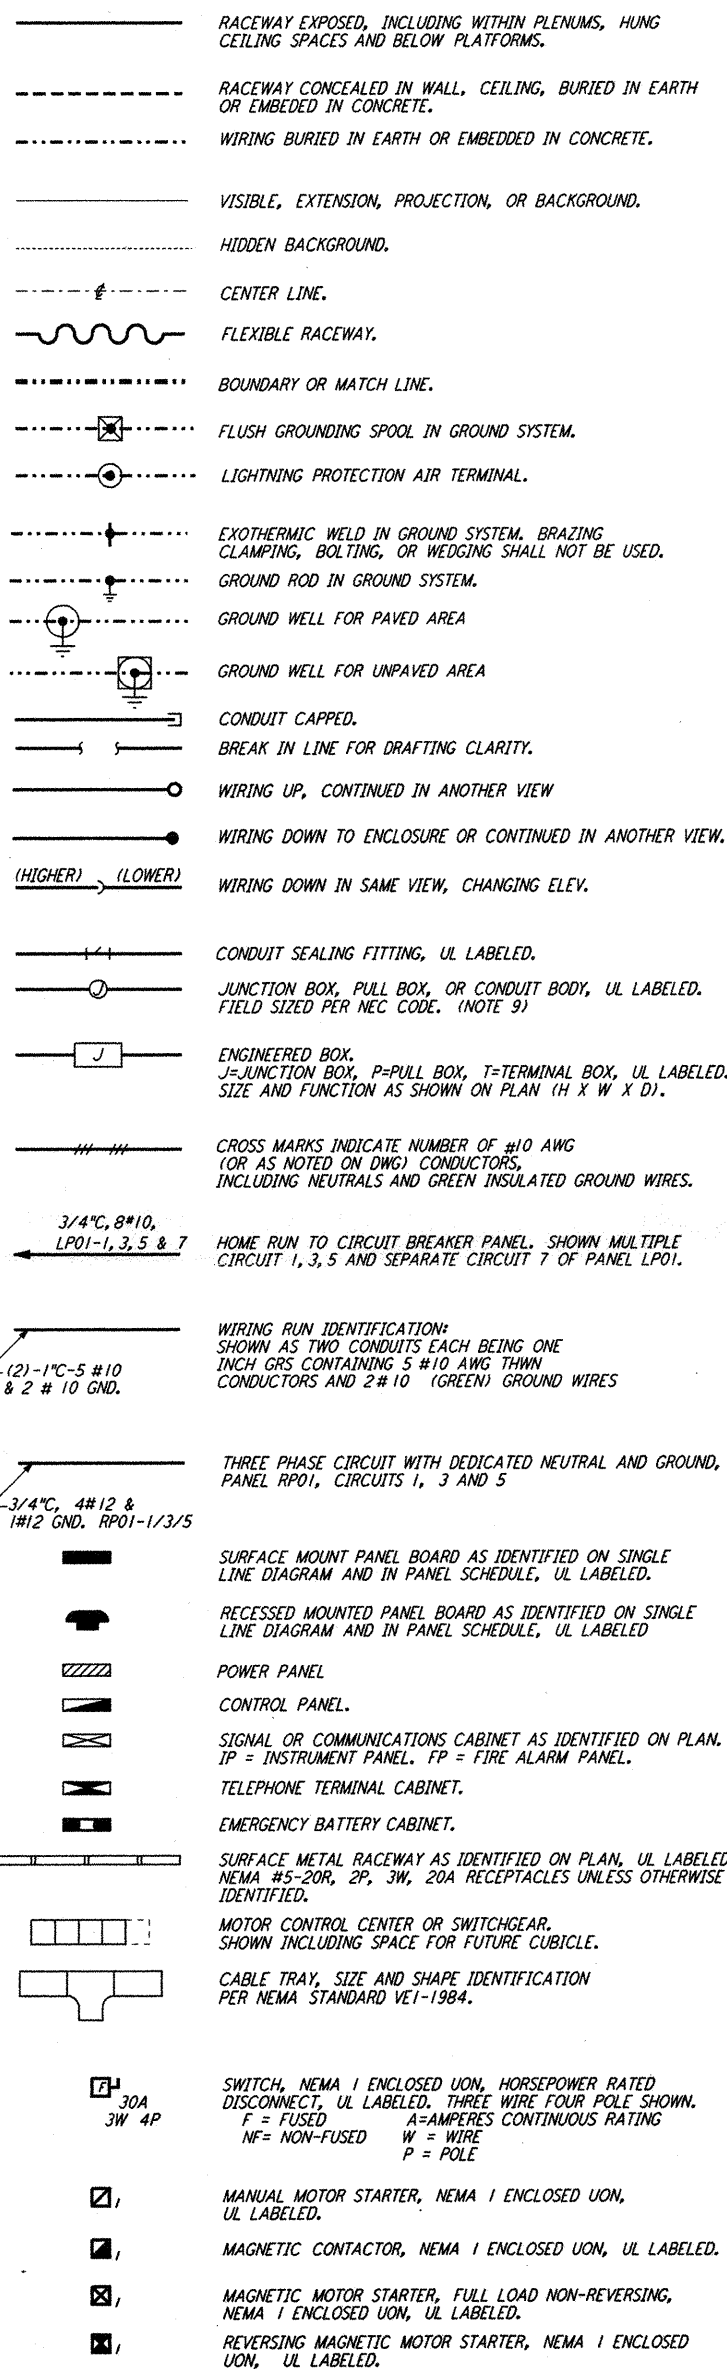

**PLAN SYMBOLS**

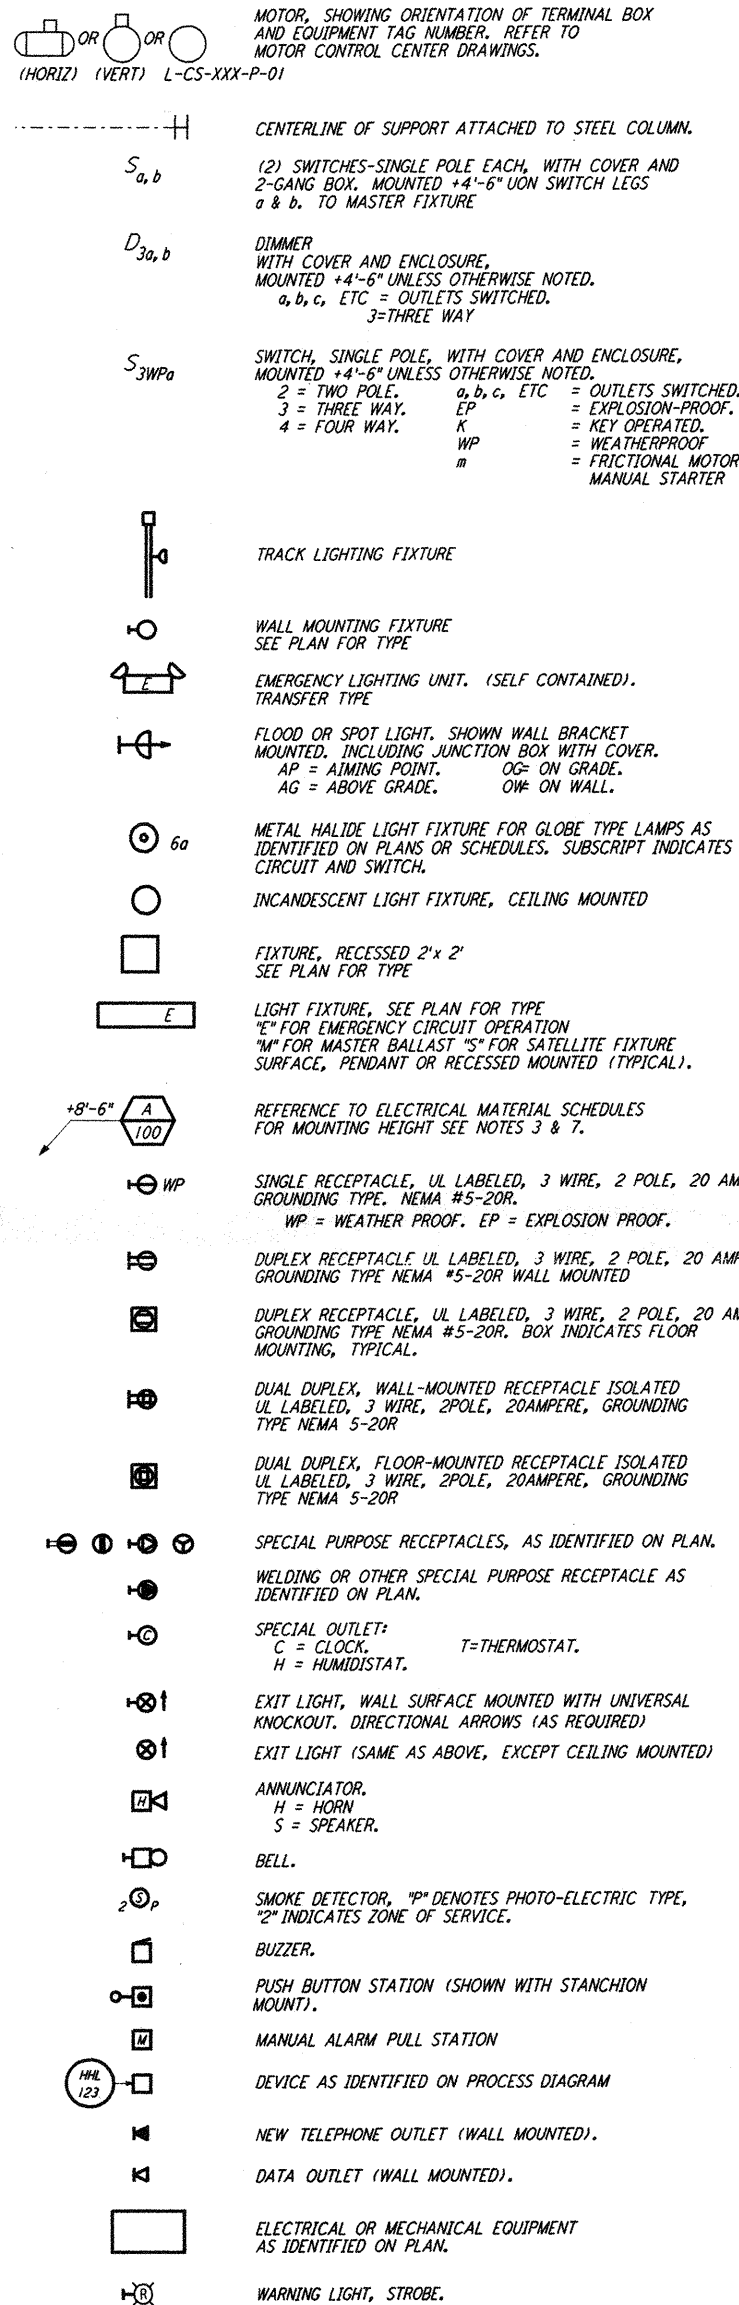

**PLAN SYMBOLS**

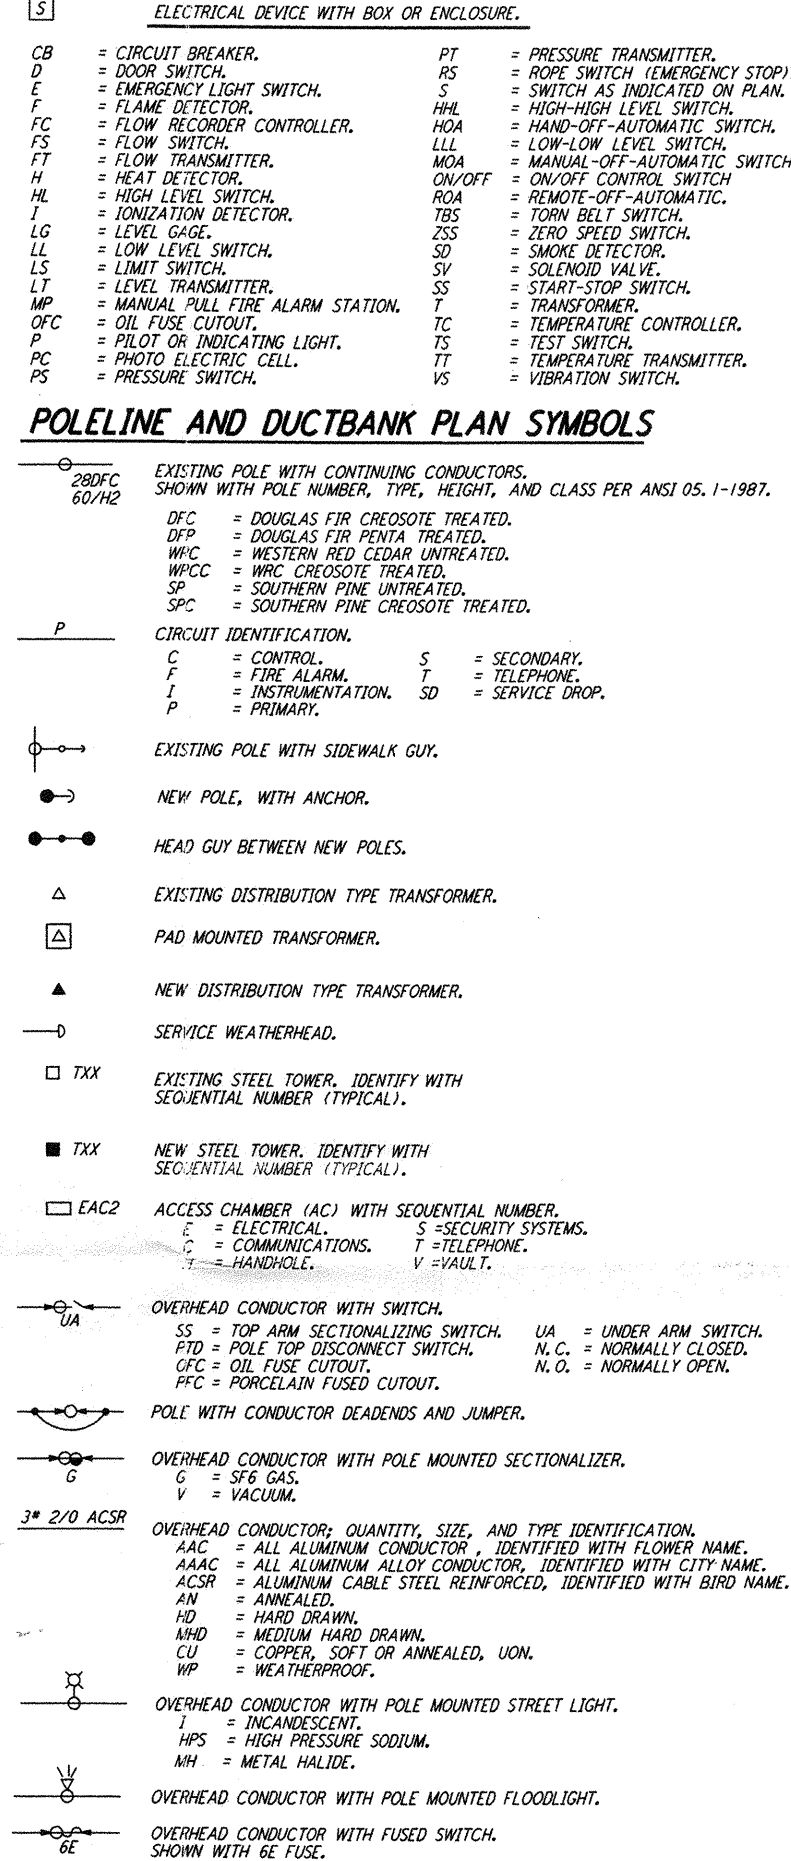

**NOTES:**

- APPROPRIATE BOX AND COVER SHALL BE PROVIDED WITH ALL OUTLETS, SEE SPECIFICATIONS.
- GROUND UNDERGROUND PIPING TO MAIN GROUNDING COUNTERPOISE.
- MOUNTING HEIGHT OF EQUIPMENT, UNLESS OTHERWISE NOTED, SHALL BE ABOVE FINISHED FLOOR AS FOLLOWS:
  - LIGHTS OVER DOORS, 1'-0" ABOVE DOOR OPENING TO BOTTOM OF FIXTURE.
  - LOCAL SWITCHES, 4'-6" TO CENTERLINE.
  - OFFICE AND CONTROL ROOM RECEPTACLES 1'-6" TO CENTERLINE.
  - OTHER RECEPTACLES, 3'-6" TO CENTERLINE.
  - LIGHTING PANELS, 6'-0" MAXIMUM TO TOP CIRCUIT BREAKER.
- EMERGENCY LIGHTING SYSTEM BRANCH CIRCUIT RACEWAY AS WELL AS FIRE ALARM AND DETECTION RACEWAY SHALL BE INDEPENDENT OF OTHER RACEWAY SYSTEMS.
- MINIMUM CONDUCTOR SIZE FOR ALL LIGHTING AND 120V CONVENIENCE RECEPTACLE CIRCUITS SHALL BE AWG #12, 600V, TYPE THWN INSULATION STRANDED COPPER WIRE, UNLESS OTHERWISE NOTED. CONNECTIONS SHALL BE MADE WITH CRIMP LUGS AND CRIMP CONNECTORS. WIRE NUTS SHALL NOT BE USED.
- FLEXIBLE CONDUIT SHALL BE USED FOR RECESSED FIXTURES FROM THE JUNCTION BOX TO THE FIXTURE NOT EXCEEDING A MAXIMUM LENGTH OF 6'-0". MINIMUM LENGTH FOR FLEXIBILITY SHALL BE 3'-0".
- MOUNTING HEIGHT OF LIGHTING FIXTURES, AS INDICATED ON THE DRAWINGS, IS FROM FINISHED FLOOR, PLATFORM, OR DECK TO BOTTOM OF FIXTURE.
- MINIMUM DISTANCE BETWEEN THE TOP OF CABLE TRAY AND BOTTOM OF THE STRUCTURAL STEEL DIRECTLY ABOVE IT SHALL BE 6". WHERE TWO TRAYS CROSS EACH OTHER, THE TOP OF THE LOWER TRAY TO THE BOTTOM OF THE TRAY ABOVE SHALL BE 6" MINIMUM.
- THE CONSTRUCTOR SHALL PROVIDE CONDUIT BODIES, FITTINGS, AND SUPPORTS NOT SHOWN ON THE DRAWINGS BUT REQUIRED BY JOB CONFIGURATION OR THE NEC.

This document and the design it covers are the property of PARSONS. They are loaned only with the borrower's expressed written agreement that they will not be reproduced, copied, loaned, exhibited, or used in any other way, except by written consent from PARSONS to the borrower.

|          |                                    |
|----------|------------------------------------|
| LA-E-001 | ABBREVIATIONS & ACRONYMS           |
| LA-E-002 | SCHEMATIC & WIRING DIAGRAM SYMBOLS |
| LA-E-004 | ONE & THREE LINE DIAGRAM SYMBOLS   |

|     |        |    |      |      |      |                     |
|-----|--------|----|------|------|------|---------------------|
| NO. | DATE   | BY | CHKD | ENGR | PROJ | ISSUED FOR AS-BUILT |
| 1   | 8-7-98 | JE | AK   | AK   | WUU  | ISSUED FOR AS-BUILT |

|                         |
|-------------------------|
| ISSUED FOR CONSTRUCTION |
| DRAWN M.M. 11-15-96     |
| CHECKED JCL 7-24-96     |
| ENGINEER KCR 10-25-96   |
| PROJ T.D.M. 11-15-96    |

**AS-BUILT DRAWINGS**

**PARSONS**

100 WEST WALNUT STREET  
PASADENA, CALIFORNIA

**LIGO**

CALIFORNIA INSTITUTE OF TECHNOLOGY  
MASSACHUSETTS INSTITUTE OF TECHNOLOGY

**LIGO-D960995-01-0**

LASER INTERFEROMETER  
GRAVITATIONAL-WAVE OBSERVATORY  
SITE NO. 2 - LIVINGSTON, LOUISIANA

|                                  |          |                 |                |
|----------------------------------|----------|-----------------|----------------|
| TITLE                            | SCALE    | CONTRACT NUMBER | PROJECT NUMBER |
| ELECTRICAL STANDARD PLAN SYMBOLS | NONE     | PP150969        | 8094           |
| SHEET NUMBER                     | LA-E-002 |                 | REVISED        |

Aug 12 13:29:41 1998 C:\PLOT\00E\53\13882.DWG 52085 K:\V3682\ee\002.prf