

**LEGEND:**


- WP RECEPTACLE, 208V, 3Ø, 5W, 4 POLE GROUNDING NEMA L21-30R HUBBELL #2810 WITH WEATHERPROOF BOX AND COVER
- RECEPTACLE, 208V, 3Ø, 5W, 4 POLE GROUNDING NEMA L21-30R HUBBELL #2810 WITH BOX AND COVER

**NOTES:**


1. FOR ABBREVIATIONS AND ACRONYMS SEE DWG. LA-E-001.
2. FOR SYMBOLS SEE DWG. LA-E-002.
3. FOR GENERAL NOTES SEE DWG. LA-E-100.
4. PANELS L-CS-175-RP-01 AND L-CS-175-RP-02 ARE RESERVED FOR CUSTOMER USE.
5. NOT USED.
6. FOR ALL PANEL FEEDER CONDUIT AND CABLE SIZES SEE SINGLE LINE DIAGRAM DWG LA-E-006. ROUTE CABLES IN CONCEALED CONDUIT TO L-CS-107-SB-01. FOR LOCATION SEE DWG LA-E-100.
7. SEE PANEL SCHEDULES ON DWG LA-E-115 & LA-E-116 FOR GFCI CIRCUITS.

**REFERENCE DRAWINGS:**

- LA-E-109 COMMUNICATION RISER DIAGRAM
- LA-E-115 LIGHTING AND POWER PANEL SCHEDULES
- LA-E-116 LIGHTING AND POWER PANEL SCHEDULES


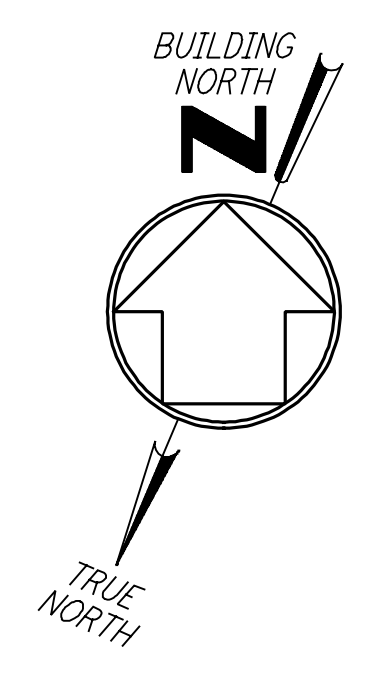


CIRCUIT NUMBER  
 SEE RECEPTACLE/POWER PANEL NUMBER IDENTIFICATION SCHEDULE AT LOWER LEFT FOR PANEL NUMBER (UNLESS OTHERWISE NOTED) (TYP)

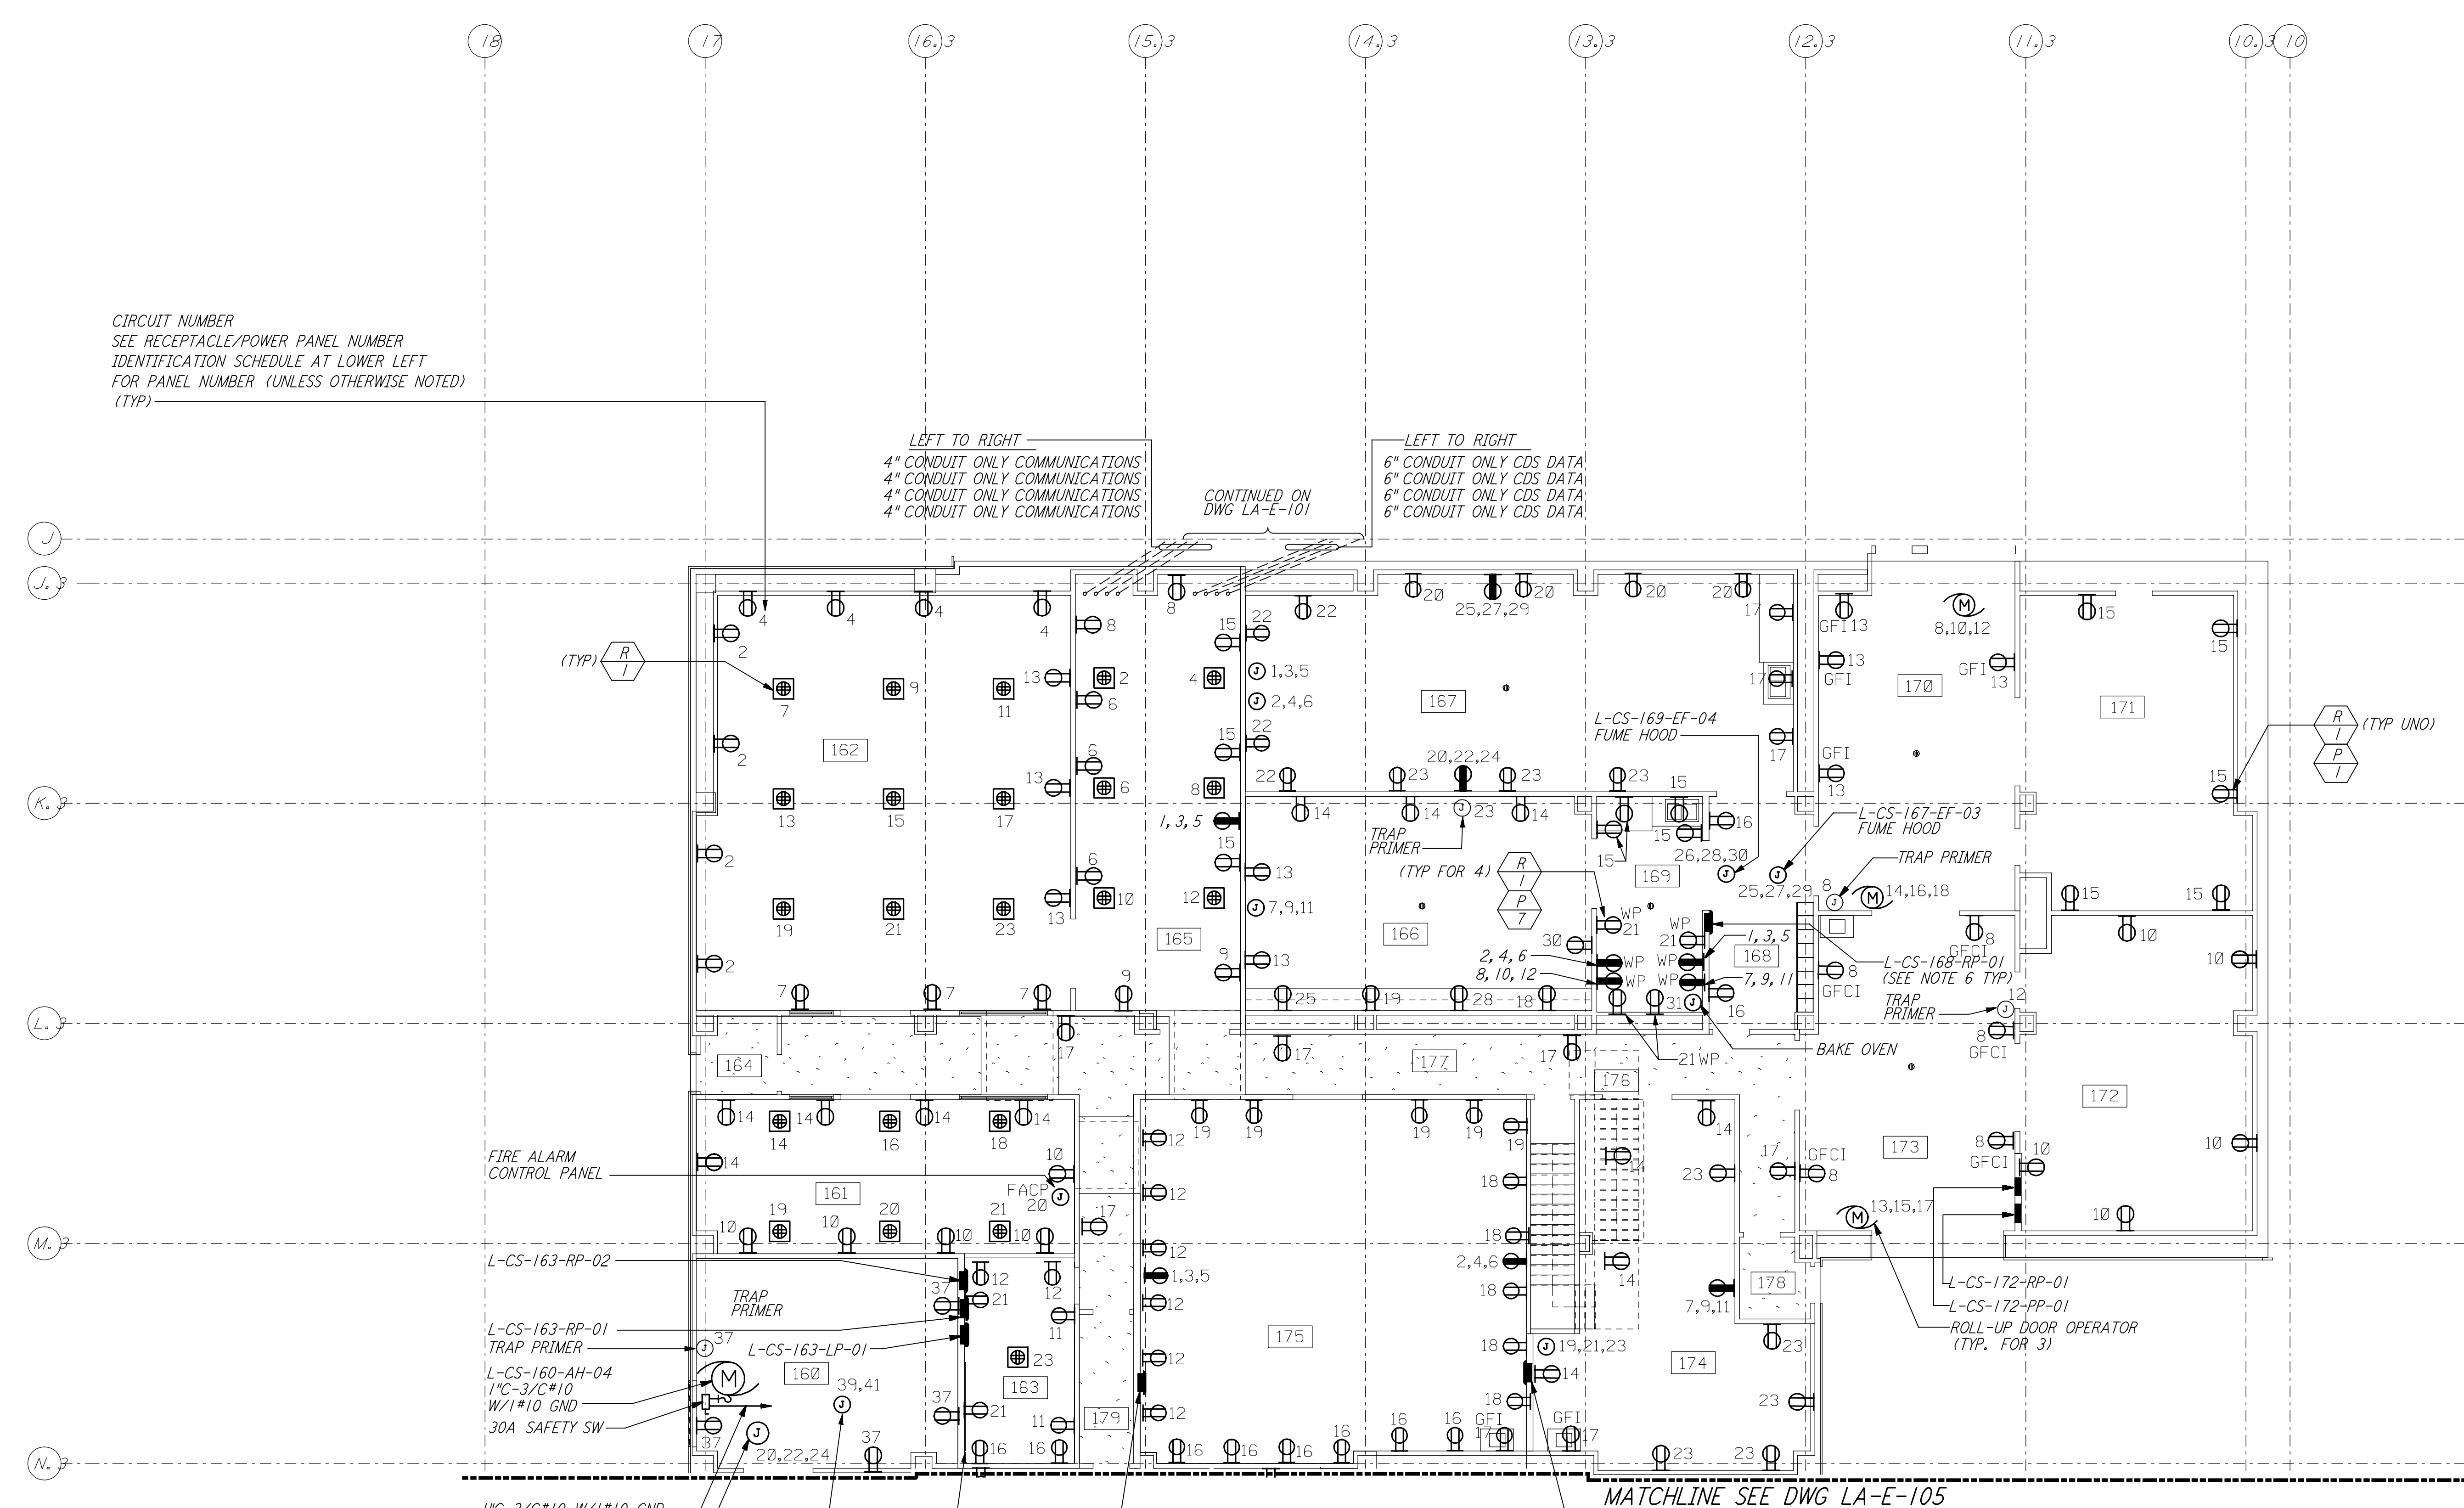

**RECEPTACLE/POWER PANEL NUMBER IDENTIFICATION SCHEDULE** (SEE NOTE 7)

ROOM NUMBER	PANEL NUMBER FOR DUPLEX RECEPTACLE	PANEL NUMBER FOR DUAL-DUPLEX RECEPTACLE	PANEL NUMBER FOR 3Ø, 5-POLE RECEPTACLE	PANEL NUMBER FOR JUNCTION BOX POWER	PANEL NUMBER FOR ROLL-UP DOOR POWER
160	L-CS-163-RP-01	---	---	L-CS-163-RP-01	---
161	L-CS-163-RP-01	L-CS-163-RP-02	---	L-CS-163-RP-01	---
162	L-CS-163-RP-01	L-CS-163-RP-02	---	---	---
163	L-CS-163-RP-01	L-CS-163-RP-02	---	---	---
164	---	---	---	---	---
165	L-CS-163-RP-01	L-CS-163-RP-02	L-CS-163-RP-01	---	---
166	L-CS-168-RP-01	---	---	L-CS-172-PP-01	---
167	L-CS-168-RP-01	---	L-CS-172-RP-01	L-CS-172-PP-01	---
168	L-CS-168-RP-01	---	---	---	---
169	L-CS-168-RP-01	---	L-CS-168-RP-01	L-CS-172-PP-01	---
170	L-CS-172-RP-01	---	---	---	L-CS-172-PP-01
171	L-CS-172-RP-01	---	---	---	---
172	L-CS-172-RP-01	---	---	---	---
173	L-CS-172-RP-01	---	---	---	L-CS-172-PP-01
174	L-CS-172-RP-01	---	L-CS-172-RP-01	L-CS-172-PP-01	---
175	L-CS-172-RP-01	---	L-CS-172-RP-01	---	---
176	---	---	---	---	---
177	L-CS-163-RP-01	---	---	---	---
178	---	---	---	---	---
179	L-CS-163-RP-01	---	---	---	---

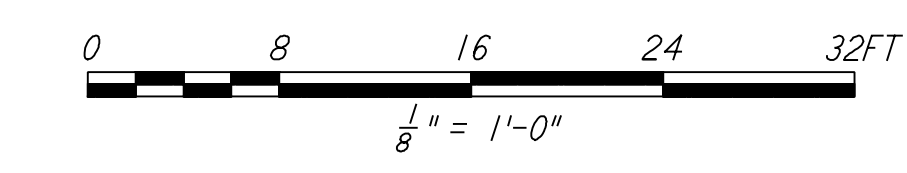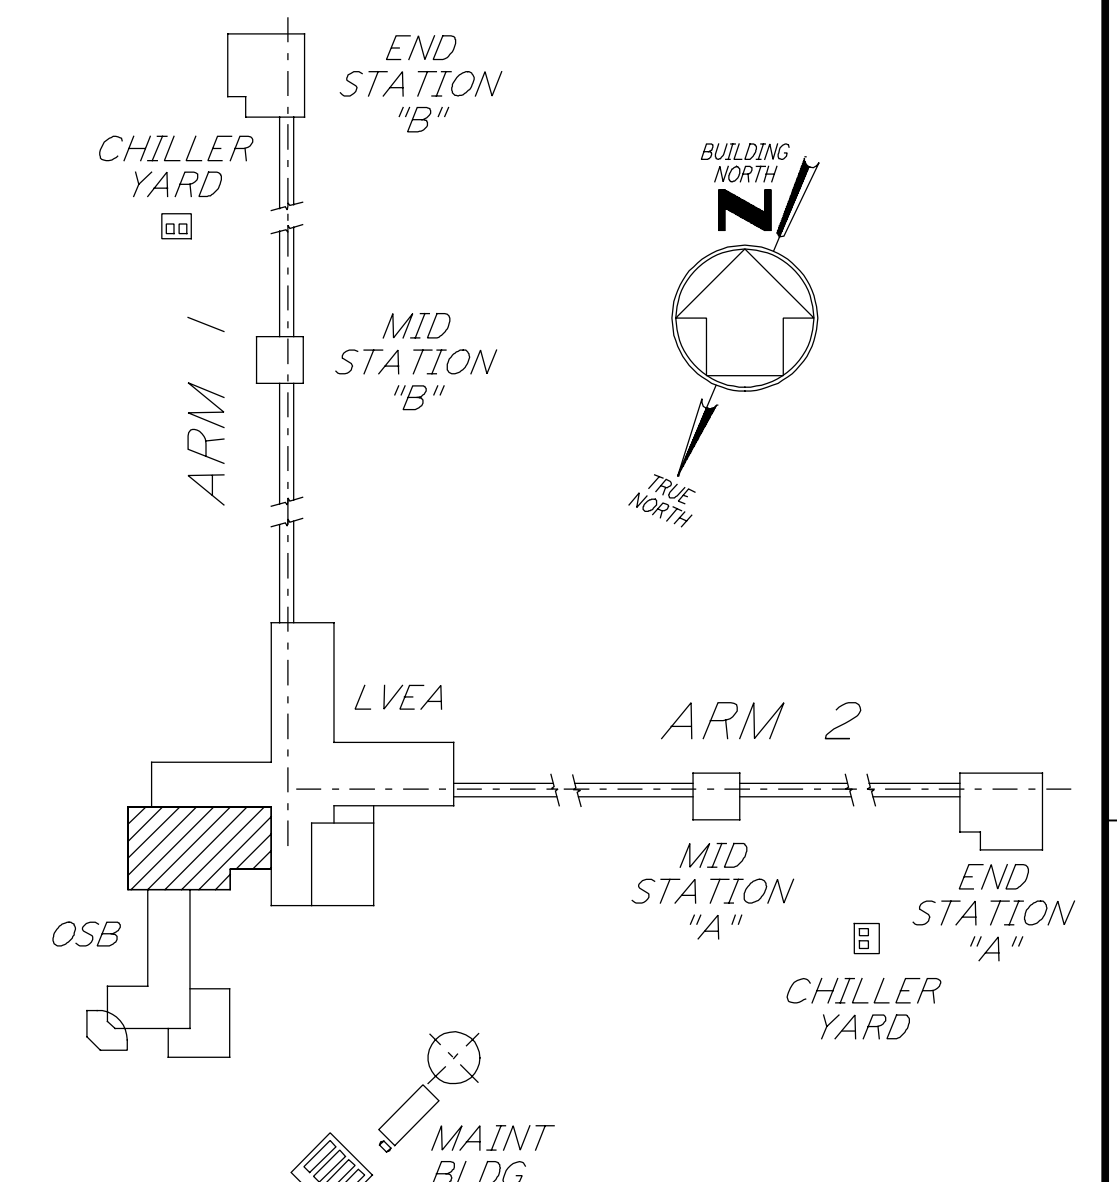

NO.	DATE	BY	CHKD	ENGR	PROJ	DESCRIPTION
2	5-21-99	AO				ISSUED AS REVISED AS-BUILT
1	8-7-98	JE	AK	AG	MDW	ISSUED FOR AS-BUILT

ISSUED FOR CONSTRUCTION  
 DRAWN M. M. 11-15-96  
 CHECKED JCL 7-24-96  
 ENGINEER KCR 10-25-96  
 PROJ T. D. M. 11-15-96

**AS-BUILT DRAWINGS**



**LIGO-D961008-02-0**

LASER INTERFEROMETER GRAVITATIONAL-WAVE OBSERVATORY  
 SITE NO. 2 - LIVINGSTON, LOUISIANA

TITLE	SCALE	CONTRACT NUMBER	PROJECT NUMBER
ELECTRICAL CORNER STATION OSB LAB AREA RECEPTACLE & POWER PLAN	NONE	PPI 50969	8094
SHEET NUMBER		REVISIONS	
<b>LA-E-106</b>		2	

This document and the design it covers are the property of PARSONS. They are loaned only with the borrower's expressed written agreement that they will not be reproduced, copied, loaned, exhibited, or used in any other way, except by written consent from PARSONS to the borrower.