

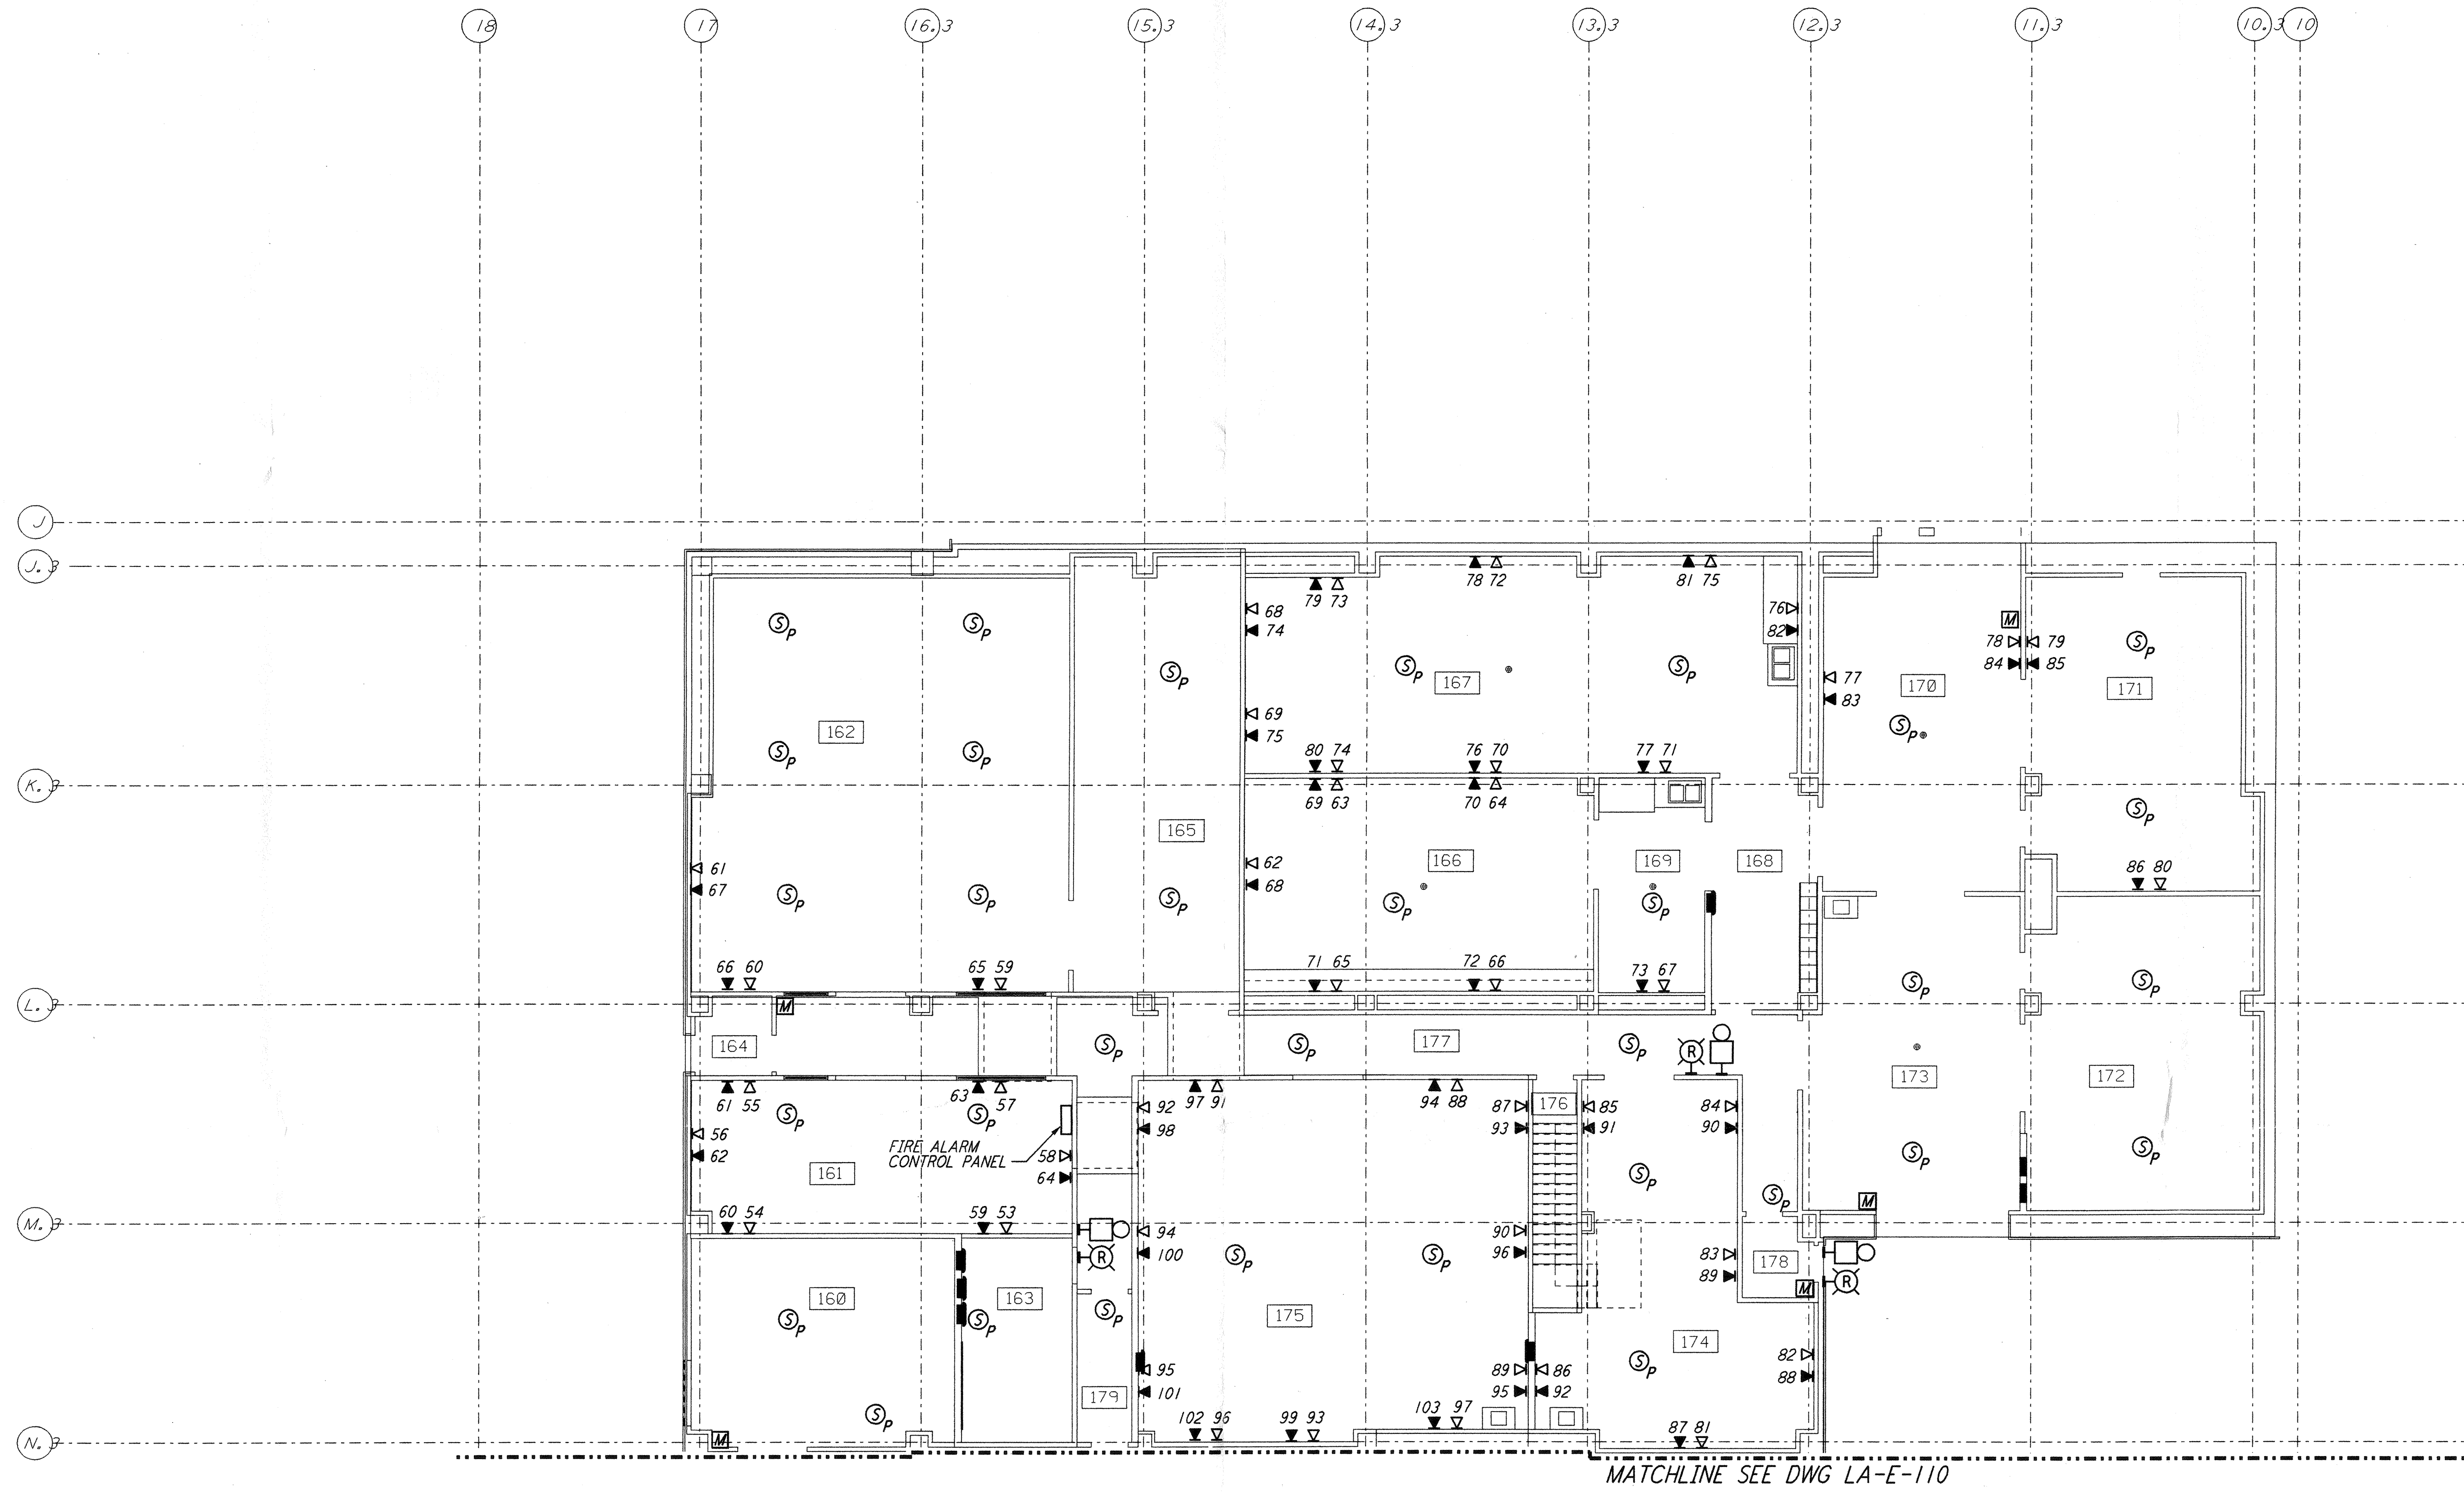


- NOTES:**
- FOR PLAN SYMBOLS SEE DWG LA-E-002.
 - WIRING FOR FIRE DETECTION SHALL BE CLASS "A". FOR FIRE ALARM DEVICES SHALL BE CLASS "B". WIRING INSTALLED IN CONCEALED CONDUIT FOR FIRE DETECTION AND SECURITY SYSTEMS SHALL BE DONE BY OTHERS.
 - DUCT MOUNTED SMOKE DETECTORS SHALL BE PROVIDED WITH AN AUXILIARY RELAY CONTACT (N.C.) FOR EQUIPMENT SHUT-DOWN.
 - COORDINATE SMOKE DETECTOR LOCATIONS WITH CLEAN AGENT DISCHARGE NOZZLES.
 - COORDINATE AHU LOCATIONS WITH DUCT MOUNTED SMOKE DETECTORS.

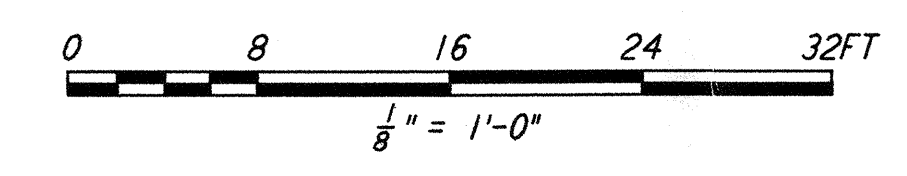

MATCHLINE SEE DWG LA-E-110

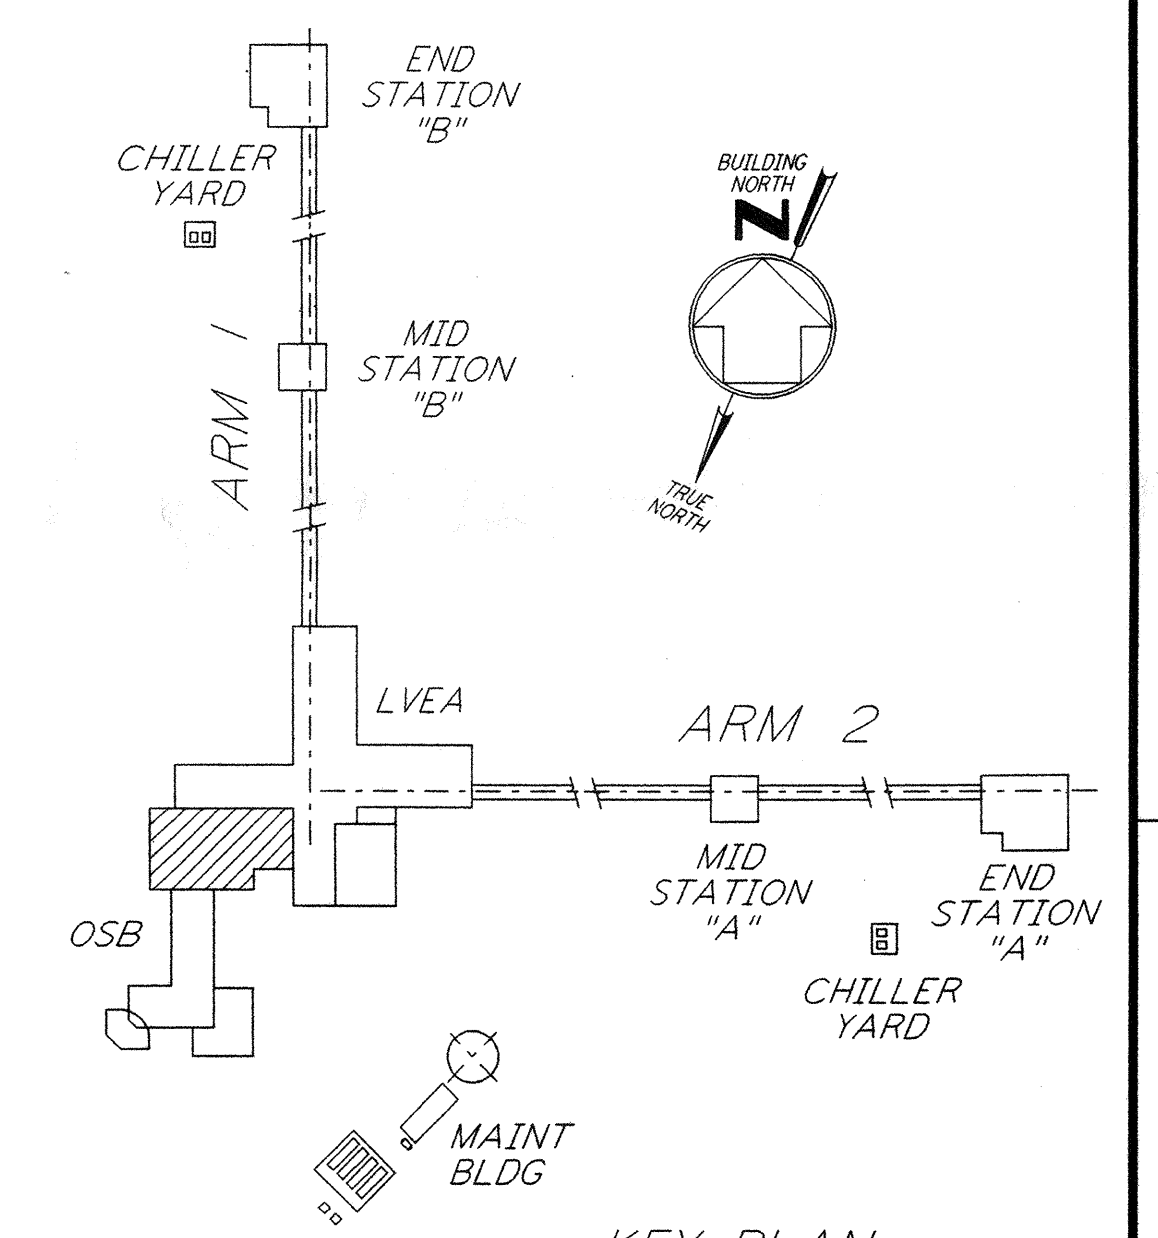

This document and the design it covers are the property of PARSONS. They are loaned only with the borrower's expressed written agreement that they will not be reproduced, copied, loaned, exhibited, or used in any other way, except by written consent from PARSONS to the borrower.

REFERENCES		ISSUED FOR CONSTRUCTION	
DRAWING NO.	DESCRIPTION	DRAWN	M. M. 11-15-96
		CHECKED	J. C. L. 7-24-96
		ENGINEER	K. C. R. 10-25-96
		PROJ	T. D. M. 11-15-96
REVISIONS		AS-BUILT DRAWINGS	
NO.	DATE	BY	CHKD
2	8-7-98	JE	RKC
1	2-28-97	J. G.	RDC
			KCR
			T. D. M.
DESCRIPTION		GENERAL REVISIONS	
		ISSUED FOR AS-BUILT	

PARSONS
 100 WEST WALNUT STREET
 PASADENA, CALIFORNIA

LIGO
 CALIFORNIA INSTITUTE OF TECHNOLOGY
 MASSACHUSETTS INSTITUTE OF TECHNOLOGY

**LASER INTERFEROMETER
 GRAVITATIONAL-WAVE OBSERVATORY
 SITE NO. 2 - LIVINGSTON, LOUISIANA**

**ELECTRICAL
 CORNER STATION
 OSB LAB AREA FIRE DET
 & SECURITY PLAN**

SCALE: NONE
 CONTRACT NUMBER: PPI50969
 PROJECT NUMBER: 8094

LA-E-111