



This document and the design it covers are the property of PARSONS. They are loaned only with the borrower's expressed written agreement that they will not be reproduced, copied, loaned, exhibited, or used in any other way, except by written consent from PARSONS to the borrower.

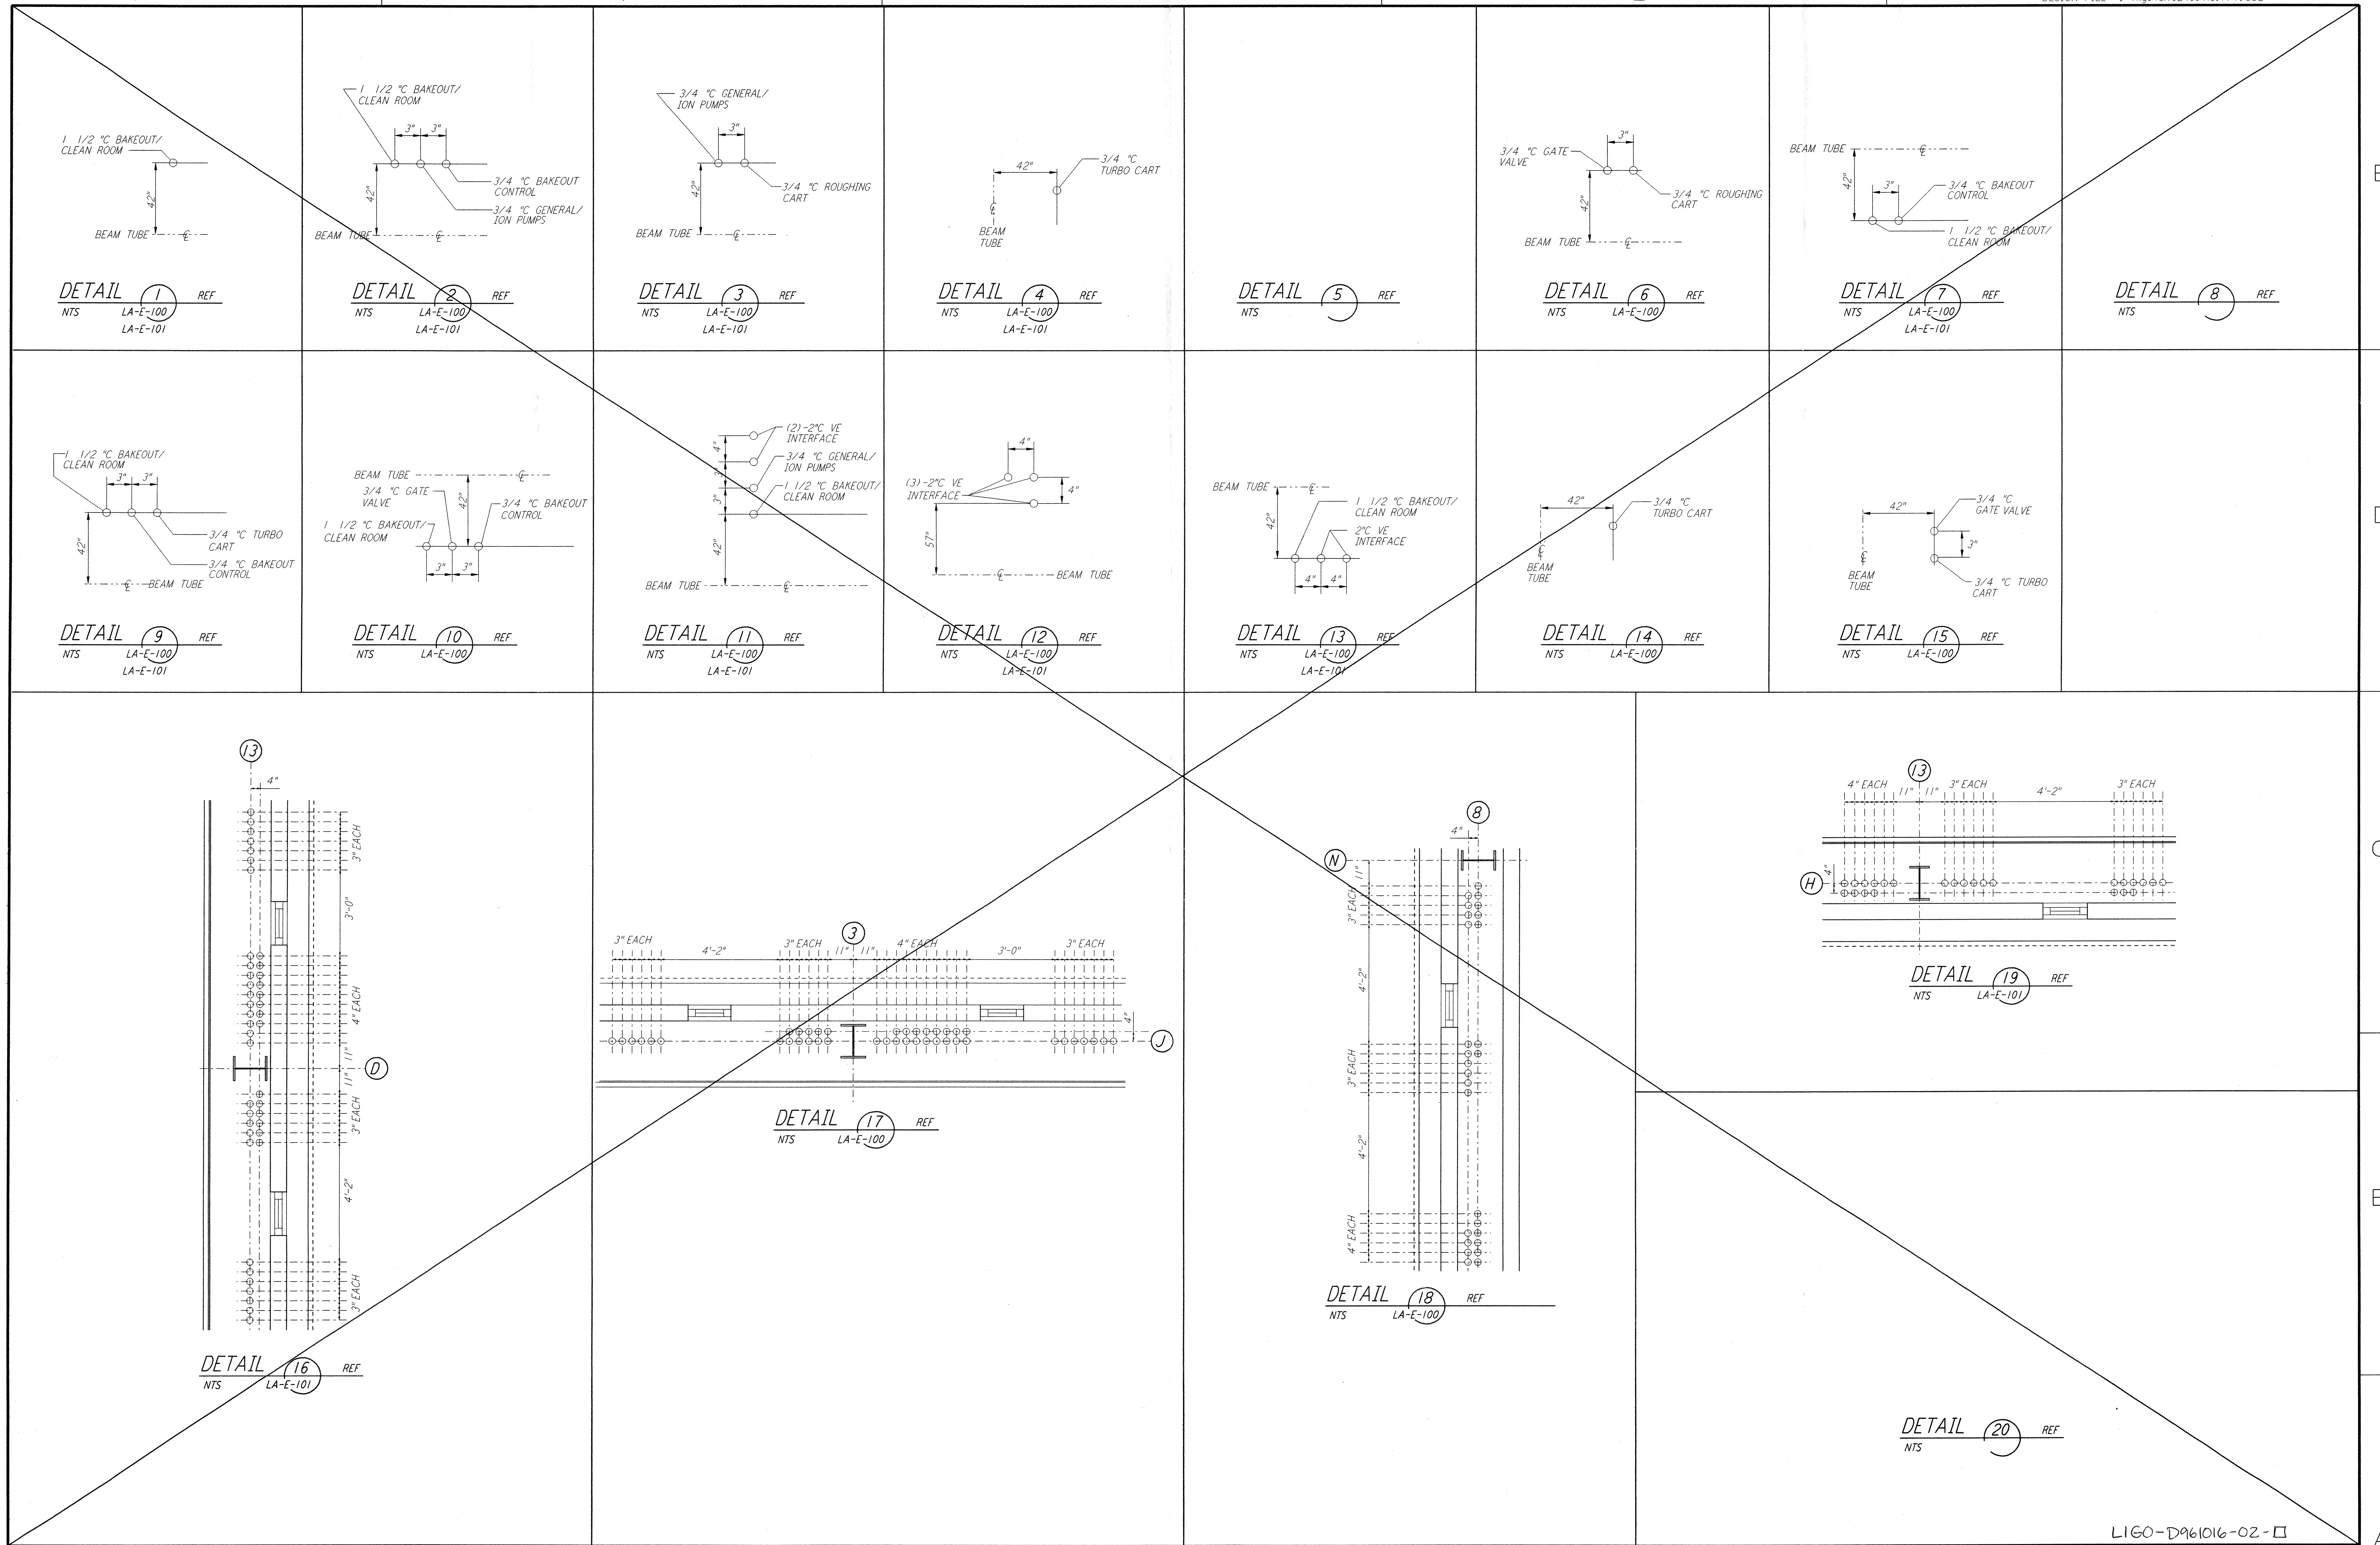

LIGO-D96106-02-□

NO.	DATE	BY	CHKD	ENGR	PROJ	DESCRIPTION
2	8-7-98	JE	BK	MD		ISSUED FOR AS-BUILT
1	3-21-97	J.G.	BK	KCR	F.D.M.	ISSUED FOR DELETE

▲ ISSUED FOR CONSTRUCTION
 DRAWN M. M. 11-15-96
 CHECKED J. C. L. 7-24-96
 ENGINEER K. C. P. 10-25-96
 PROJ 7. D. M. 11-15-96
AS-BUILT DRAWINGS


PARSONS
 100 WEST WALNUT STREET
 PASADENA, CALIFORNIA


LIGO
 CALIFORNIA INSTITUTE OF TECHNOLOGY
 MASSACHUSETTS INSTITUTE OF TECHNOLOGY

LASER INTERFEROMETER
 GRAVITATIONAL-WAVE OBSERVATORY
 SITE NO. 2 - LIVINGSTON, LOUISIANA
 TITLE: ELECTRICAL CORNER STATION
 LVEA AREAS 101, 102, 103, 104
 DETAILS
 SCALE: NONE
 CONTRACT NUMBER: PPI50969
 PROJECT NUMBER: 8094
 SHEET NUMBER: **LA-E-114**
 REVISIONS: 