



This document and the design it covers are the property of PARSONS. They are loaned only with the borrower's expressed written agreement that they will not be reproduced, copied, loaned, exhibited, or used in any other way, except by written consent from PARSONS to the borrower.

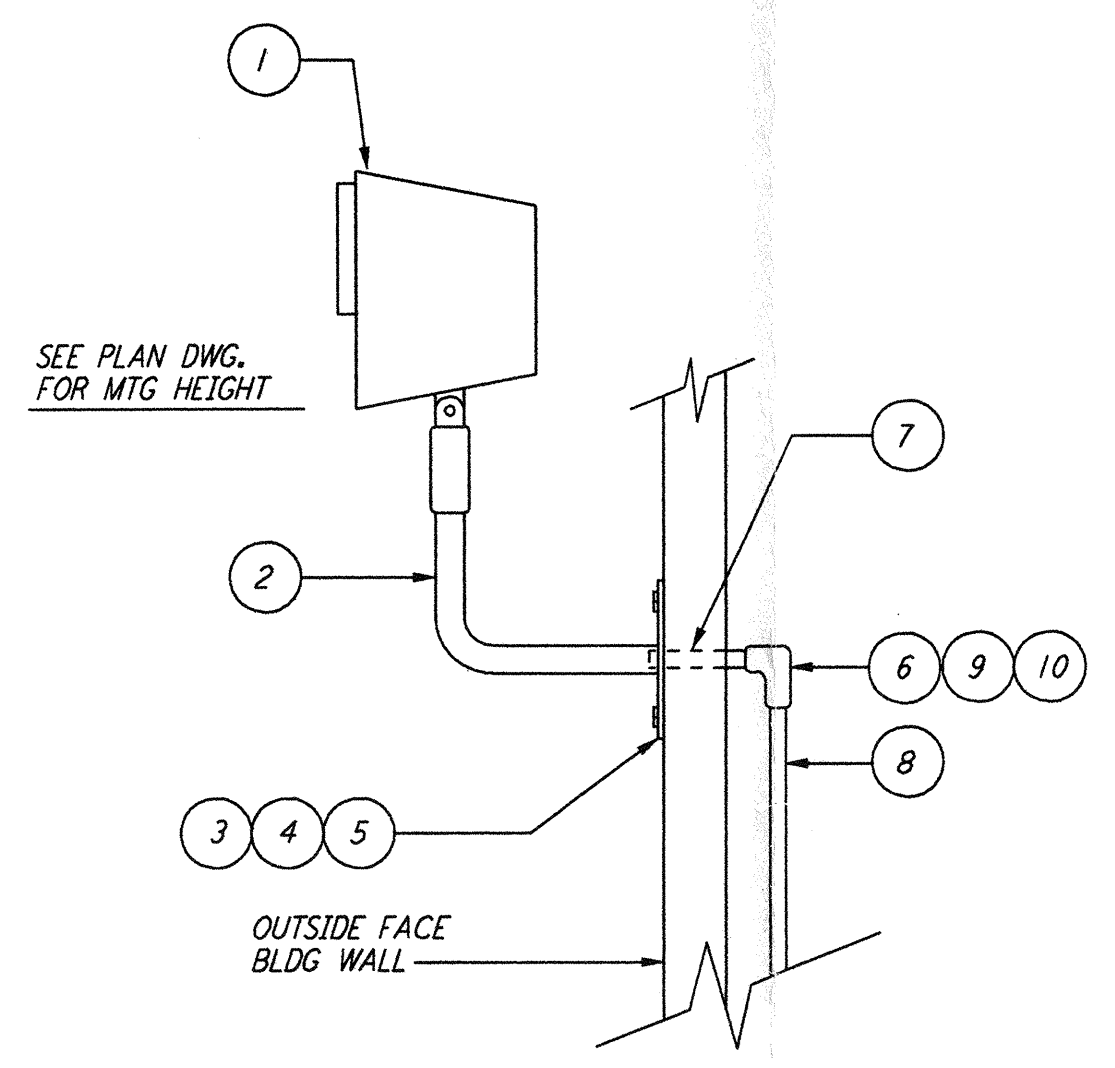


LIST OF MATERIAL		
ITEM NO.	QTY.	DESCRIPTION
1	1	LIGHTING FIXTURE-TYPE AS SPECIFIED ON PLAN
2	1	WALL MTG BRACKET FOR FLD LIGHT
3	4	BOLT HEX HEAD, 3/8"-16 X 1 1/2" LG GALV.
4	4	ANCHOR MASONARY 3/8"-16
5	4	LOCKWASHER SPRING 3/8" BOLT SST
6	1	CONDUIT FITTING 3/4"
7	AR	CONDUIT 3/4" RIGID STEEL GALV
8	AR	CONDUIT 3/4" RIGID STEEL GALV
9	1	CONDUIT FITTING COVER, CAST 3/4"
10	1	CONDUIT FITTING COVER GASKET, NEOPRENE, 3/4"

FLOODLIGHT MOUNTING DETAIL (2) REF
 N. T. S.

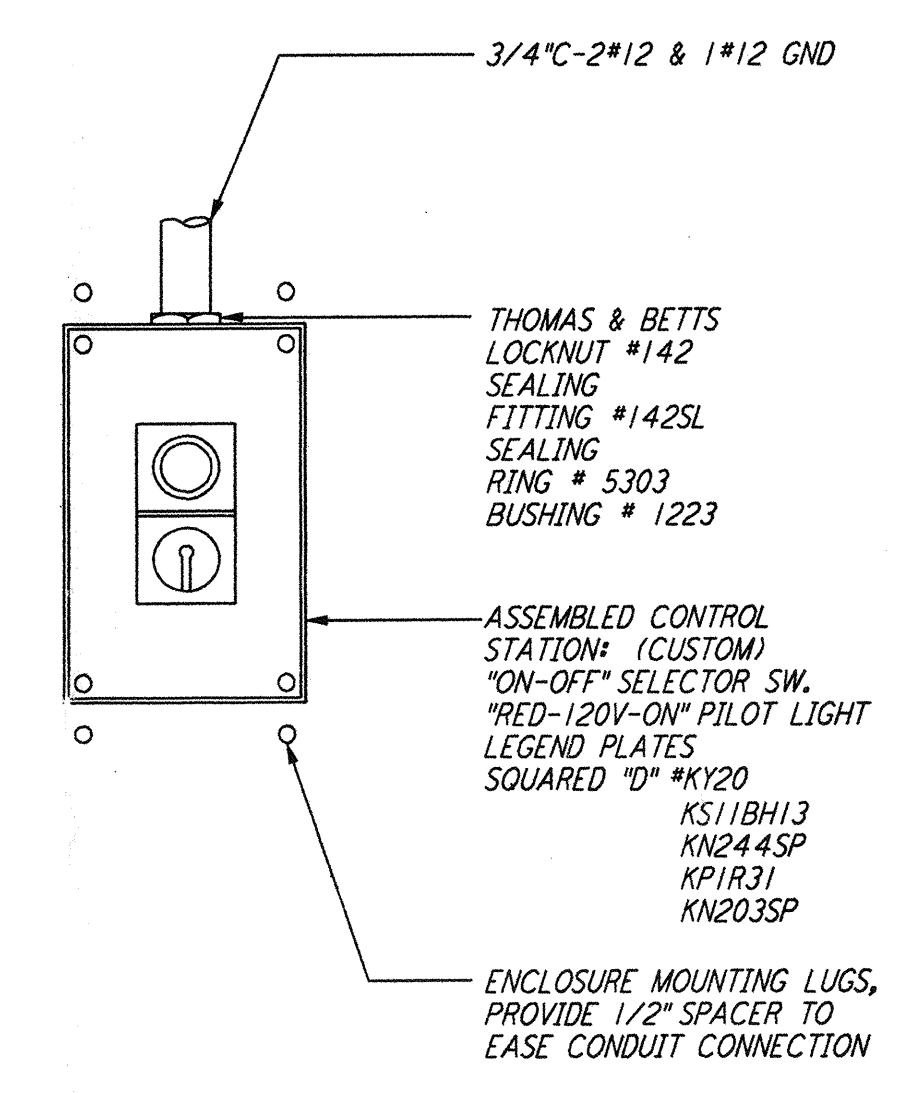


DETAIL (3) REF
 N. T. S.

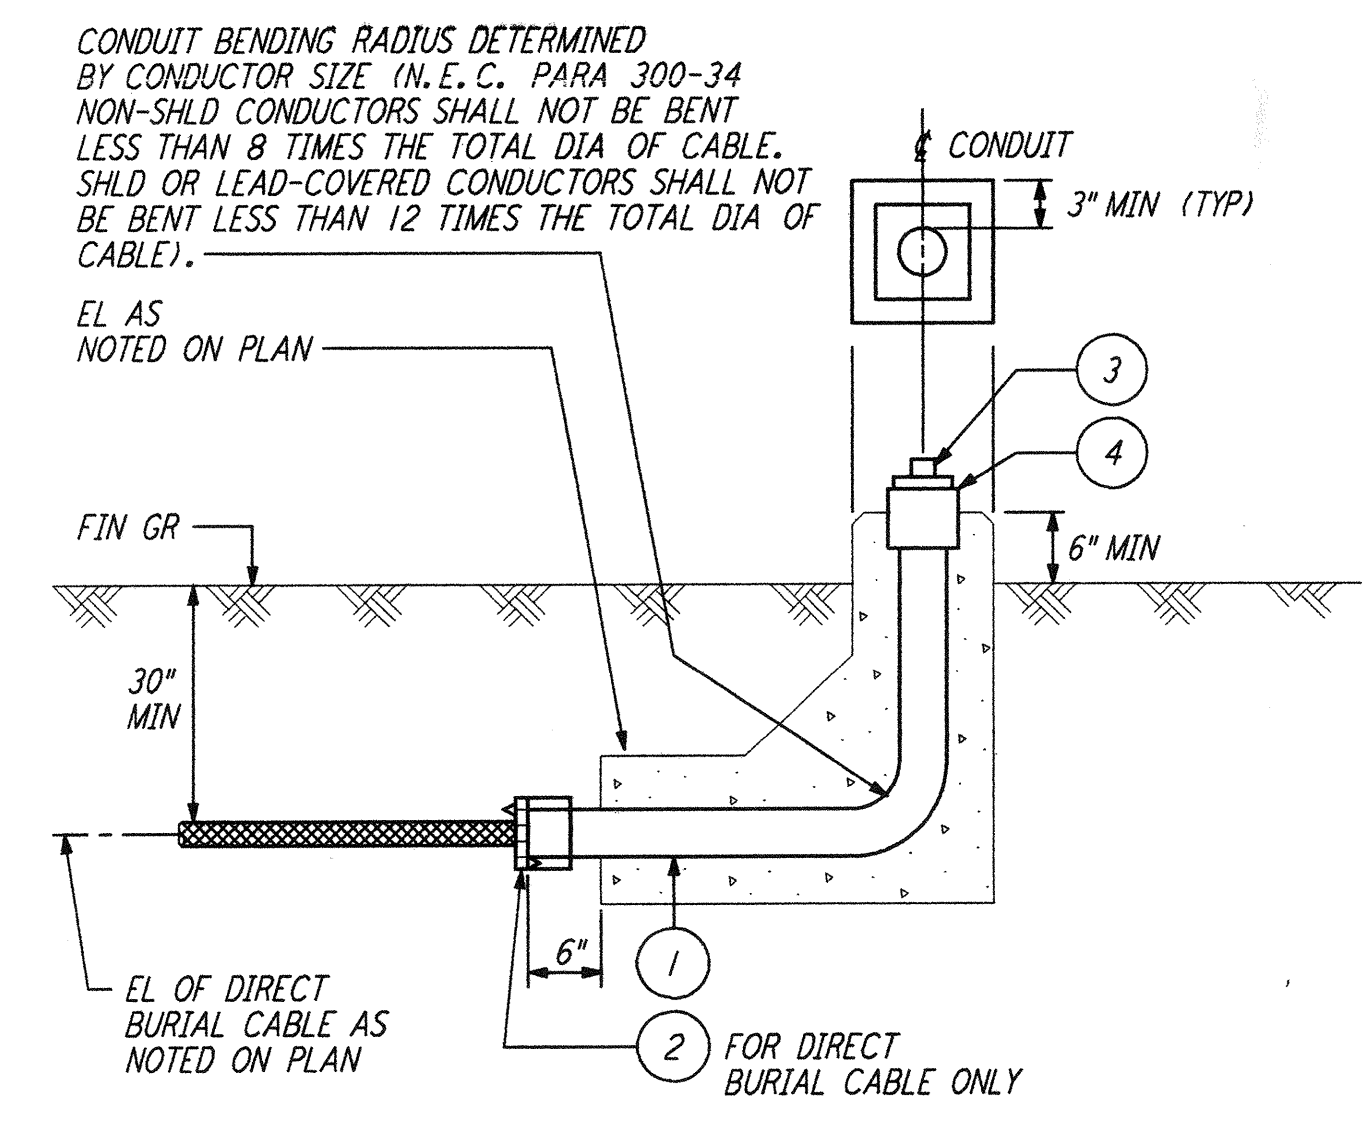

LIST OF MATERIAL		
ITEM NO.	QTY	DESCRIPTION
1	AR	CONDUIT, RIGID GALVANIZED STEEL, SIZE PER PLAN
2	1	CONDUIT BUSHING, NON-INSULATED GALV, PER CONDUIT SIZE
3	1	PLUG, SO HD RIGID AL, PER CONDUIT SIZE
4	1	CONDUIT COUPLING, RIGID GALVANIZED STEEL, PER CONDUIT SIZE

CONDUIT STUB-UP (4) REF
 N. T. S.

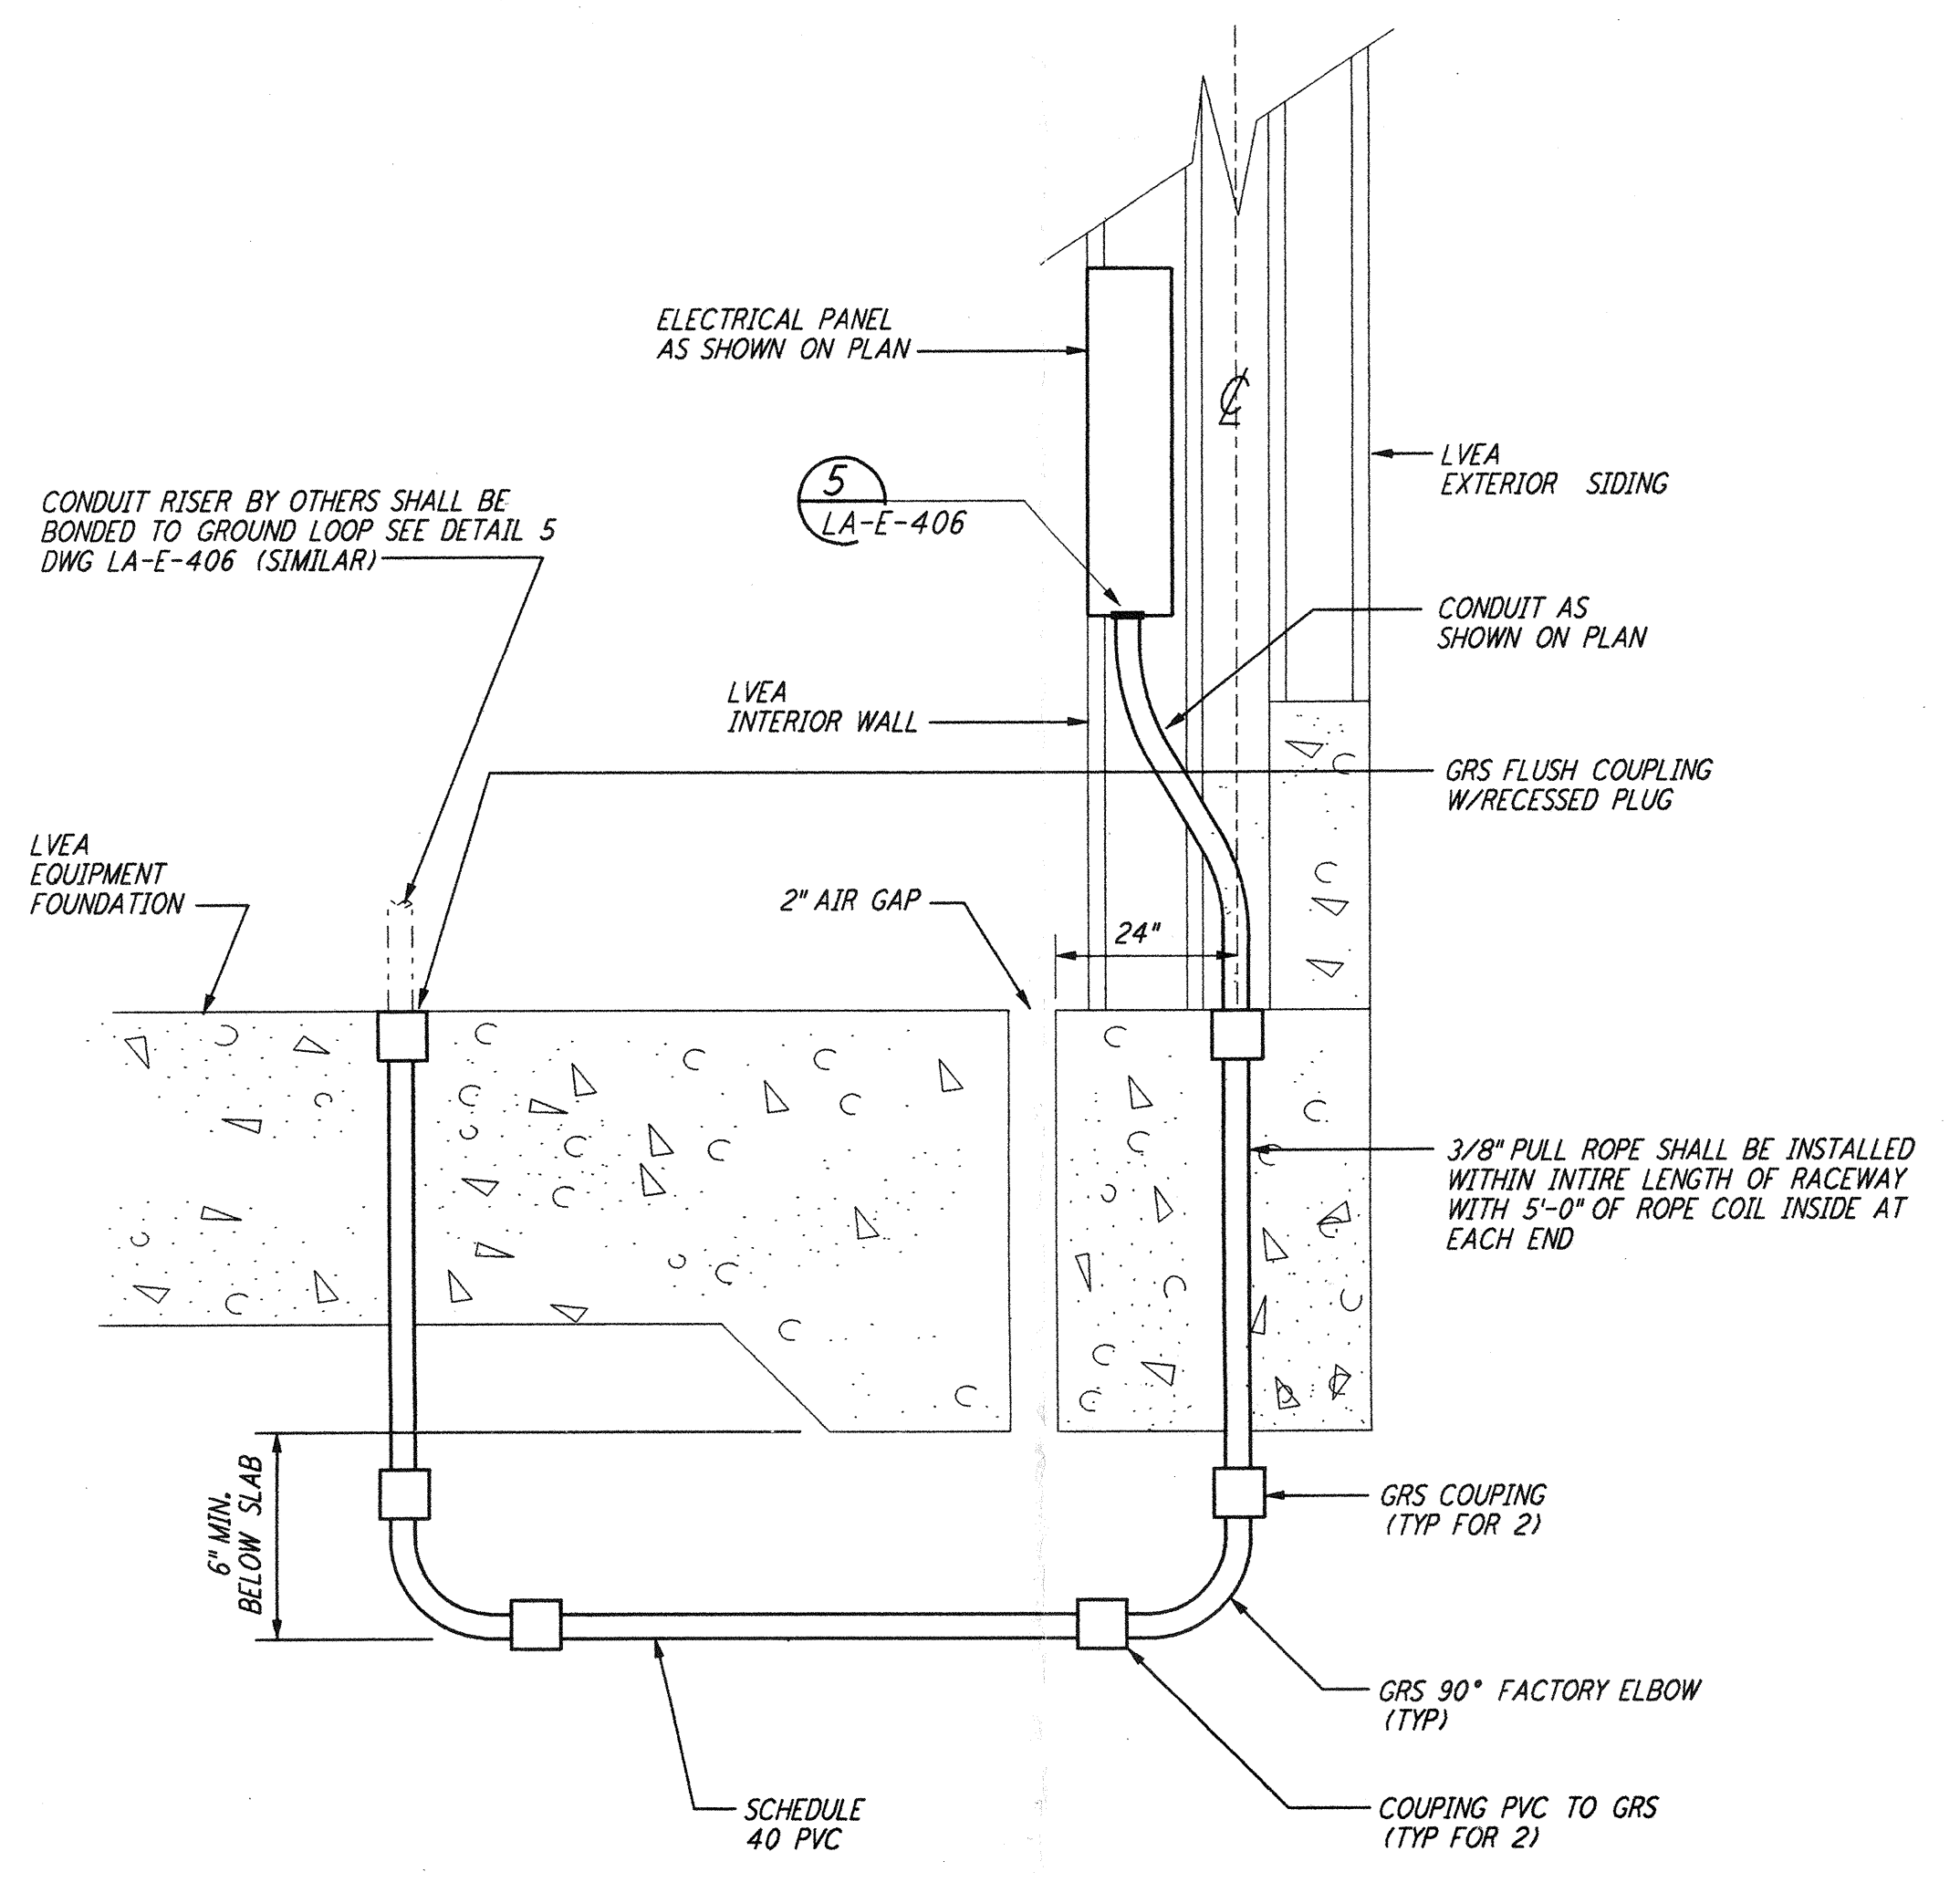

LVEA CONDUIT FLOOR RISER (5) REF
 N. T. S.

DRAWING NO.	DESCRIPTION	REVISIONS				
		NO.	DATE	BY	CHKD	ENGR
		1	8-7-98	JE	CHK	ENR

ISSUED FOR CONSTRUCTION			
DRAWN	M. M.	11-15-96	
CHECKED	JCL	7-24-96	
ENGINEER	KCR	10-25-96	
PROJ	T. D. M.	11-15-96	

AS-BUILT DRAWINGS

PARSONS
 100 WEST WALNUT STREET
 PASADENA, CALIFORNIA

LIGO
 CALIFORNIA INSTITUTE OF TECHNOLOGY
 MASSACHUSETTS INSTITUTE OF TECHNOLOGY

LIGO-D961045-01-O

LASER INTERFEROMETER
 GRAVITATIONAL-WAVE OBSERVATORY
 SITE NO. 2 - LIVINGSTON, LOUISIANA

TITLE	SCALE	CONTRACT NUMBER	PROJECT NUMBER
	NONE	PP150969	8094
ELECTRICAL SECTIONS AND DETAILS		REVISIONS	
SHEET NUMBER		LA-E-409	