



This document and the design it covers are the property of PARSONS. They are loaned only with the borrower's expressed written agreement that they will not be reproduced, copied, loaned, exhibited, or used in any other way, except by written consent from PARSONS to the borrower.

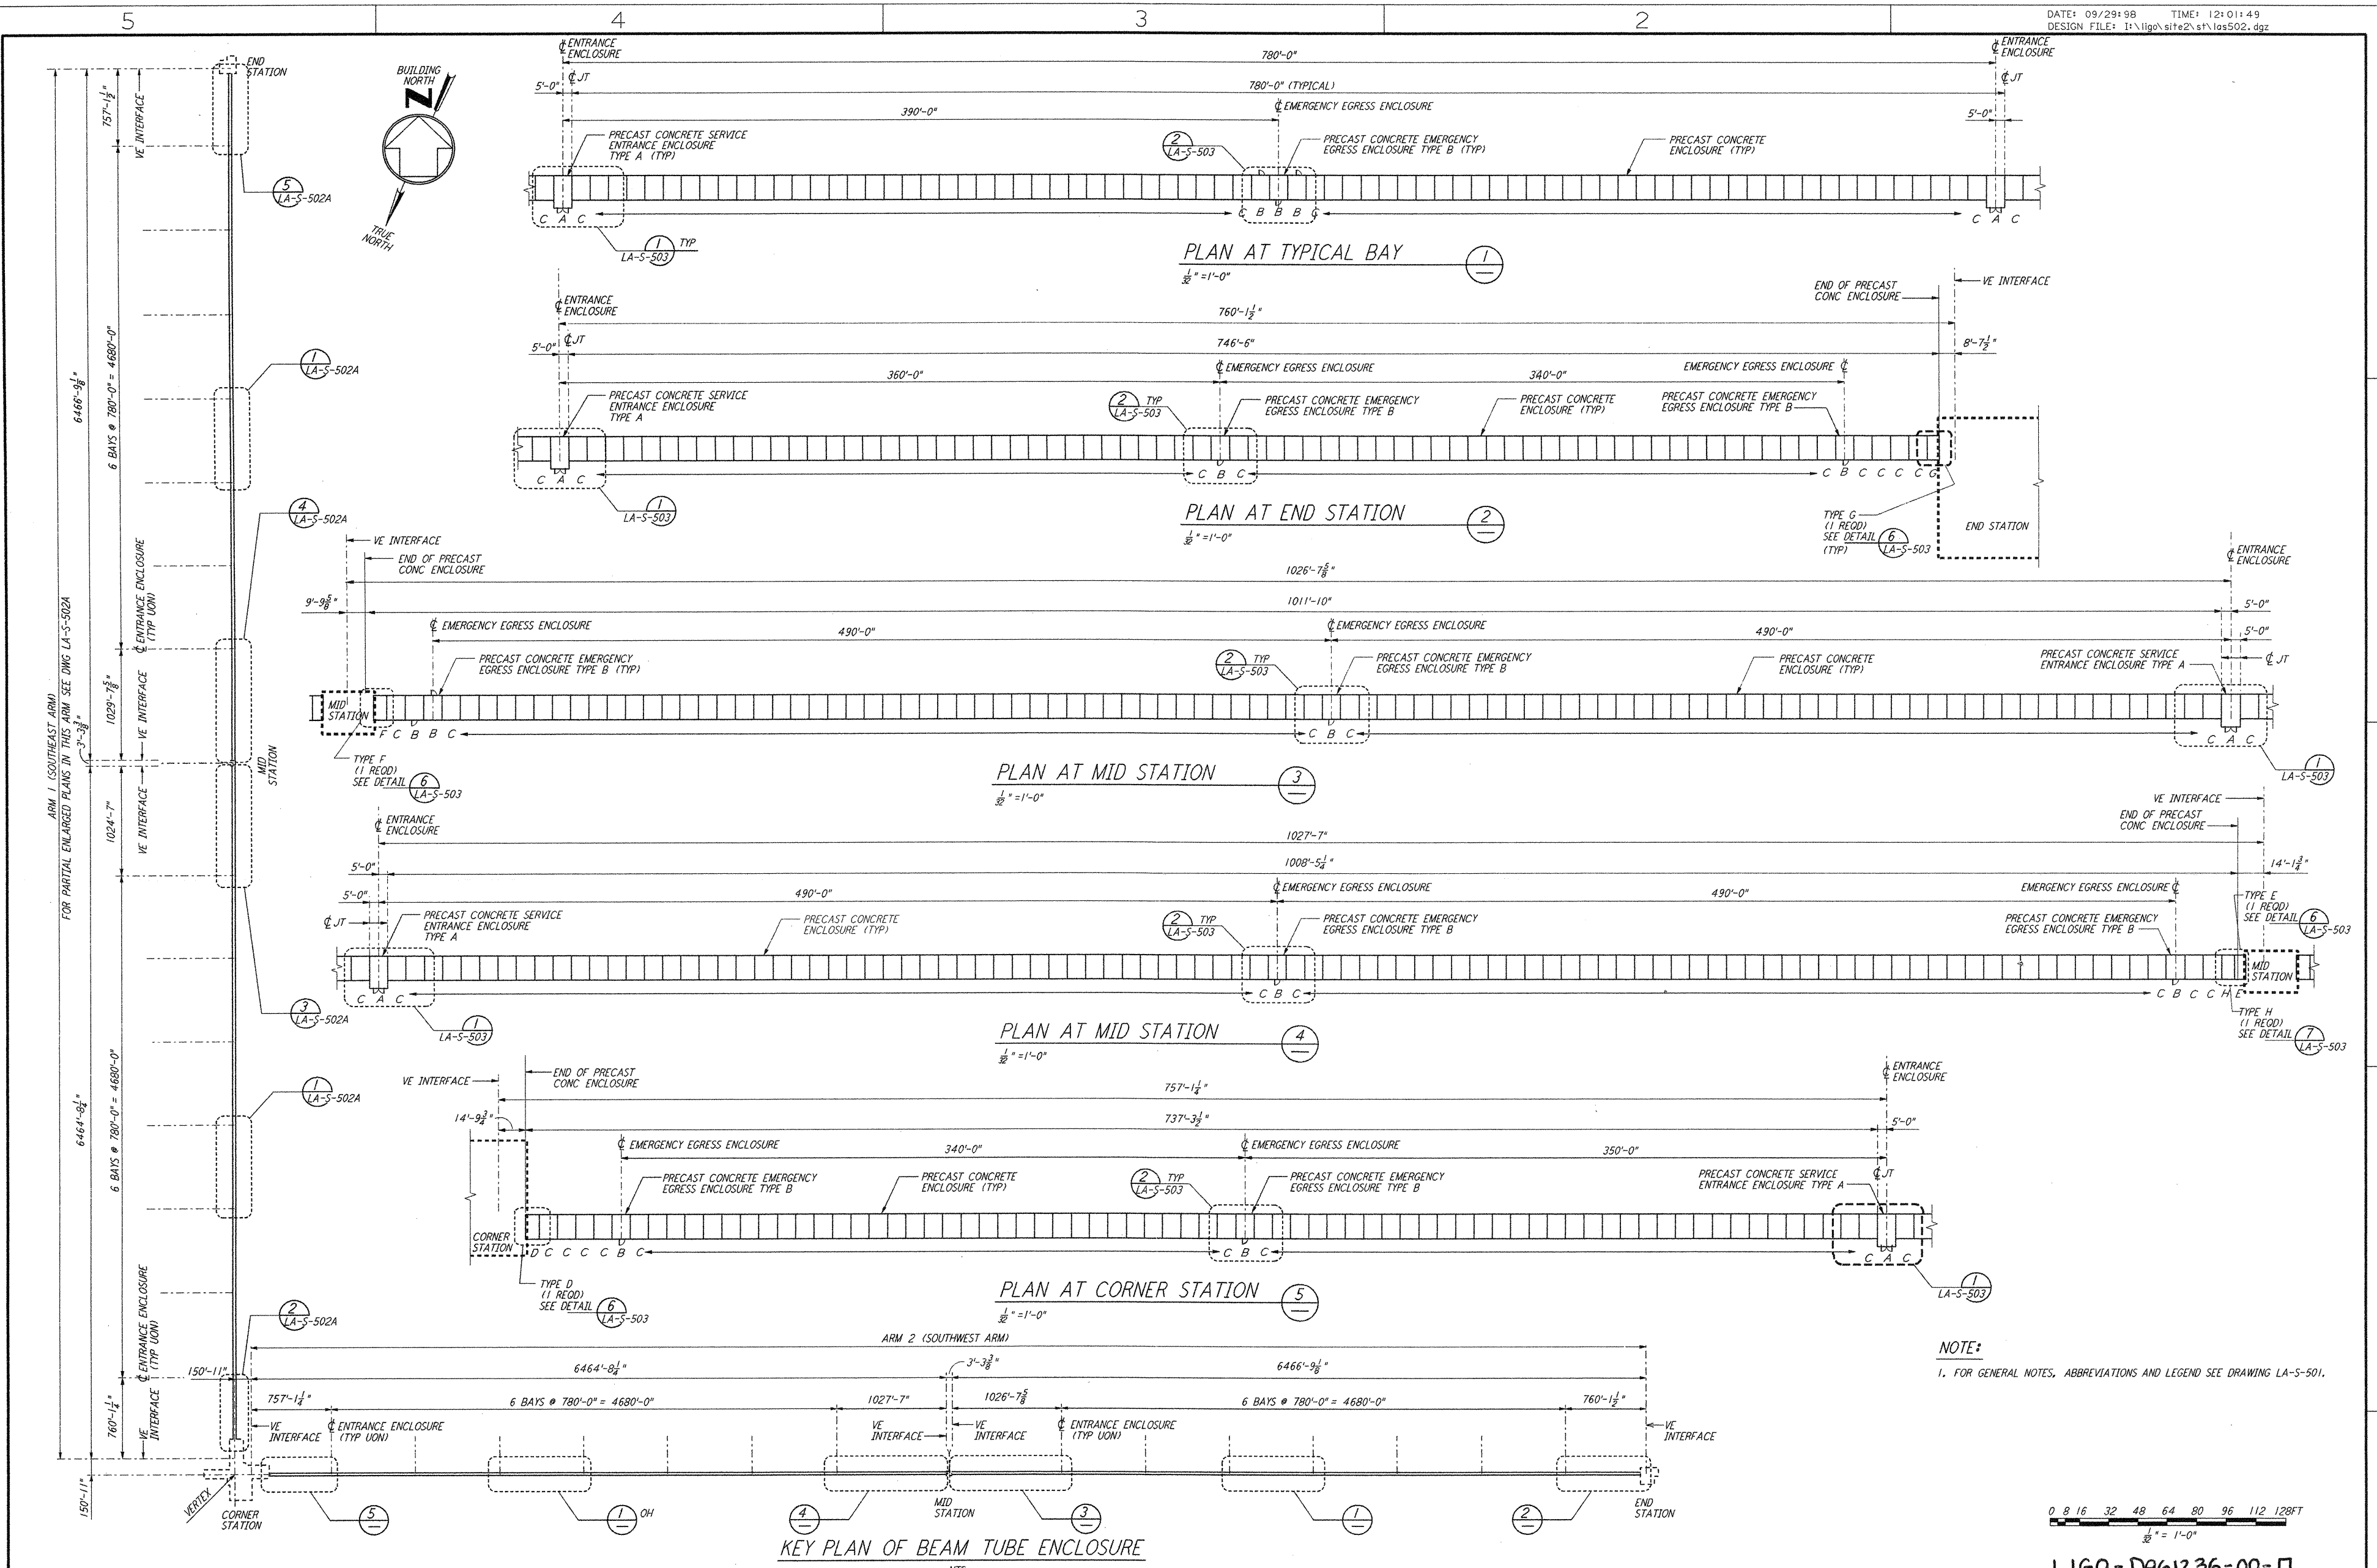

NOTE:
 1. FOR GENERAL NOTES, ABBREVIATIONS AND LEGEND SEE DRAWING LA-S-501.

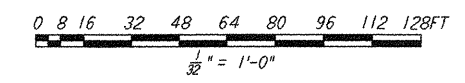

LIGO-D961236-00-D

NO.	DATE	BY	CHKD	ENGR	PROJ	DESCRIPTION
2	9-25-98	JD	BP	BP	WDM	ISSUED FOR AS BUILT
1	2-28-97	GP	ZDM	GP	ZDM	REV DIMENSIONS & ENCLOSURE TYPES

ISSUED FOR CONSTRUCTION		
DRAWN	MCS	11-15-96
CHECKED	DDM	11-15-96
ENGINEER	BP	11-15-96
PROJ	TDM	11-15-96

PARSONS
 100 WEST WALNUT STREET
 PASADENA, CALIFORNIA

LIGO
 CALIFORNIA INSTITUTE OF TECHNOLOGY
 MASSACHUSETTS INSTITUTE OF TECHNOLOGY

LASER INTERFEROMETER
 GRAVITATIONAL-WAVE OBSERVATORY
BEAM TUBE ENCLOSURE - LIVINGSTON, LA

SCALE: AS NOTED
 PROJECT NUMBER: PPI50969
 SHEET NUMBER: 8094
LA-S-502