


This document and the design it covers are the property of PARSONS. They are loaned only with the borrower's expressed written agreement that they will not be reproduced, copied, loaned, exhibited, or used in any other way, except by written consent from PARSONS to the borrower.

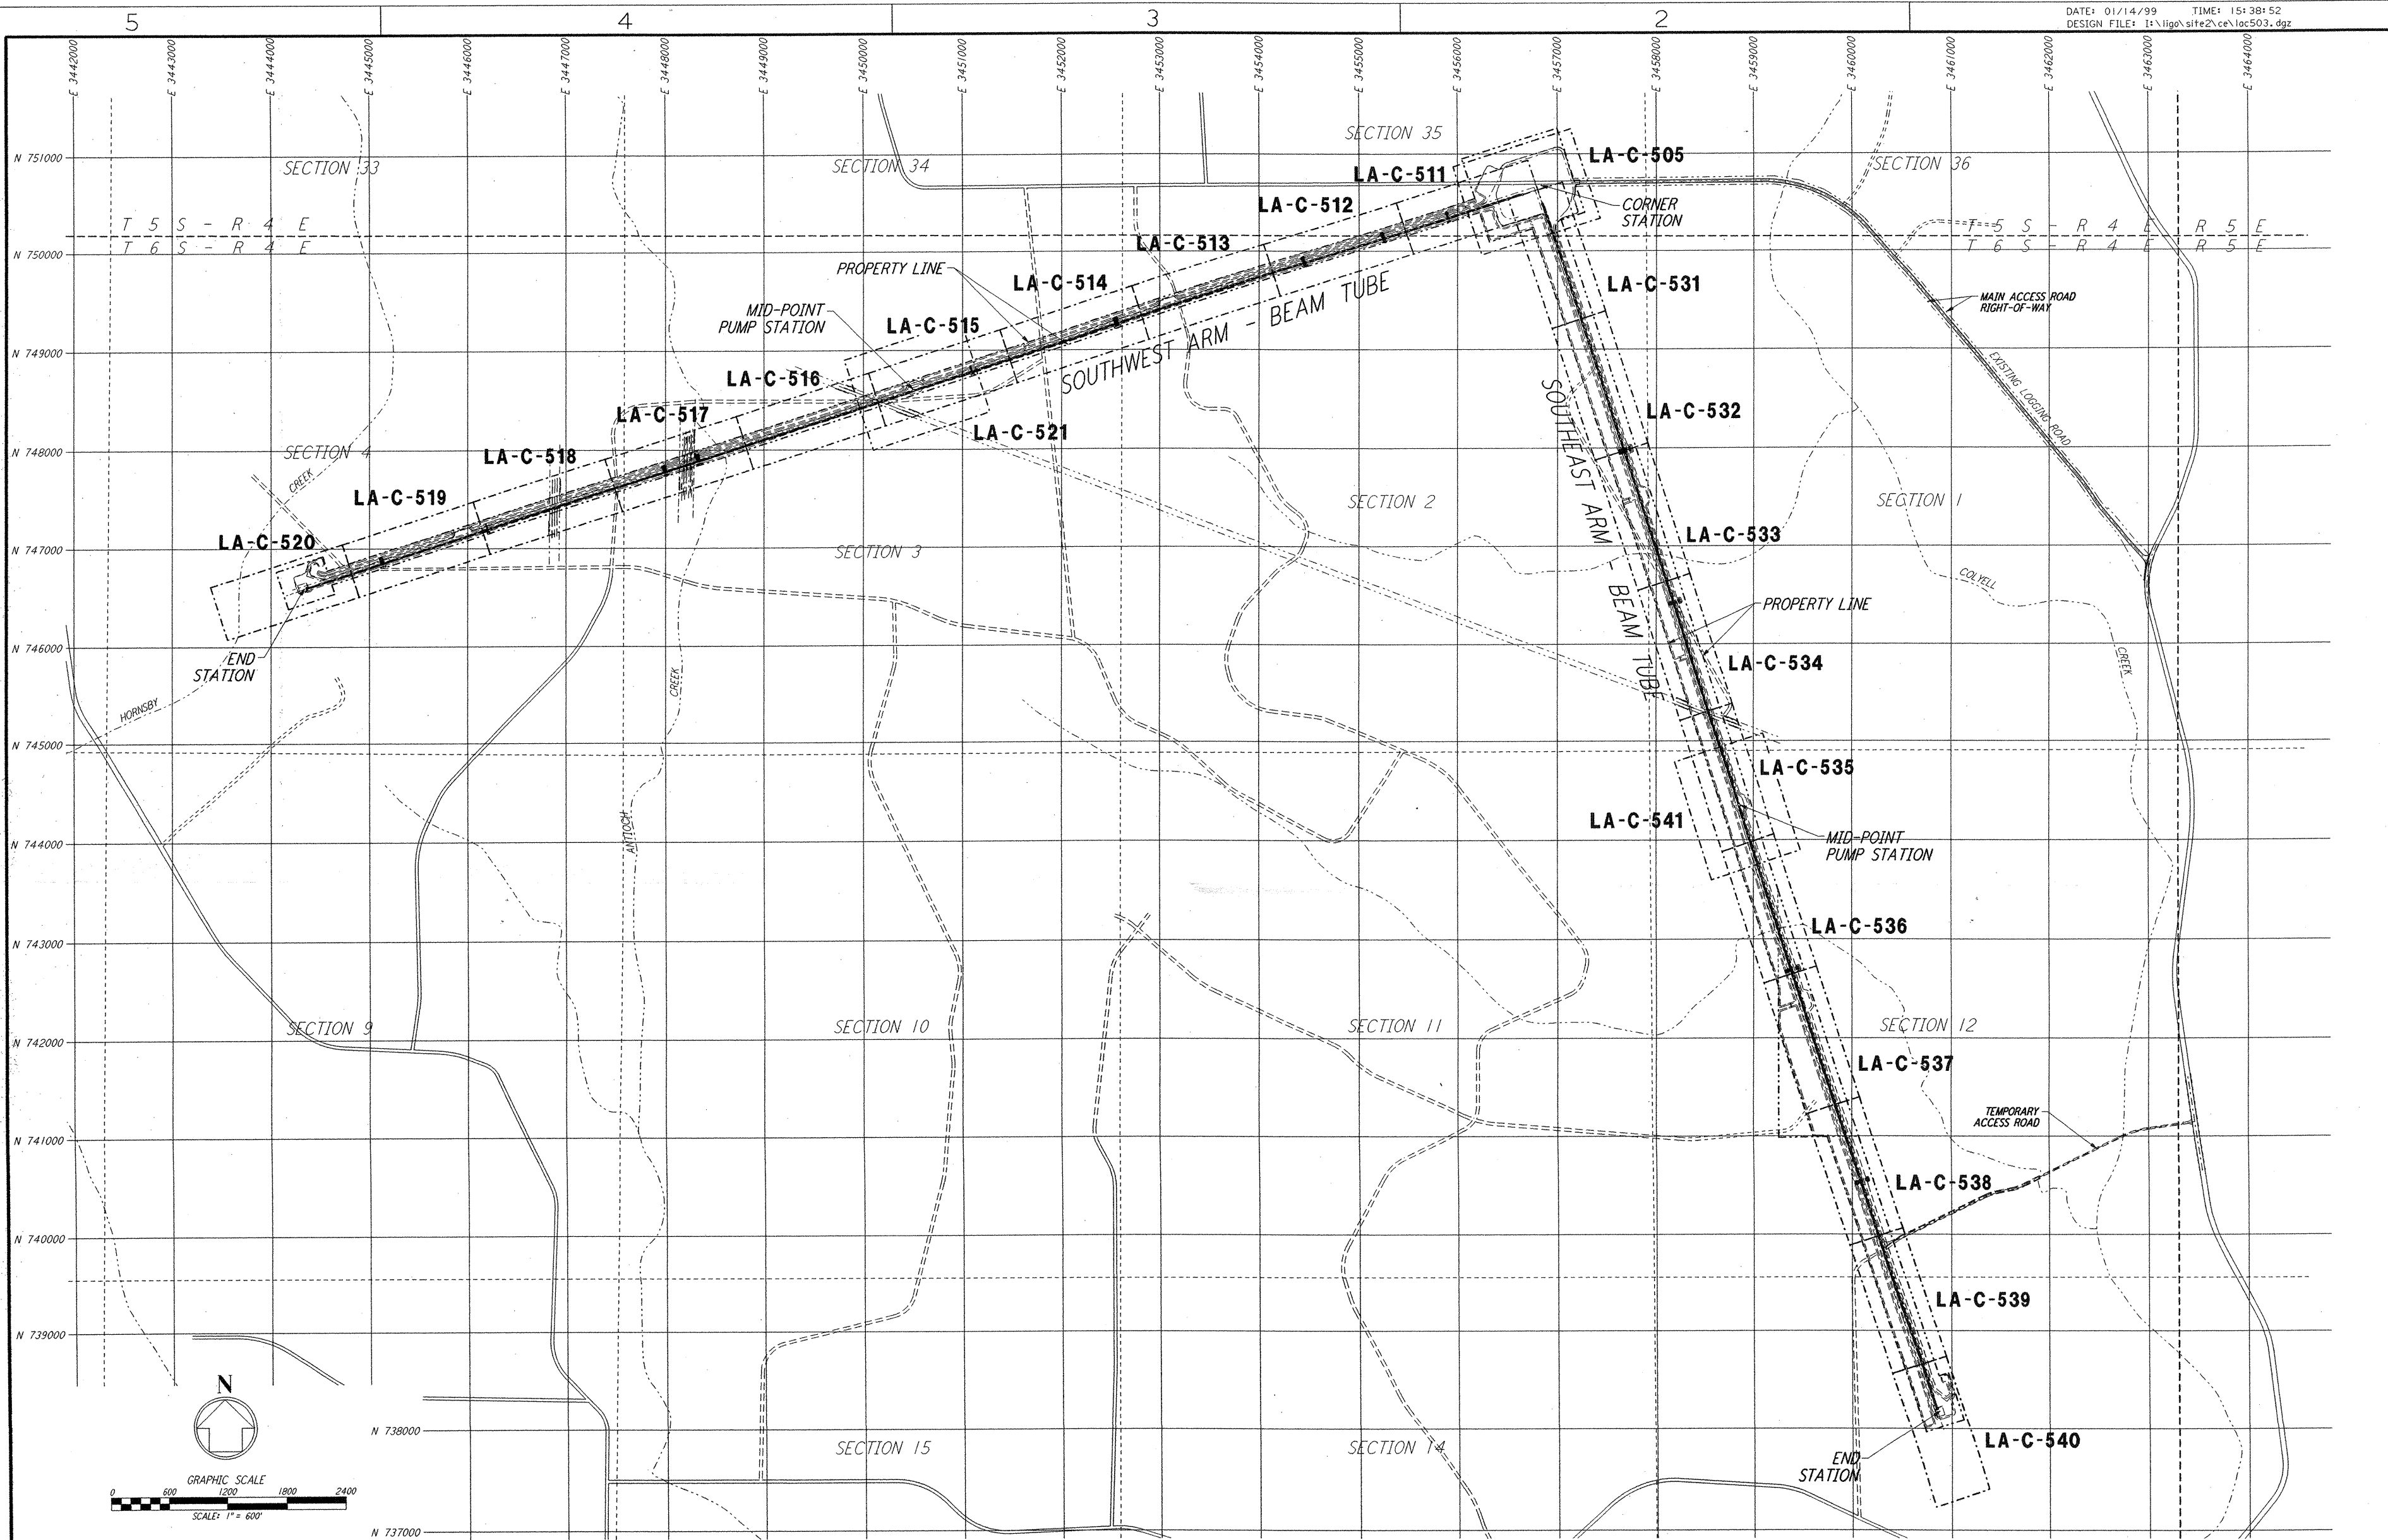

LIGO-D961260-01-O

NO.	DATE	BY	CHKD	ENGR	PROJ	DESCRIPTION
1	1-15-99	MEJ	--	--	MDW	ISSUED FOR AB BUILT

ISSUED FOR CONSTRUCTION
 DRAWN WRB 11-15-96
 CHECKED
 ENGINEER
 PROJ

AS-BUILT DRAWINGS

PARSONS
 100 WEST WALNUT STREET
 PASADENA, CALIFORNIA

LIGO
 CALIFORNIA INSTITUTE OF TECHNOLOGY
 MASSACHUSETTS INSTITUTE OF TECHNOLOGY

LASER INTERFEROMETER GRAVITATIONAL-WAVE OBSERVATORY BEAM TUBE ENCLOSURE - LIVINGSTON, LA		SCALE: 1" = 600'	PROJECT NUMBER: PPI50969	8094
CIVIL DRAWING MATRIX		SHEET NUMBER: LA-C-503		REVISIONS

The Jan 14 1999 15:38:52 C:\PLOT\QUE\53\3662\LOC503.DWG 52685 K:\V\BRO\ce\4963a.prf LIGOLF3.BOR