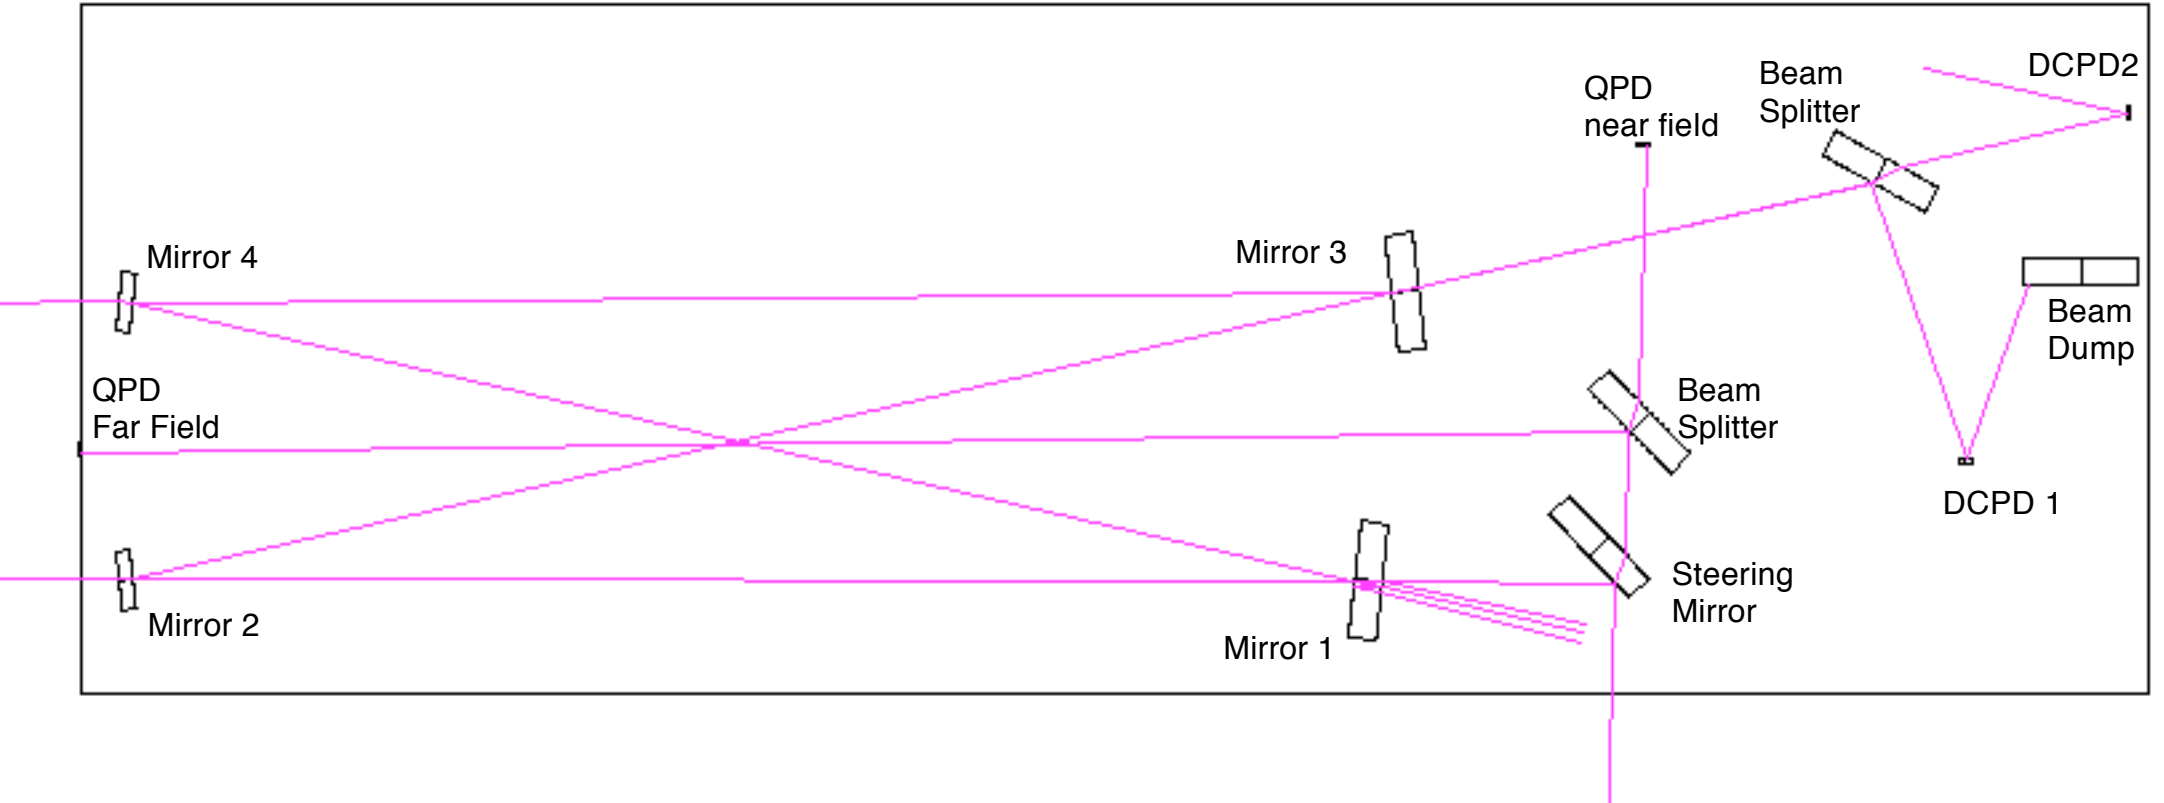
QPD
near field
Beam
Splitter
DCPD2
Mirror 4
Mirror 3
Beam
Dump
QPD
Far Field
Beam
Splitter
DCPD 1
Steering
Mirror
Mirror 2
Mirror 1