

- (A) SUB-MODULE CONSISTING OF THE FOLLOWING:
- 6 (4-A) BEAM ASSEMBLY W/EXPANSION JOINT
 - 5 (4-B) BEAM ASSEMBLY
 - 1 (4-C) BEAM ASSEMBLY W/VACUUM PORT
 - 6 - FIXED SUPPORT (DWG # 6, 7, & 8)
 - 6 - GUIDED SUPPORT (DWG # 17, 18, & 19)



APPROVED

M. Jellison 11/10/95
CBI DATE

J. Jones 11/10/95
CALIEN DATE

Date Received:	LIGO-D950032-02-B
11/10/95	Contractor #: CBI 2, Rev. 2
TIM #: 25	LIGO-C960675-00-V
Date: 3/29/96	Approved: <i>J.K.</i>
TDM #:	LIGO-
Date: / /	Approved:
Gen'l Transmittal	LIGO-
Date: / /	Approved:

- (D) SUB-MODULE CONSISTING OF THE FOLLOWING:
- 7 (4-A) BEAM ASSEMBLY W/EXPANSION JOINT
 - 7 (4-B) BEAM ASSEMBLY
 - 7 - FIXED SUPPORT (DWG # 6, 7, & 8)
 - 7 - GUIDED SUPPORT (DWG # 17, 18, & 19)

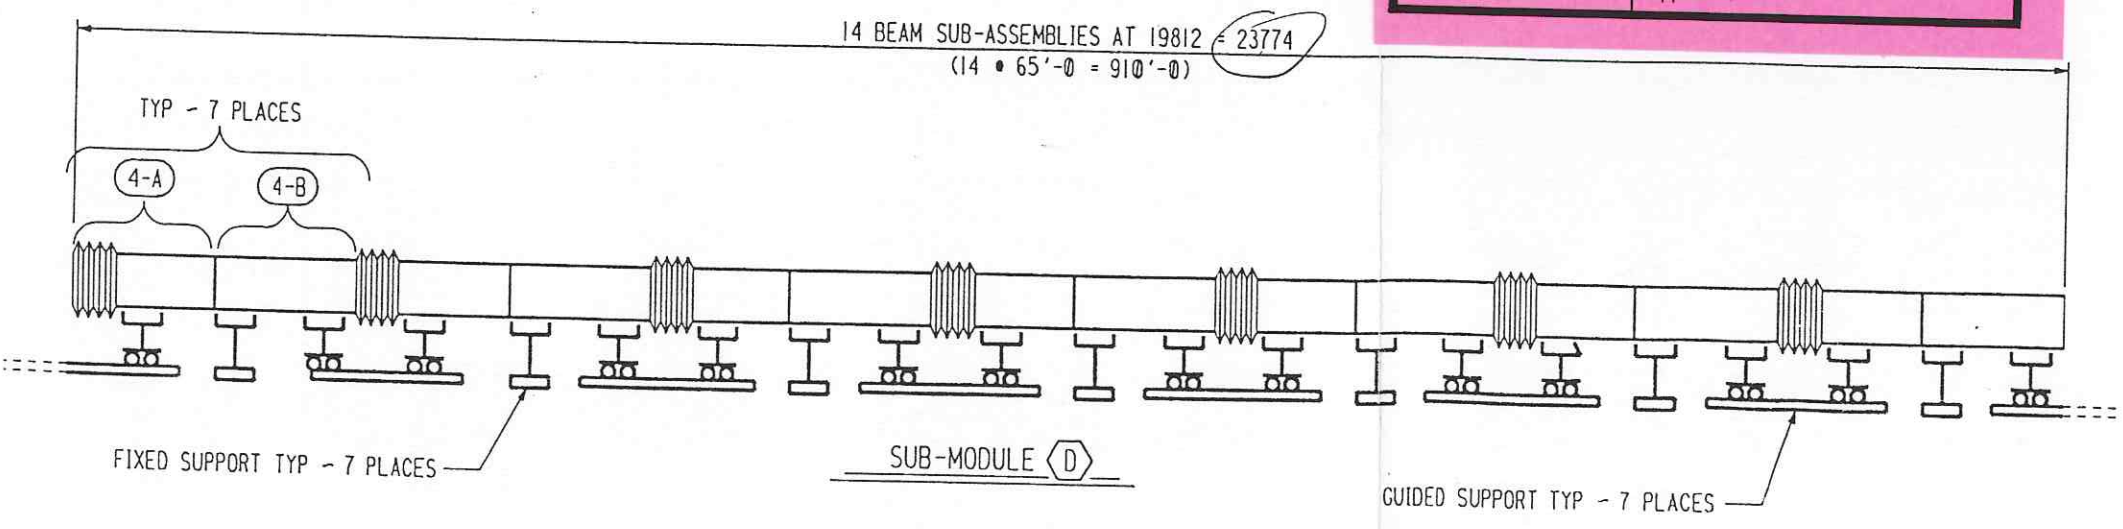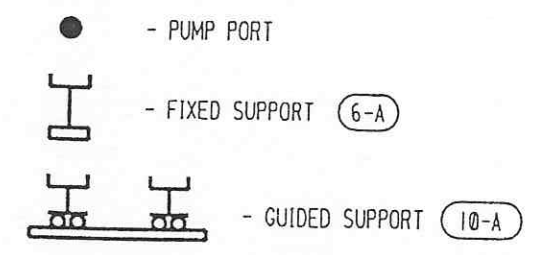

CBI		SUPPLIER'S / PURCHASER'S NO	
LIGO BEAM TUBE MODULES HANFORD, WA & LIVINGSTON, LA			
SUB-MODULES (A) & (D)			
CUSTOMER'S NO		CONTRACT NO	
BY <u>KJR</u> CHKD _____ DATE _____		930212	
D.F. Thom		DWG 2	REV 2
ENGINEERING ASSIGNED		SHT	
LIGO-D950032-02-B			

3212A002.DGN

▶ INDICATES CHANGE FROM PREVIOUS ISSUE