
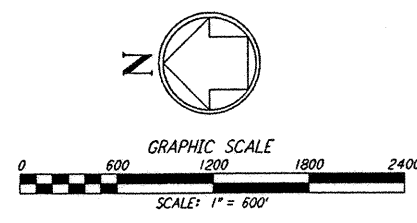


This document and the design it covers are the property of PARSONS. They are loaned only with the borrower's expressed written agreement that they will not be reproduced, copied, loaned, exhibited, or used in any other way, except by written consent from PARSONS to the borrower.

This document and the design it covers are the property of PARSONS. They are loaned only with the borrower's expressed written agreement that they will not be reproduced, copied, loaned, exhibited, or used in any other way, except by written consent from PARSONS to the borrower.

IN: F:\01\_21\_2002\2101\_1770\_5374\2002 - JAVL\13\WORKSPACE\PROJECTS\LIGO\DRAWING

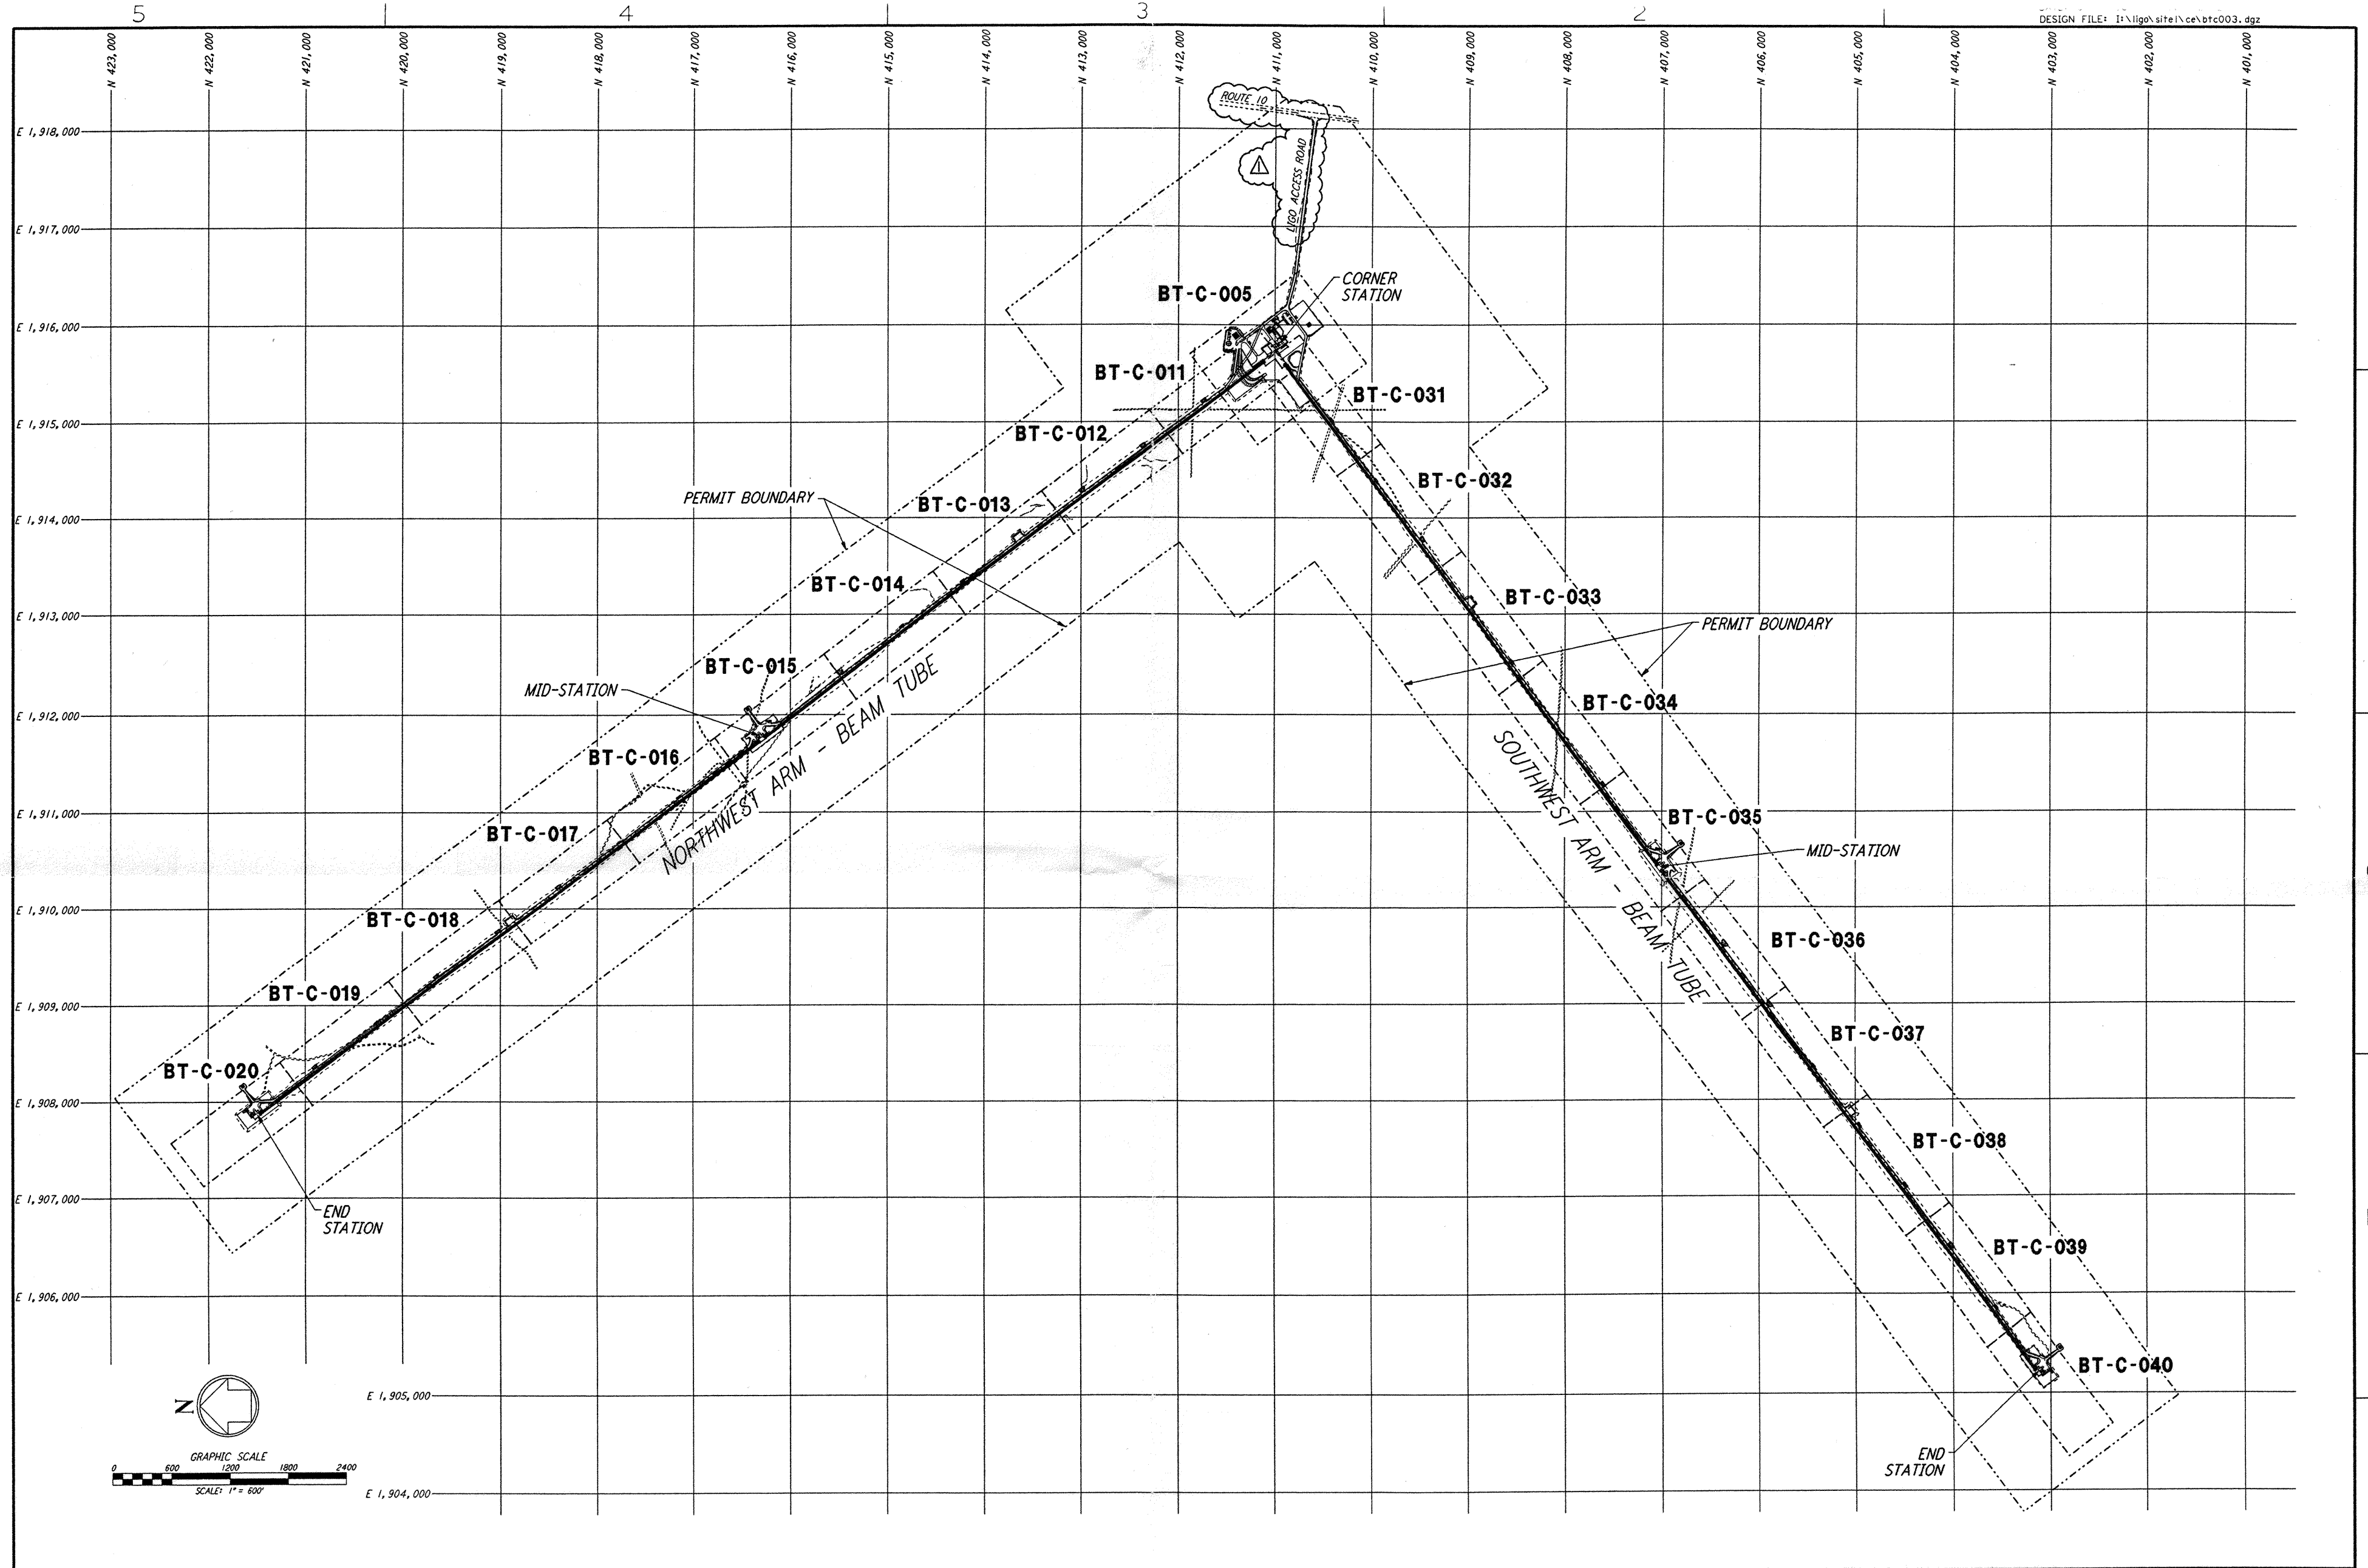

<p>REFERENCES</p> <table border="1"> <tr><td> </td><td> </td><td> </td><td> </td><td> </td><td> </td></tr> <tr><td> </td><td> </td><td> </td><td> </td><td> </td><td> </td></tr> <tr><td> </td><td> </td><td> </td><td> </td><td> </td><td> </td></tr> <tr><td> </td><td> </td><td> </td><td> </td><td> </td><td> </td></tr> <tr><td> </td><td> </td><td> </td><td> </td><td> </td><td> </td></tr> </table>																															<p>REVISIONS</p> <table border="1"> <tr><td> </td><td> </td><td> </td><td> </td><td> </td><td> </td></tr> <tr><td> </td><td> </td><td> </td><td> </td><td> </td><td> </td></tr> <tr><td> </td><td> </td><td> </td><td> </td><td> </td><td> </td></tr> <tr><td> </td><td> </td><td> </td><td> </td><td> </td><td> </td></tr> <tr><td> </td><td> </td><td> </td><td> </td><td> </td><td> </td></tr> </table>																															<p>ISSUED FOR CONSTRUCTION</p> <table border="1"> <tr><td>DRAWN</td><td>WRB</td><td>1-19-96</td></tr> <tr><td>CHECKED</td><td>MP</td><td>1-19-96</td></tr> <tr><td>ENGINEER</td><td>JEB</td><td>1-19-96</td></tr> <tr><td>PROJ</td><td>MDW</td><td>1-19-96</td></tr> </table>	DRAWN	WRB	1-19-96	CHECKED	MP	1-19-96	ENGINEER	JEB	1-19-96	PROJ	MDW	1-19-96		<p>100 WEST WALNUT STREET PASADENA, CALIFORNIA</p>	<p>CALIFORNIA INSTITUTE OF TECHNOLOGY MASSACHUSETTS INSTITUTE OF TECHNOLOGY</p>	<p>LASER INTERFEROMETER GRAVITATIONAL-WAVE OBSERVATORY BTE SITEWORK &amp; FABRICATION - HANFORD, WA</p> <table border="1"> <tr><td>SCALE</td><td>CONTRACT NUMBER</td><td>PROJECT NUMBER</td></tr> <tr><td>1" = 600'</td><td>PP150969</td><td>8094</td></tr> <tr><td colspan="2">SHEET NUMBER</td><td>REVISIONS</td></tr> <tr><td colspan="2">BT-C-003</td><td> </td></tr> </table>	SCALE	CONTRACT NUMBER	PROJECT NUMBER	1" = 600'	PP150969	8094	SHEET NUMBER		REVISIONS	BT-C-003		
DRAWN	WRB	1-19-96	
CHECKED	MP	1-19-96	
ENGINEER	JEB	1-19-96	
PROJ	MDW	1-19-96	
SCALE	CONTRACT NUMBER	PROJECT NUMBER	
1" = 600'	PP150969	8094	
SHEET NUMBER		REVISIONS	
BT-C-003	
<table border="1"> <tr><th>DRAWING NO.</th><th>DESCRIPTION</th></tr> <tr><td> </td><td> </td></tr> </table>		DRAWING NO.	DESCRIPTION			<table border="1"> <tr><th>NO.</th><th>DATE</th><th>BY</th><th>CHKD</th><th>ENGR</th><th>PROJ</th><th>DESCRIPTION</th></tr> <tr><td>1</td><td>2-29-96</td><td>WRB</td><td> </td><td> </td><td> </td><td>CHANGE ORDER NO. 2</td></tr> </table>		NO.	DATE	BY	CHKD	ENGR	PROJ	DESCRIPTION	1	2-29-96	WRB				CHANGE ORDER NO. 2	<p style="text-align: right;">LIGO 0960163-01-01</p>		<p style="text-align: right;">LIGOBTF3.BOR</p>	
DRAWING NO.	DESCRIPTION	
NO.	DATE	BY	CHKD	ENGR	PROJ	DESCRIPTION	
1	2-29-96	WRB				CHANGE ORDER NO. 2	

5

4

3

2

LIGO 0960163-01-01

LIGOBTF3.BOR

IN: F:\01\_21\_2002\2101\_1770\_5374\2002 - JAVL\13\WORKSPACE\PROJECTS\LIGO\DRAWING