
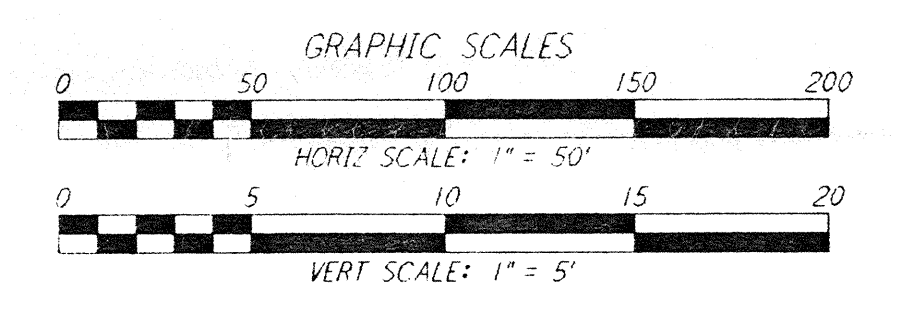
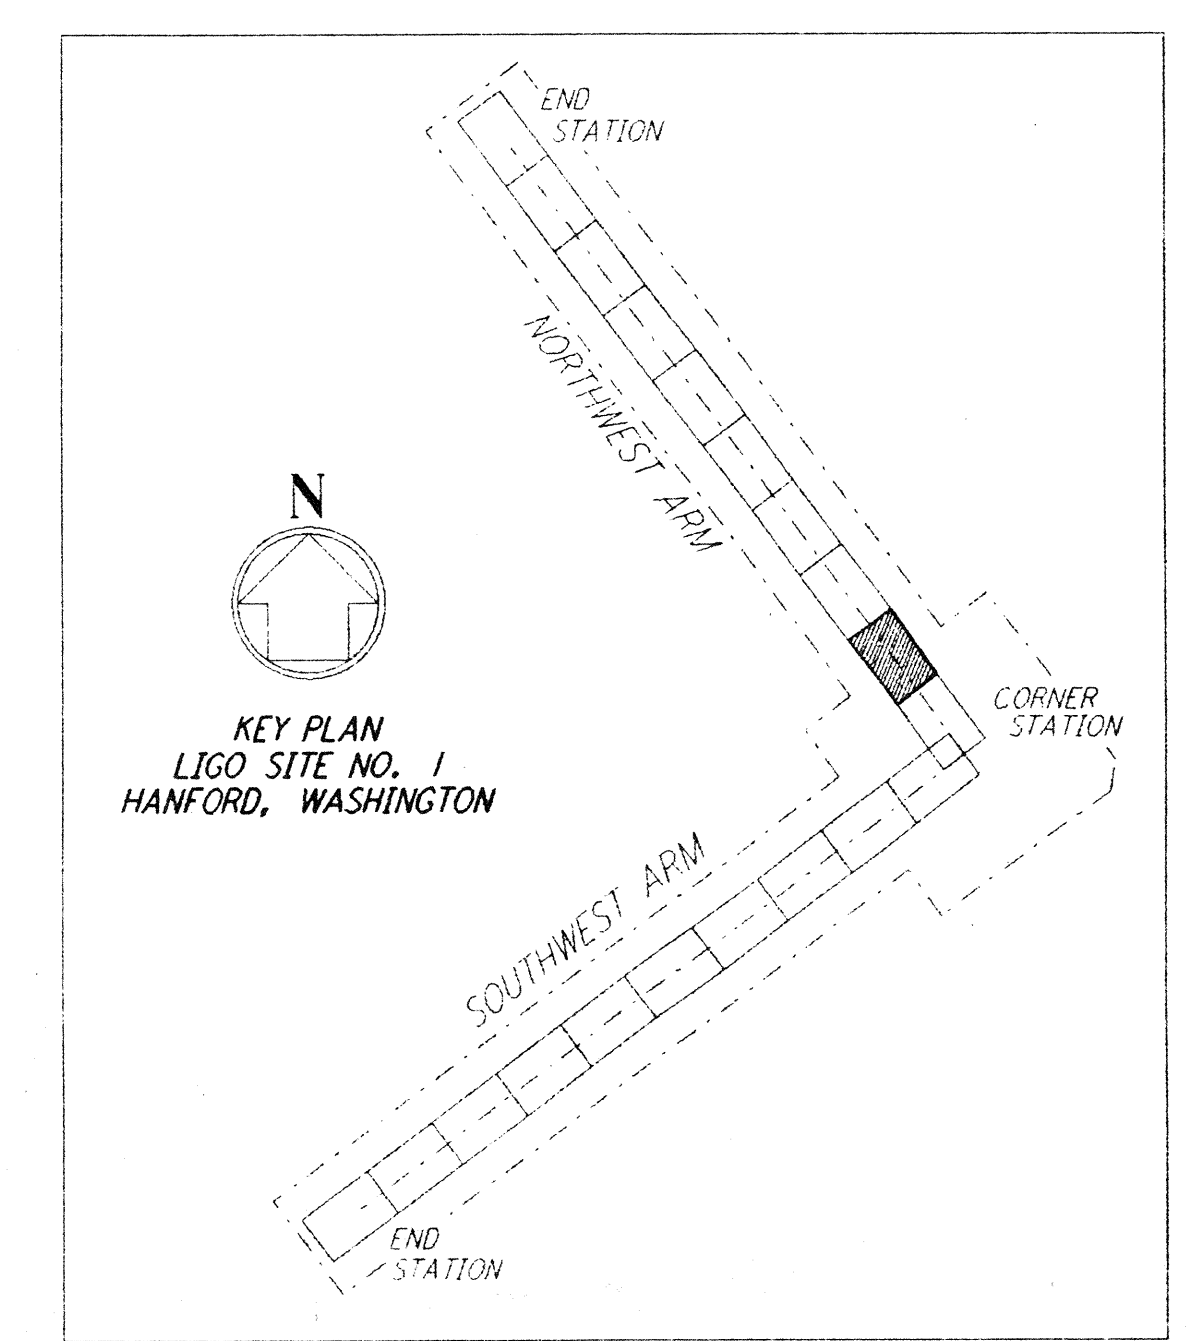
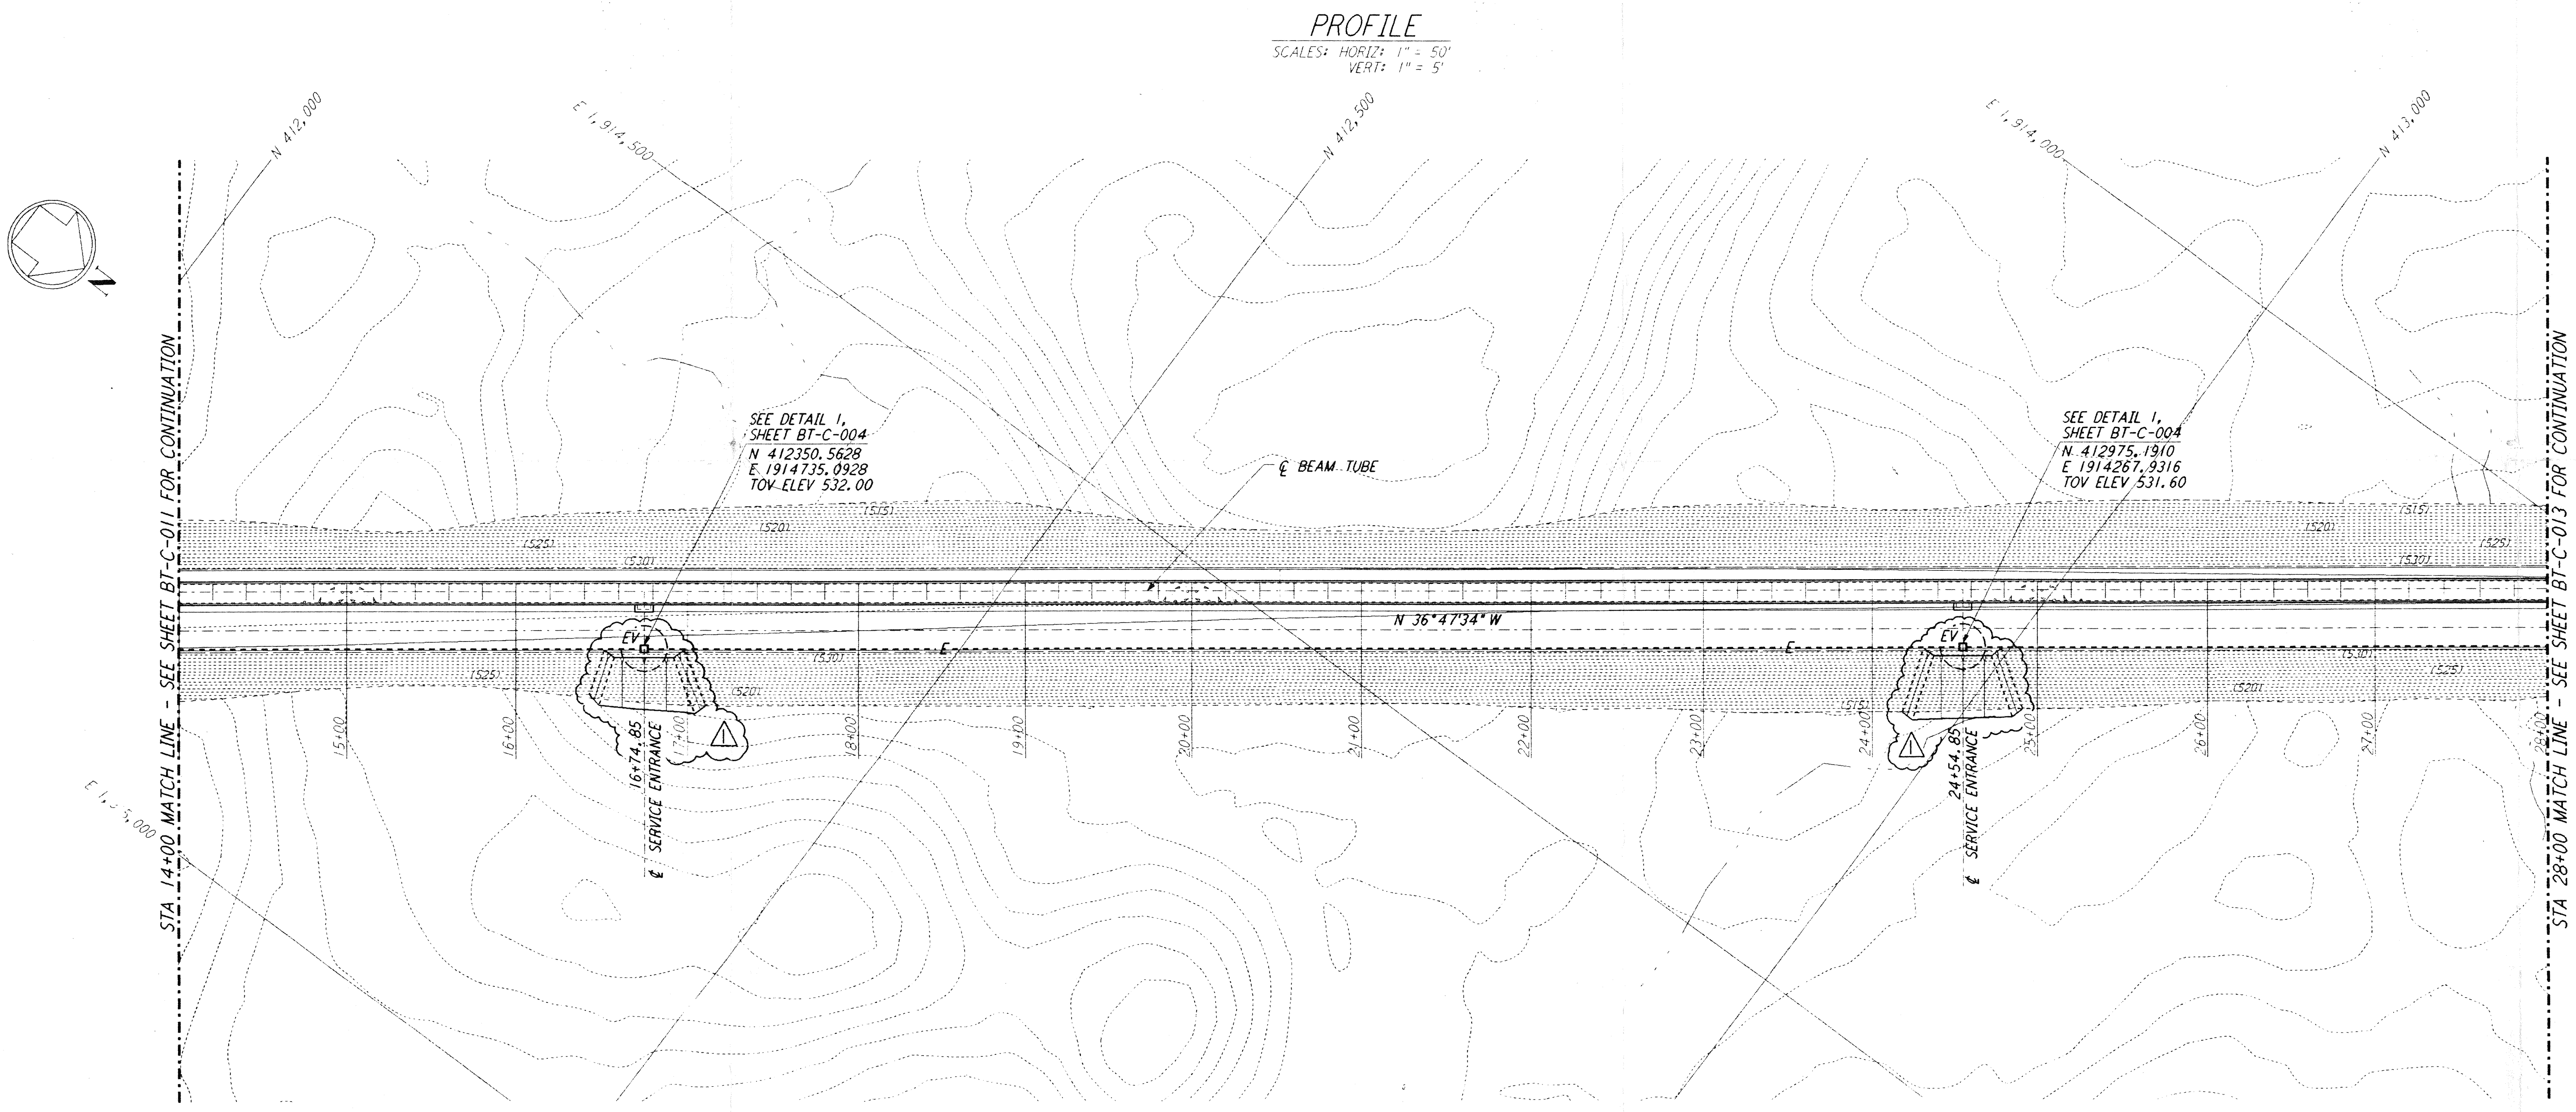


- NOTES:**
1. SEE SHEET BT-C-002 FOR GENERAL NOTES, LEGEND AND ABBREVIATIONS.
 2. SEE SHEET BT-C-004 FOR TYPICAL SECTIONS AND DETAILS.

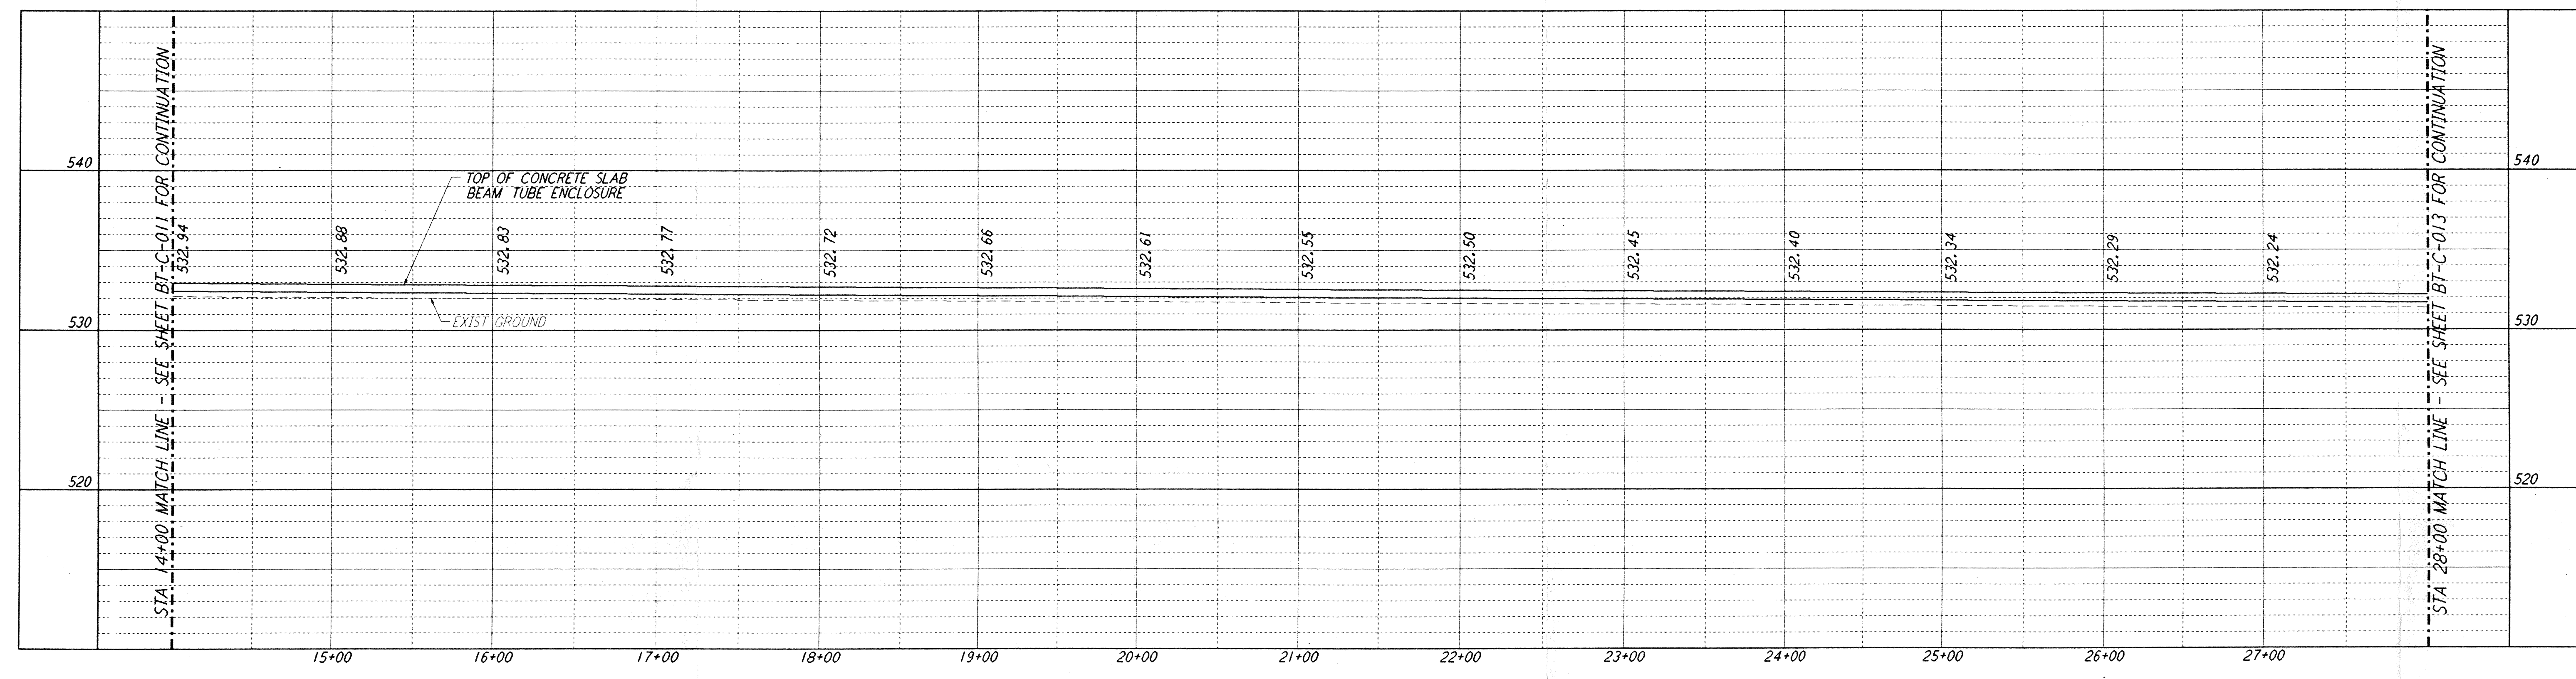

NO.	DATE	BY	CHKD	ENGR	PROJ	DESCRIPTION
1	2-29-96	WRB				CHANGE ORDER NO. 2

ISSUED FOR CONSTRUCTION	
DRAWN	WRB 1-19-96
CHECKED	MP 1-19-96
ENGINEER	JB 1-19-96
PROJ	MDW 1-19-96

Handwritten signature and initials

PARSONS
 100 WEST WALNUT STREET
 PASADENA, CALIFORNIA

LIGO
 CALIFORNIA INSTITUTE OF TECHNOLOGY
 MASSACHUSETTS INSTITUTE OF TECHNOLOGY

LASER INTERFEROMETER
 GRAVITATIONAL-WAVE OBSERVATORY
 BTE SITework & FABRICATION - HANFORD, WA

CIVIL
 NORTHWEST ARM
 PLAN AND PROFILE
 STA 14+00 TO STA 28+00

AS NOTED PPI 50969 8094
BT-C-012

LIGO-D960167-01-D

Date Revised:	3/25/96	LIGO-D960167-01-D
Title #		Sheet # BT-C-012
Drawn	/ /	Approved
Checked	/ /	Approved
Engineer	/ /	Approved
Design	/ /	Approved
Date	/ /	Approved

PARSONS. They are loaned only with the written consent from the borrower's expressed written agreement that they will PARSONS to the borrower.

E
 D
 C
 B
 A