

5


4

3

2


**NOTES:**

1. SEE SHEET BT-C-002 FOR GENERAL NOTES, LEGEND AND ABBREVIATIONS.
2. SEE SHEET BT-C-004 FOR TYPICAL SECTIONS AND DETAILS.

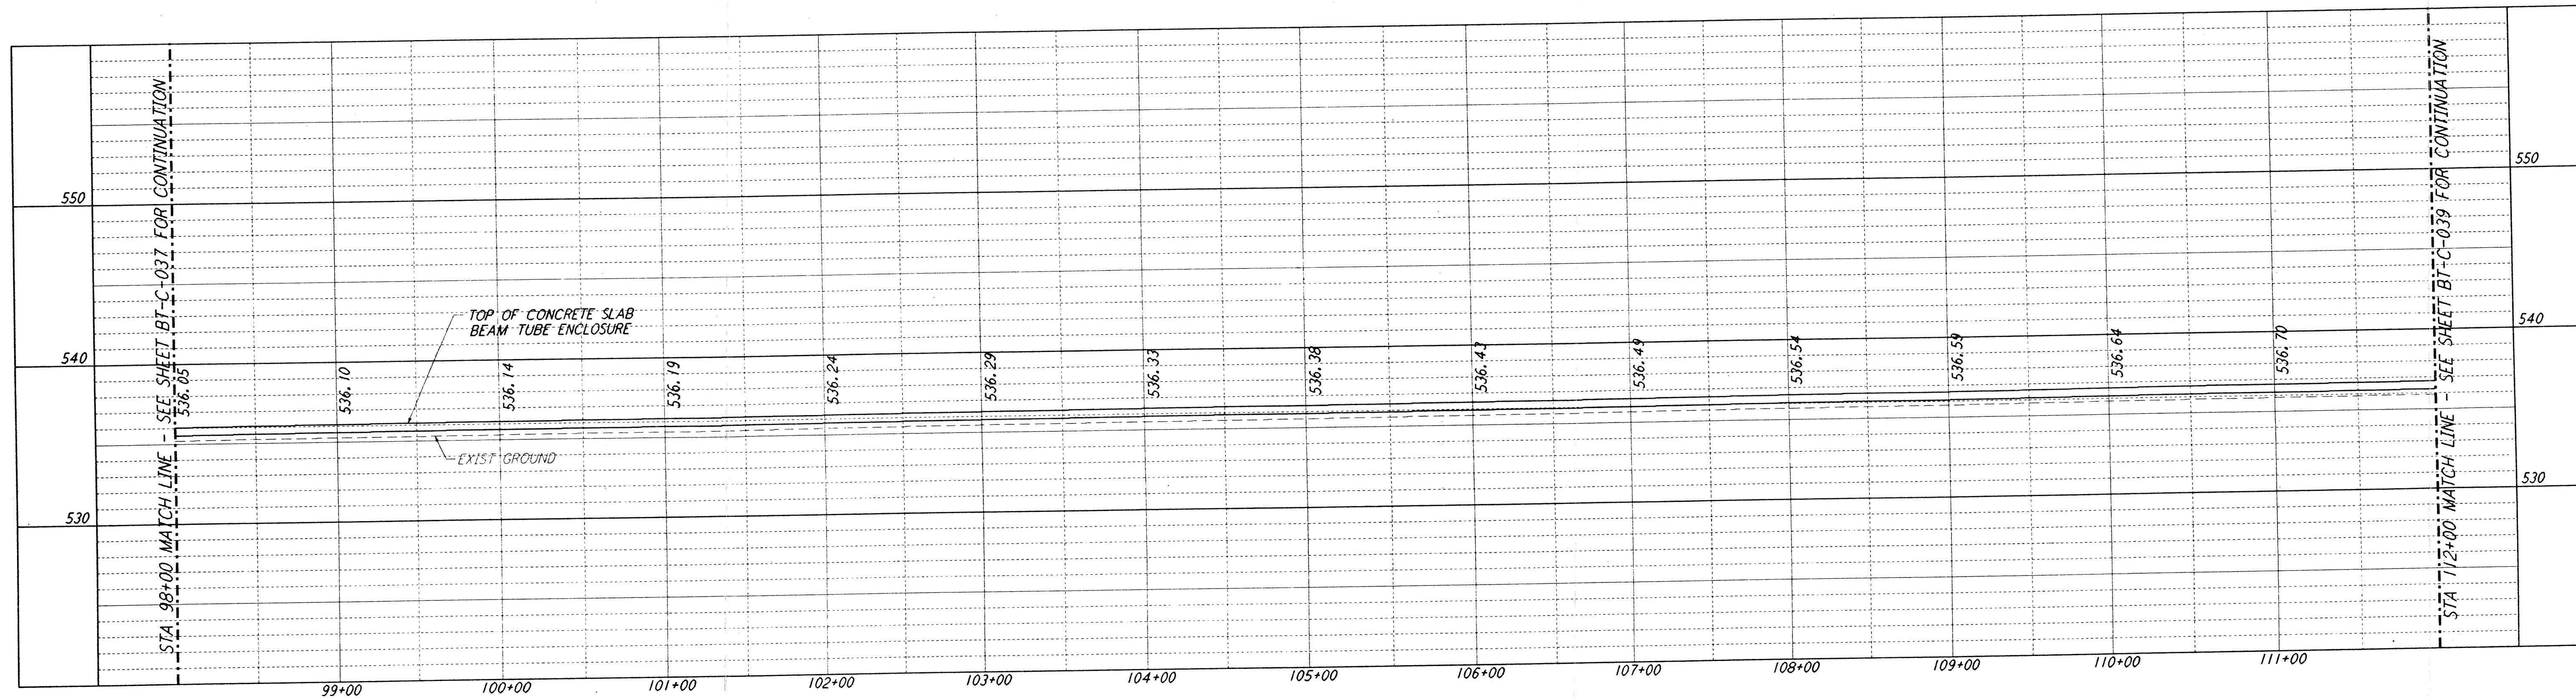



**PROFILE**

SCALE: HORIZ: 1" = 50'  
 VERT: 1" = 5'

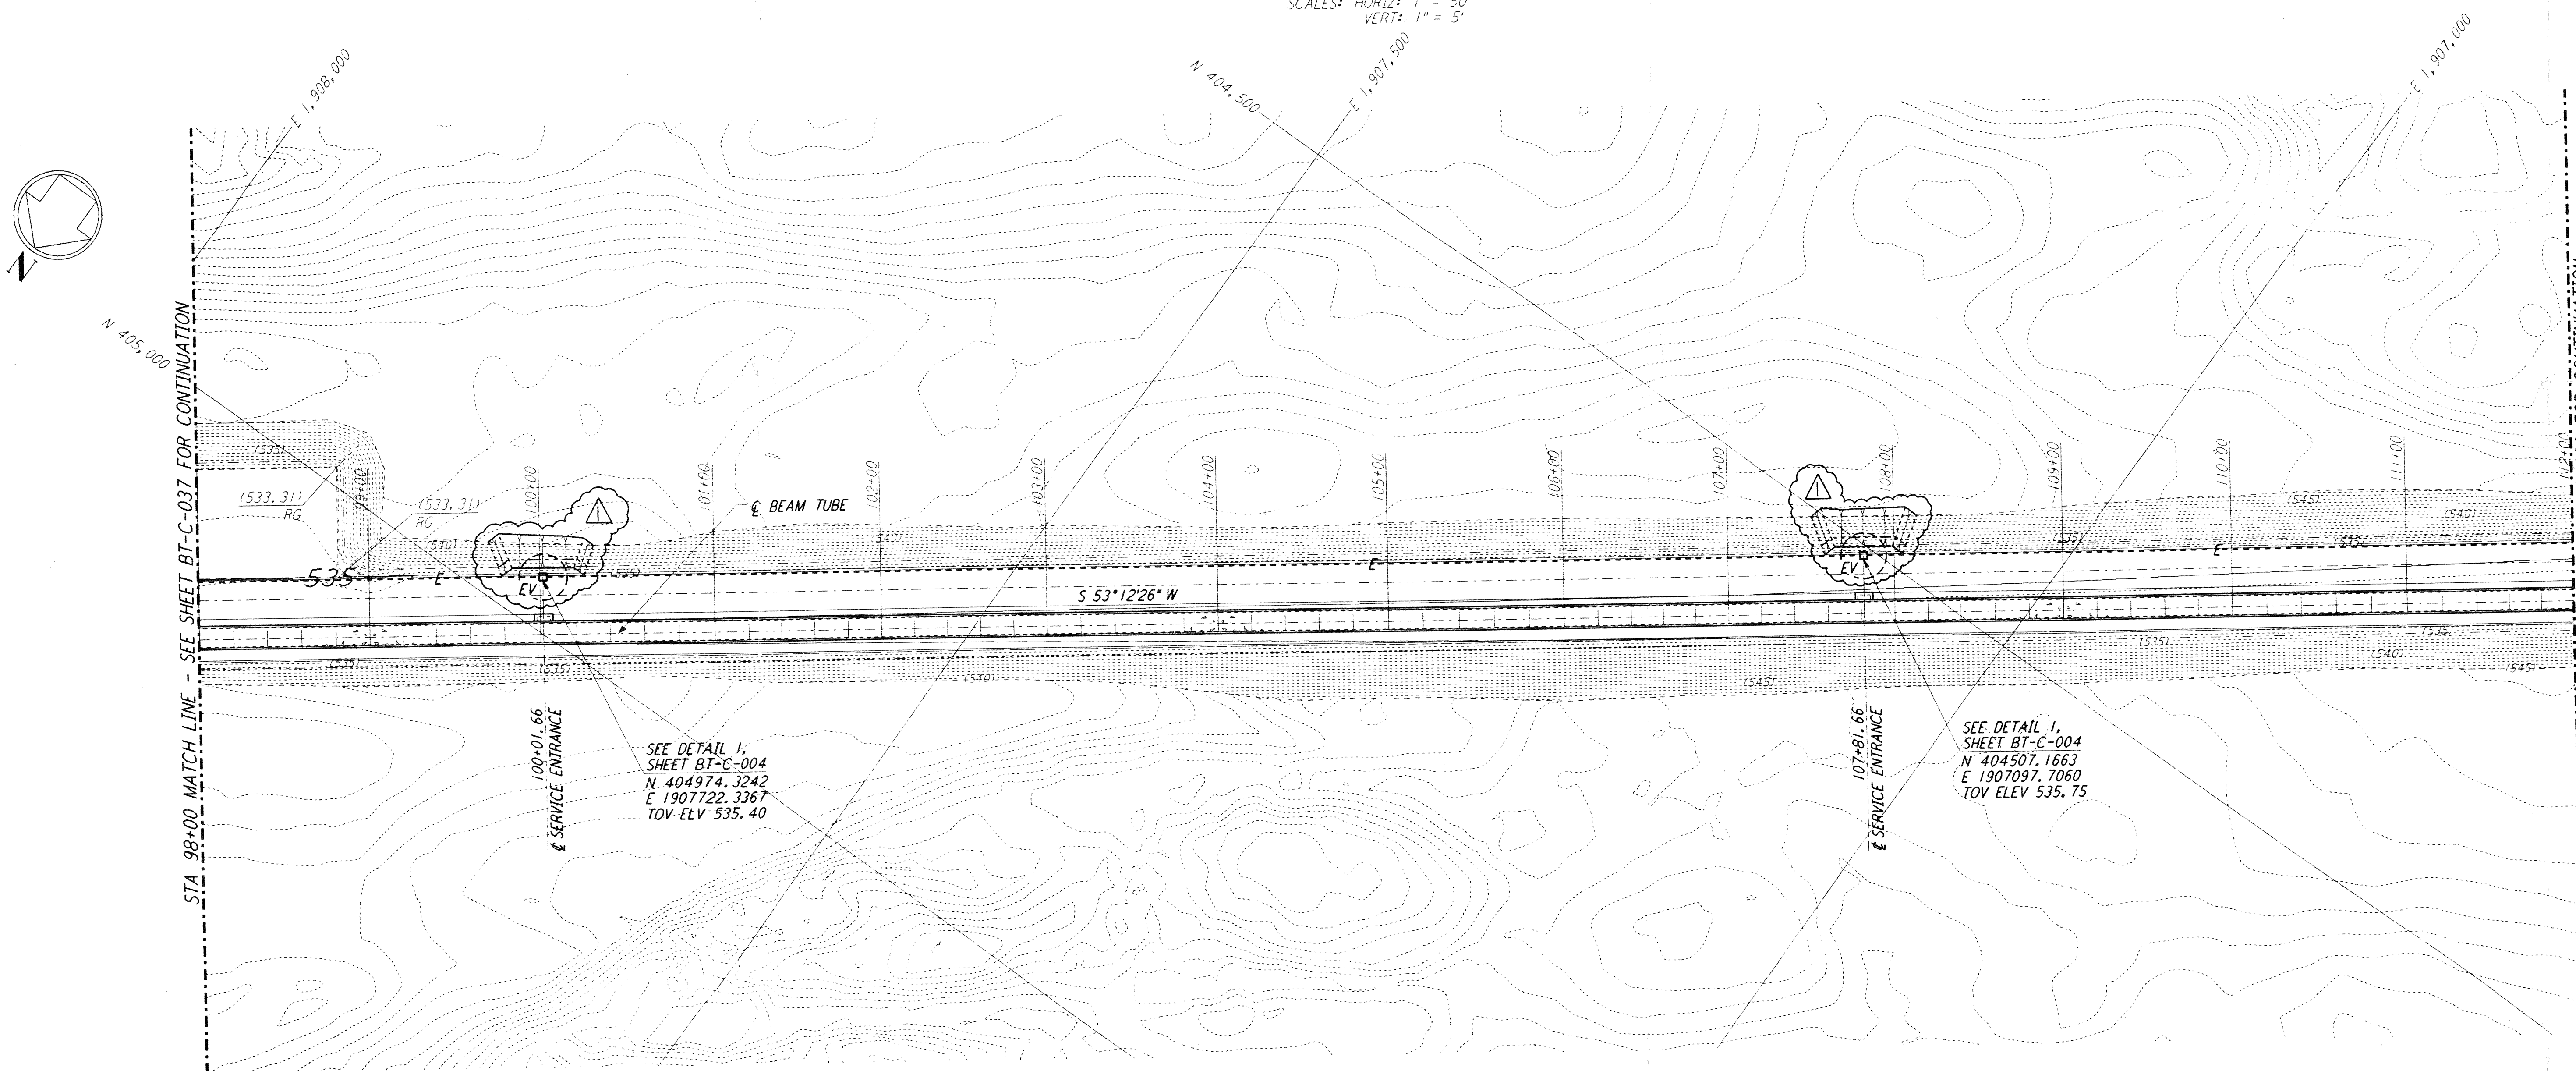

**PLAN**

SCALE: 1" = 50'

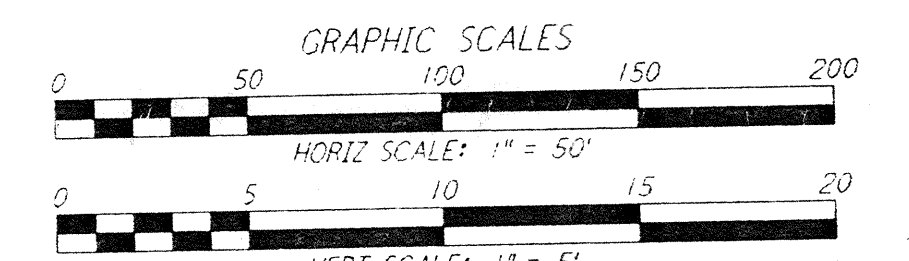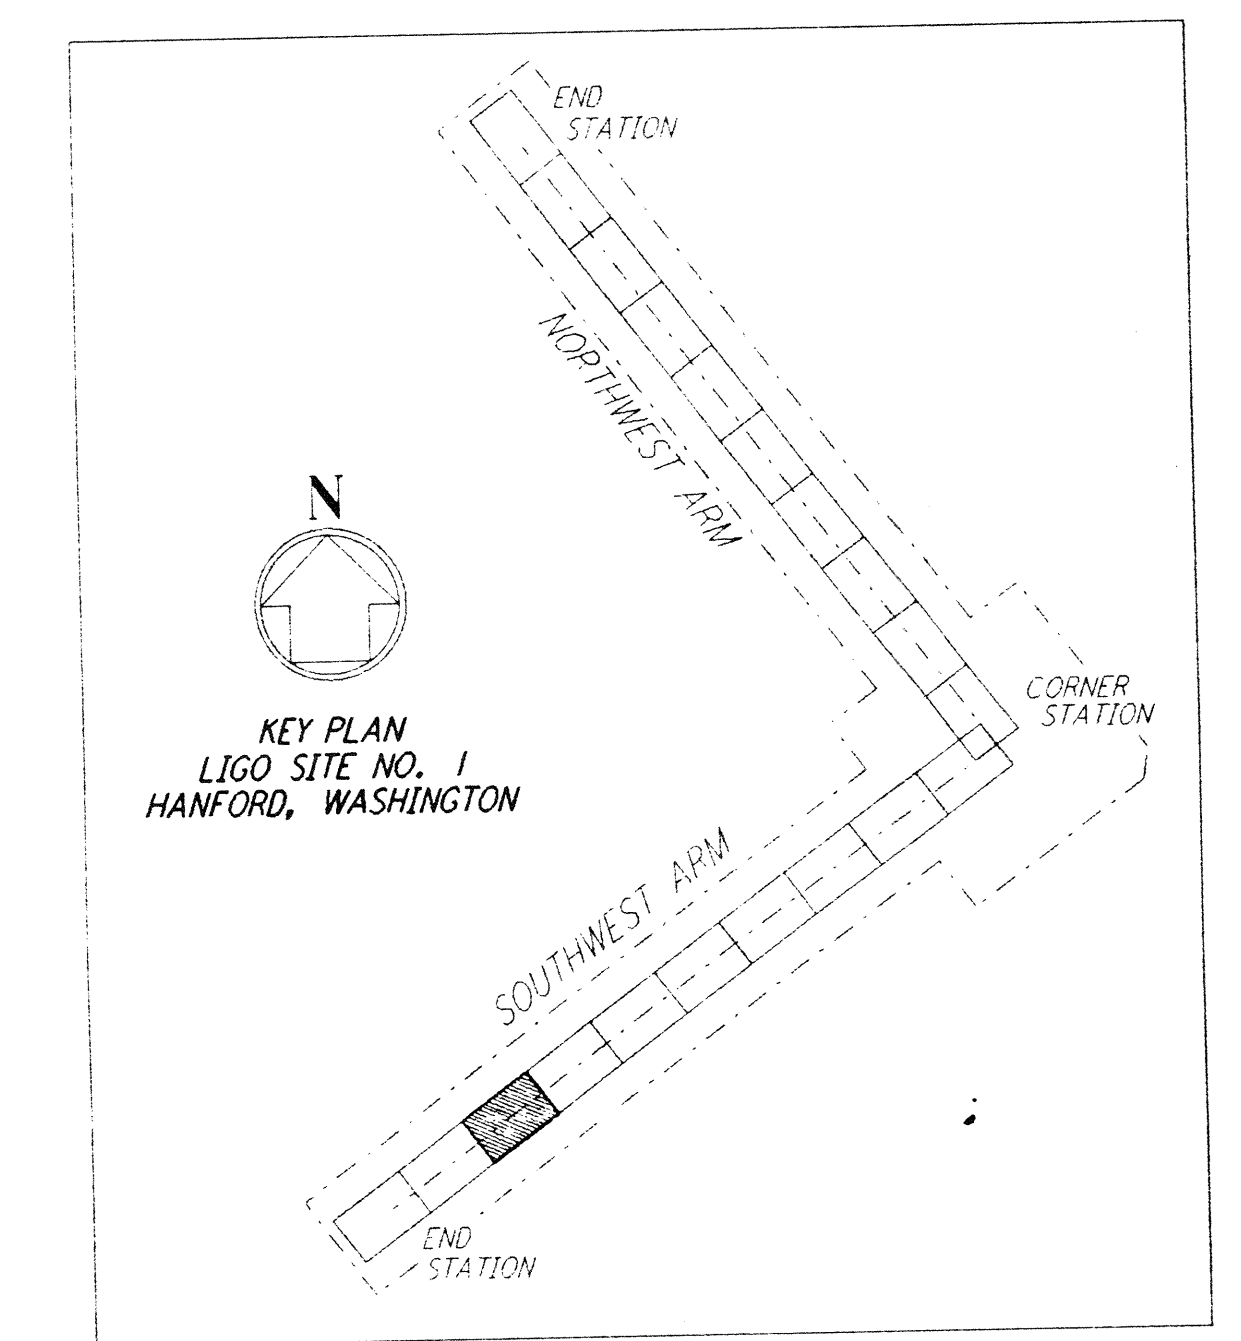

ISSUED FOR CONSTRUCTION			
DRAWN	WRB	1-19-96	
CHECKED	MP	1-19-96	
ENGINEER	JB	1-19-96	
PROJ	MDW	1-19-96	

*John Howard*

rlaw



100 WEST WALNUT STREET  
 PASADENA, CALIFORNIA



CALIFORNIA INSTITUTE OF TECHNOLOGY  
 MASSACHUSETTS INSTITUTE OF TECHNOLOGY

LASER INTERFEROMETER  
 GRAVITATIONAL-WAVE OBSERVATORY  
 BTE SITework & FABRICATION - HANFORD, WA

TITLE	CIVIL SOUTHWEST ARM PLAN AND PROFILE STA 98+00 TO STA 112+00	AS NOTED	PP150969	PROJECT NUMBER	8094
SHEET NUMBER	BT-C-038	REVISIONS			

LIGO-D960183-017

NO.	DATE	BY	CHKD	ENGR	PROJ	DESCRIPTION
1	2-29-96	WRB				CHANGE ORDER NO. 2

DRAWING NO.	DESCRIPTION
-------------	-------------

Date Received	9/25/96	Drawn	WRB	Checked	MP	Engineer	JB	Proj	MDW
DATE	/ /	APPROVED							
DATE	/ /	APPROVED							
DATE	/ /	APPROVED							

THIS DOCUMENT AND THE DESIGN IT REPRESENTS ARE THE PROPERTY OF PARSONS. THEY ARE LOANED ONLY WITH THE BORROWER'S EXPRESSED WRITTEN AGREEMENT THAT THEY WILL BE USED ONLY FOR THE PROJECT AND NOT BE REPRODUCED OR TRANSMITTED IN ANY FORM OR BY ANY MEANS, ELECTRONIC OR MECHANICAL, INCLUDING PHOTOCOPYING, RECORDING, OR BY ANY INFORMATION STORAGE AND RETRIEVAL SYSTEM, WITHOUT THE WRITTEN PERMISSION OF PARSONS.

PARSONS

5

4

3

2

A

B

C

D

E